


BK 11 6.2

Property
 53.1
 8.5
 27.2
 69.6
 22.4
 108.3
 431.7
 + 1136
 474.9

B.M. 125.45 N. BOTT Top of Fire Hyd. N. 18" — E.L. Litchfield

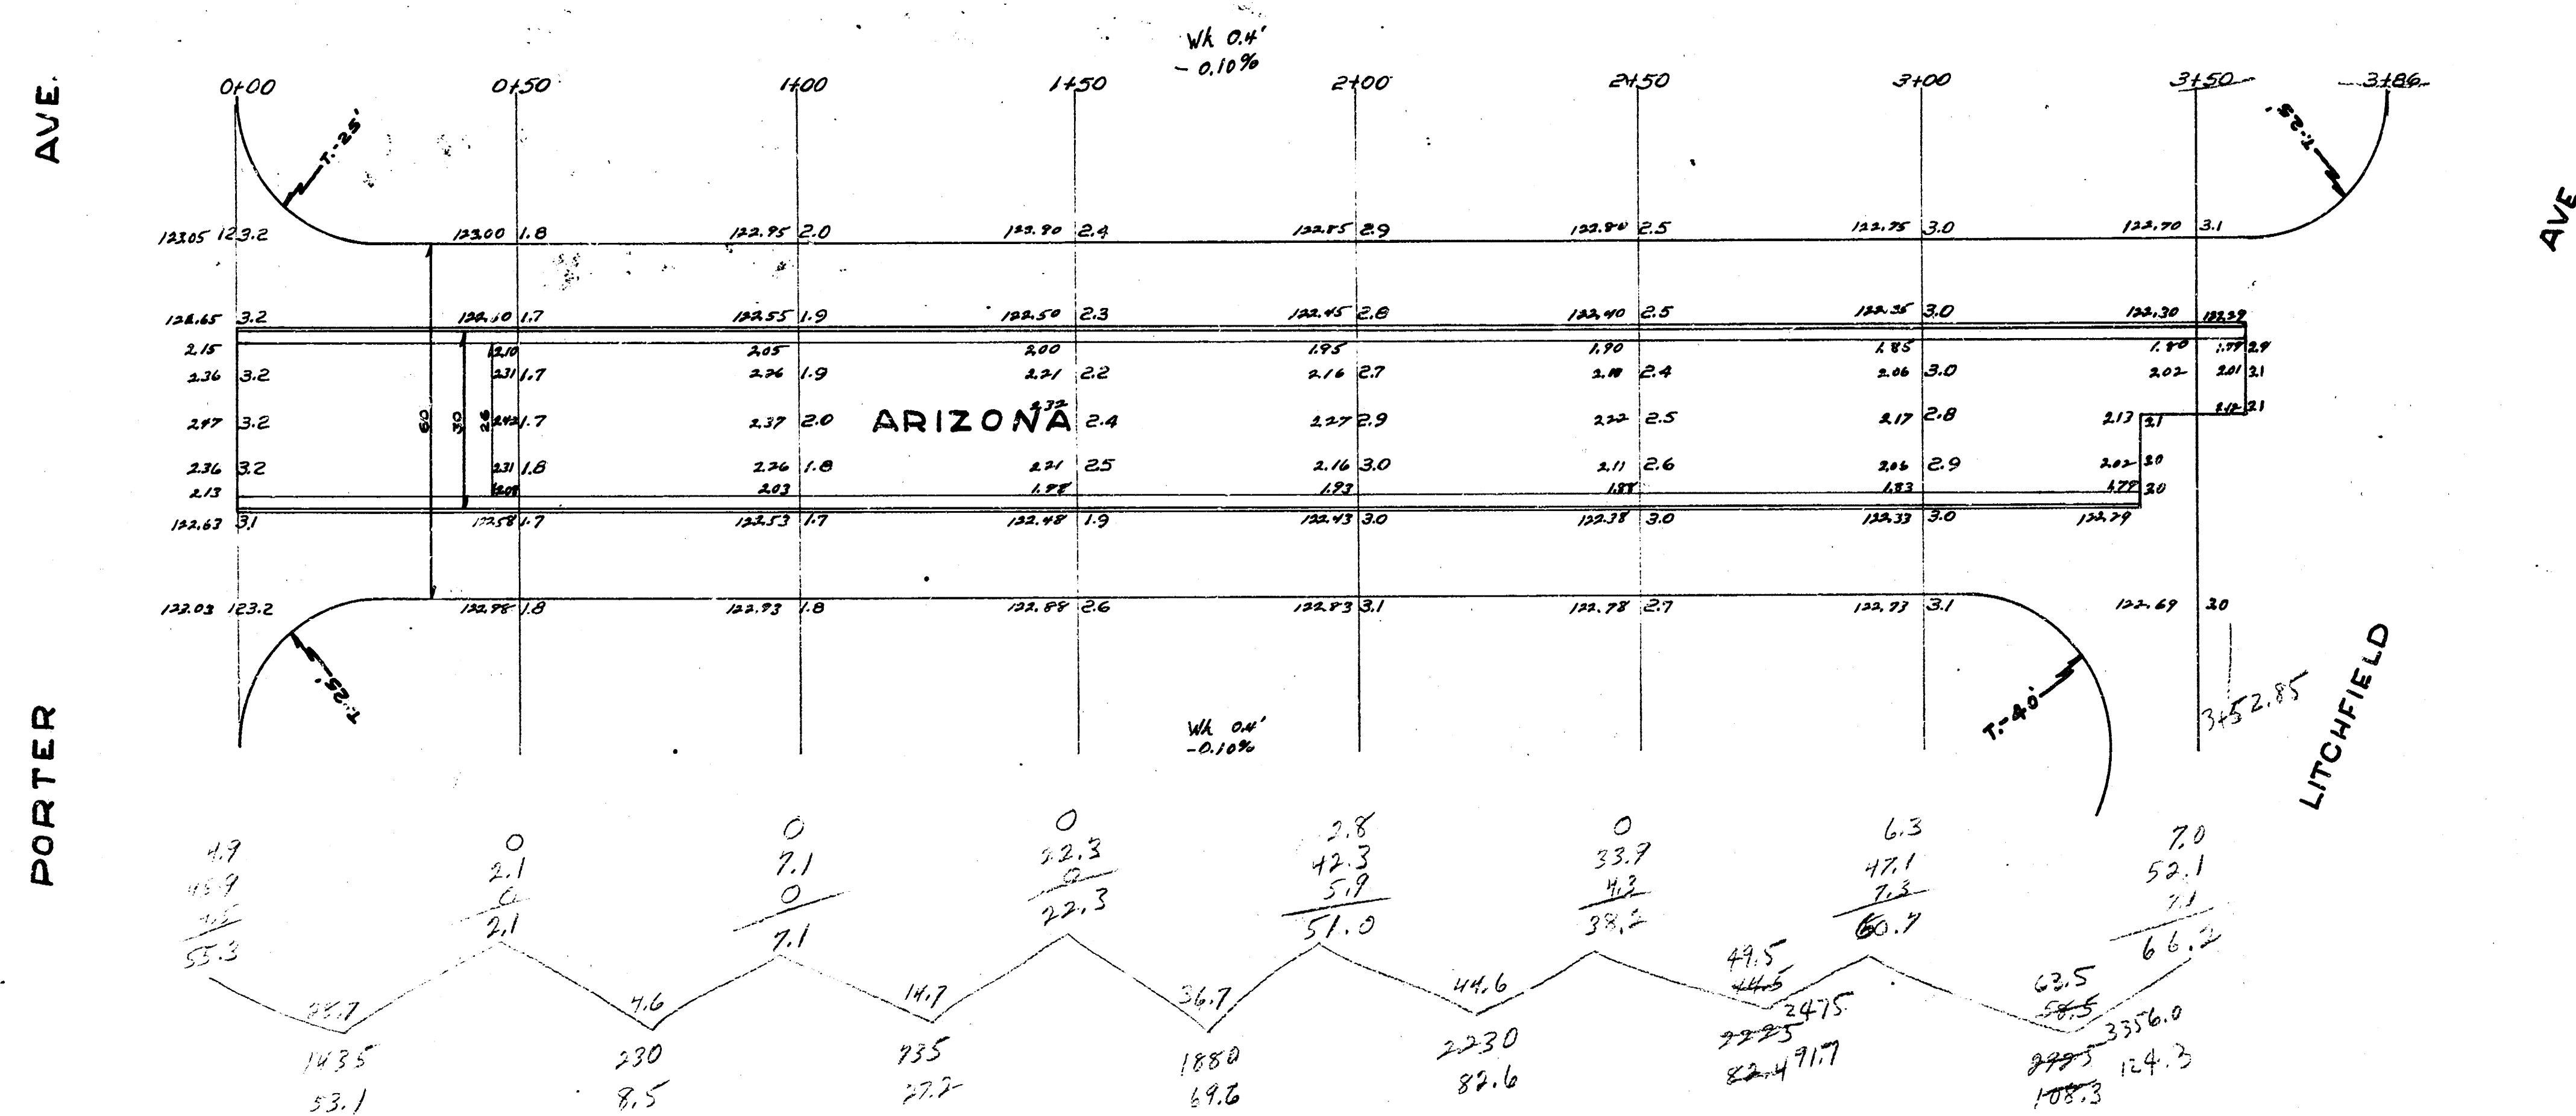

14 011003
 1
 ARIZONA
 W.L. LITCHFIELD E.L. PORTER
 26-2-30 ASPH. CONC.
 CITY OF WICHITA, KANS.
 L.K. WHITE CITY ENGINEER
 JULY, 1947