S-9

BM. 104.97 S.W. COR. CONC. PORCH HOS# 1616 S. ASH
BM. ~~98.33~~ 98.83 TOP Cb S. END RET. FUNSTON & ASH

Prop
104.3
86.3
113.9
157.0
204.8
241.3
255.2
251.5
214.3
167.3
126.9
64.6
1987.4

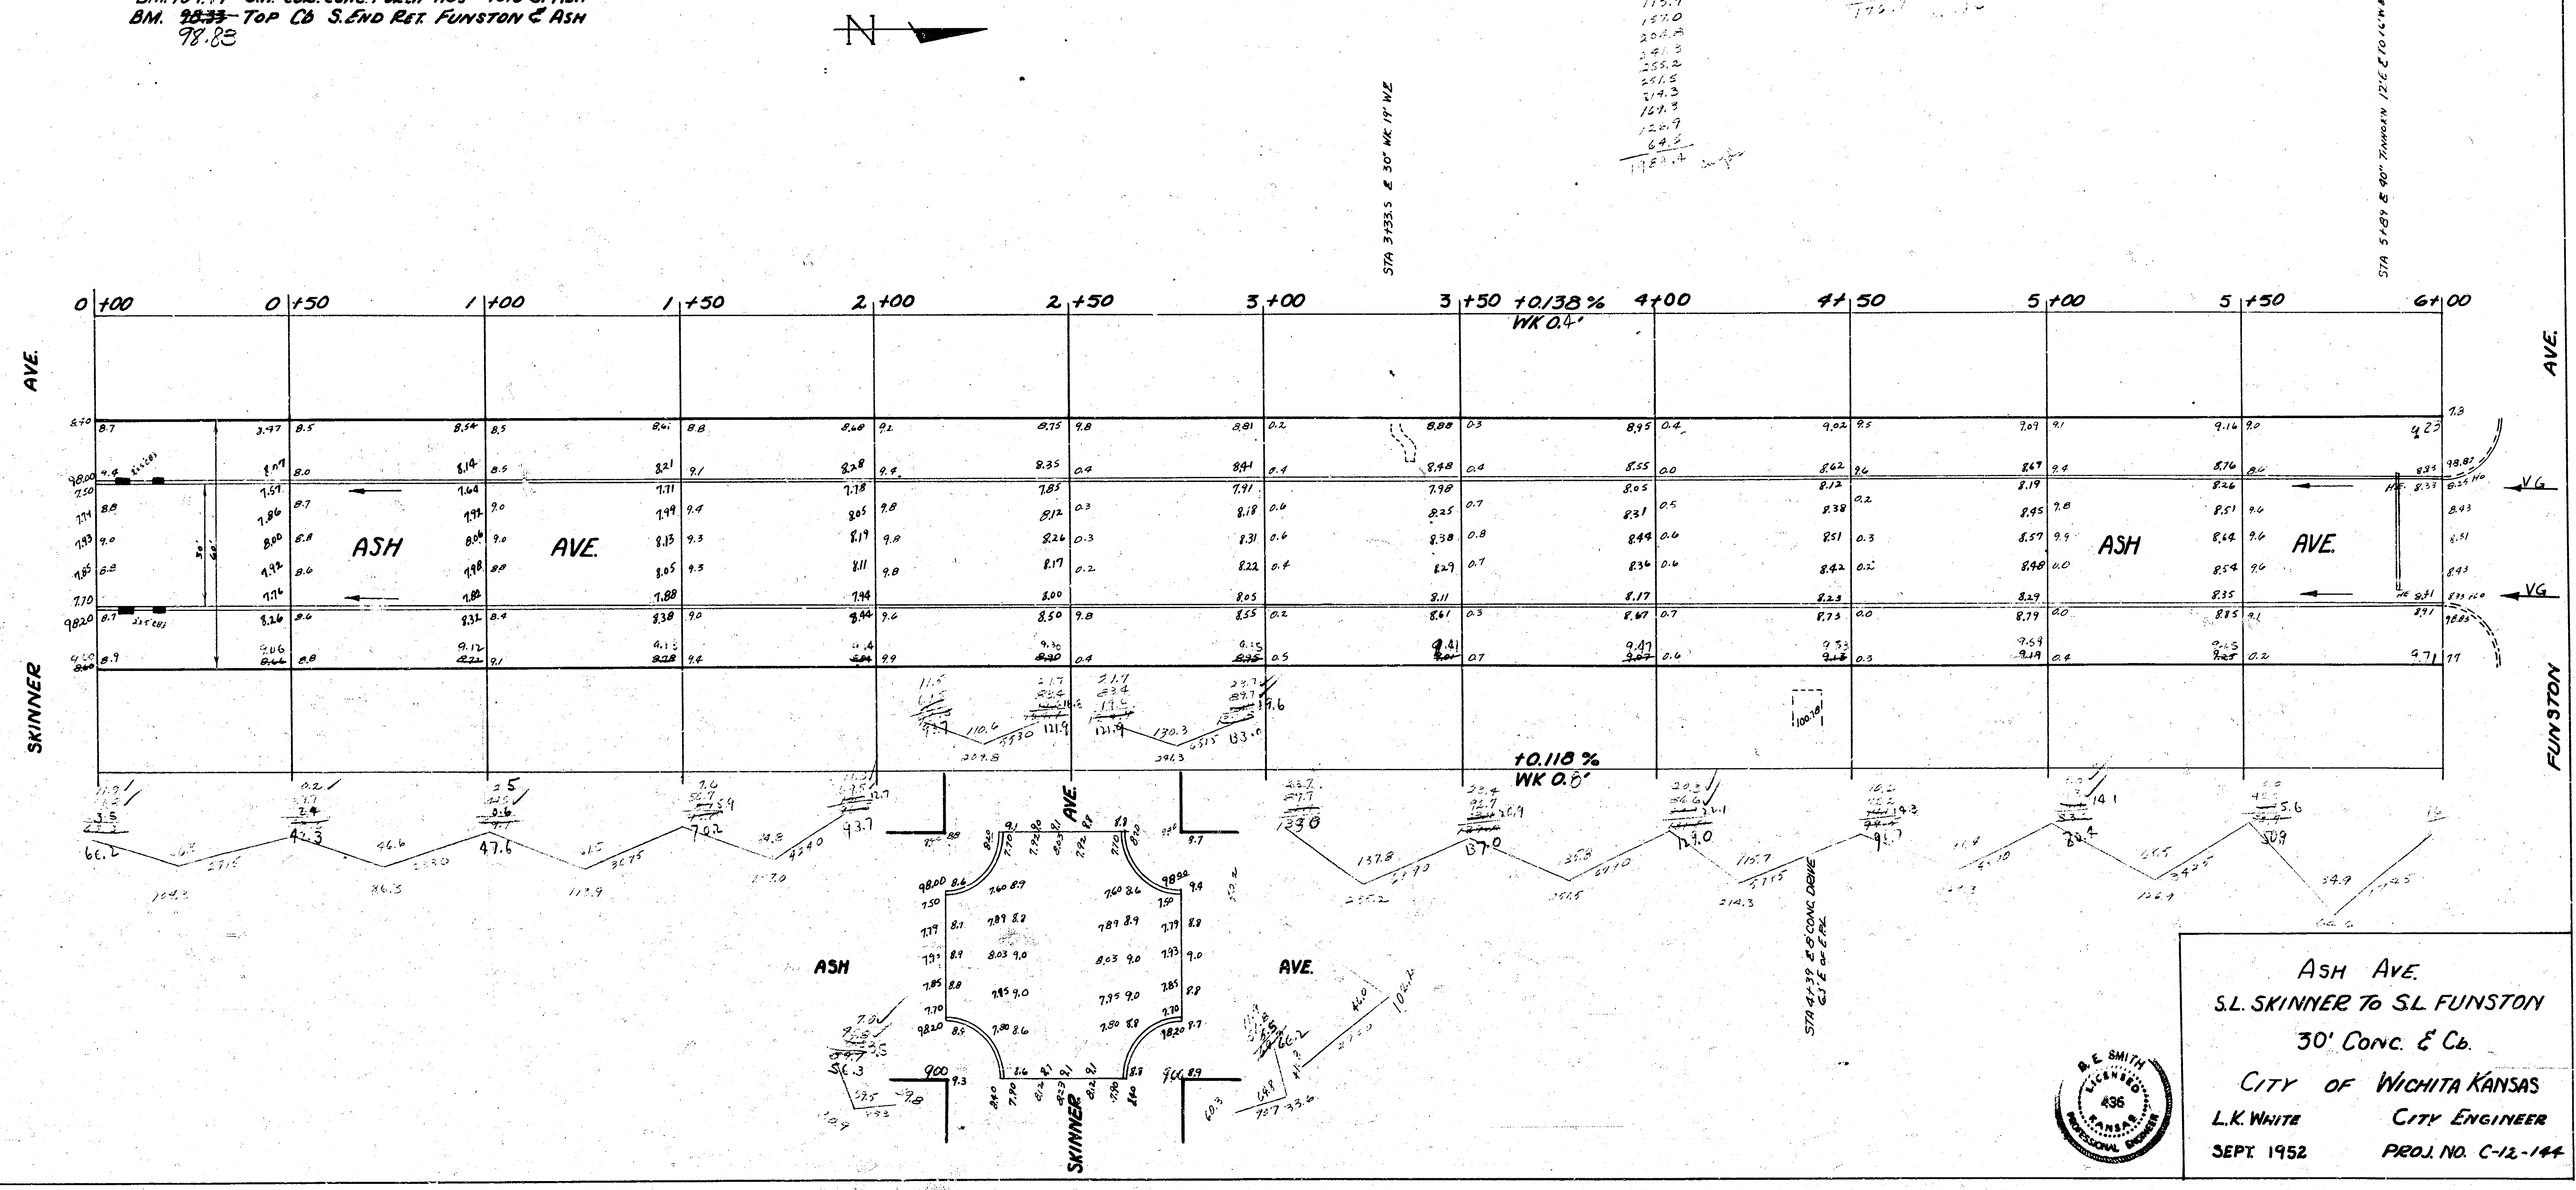
N
STA 3+33.5 ℄ 30" WK. 19' W℄
STA 5+89 ℄ 90" TINHORN 12' E ℄ TO 16' W℄
0+00
0+50
1+00
1+50
2+00
2+50
3+00
3+50
+0.138 %
WK 0.4'
4+00
4+50
5+00
5+50
6+00
AVE.
ASH
AVE.
ASH
AVE.
VG
VG
SKINNER
FUNSTON
+0.118 %
WK 0.6'
ASH
AVE
AVE.
SKINNER
STA 4+39 ℄ 8' CONC DRIVE 63' E of E.P.L.

ASH AVE.
S.L. SKINNER TO S.L. FUNSTON
30' CONC. & Cb.
CITY OF WICHITA KANSAS
L.K. WHITE CITY ENGINEER
SEPT. 1952 PROJ. NO. C-12-144

B. E. SMITH
LICENSED
436
KANSAS
PROFESSIONAL ENGINEER

1 3 3 (2)