

H-6

ch. Elevation



139 E CONC. DE. 32' RT.







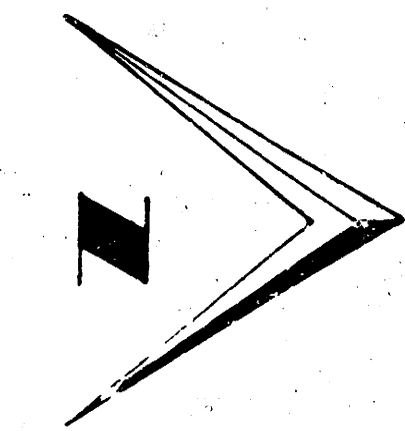

SCALE: 1"=20'

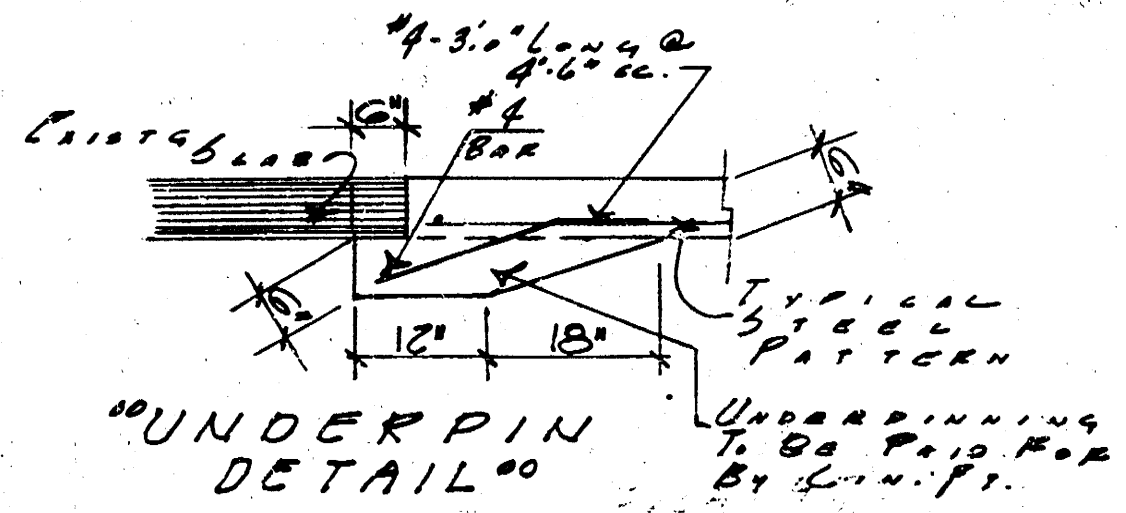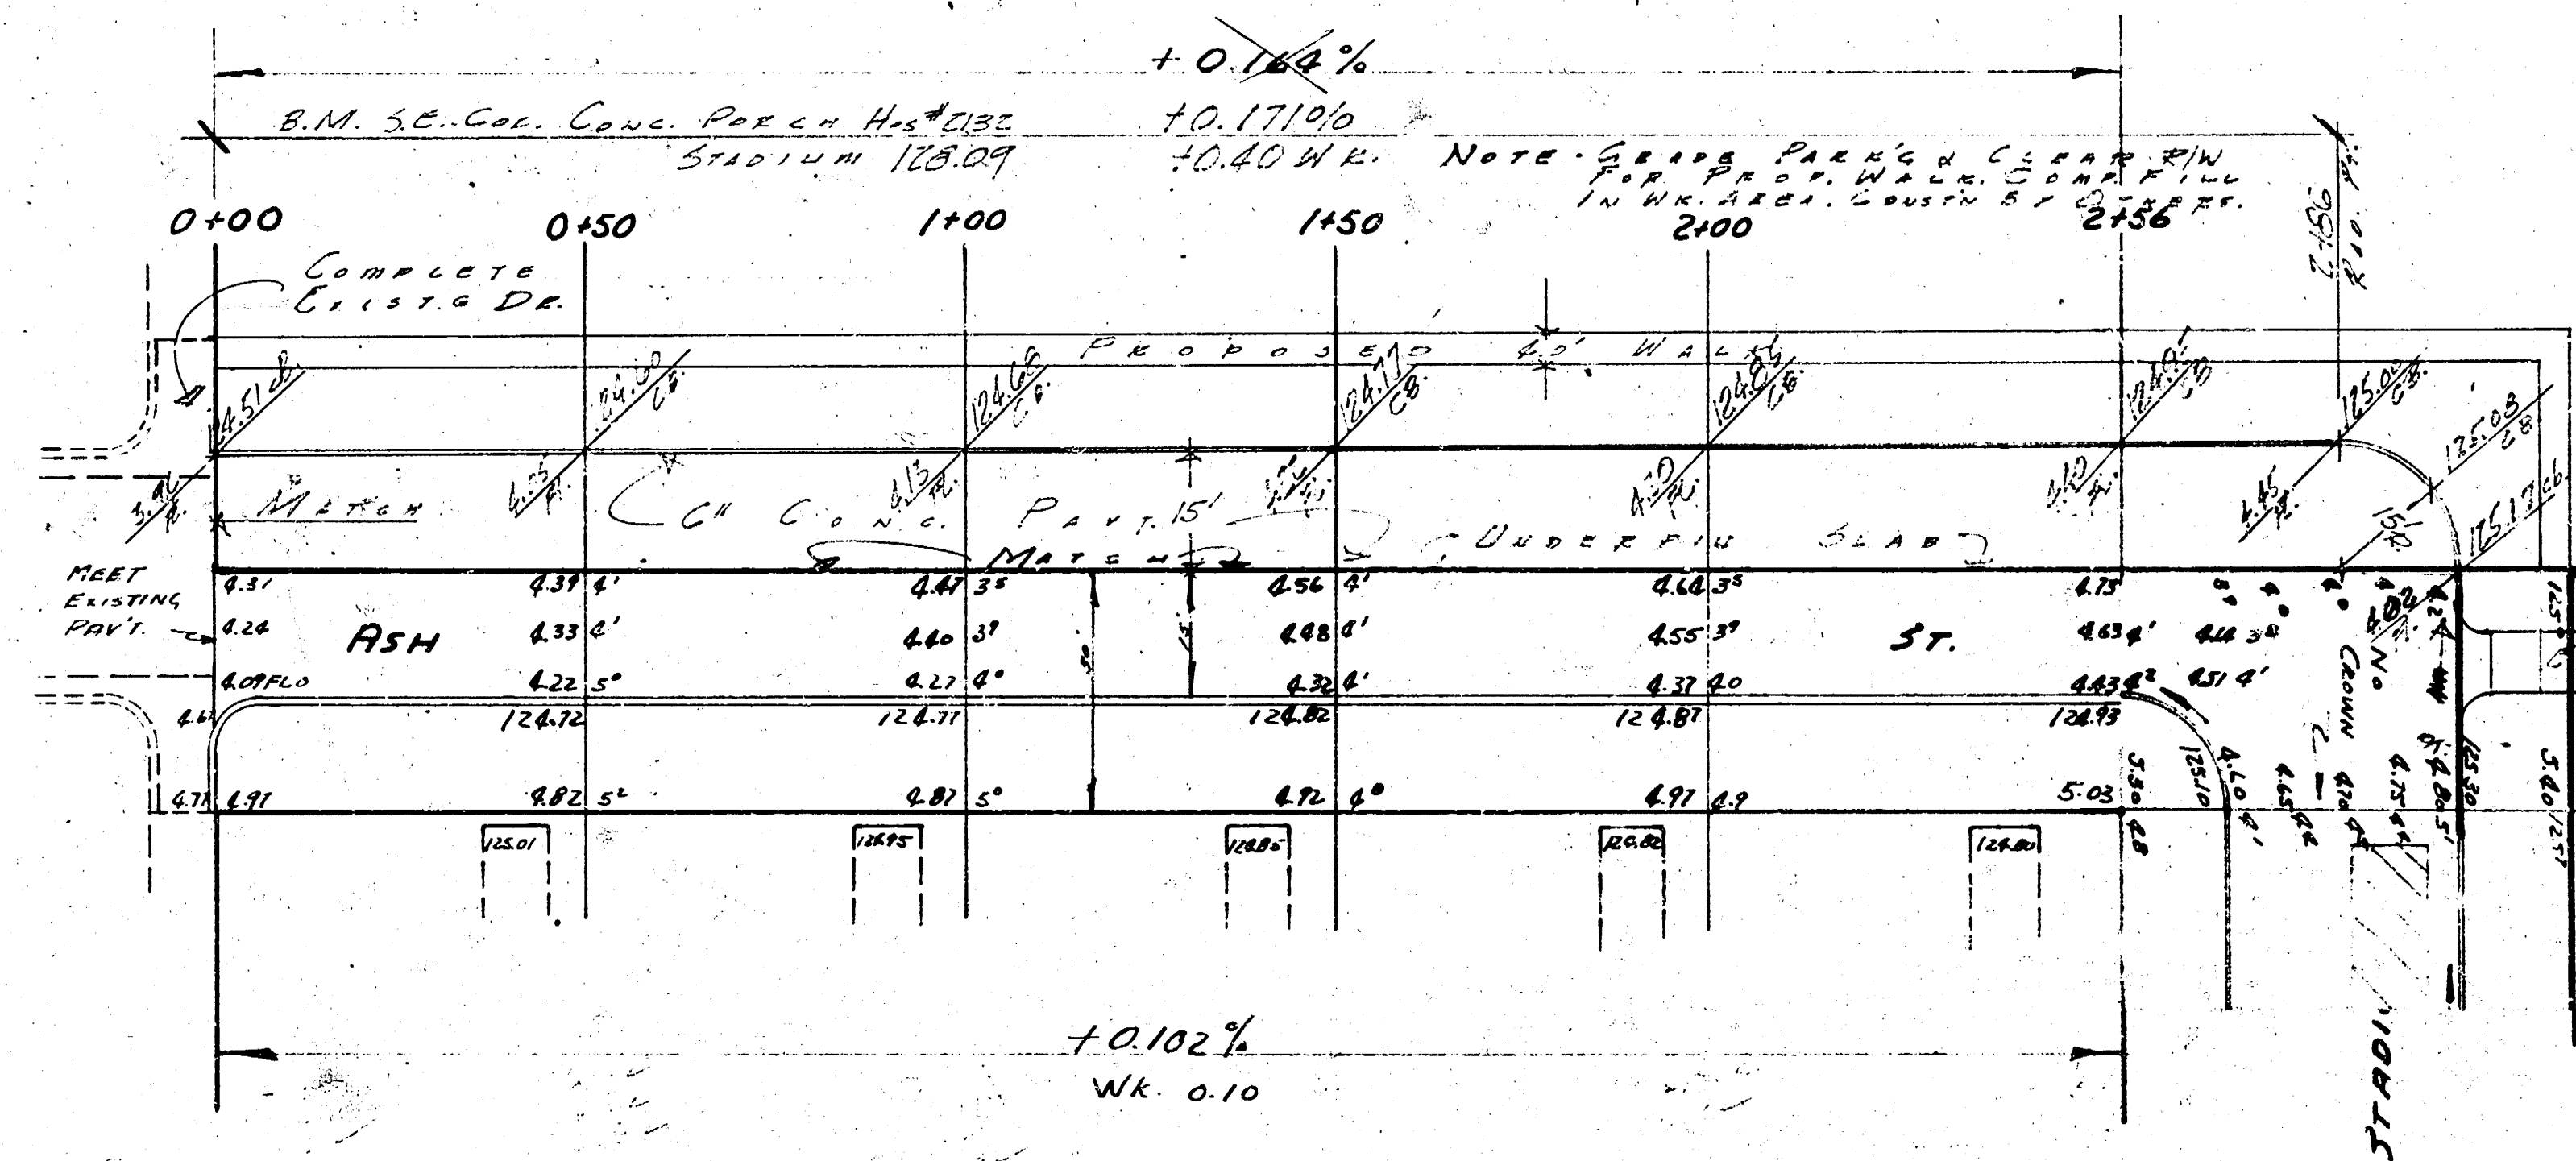

ASH E 1/2
SL. J. WALTER ROSS 2ND ADDN. TO NE STADION
15' CONC. & C.B.
CITY OF WICHITA, KANSAS
L.R. WHITE CITY ENGINEER
JUNE 1952 PROJ. NO. C16-112

