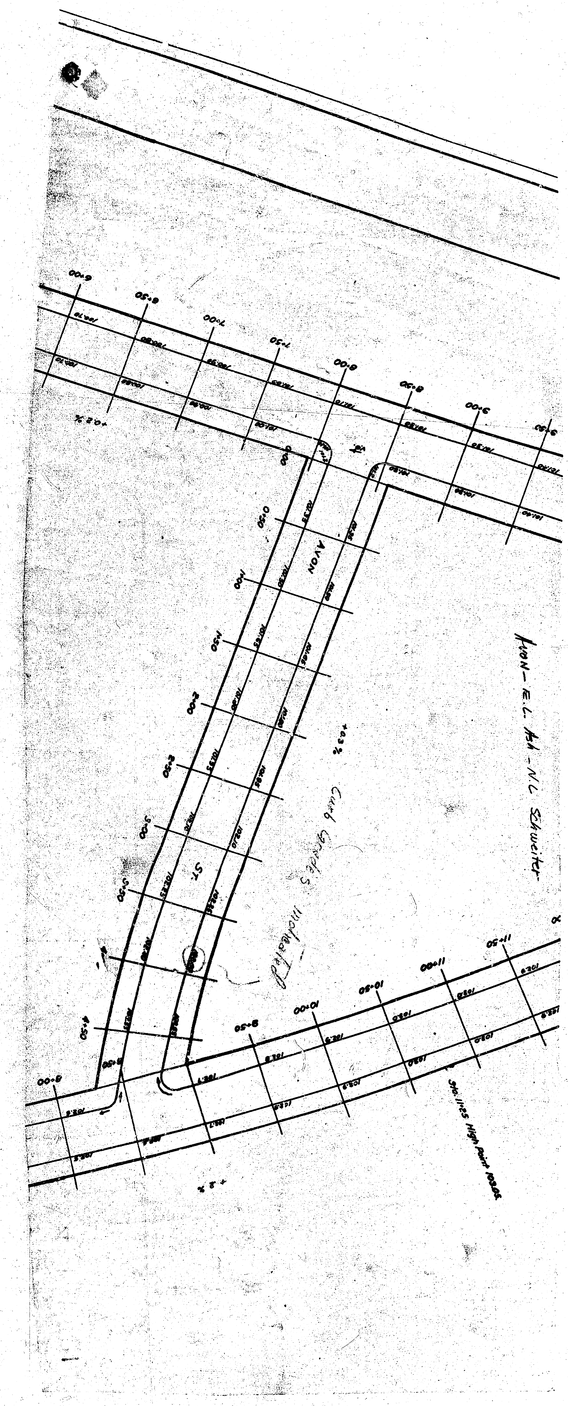
AVON
ST
