


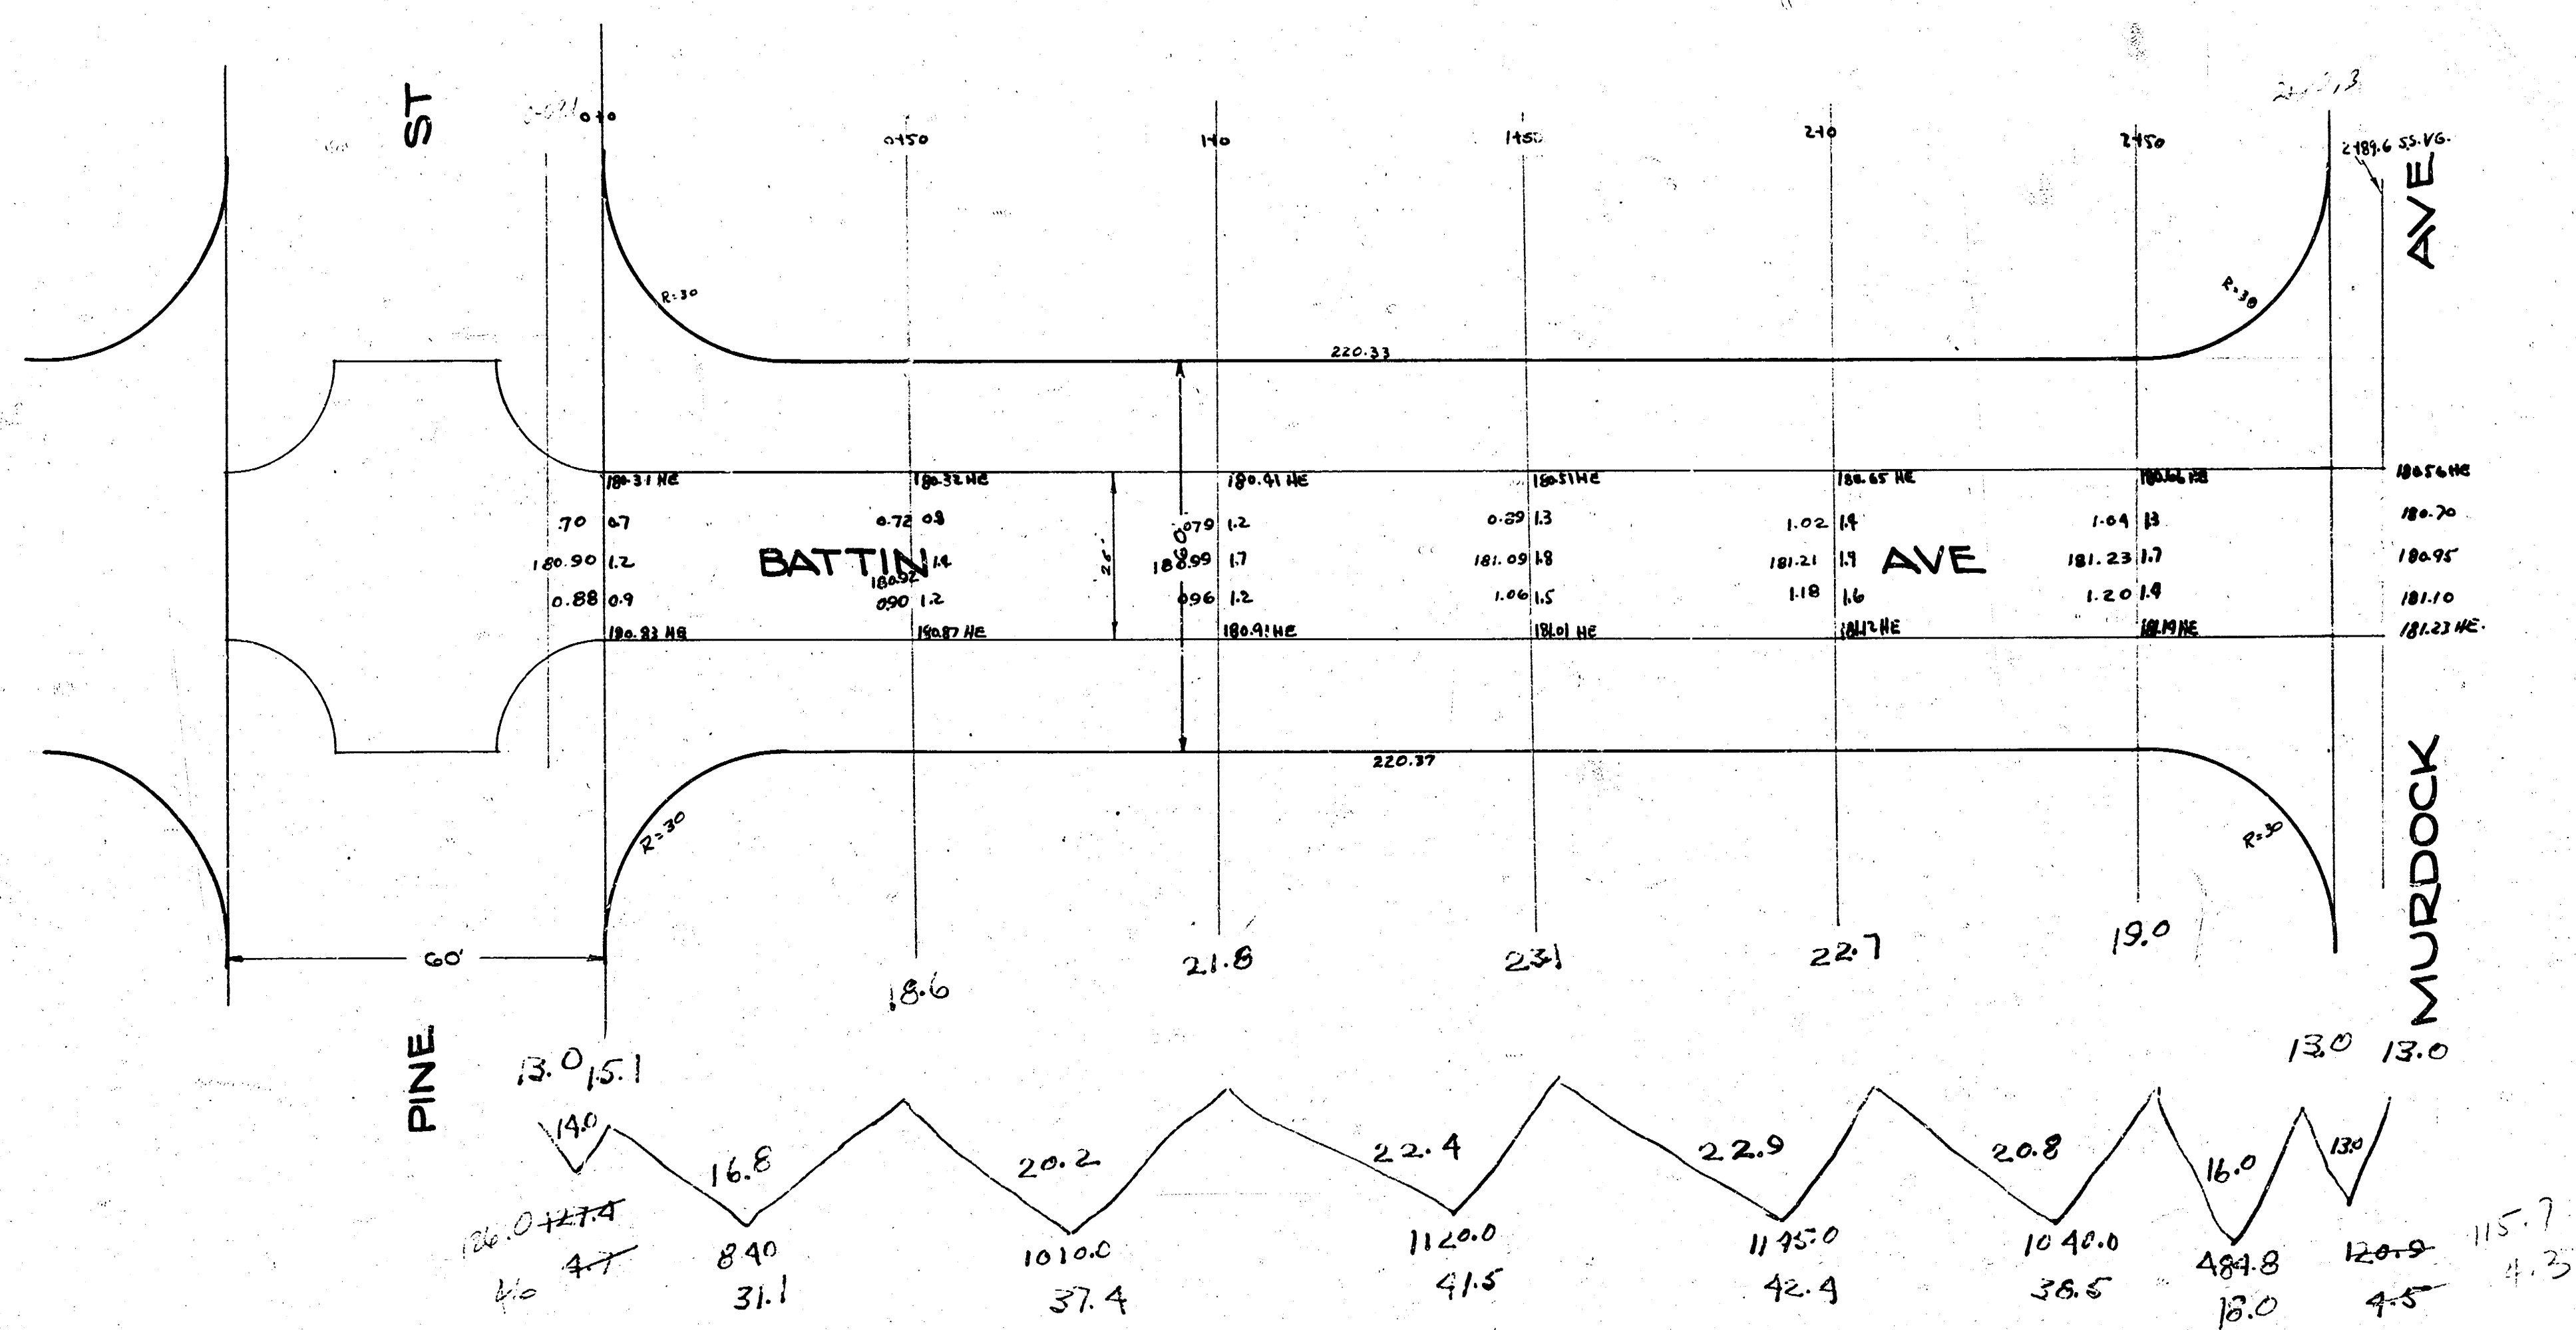

PLAN VIEW OF PROPOSED 26' CONC. ST. LANEWAY SUBGRADE



City	
4.7	
4.5	
Total 9.2	
+ 10.0 19.2	
19.2	
Property	
31.1	
37.4	
41.5	
42.4	
38.5	
18.0	
Total 208.9	
+ 10.0 218.9	
218.9	

BATTIN AVE.
S.L. PINE to S.L. MURDOCK
26' CONC.
CITY OF WICHITA, KANSAS
L.K. WHITE - CITY ENGINEER
APRIL 1947