
B.M. 105.08 Iron in thimble E Laura & Bayley
B.M. 105.98 "G" in Globe Top cb E.S. Lulu-N.S. Bayley

AVE.

AVE.


SCALE 1"=20'

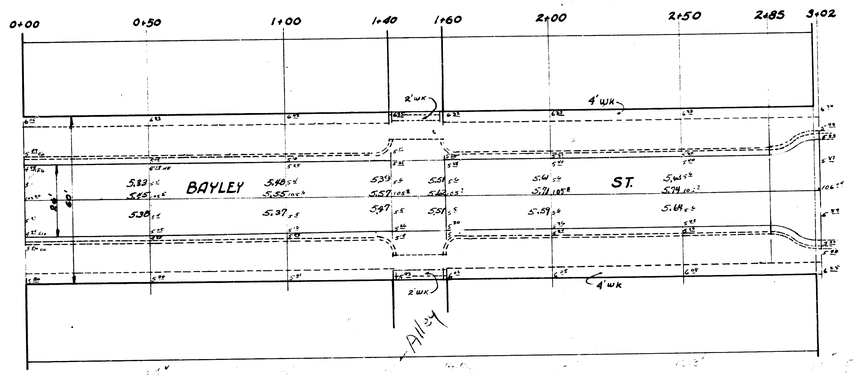

BAYLEY ST.
E. LAURA AVE. TO W. L. PATTIE AVE.
26' Conc.

CITY OF WICHITA, KANSAS.
L.K. WHITE CITY ENGINEER
OCT. 1951 PROJ. NO. C-11-152


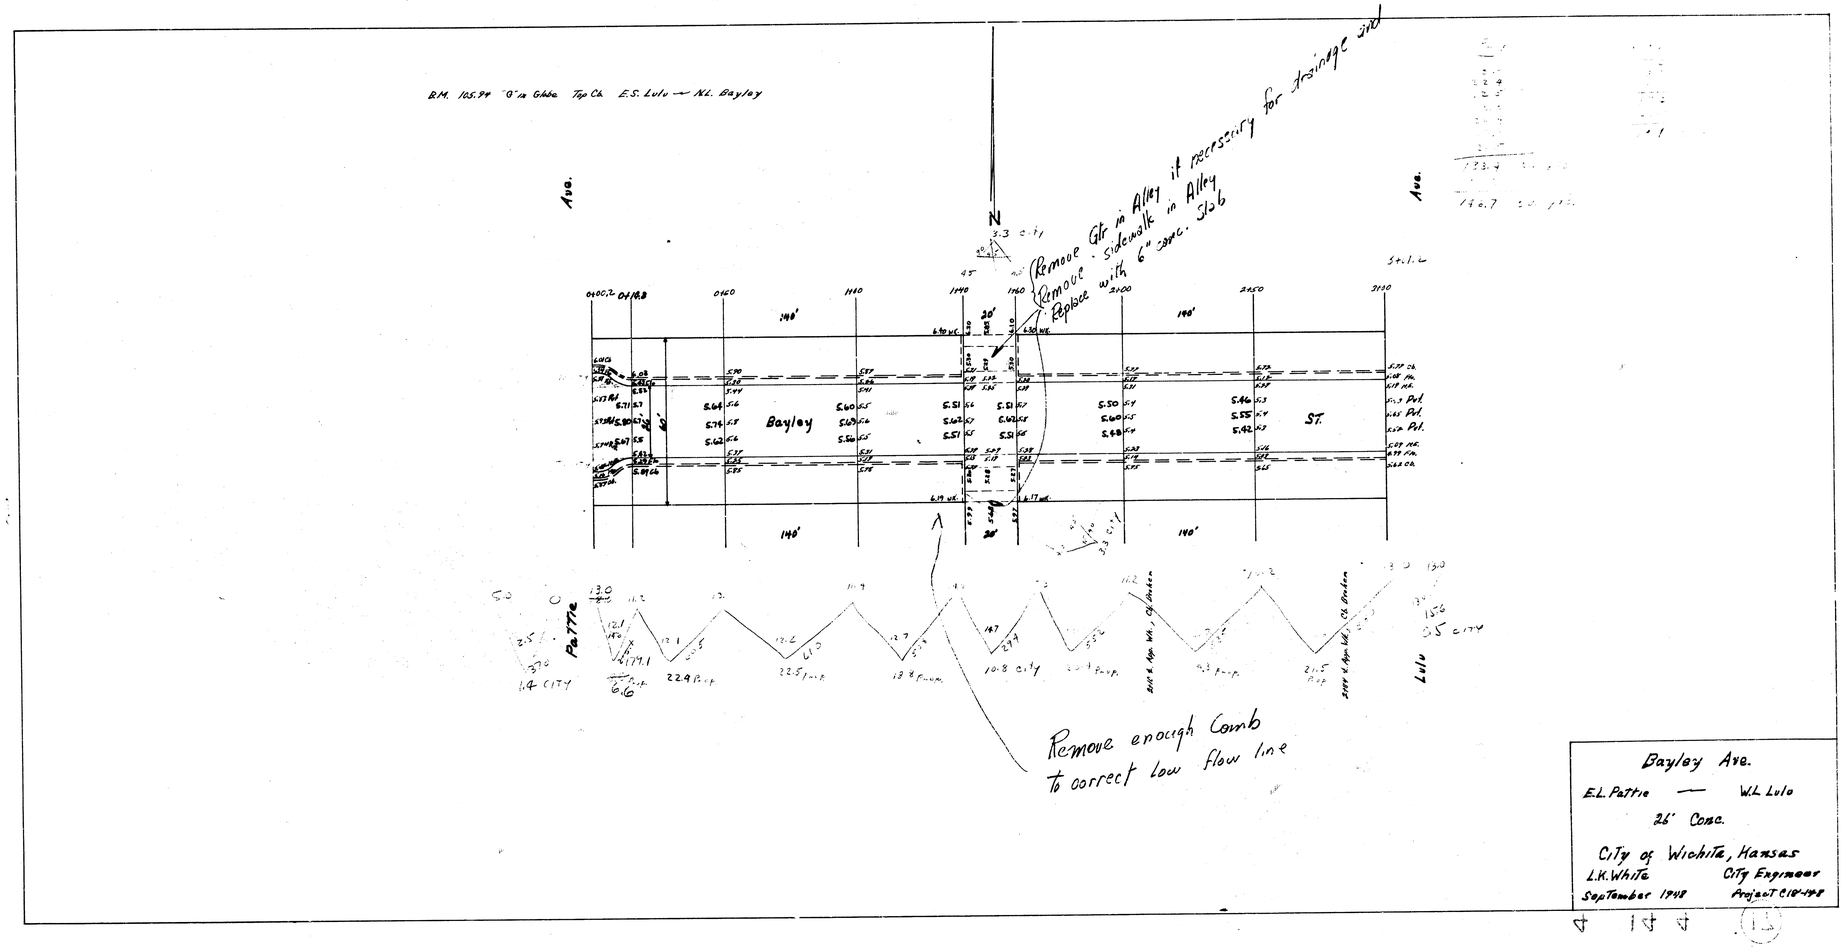

Bayley Ave.

E.L. Pattie — W.L. Lulu

26' Conc.

City of Wichita, Kansas

L.K. White City Engineer

September 1948 Project 618-48

14 21 (11)