* B.M. 102.76 Iron in thimble S.E. Cor. Lot 15 W.S. Minneapolis at Kansas.
B.M. 100.64 Iron in thimble N.E. Cor. Lot 15 W.S. Minnesota, S.L. Bayley.

* Note:
This iron was changed when iron was thimbled, Use this B.M. for no other work.

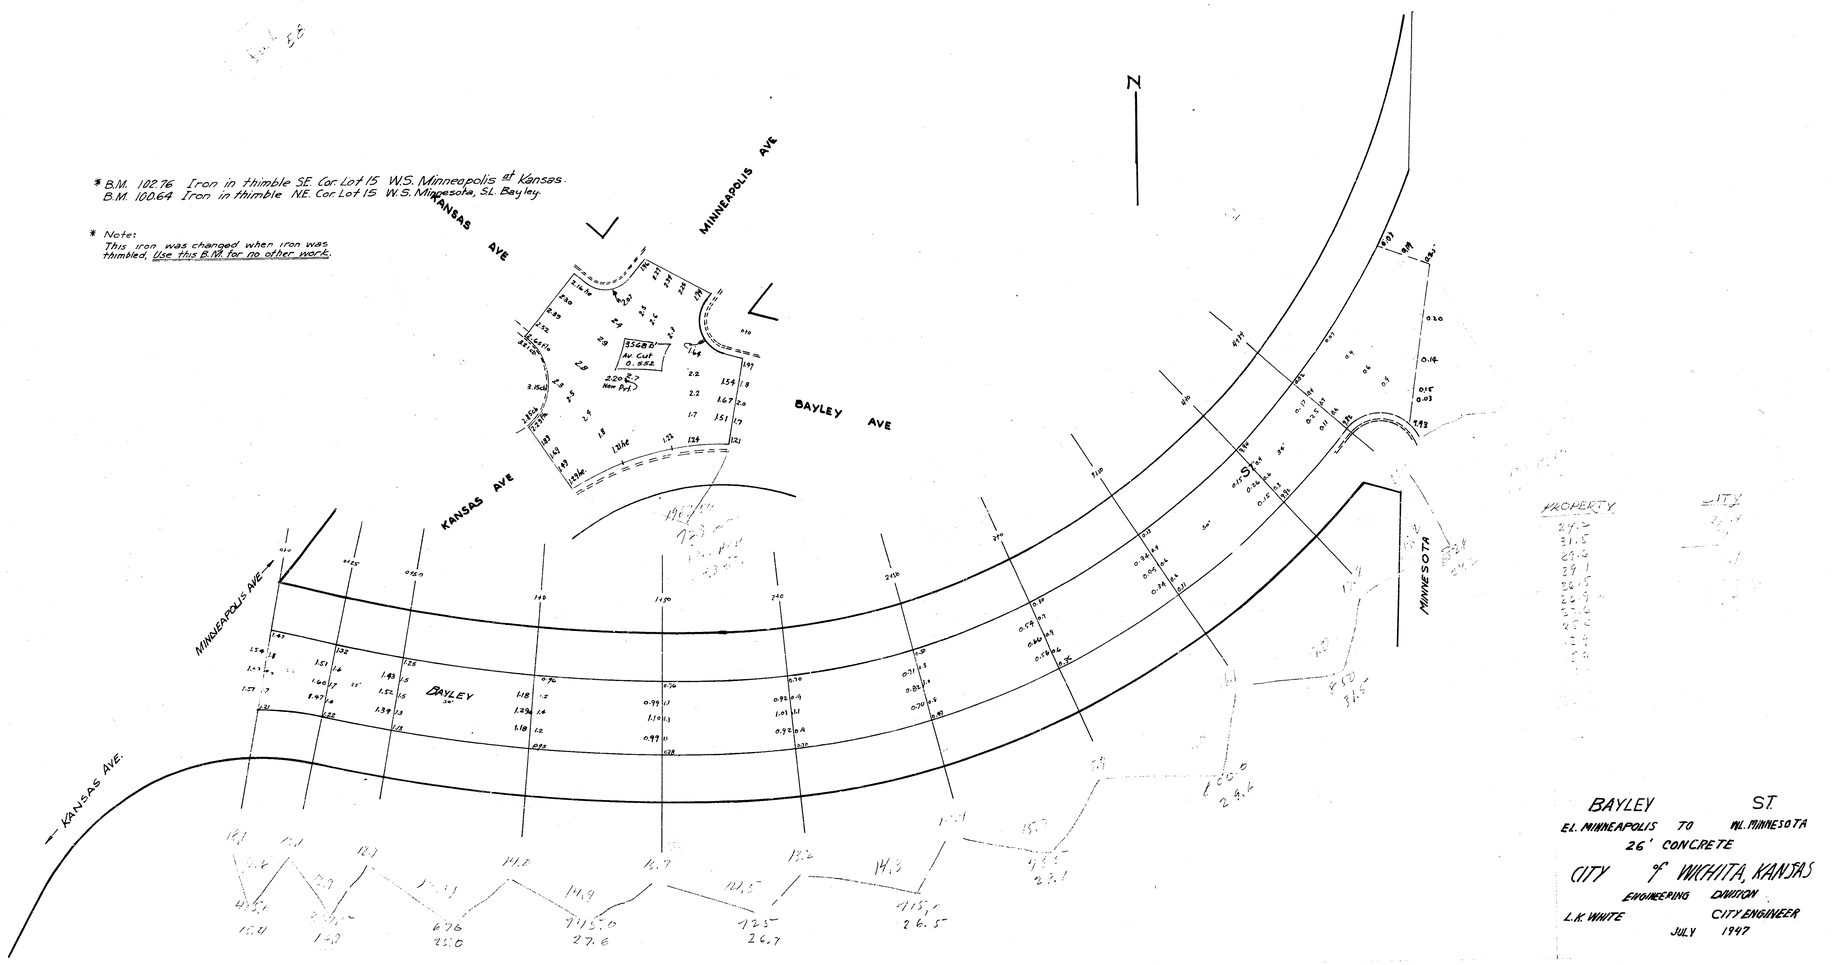


BAYLEY ST.
EL. MINNEAPOLIS TO WL. MINNESOTA
26' CONCRETE
CITY OF WICHITA, KANSAS
ENGINEERING DIVISION
L.K. WHITE CITY ENGINEER

Book 55

* B.M. 102.76 Iron in thimble S.E. Cor. Lot 15 W.S. Minneapolis at Kansas.
B.M. 100.64 Iron in thimble N.E. Cor. Lot 15 W.S. Minnesota, St. Bayley

* Note:
This iron was changed when iron was thimbled. Use this B.M. for no other work.

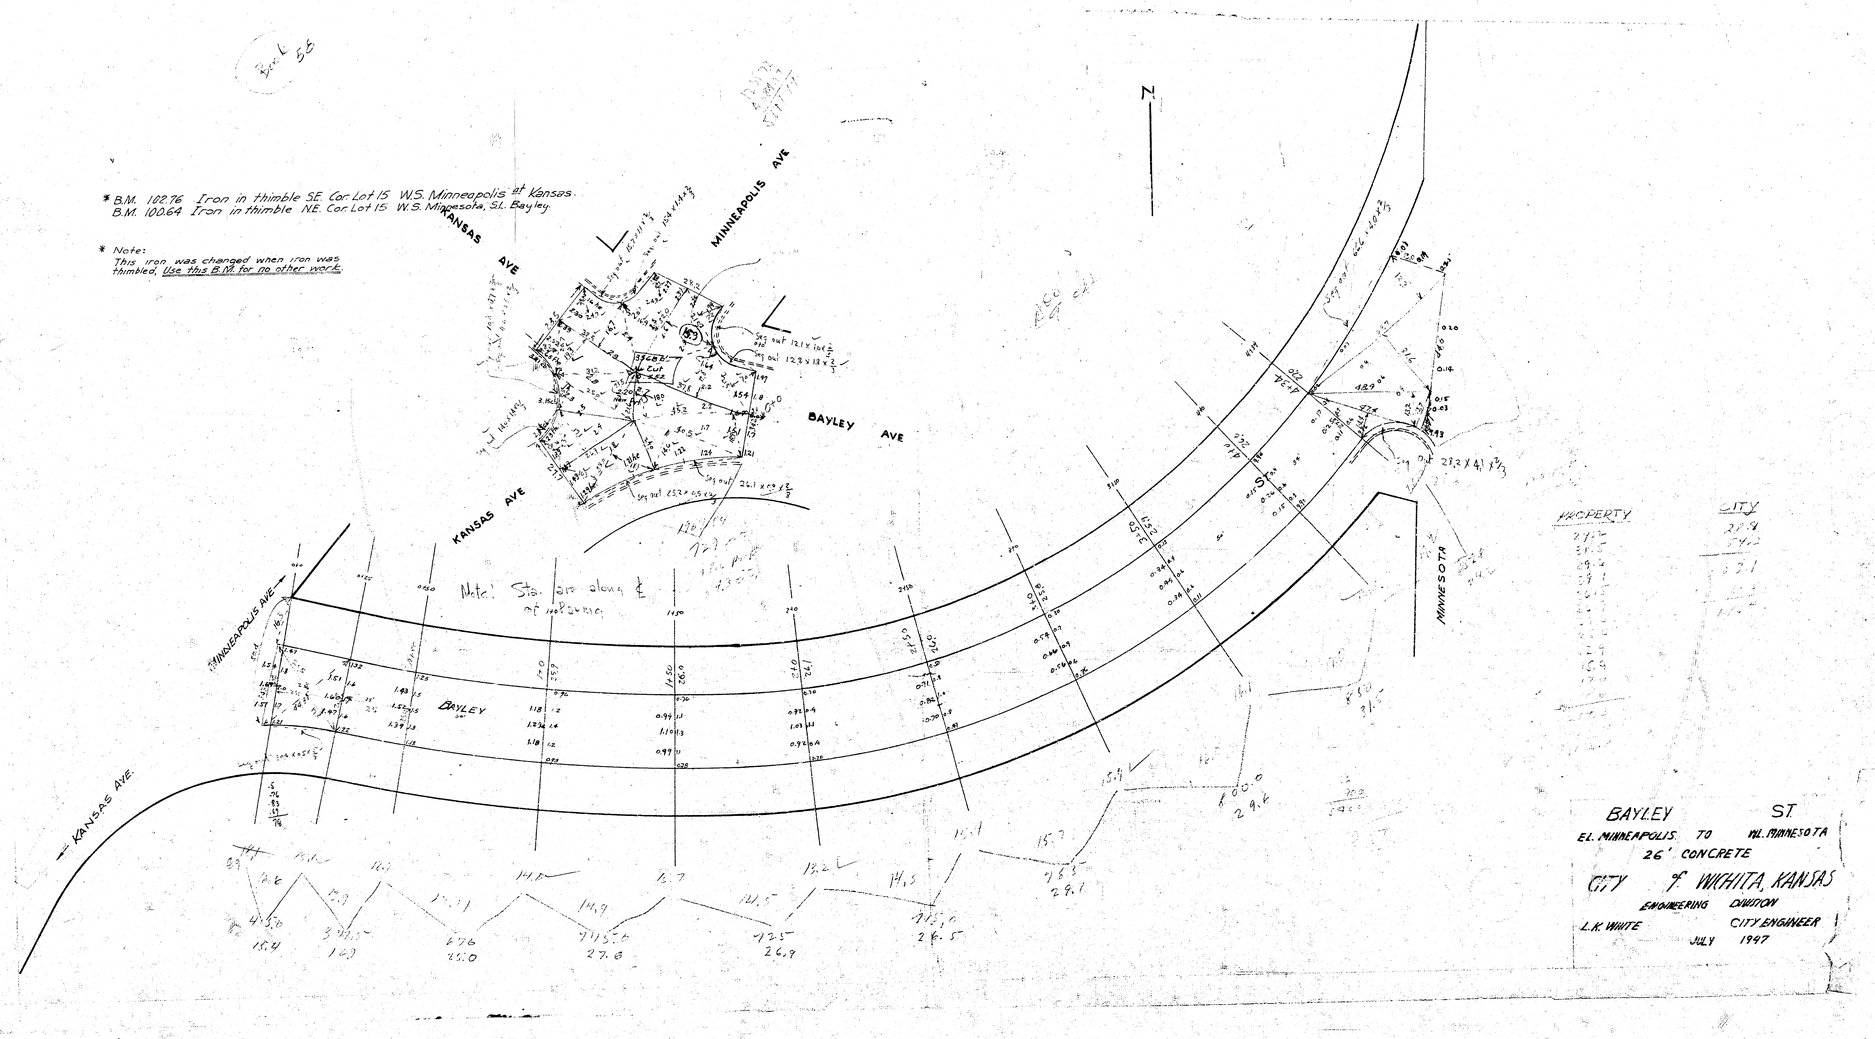

MINNESOTA
AVE
ST
BAYLEY
MINNEAPOLIS
KANSAS
AVE
BM. Elev.
C+G only