
49 Y

B.M. 153.00 S.W. Cor. Conc. Porch Ho. # 858 So. Dravola

NOTE: STATIONING IS ON S.P.L.

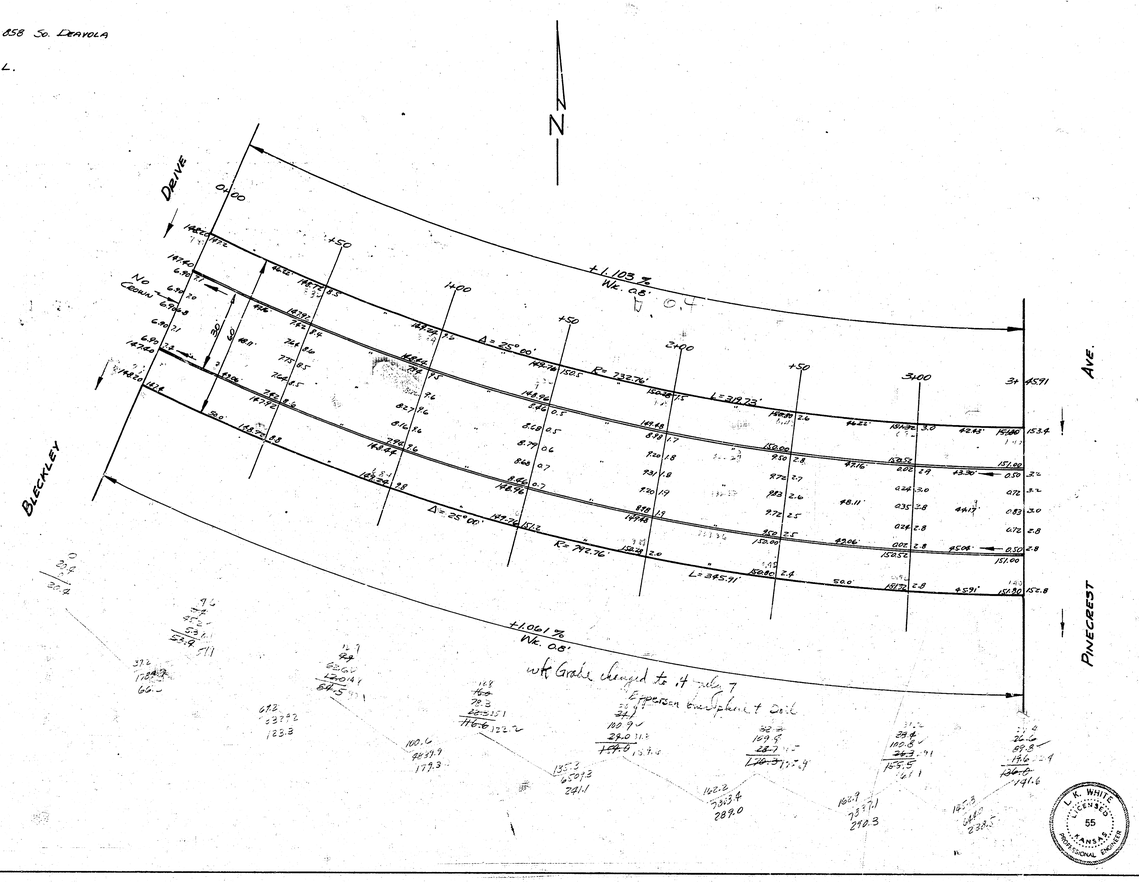


BAYLEY ST.
W.L. PINECREST TO E.L. BLECKLEY
30' CONC. & CB.
CITY OF WICHITA, KANSAS
L. K. WHITE CITY ENGINEER
SEPT. 1951 PROJ. C11-54

L. K. WHITE LICENSED 55 KANSAS PROFESSIONAL ENGINEER

B V 12 1 53