


B.M. 154.05 R in Ritchie E. Curb San Pablo N.E. Bayley
 B.M. 152.67 R in Ritchie E. Curb San Pablo S.E. Lincoln


Stationing on N.E.

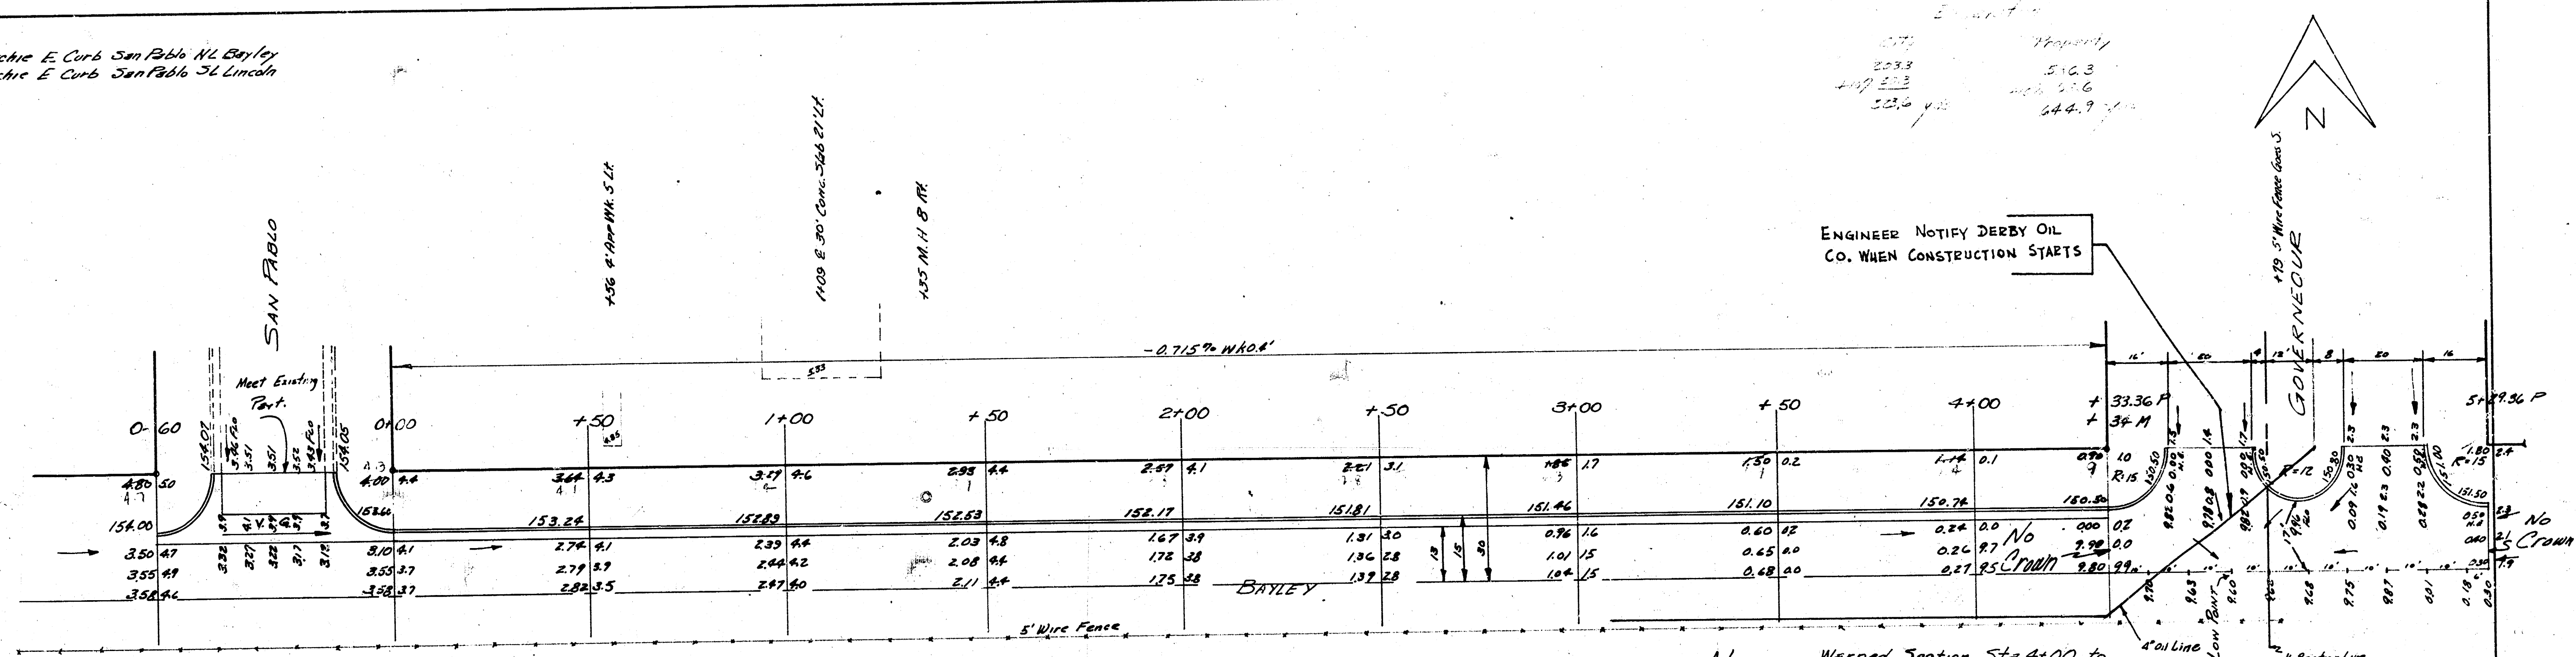

NOTE: Warped Section Sta 4+00 to 5+23.36 Use elevations shown. Drainage is to the south.

INTERSECTION TO BE 6" CONCRETE WITH INTERNAL CURB.

Surveyed by
 Plan 4-2
 Checked 27

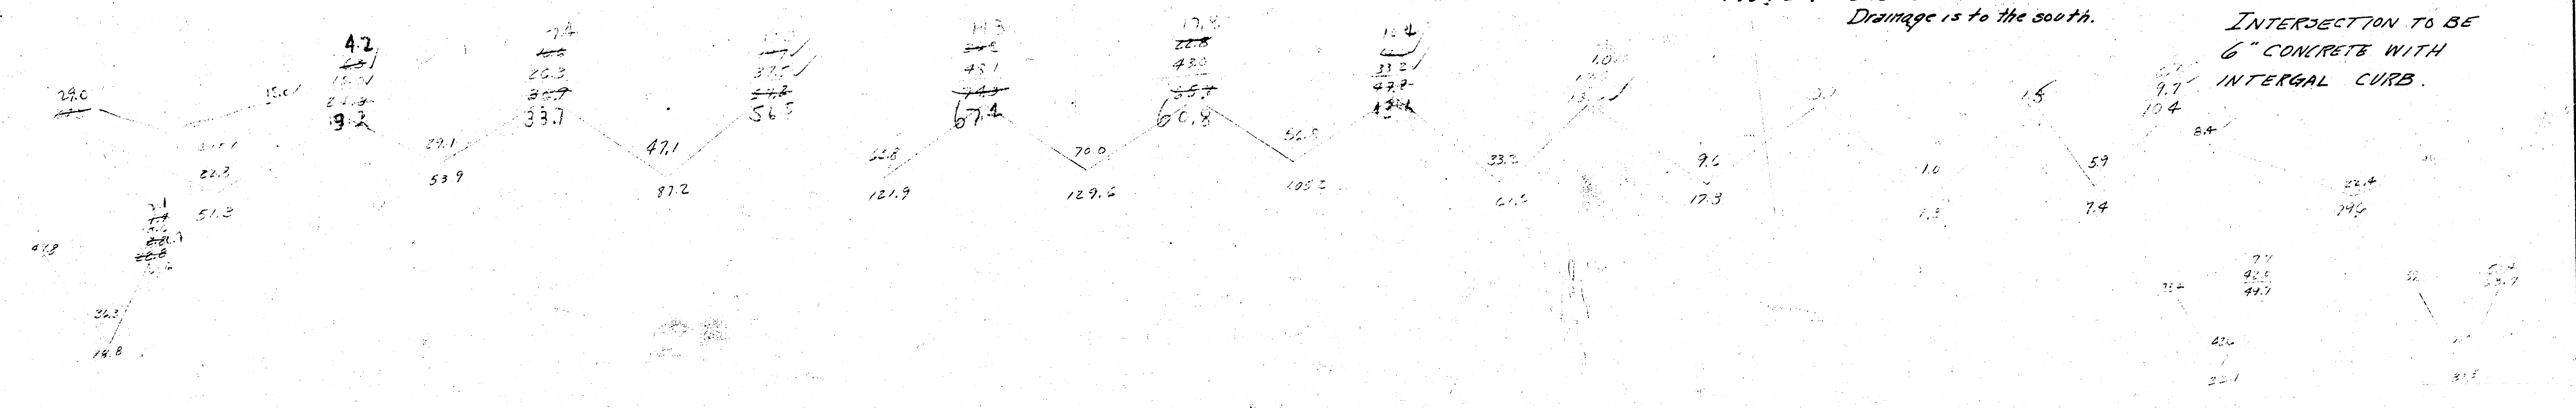

BAYLEY, N.E.
 W.L. SAN PABLO TO EL GOVERNADOR
 13-2-15 A.C.
 CITY OF WICHITA, KANS.
 B. SMITH CITY ENGINEER
 MAY 1954 PROJ. C14-43

