
B.M. 155.31 "R" in Ritchie El. Capri S. Cb. Bayley

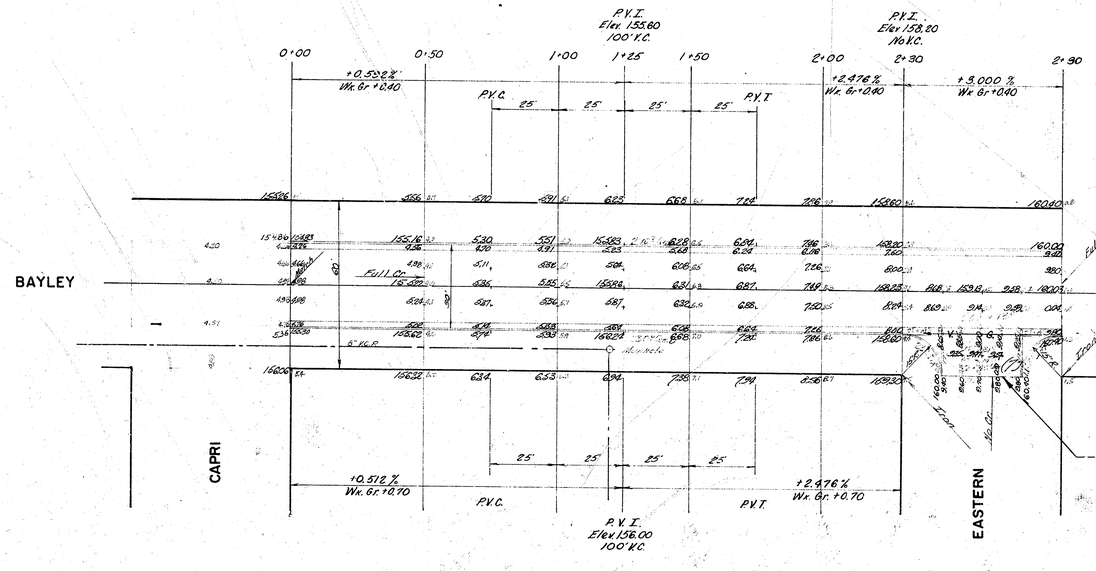

Private Job

Units	Quantities	Totals
S.Y.	Pavement	785
L.F.	Comb. Cb & Gtr.	520
Lbs.	Reinf. Steel	2185
C.Y.	Excavation	320
C.Y.	Comp. Fill	1.5

Final Quantities

Units	Quantities	Totals
S.Y.	Pavement	751.4
L.F.	Comb. Cb. & Gtr.	520.2
Lbs.	Reinf. Steel	2035
C.Y.	Excav.	320.4
C.Y.	Comp. Fill	10.8

INTERSECTION BAYLEY & EASTERN A. C. CITY OF WICHITA, KANSAS B.E.SMITH CITY ENGINEER DATE PROJ. C14-8	BAYLEY ST. E.L. CAPRI TO E.L. EASTERN 26'-2'-30' A. C. CITY OF WICHITA, KANSAS B.E.SMITH CITY ENGINEER DATE APRIL 1954 PRIVATE JOB