


17/10/10 (3-1)

FLOOR PLAN OF CITY HALL
WICHITA, KANSAS
SOUTH HALF OF THIRD FLOOR
CITY ENGINEER'S OFFICE DEC. 7, 1917
SCALE 1/4" = 1'-0"

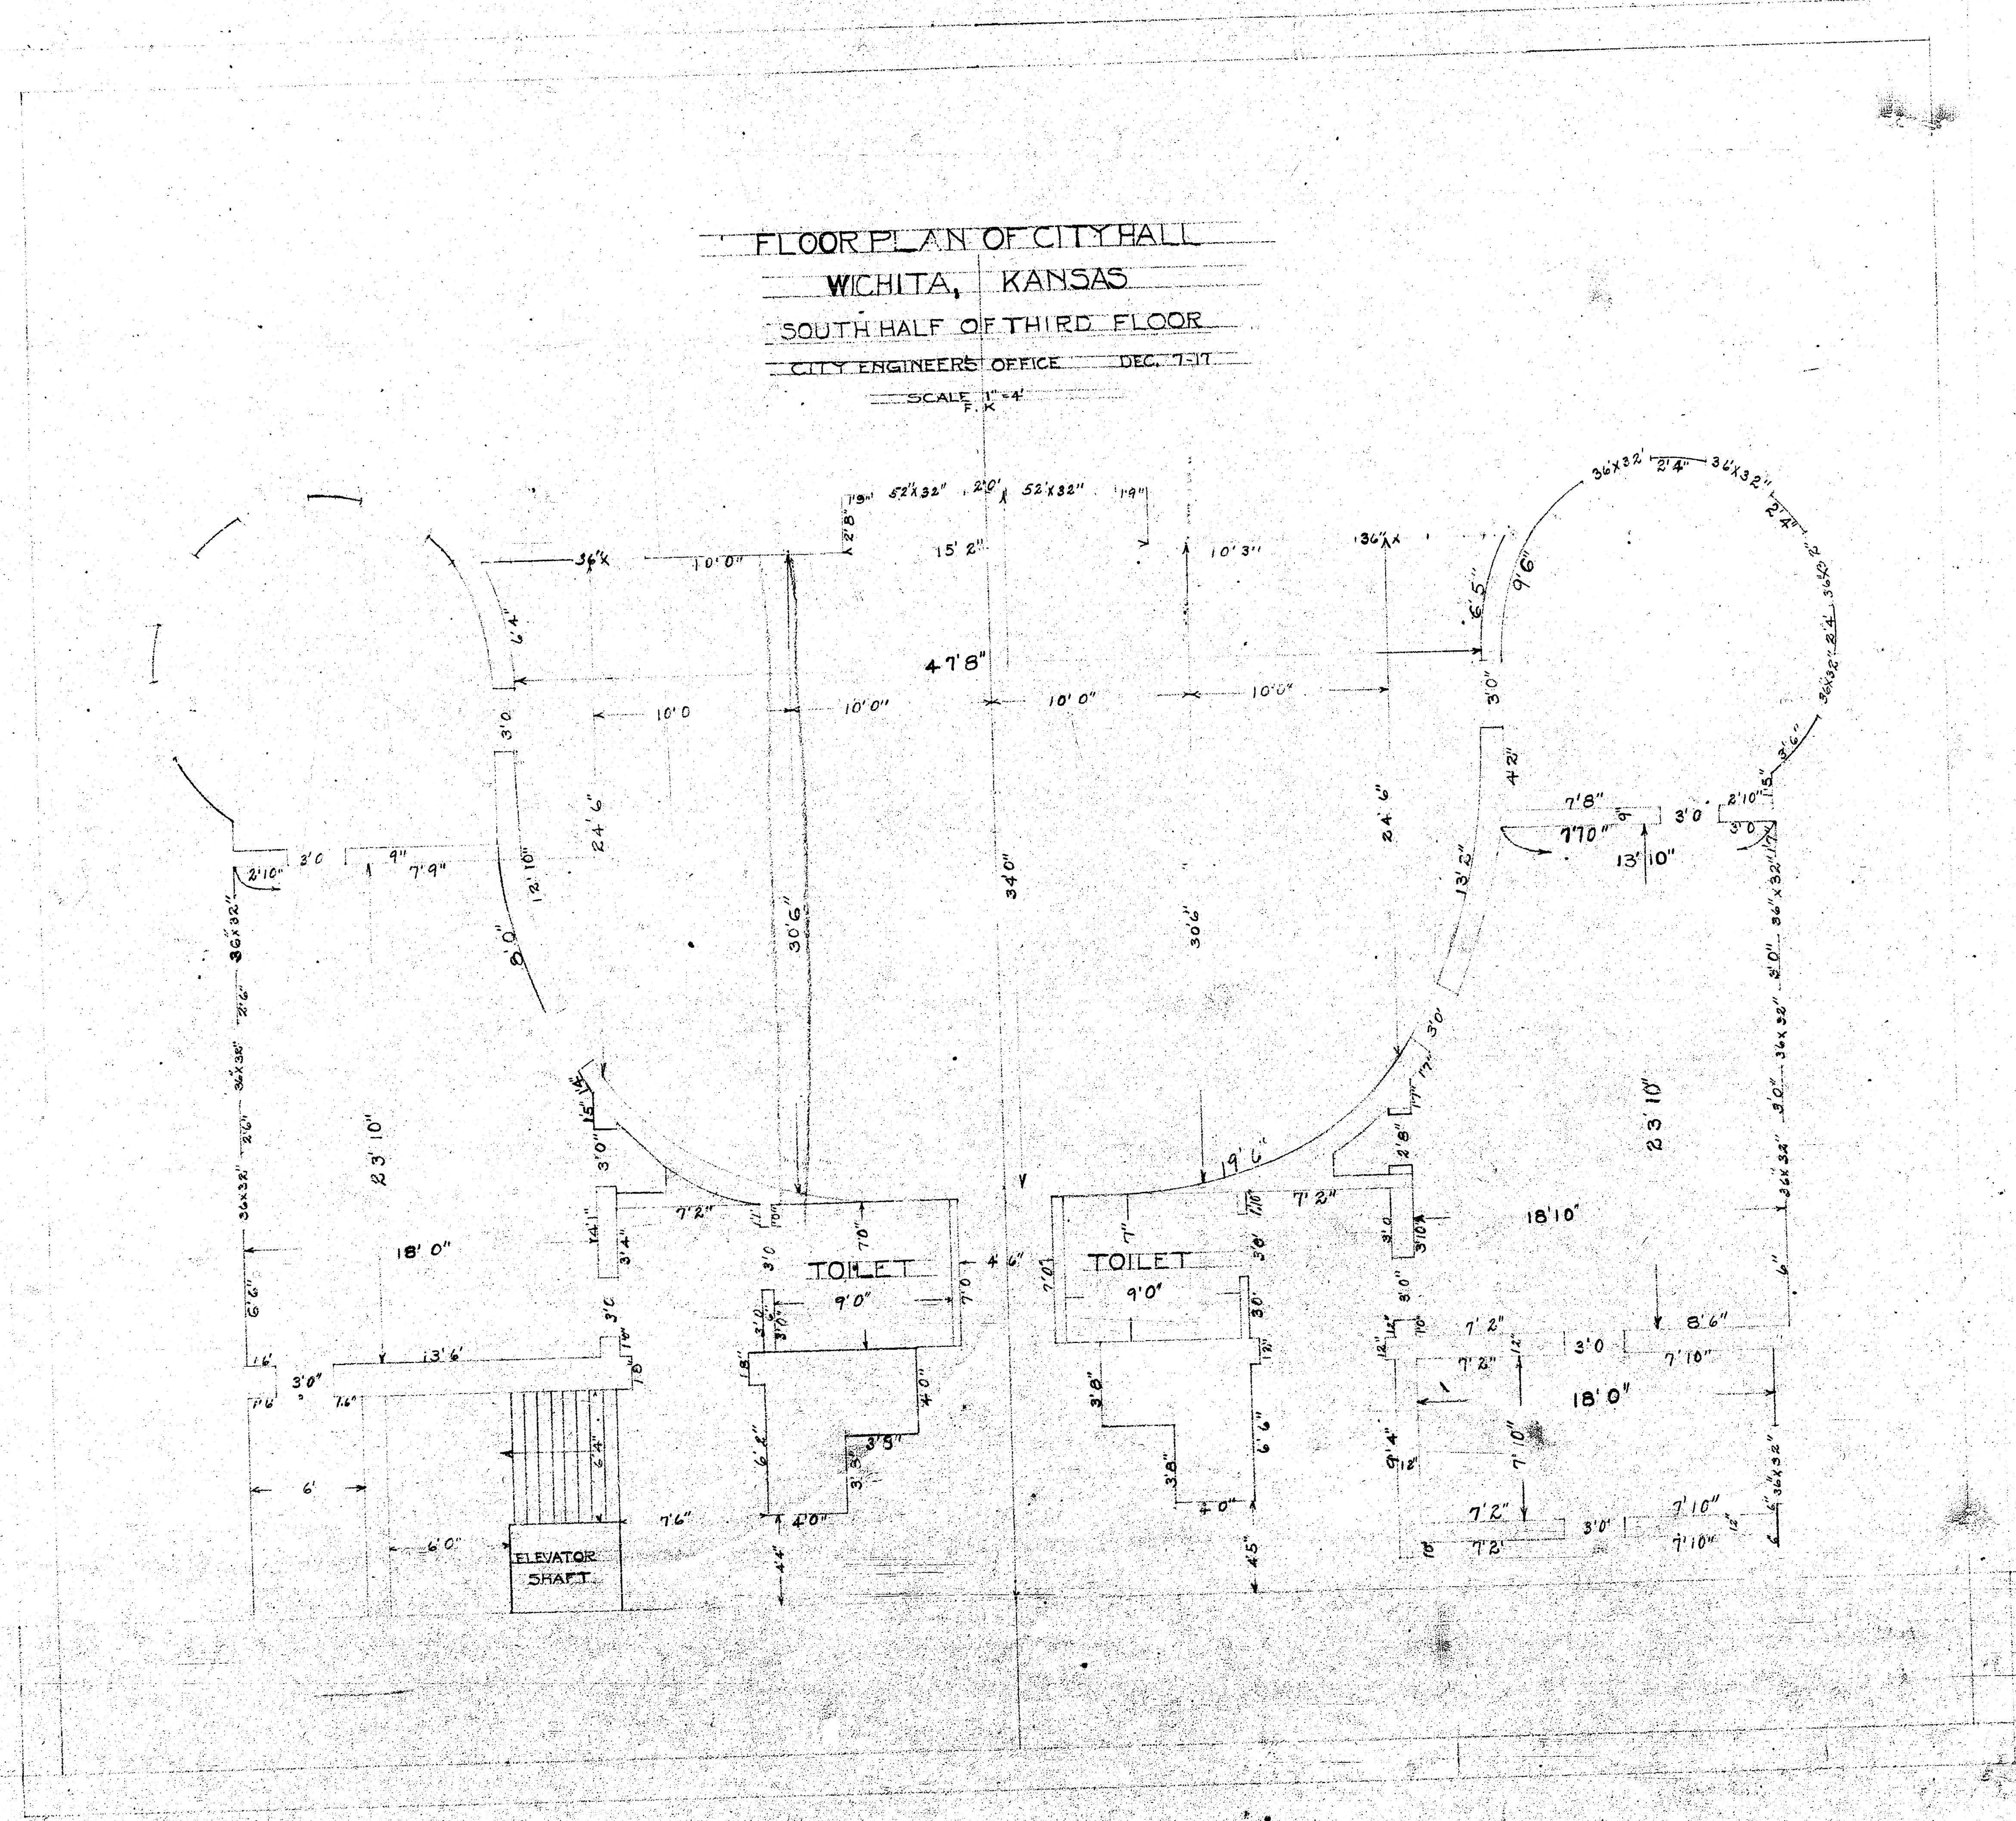

FLOOR PLAN OF CITY HALL
WICHITA, KANSAS
SOUTH HALF OF FOURTH FLOOR
CITY ENGINEER'S OFFICE DEC 10-17
SCALE 1"=4' F.K.

The floor plan shows a large rectangular area with a central corridor and several rooms. The dimensions of the rooms and corridors are given in feet and inches. The plan is titled "FLOOR PLAN OF CITY HALL" and "WICHITA, KANSAS". It is dated "CITY ENGINEER'S OFFICE DEC 10-17" and has a scale of "1"=4' F.K."

SOUTH HALF OF SECOND FLOOR
CITY ENGINEERS OFFICE DEC 8-7
SCALE 1"=4'
FK

