

KOCH BUILDING

DOUGLAS AVENUE

PROPERTY LINE

check elevations

? part of Douglas prop?

FOUNTAIN DET. VNF.

TERRACE

TERRACE RAMP (4.11)

MANHOLE DET. RES.

PLANTER

RAMP

SIDEWALK

MICHIGAN PACIFIC RAILROAD RIGHT OF WAY

AREA DRAIN DET. RES.

AREA DRAIN DET. RES.

AREA DRAIN DET. RES.

SIDEWALK


MATCH LINE

MATCH LINE

CIVIC CULTURAL CENTER
CITY OF WICHITA, KANSAS

PLAN # 1

COPIES BY OTHER PERSONS

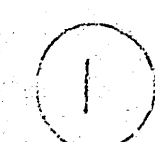


THE

BY STERNER IN
LAMP. TO BE GE

PROGRESS PRINT

0 1 2 3 4 5 6 7 8 9

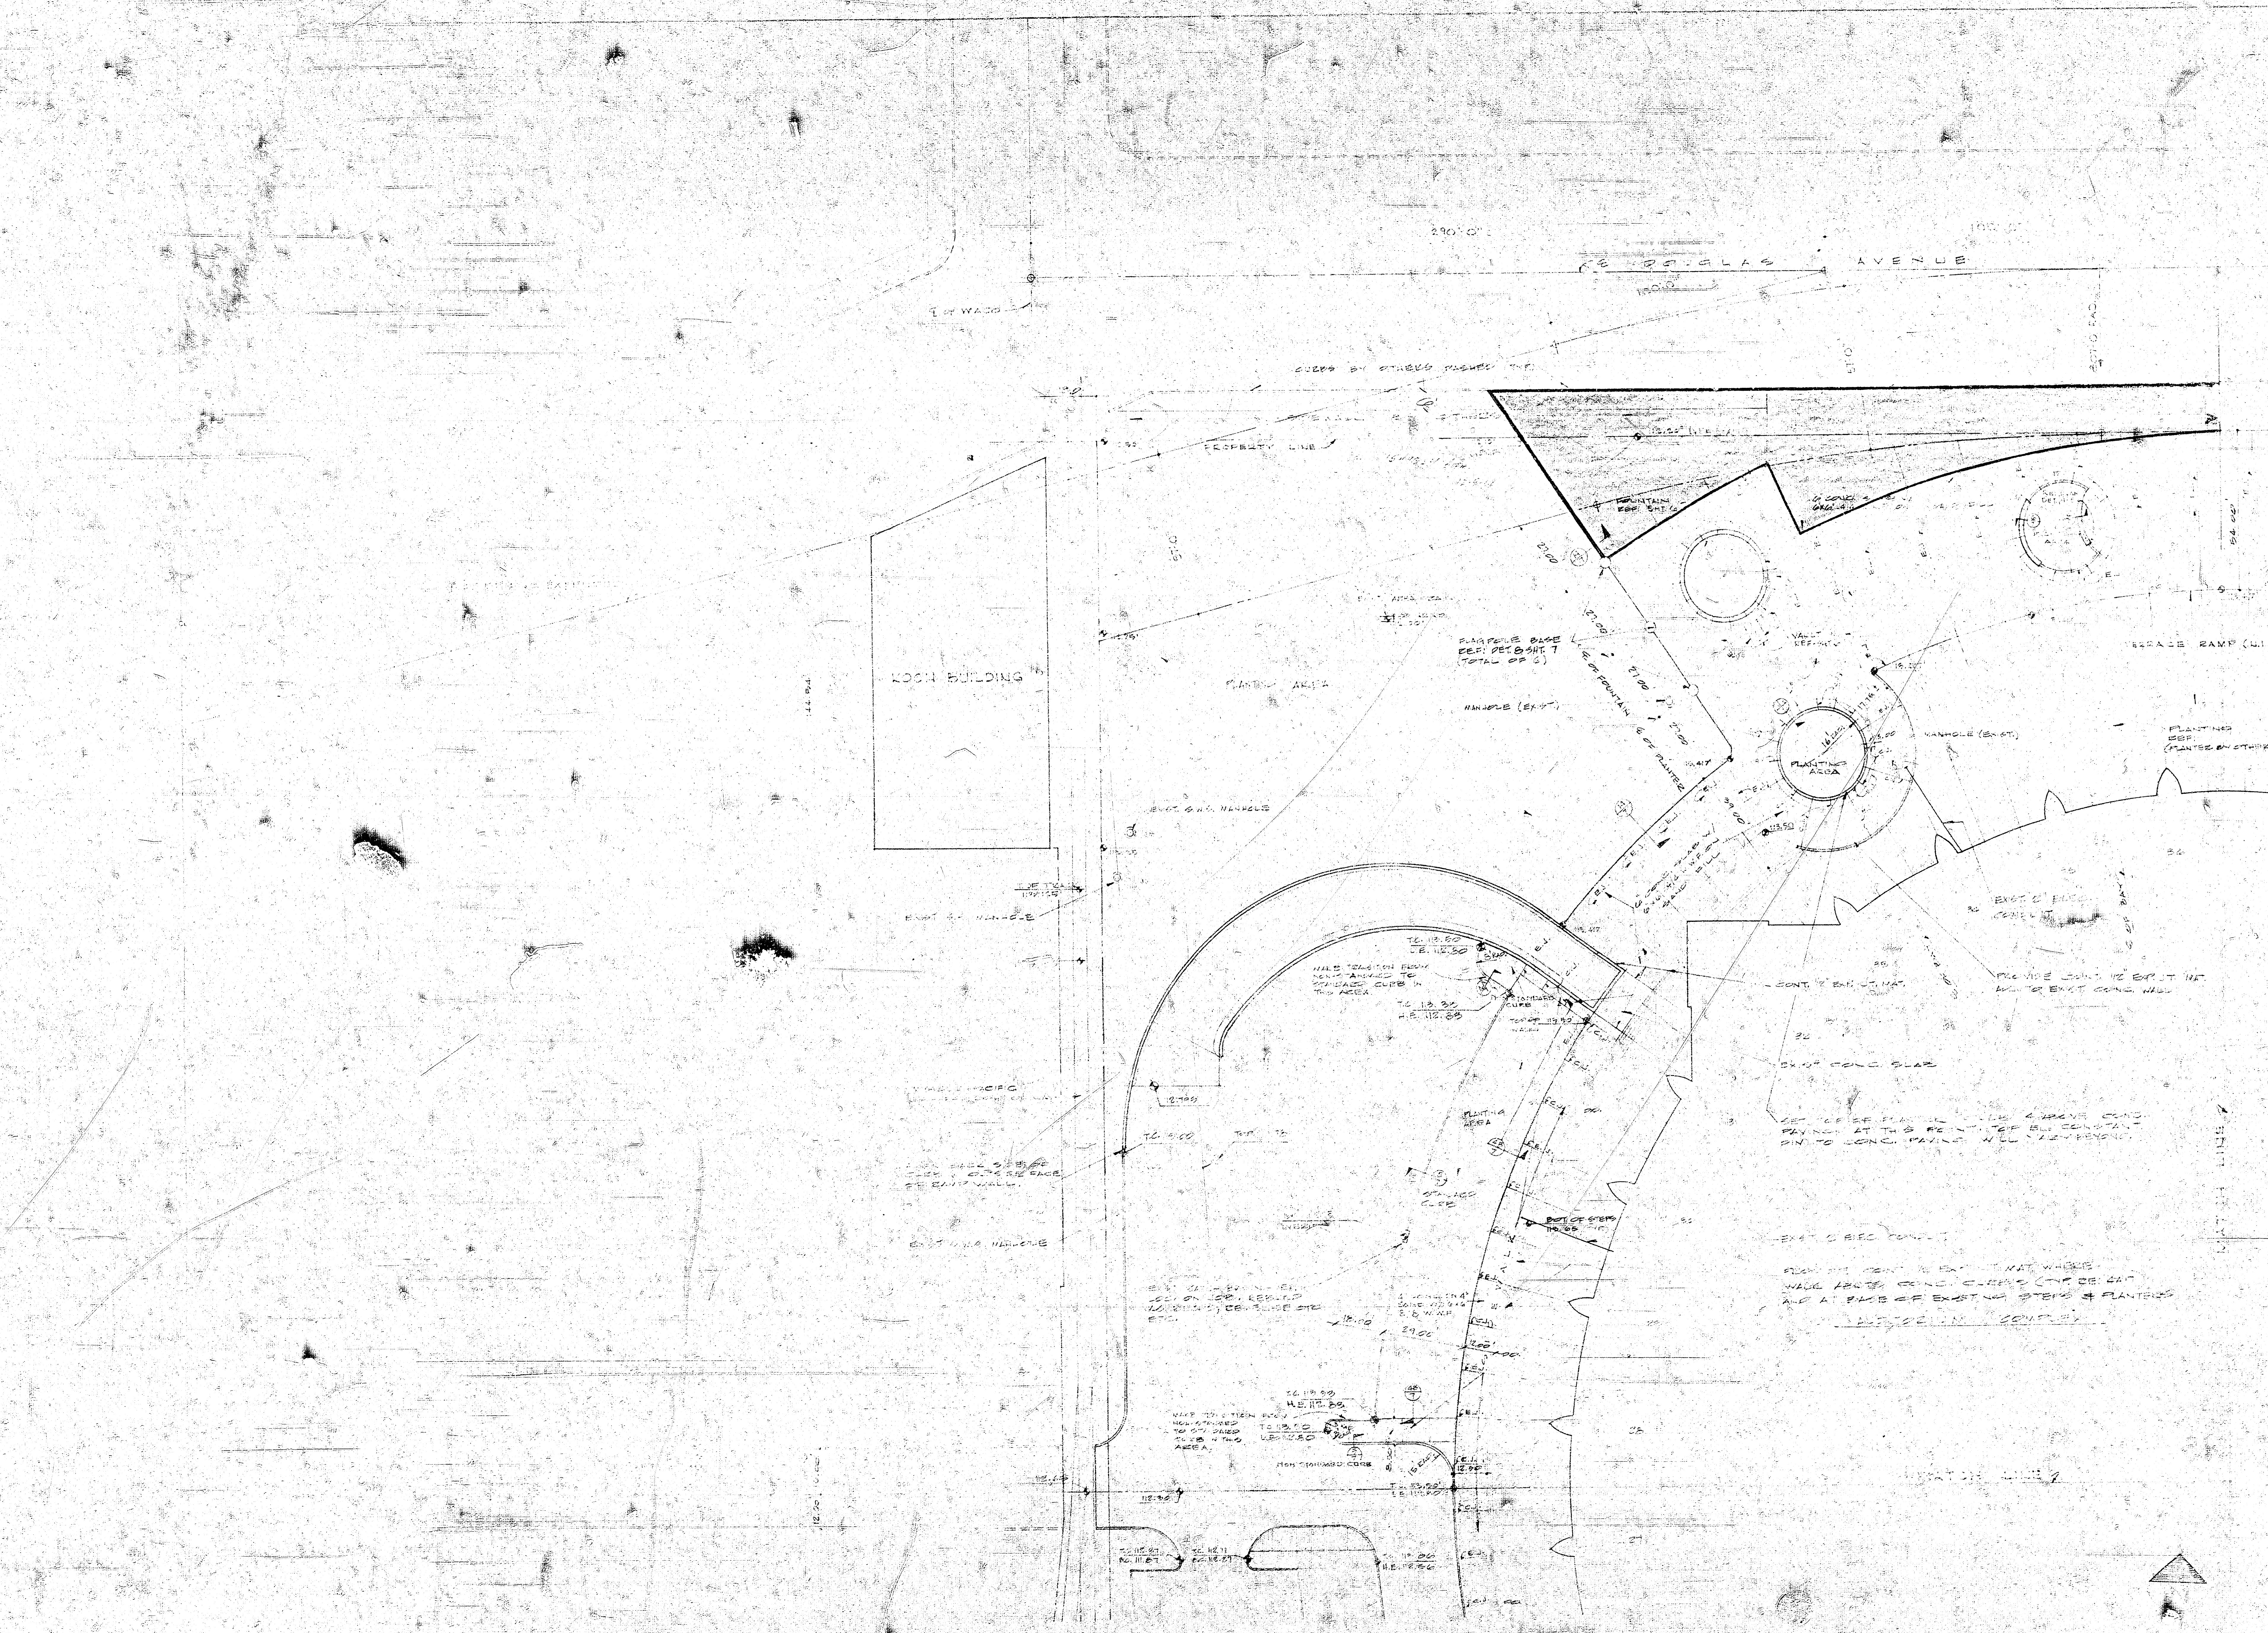

PARTIAL SITE DEVELOPMENT PLAN

1" = 20'-0"

PROCESS PLAN

CIVIC CULTURAL CENTER
CITY OF WICHITA, KANSAS

DATE	10-10-63
BY	RJ
CHECKED	
APPROVED	