


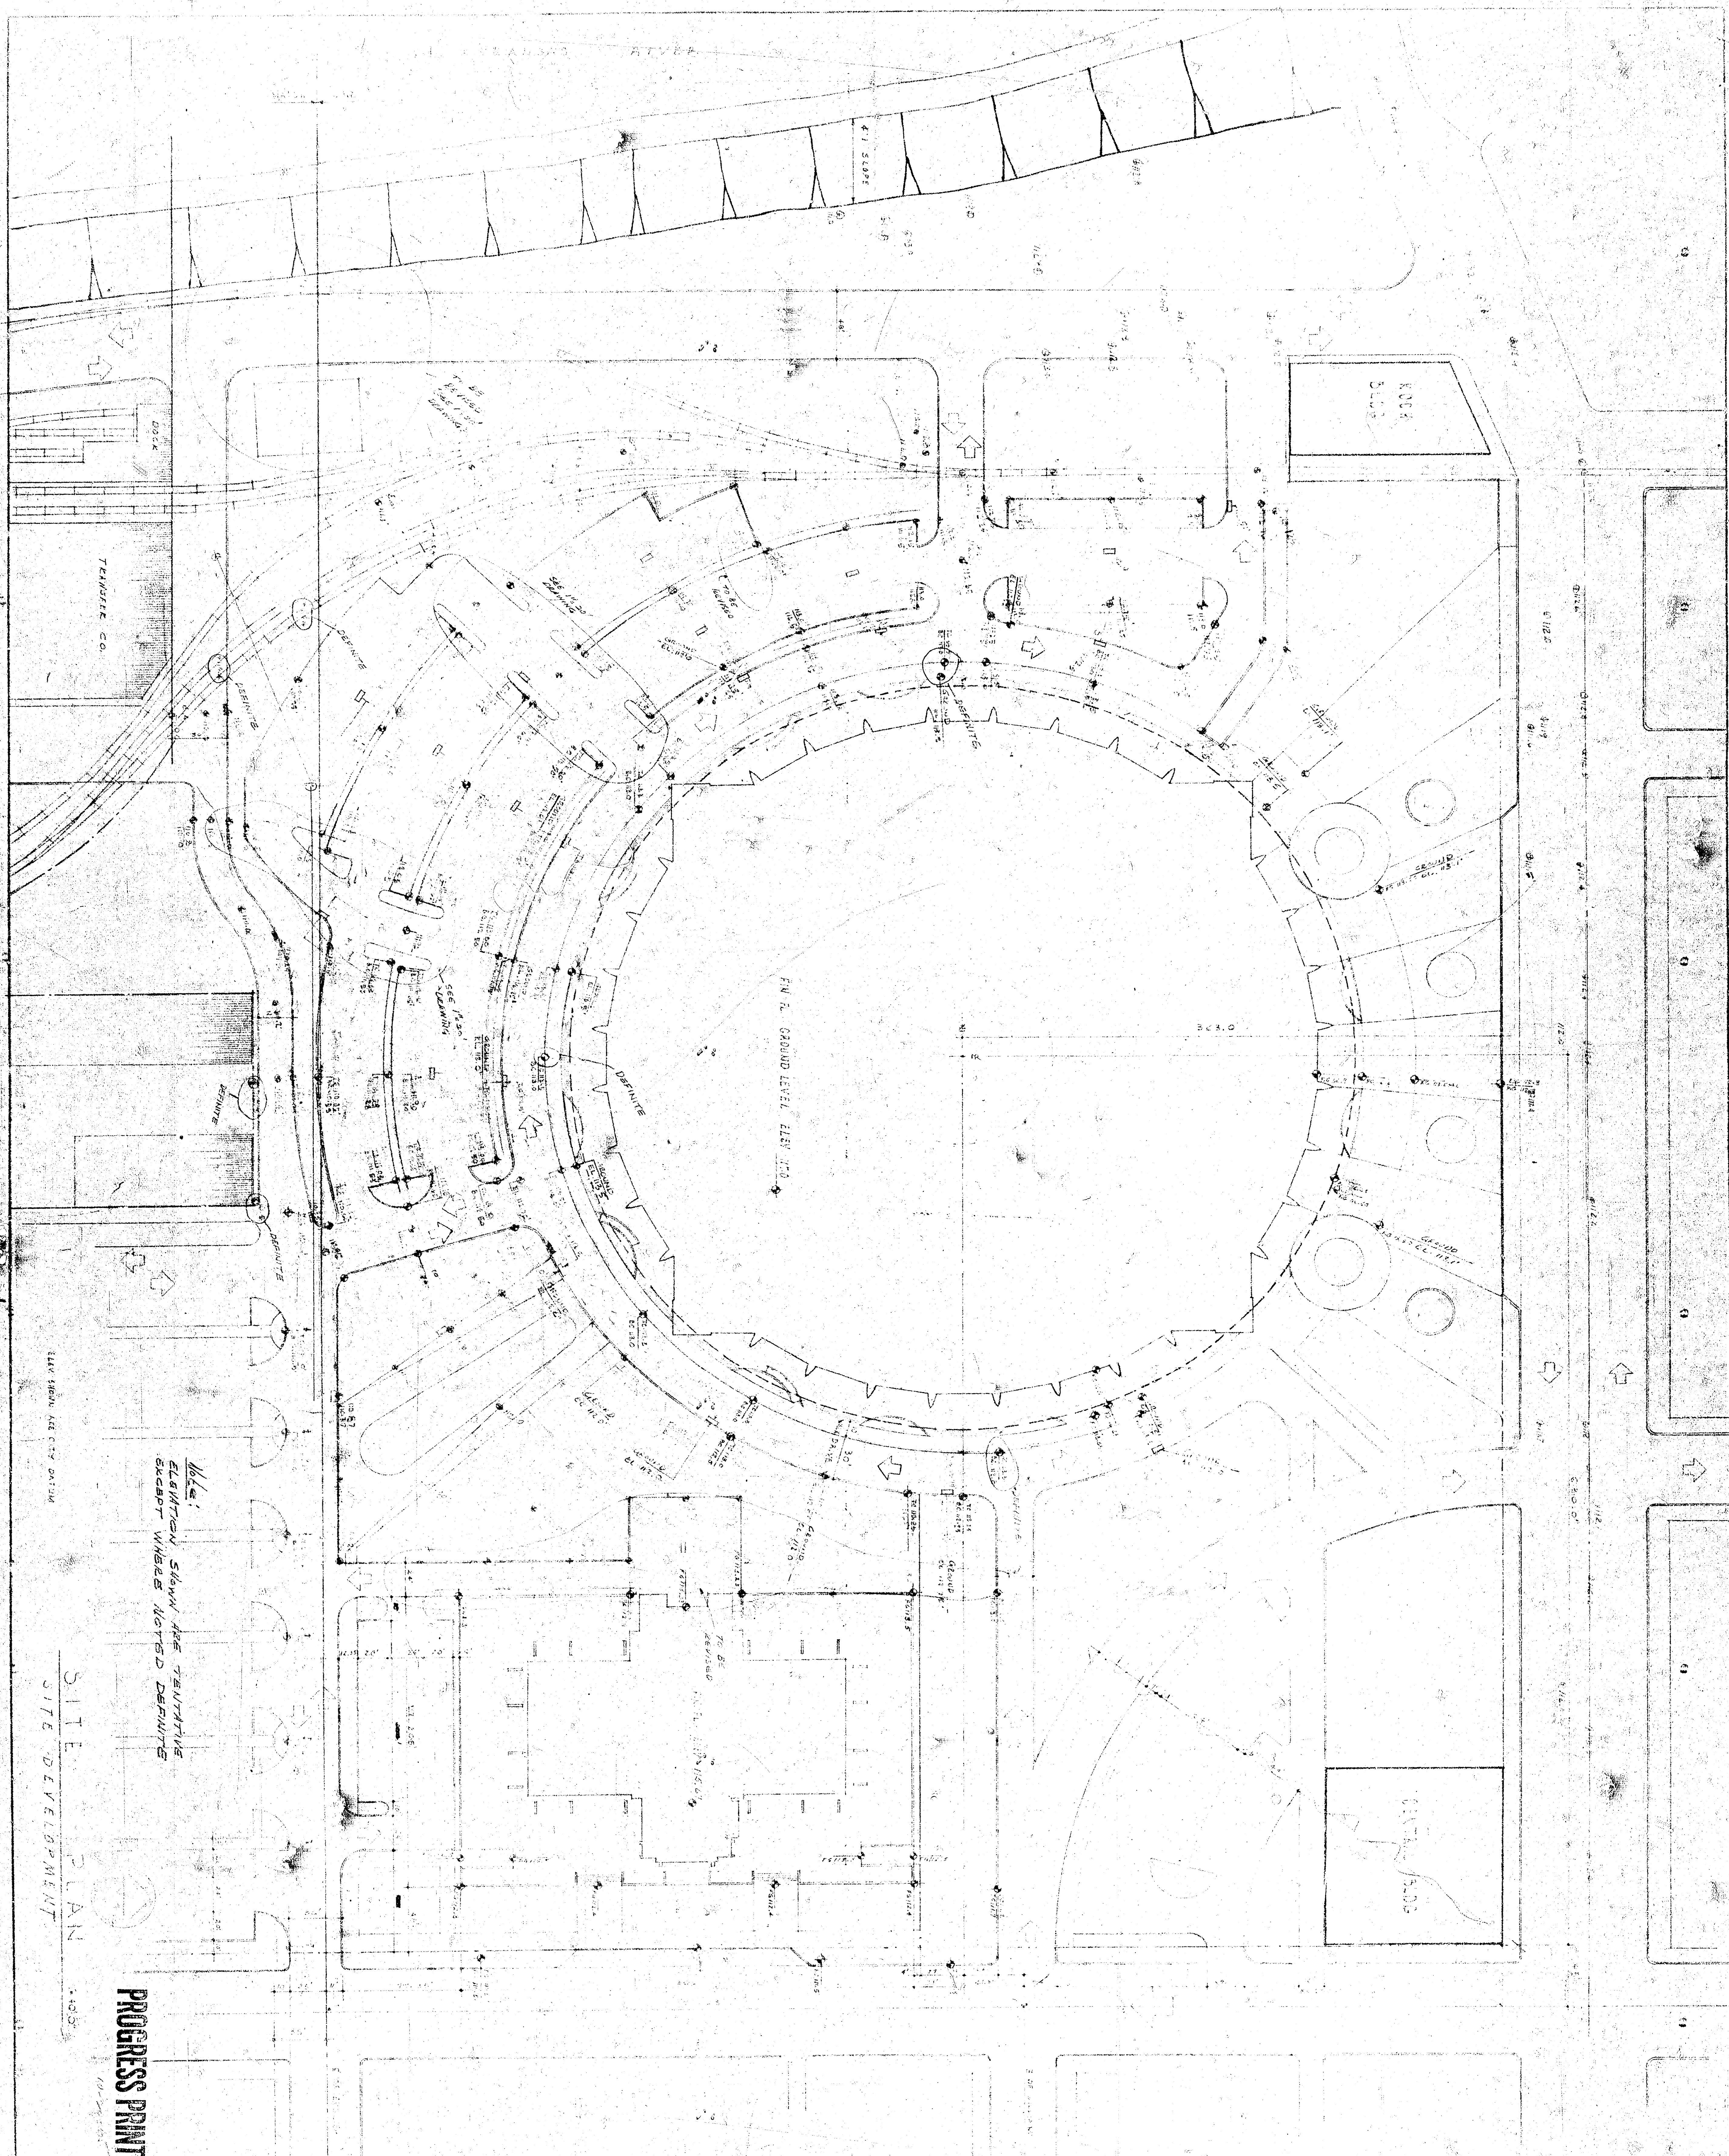

Notes:
ELEVATION SHOWN ARE TENTATIVE

SITE PLAN
SITE DEVELOPMENT
PROGRESS PRINT

AUDITORIUM COMPLEX
CIVIC CULTURAL CENTER
CITY OF WICHITA, KANSAS

JOHN M. HICKMAN ASSOCIATES
PROJECT ARCHITECTS
KRAUSE ROBERTSON SMITH
ASSOCIATES

