


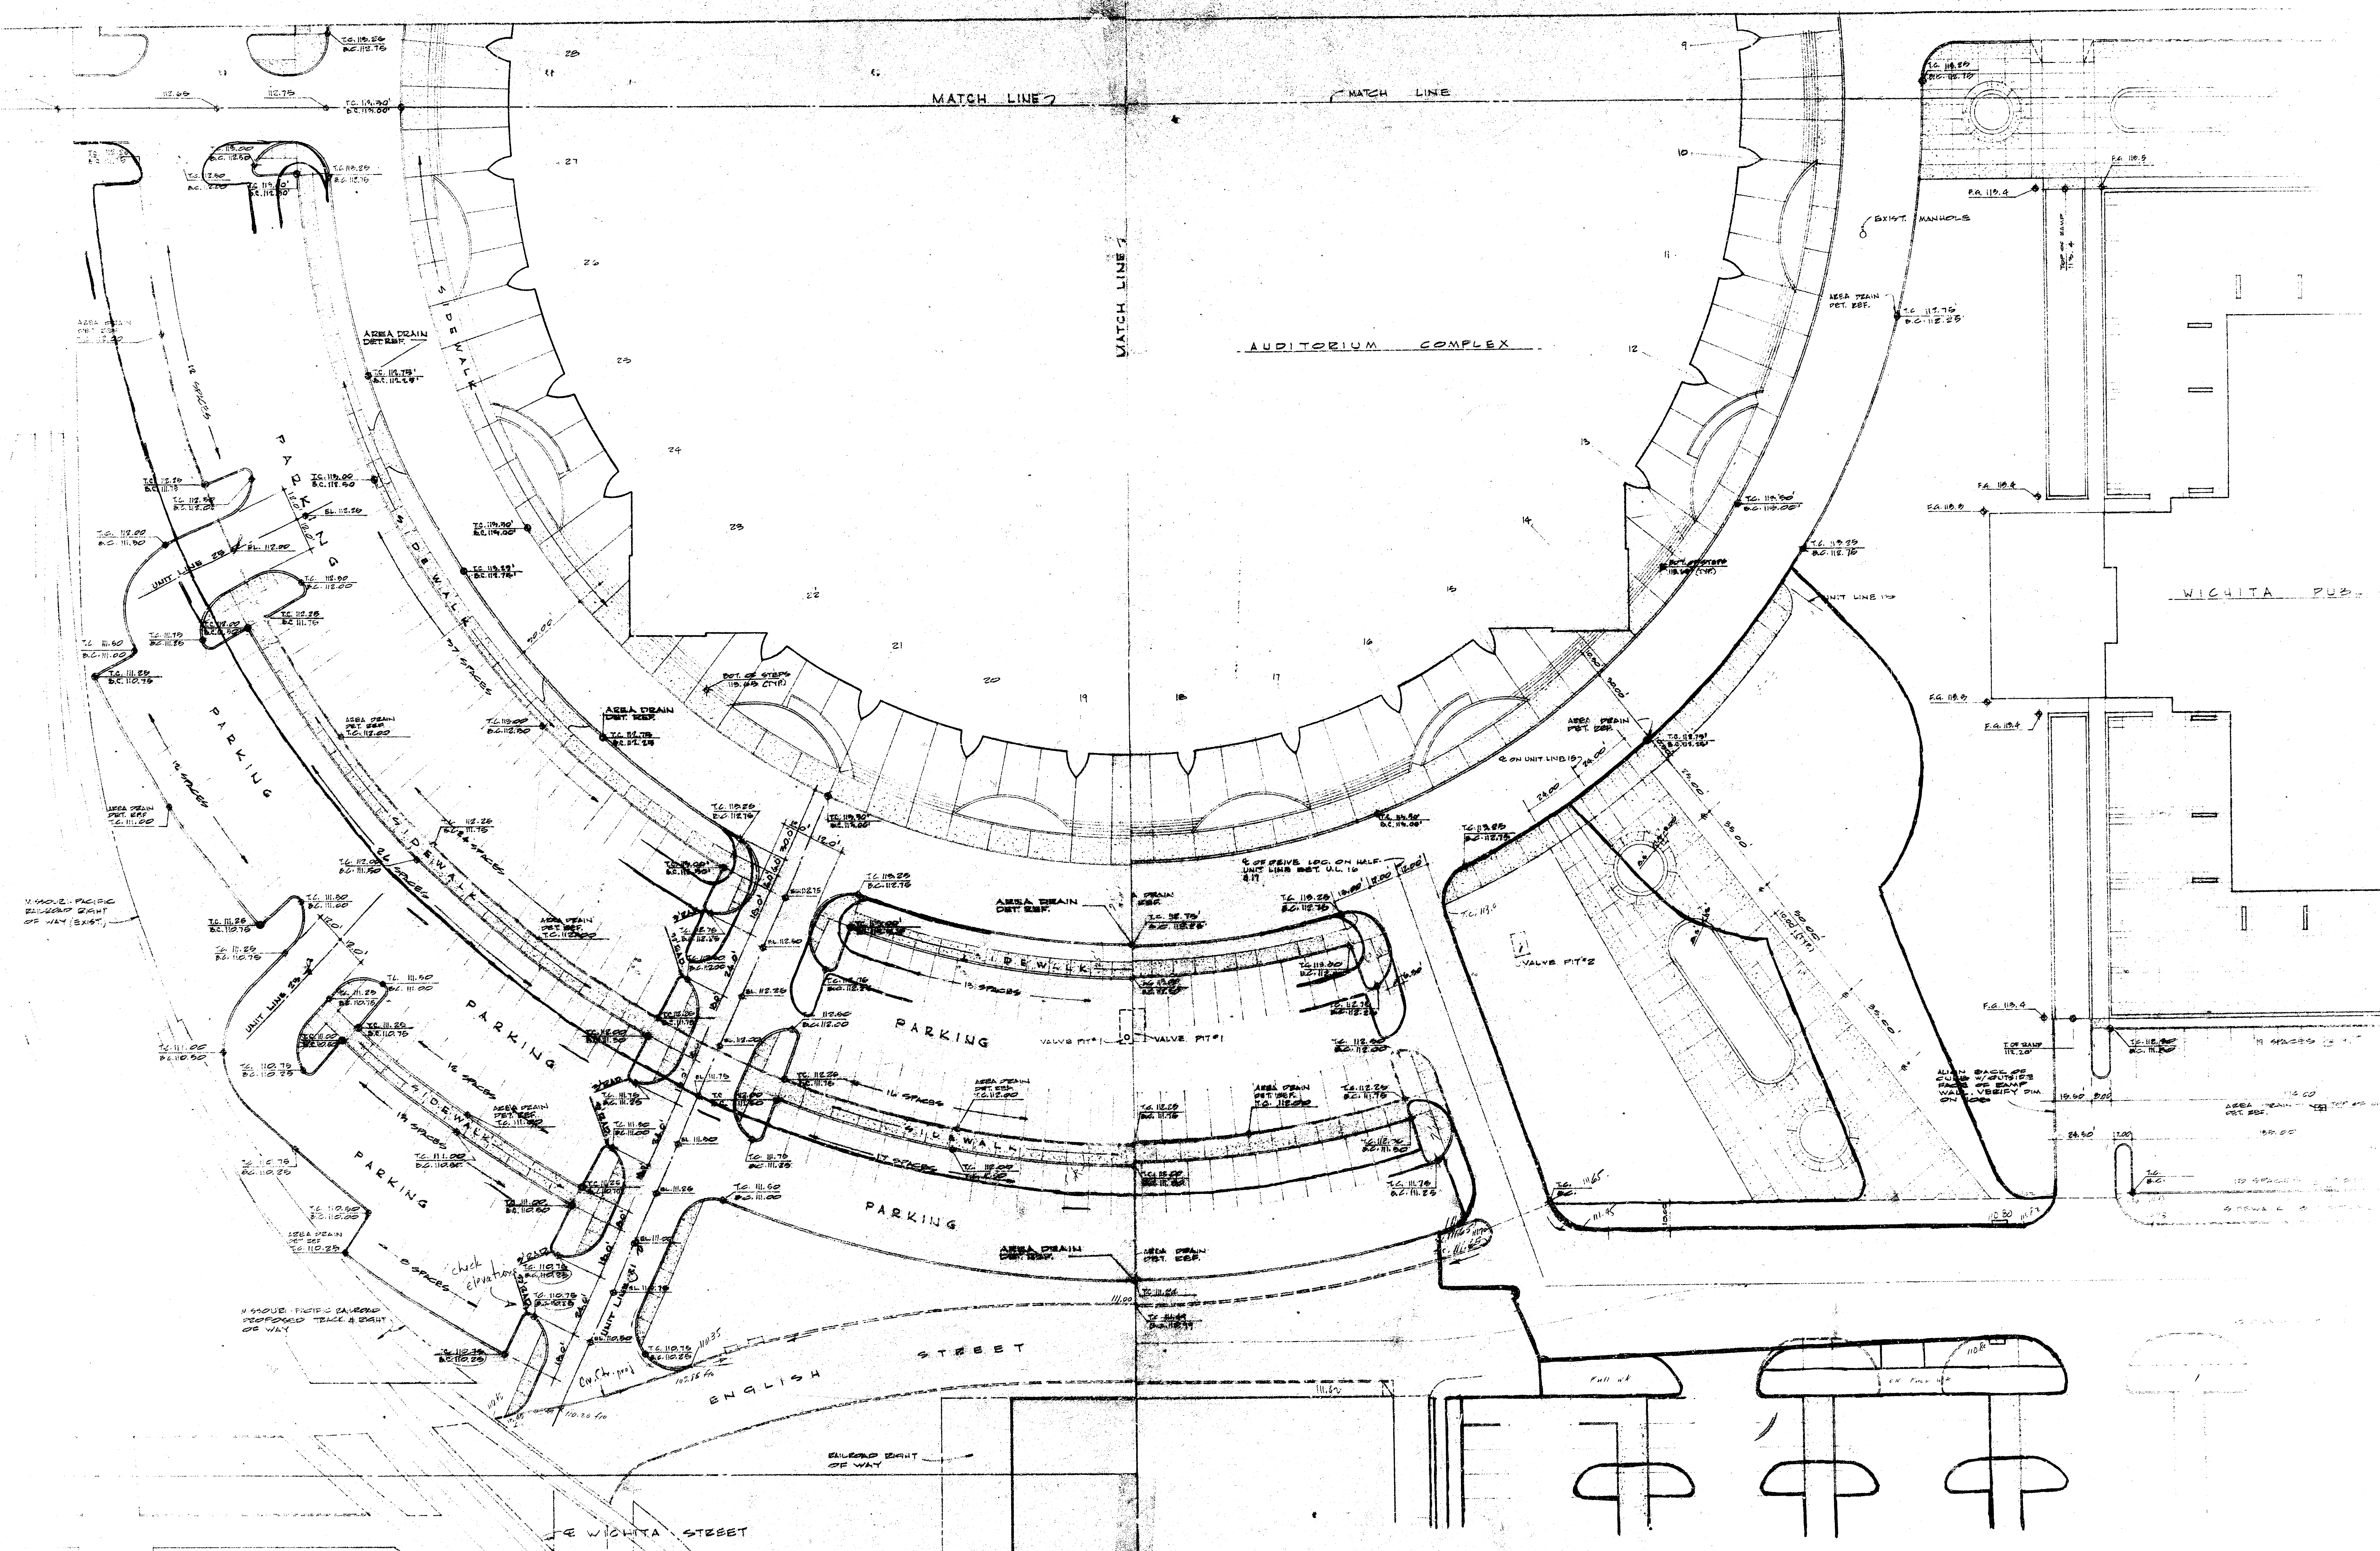


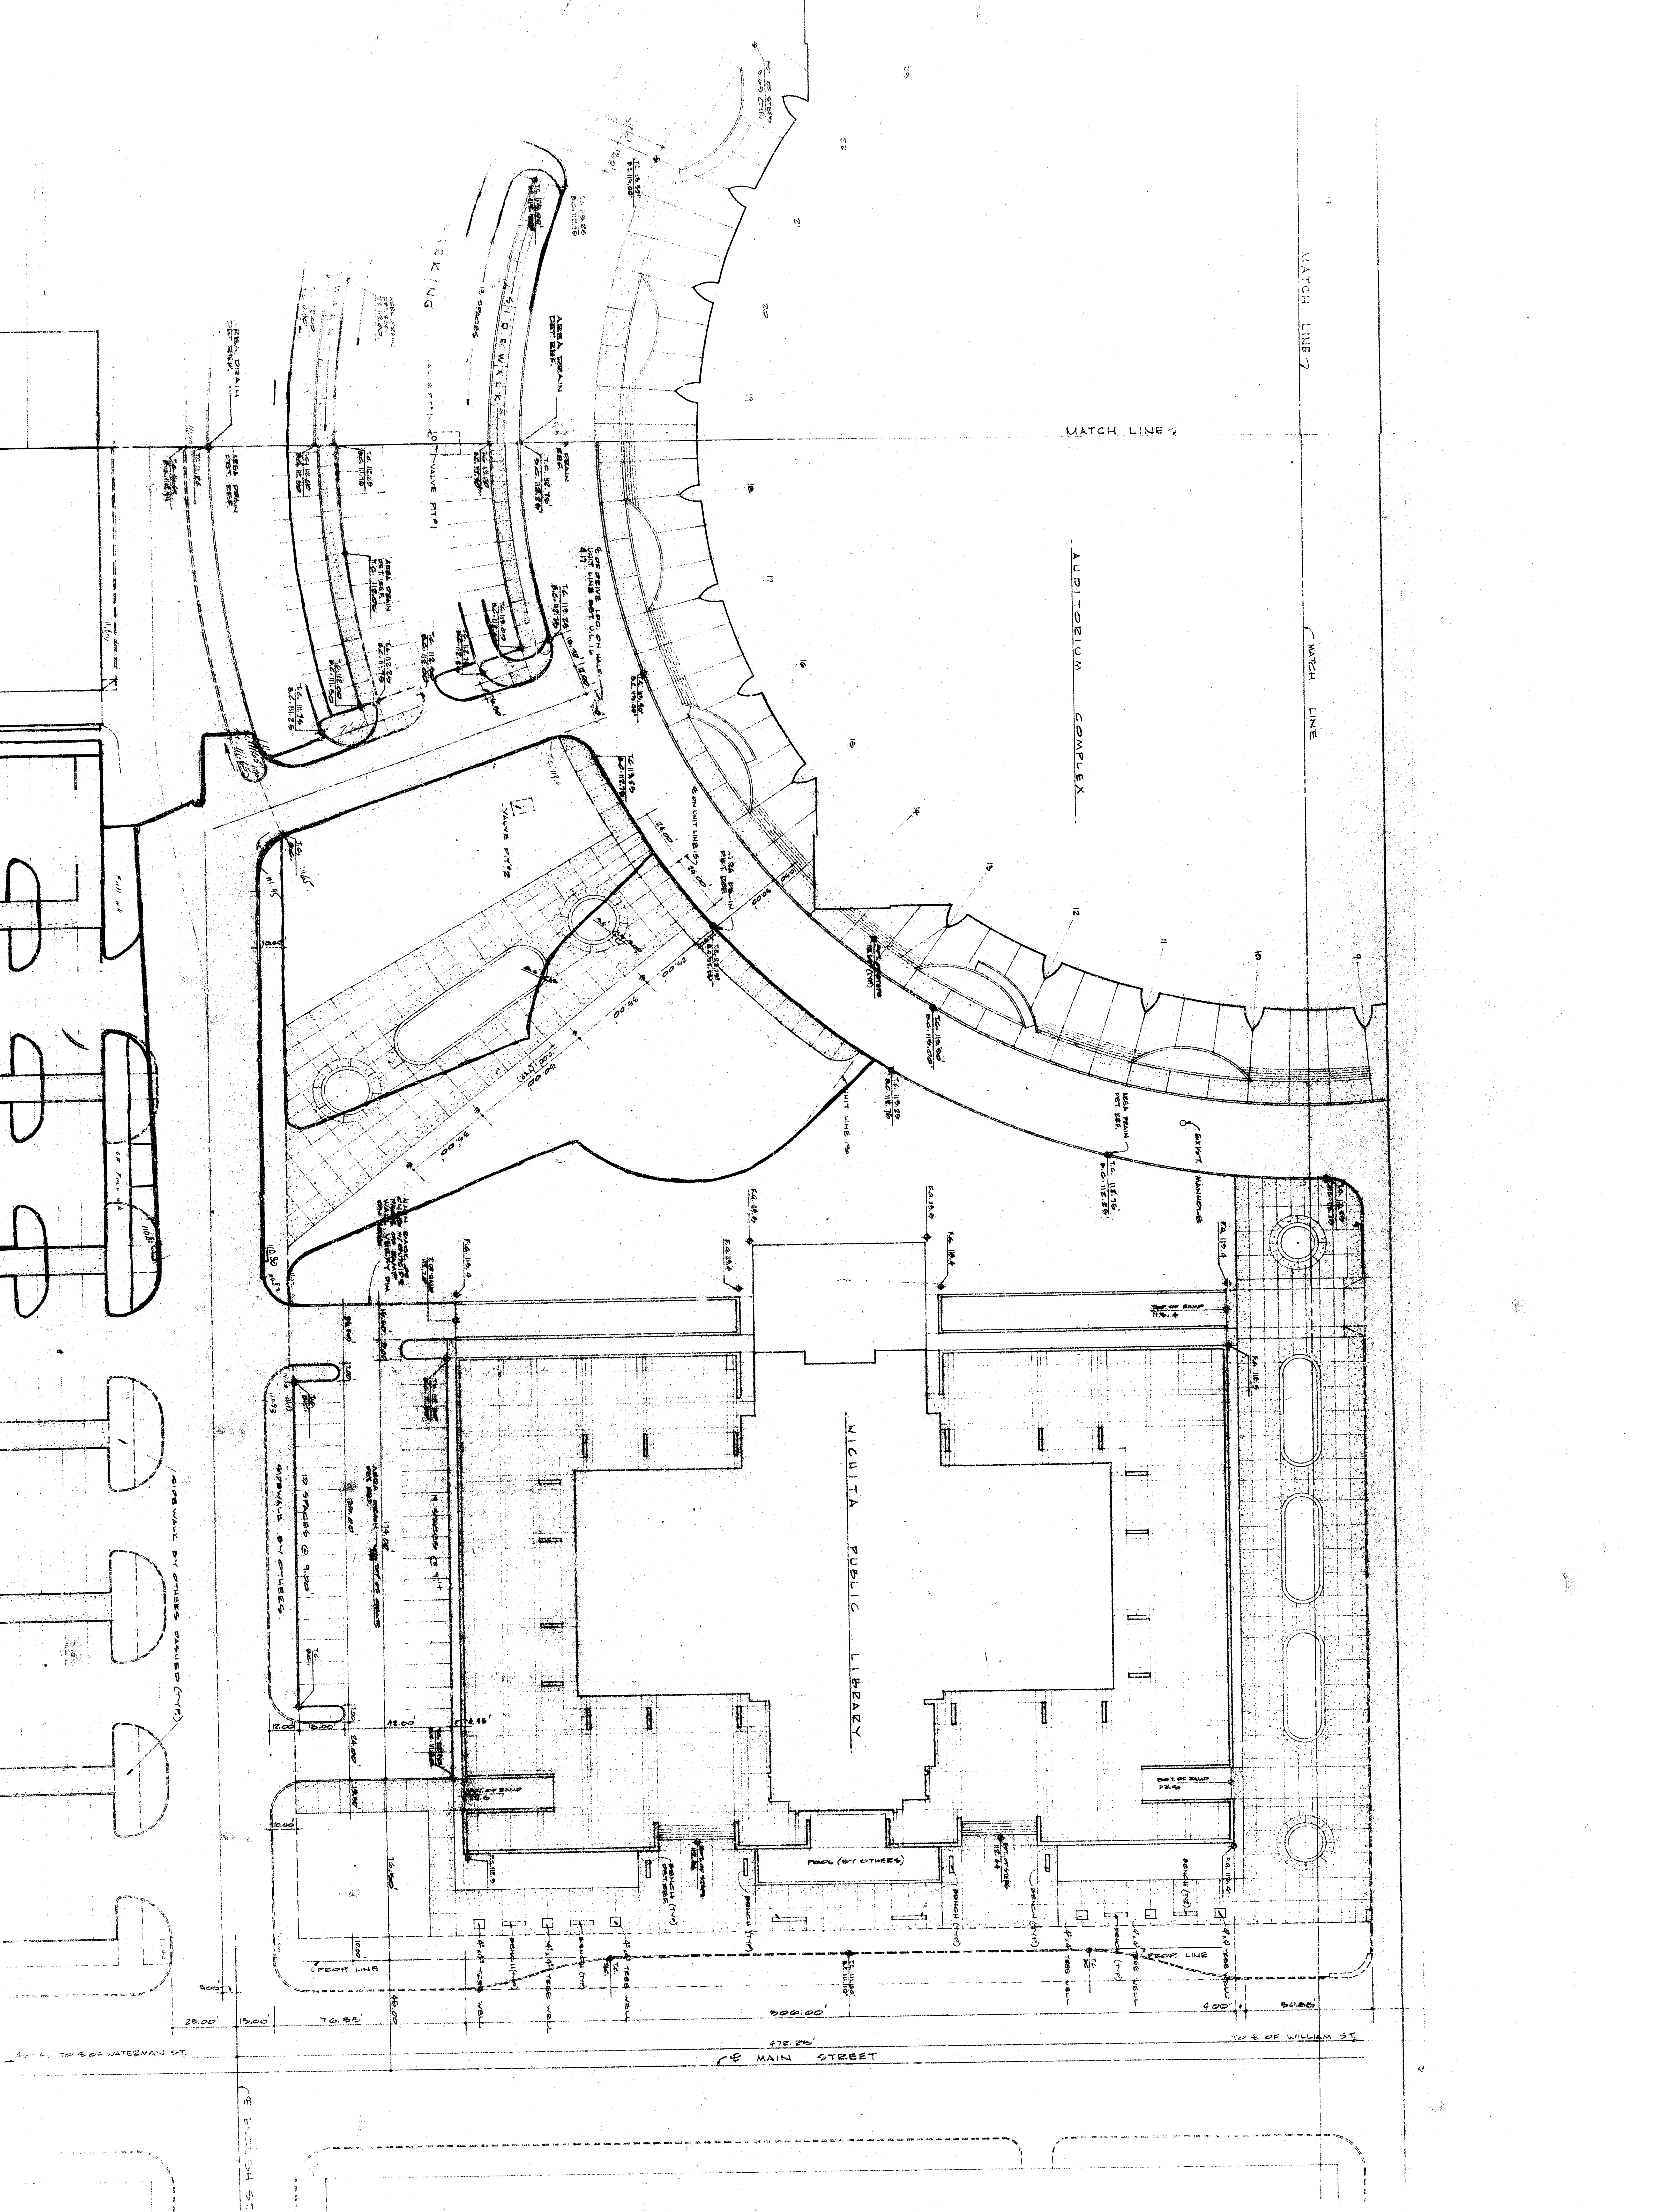

FLAN #4

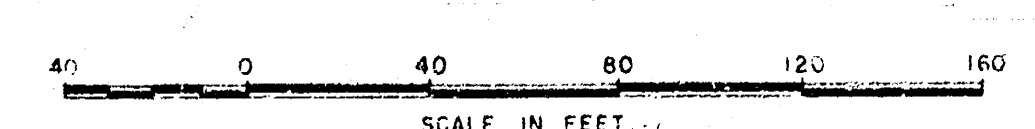

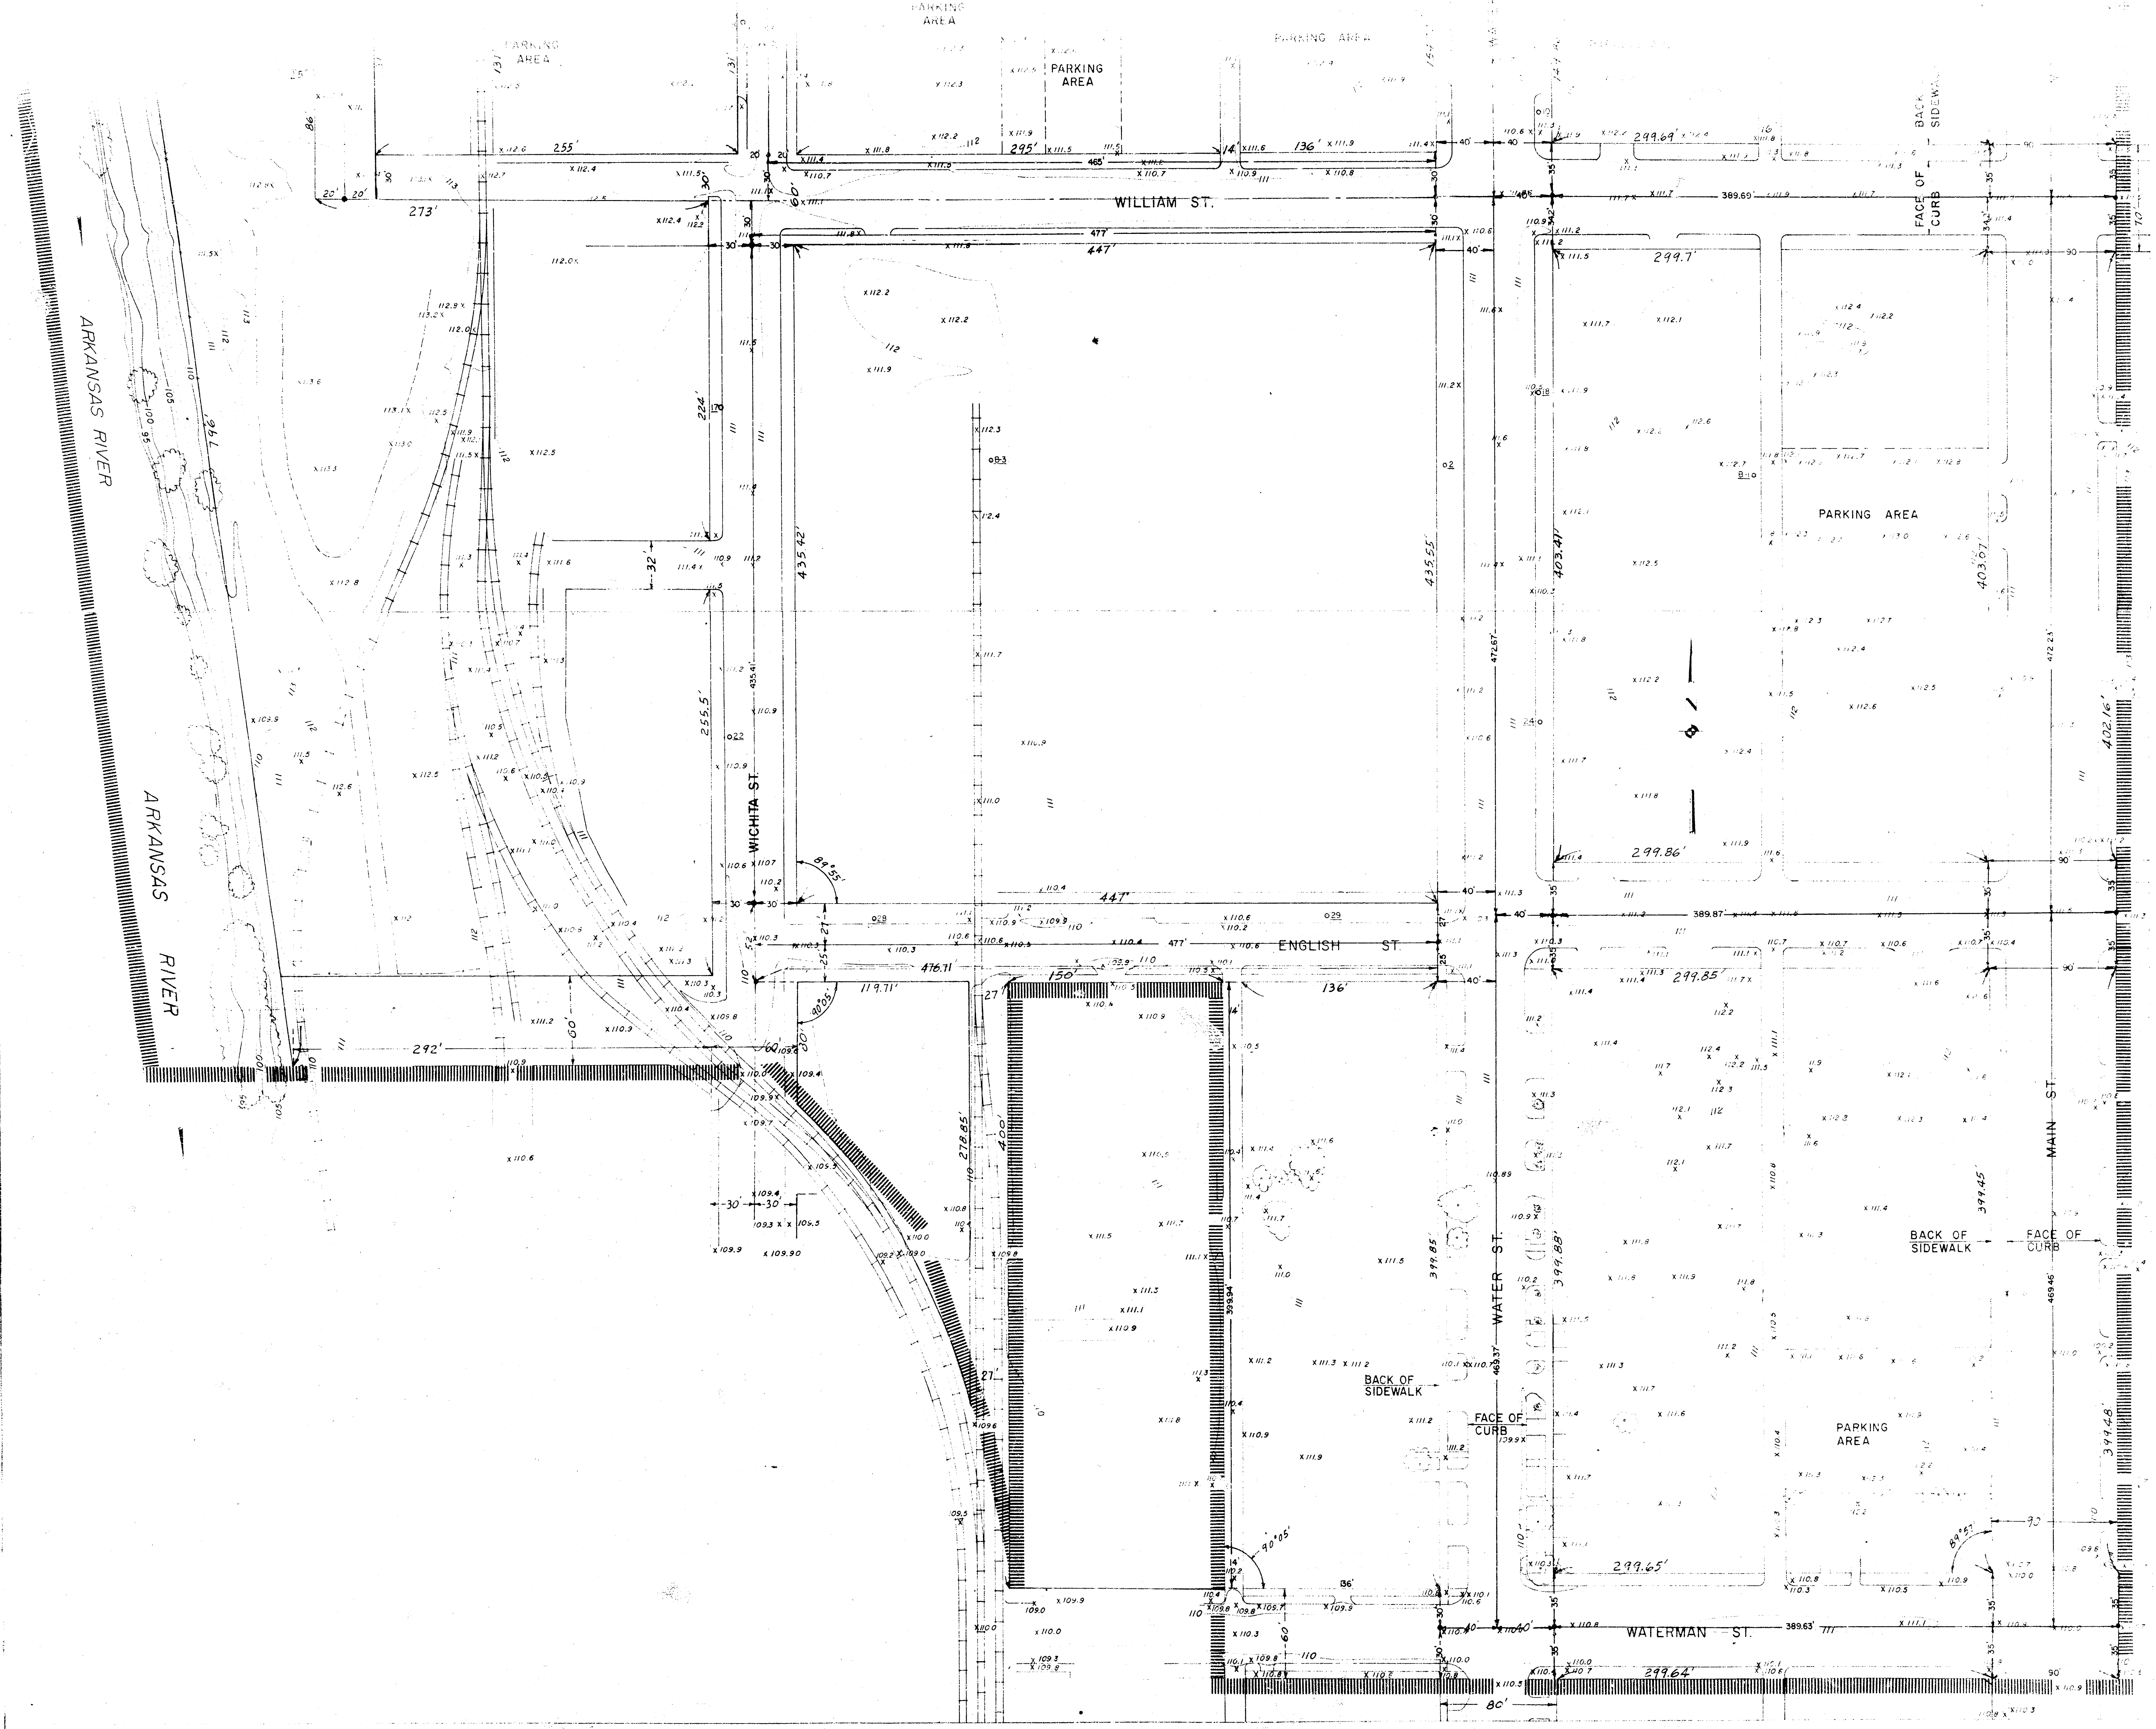

NOTE
Topography by Servis, Van Doren & Hazard, Engineers of Topeka,
Kansas, by a standard photogrammetric process from aerial photo-
graphs taken by Aerial Photo Service of Tulsa, Oklahoma on 17
March 1963.

DIMENSIONS

TOPOGRAPHIC SURVEY
CIVIC CENTER
FOR THE

