


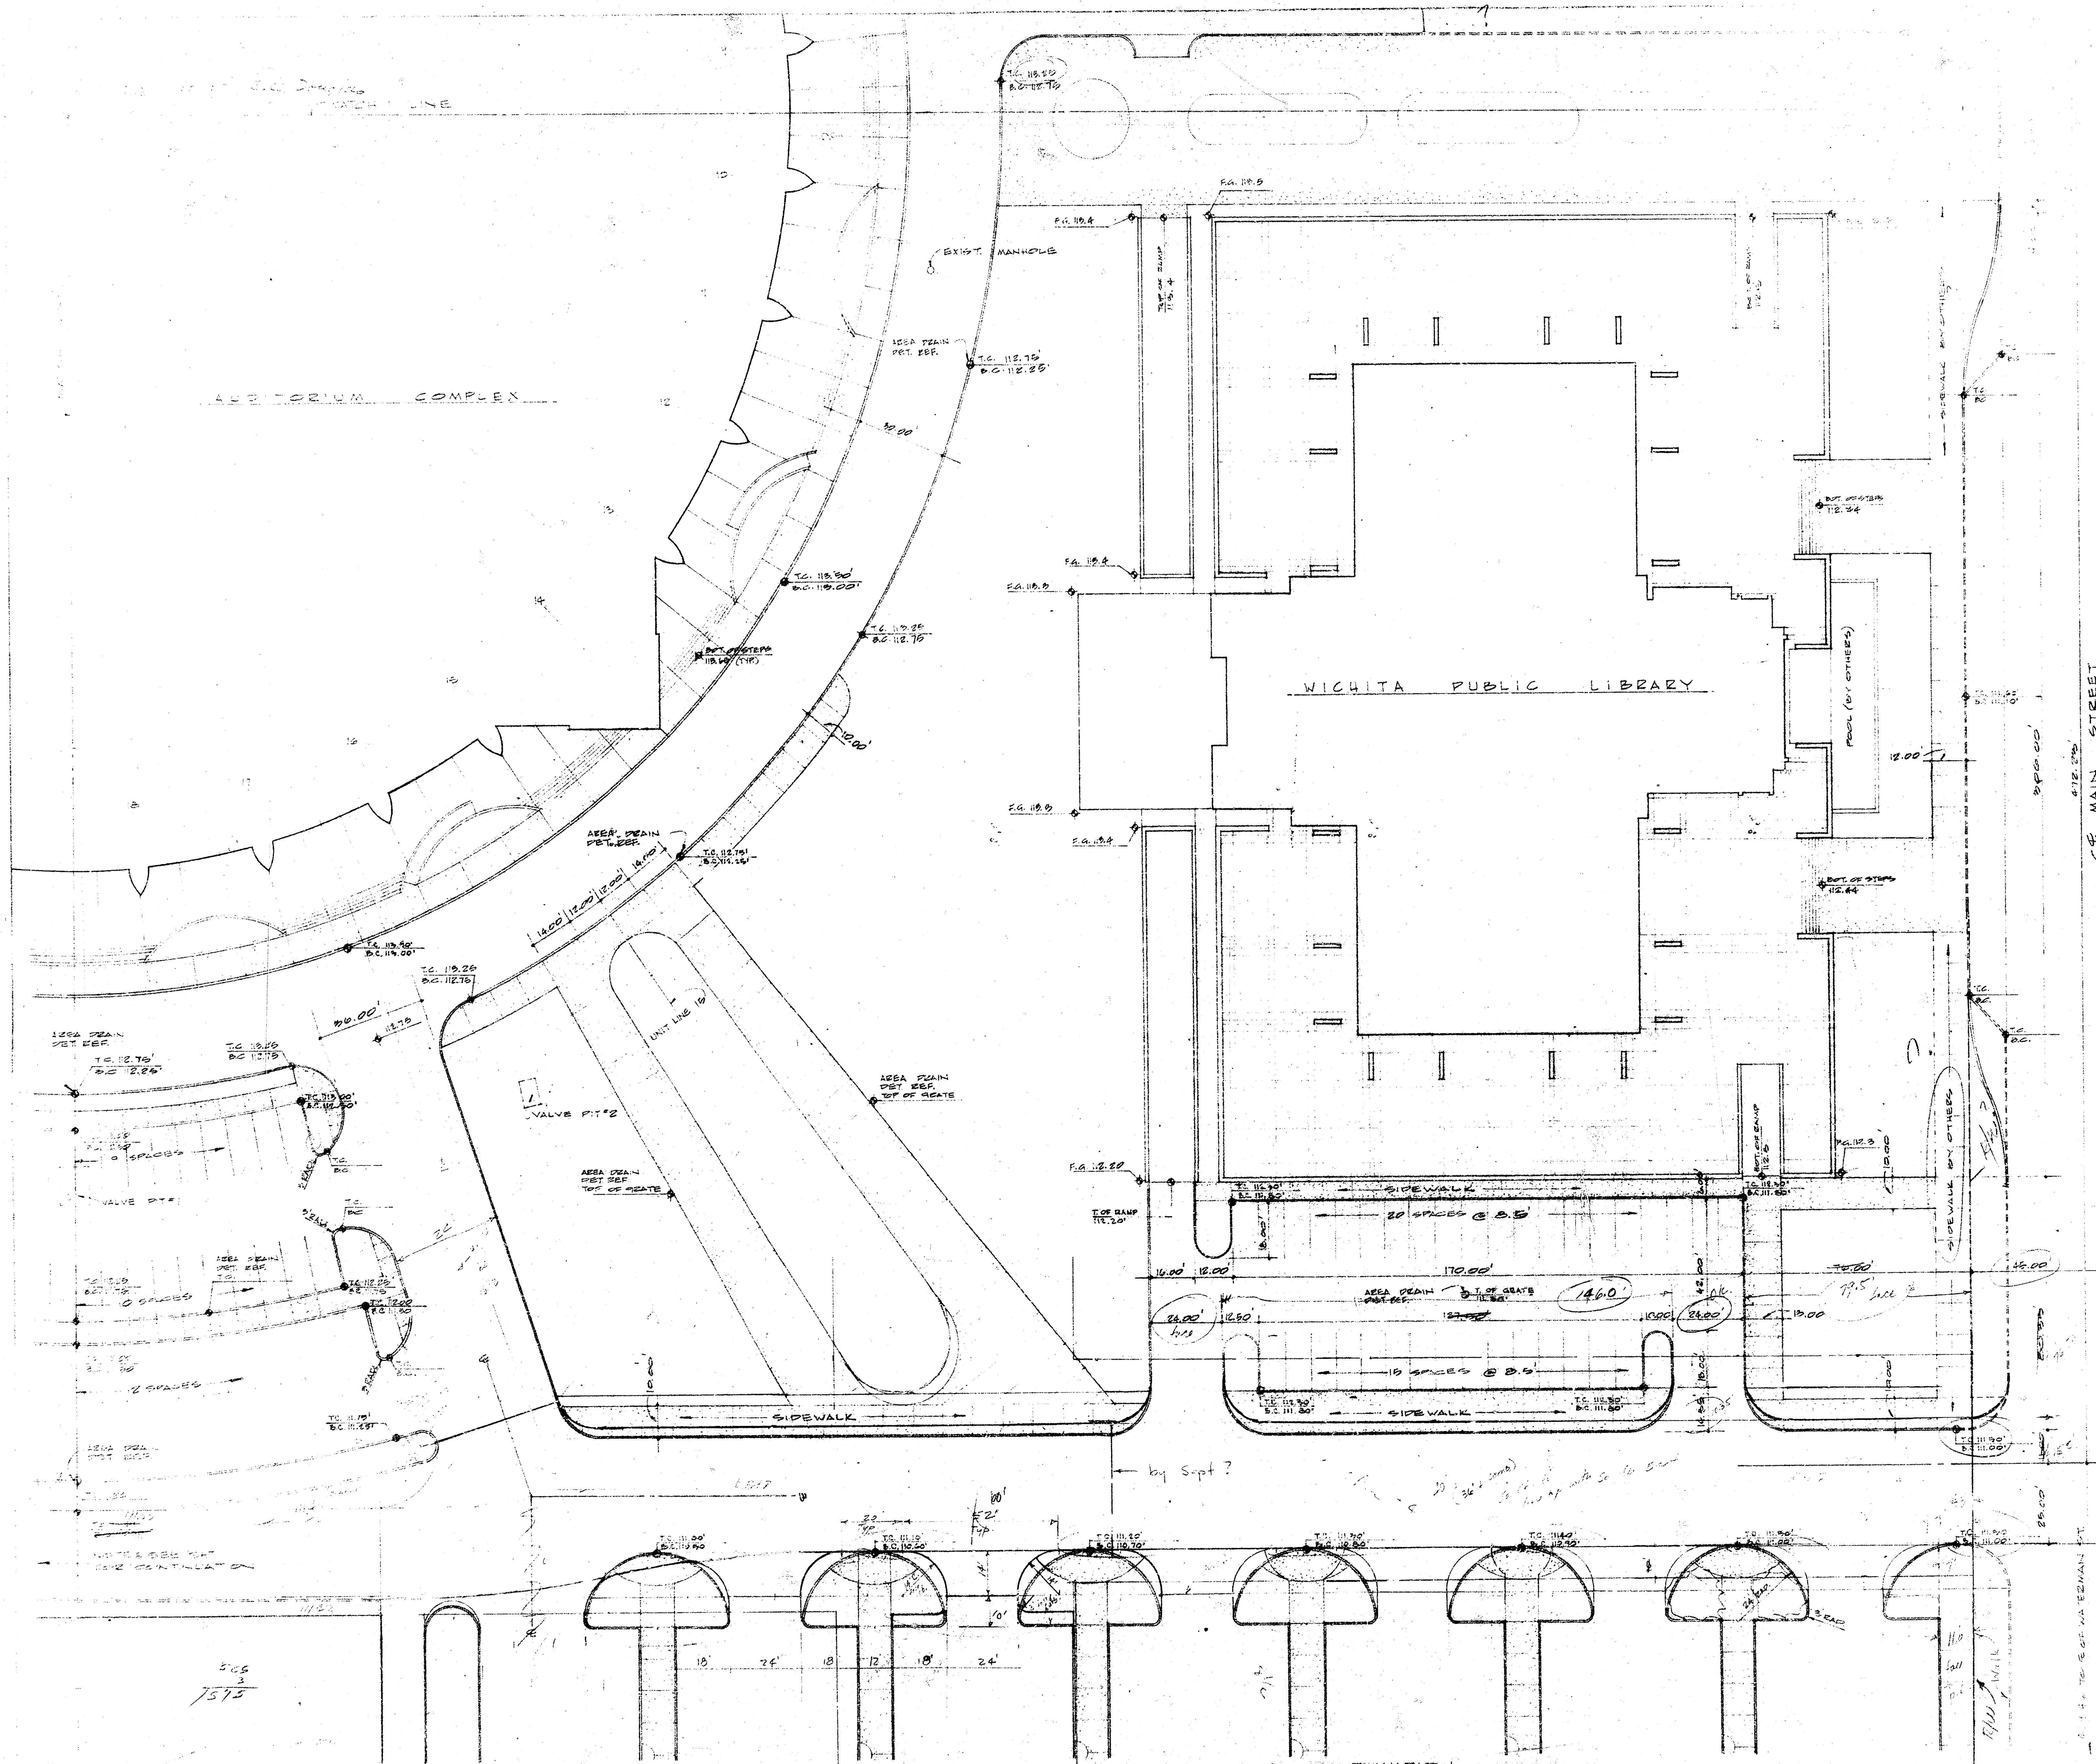

NOTE: SEE SHT. FOR CONTINUATION

PLAN



