




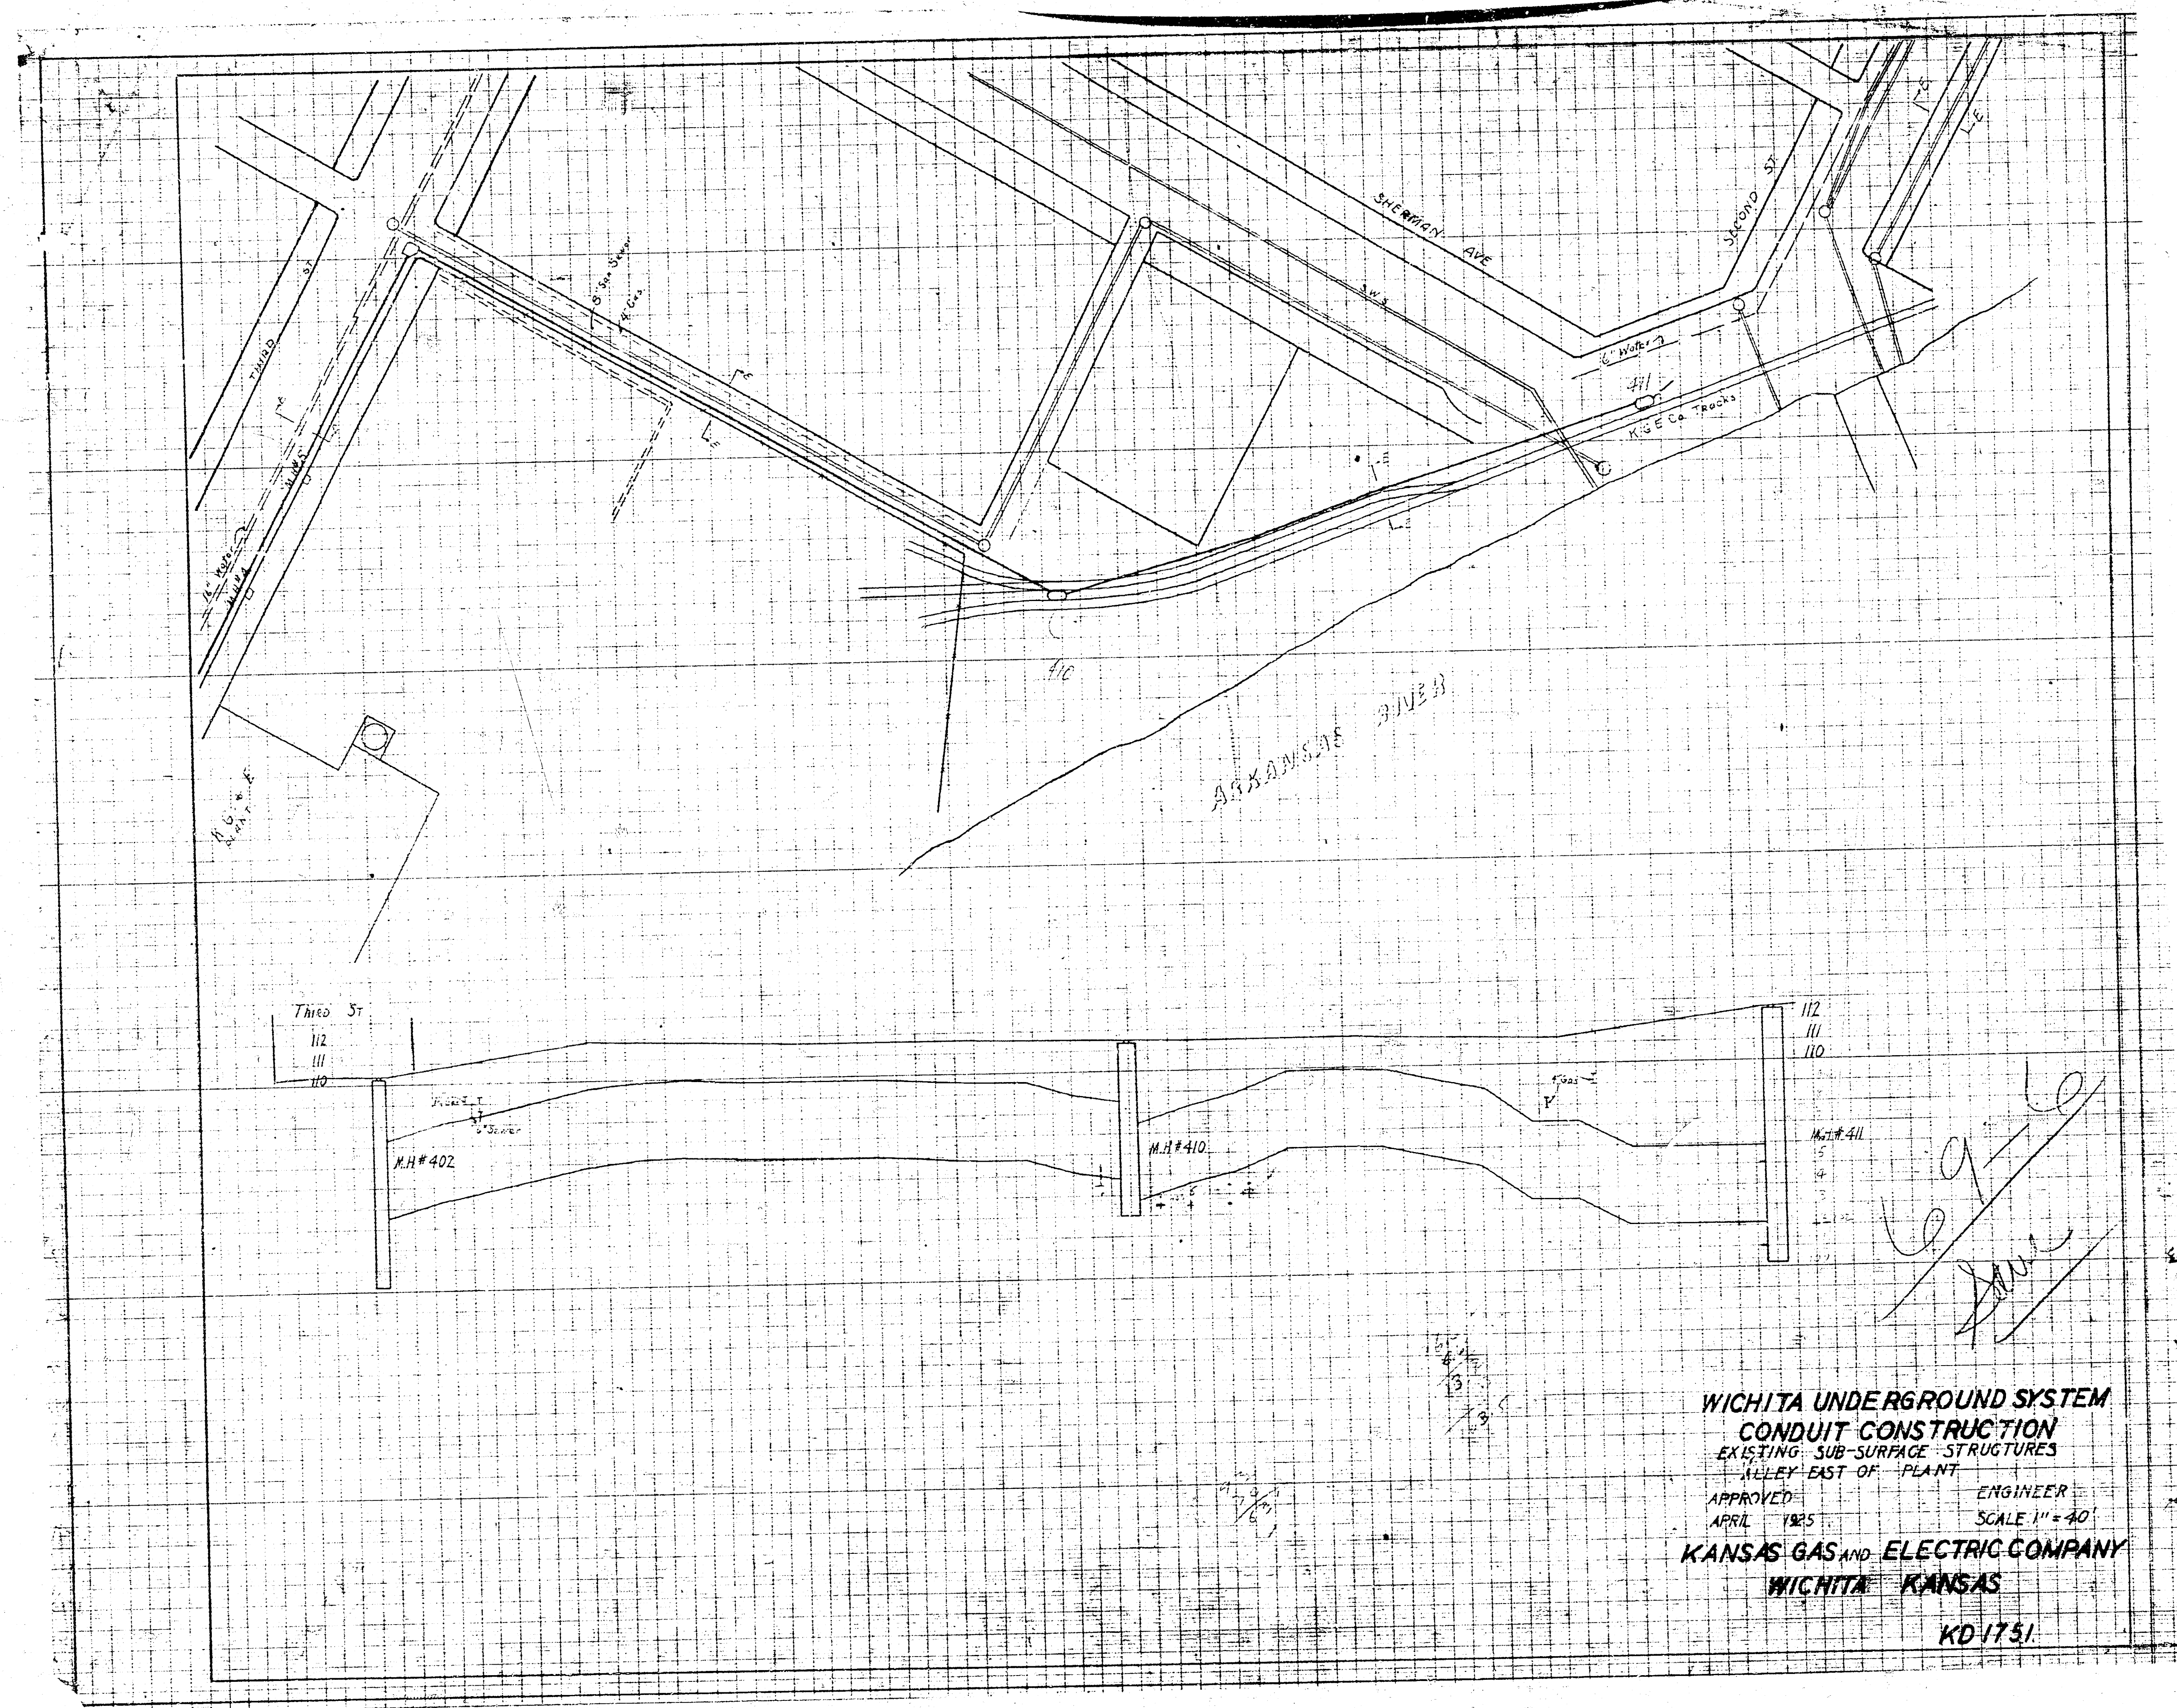

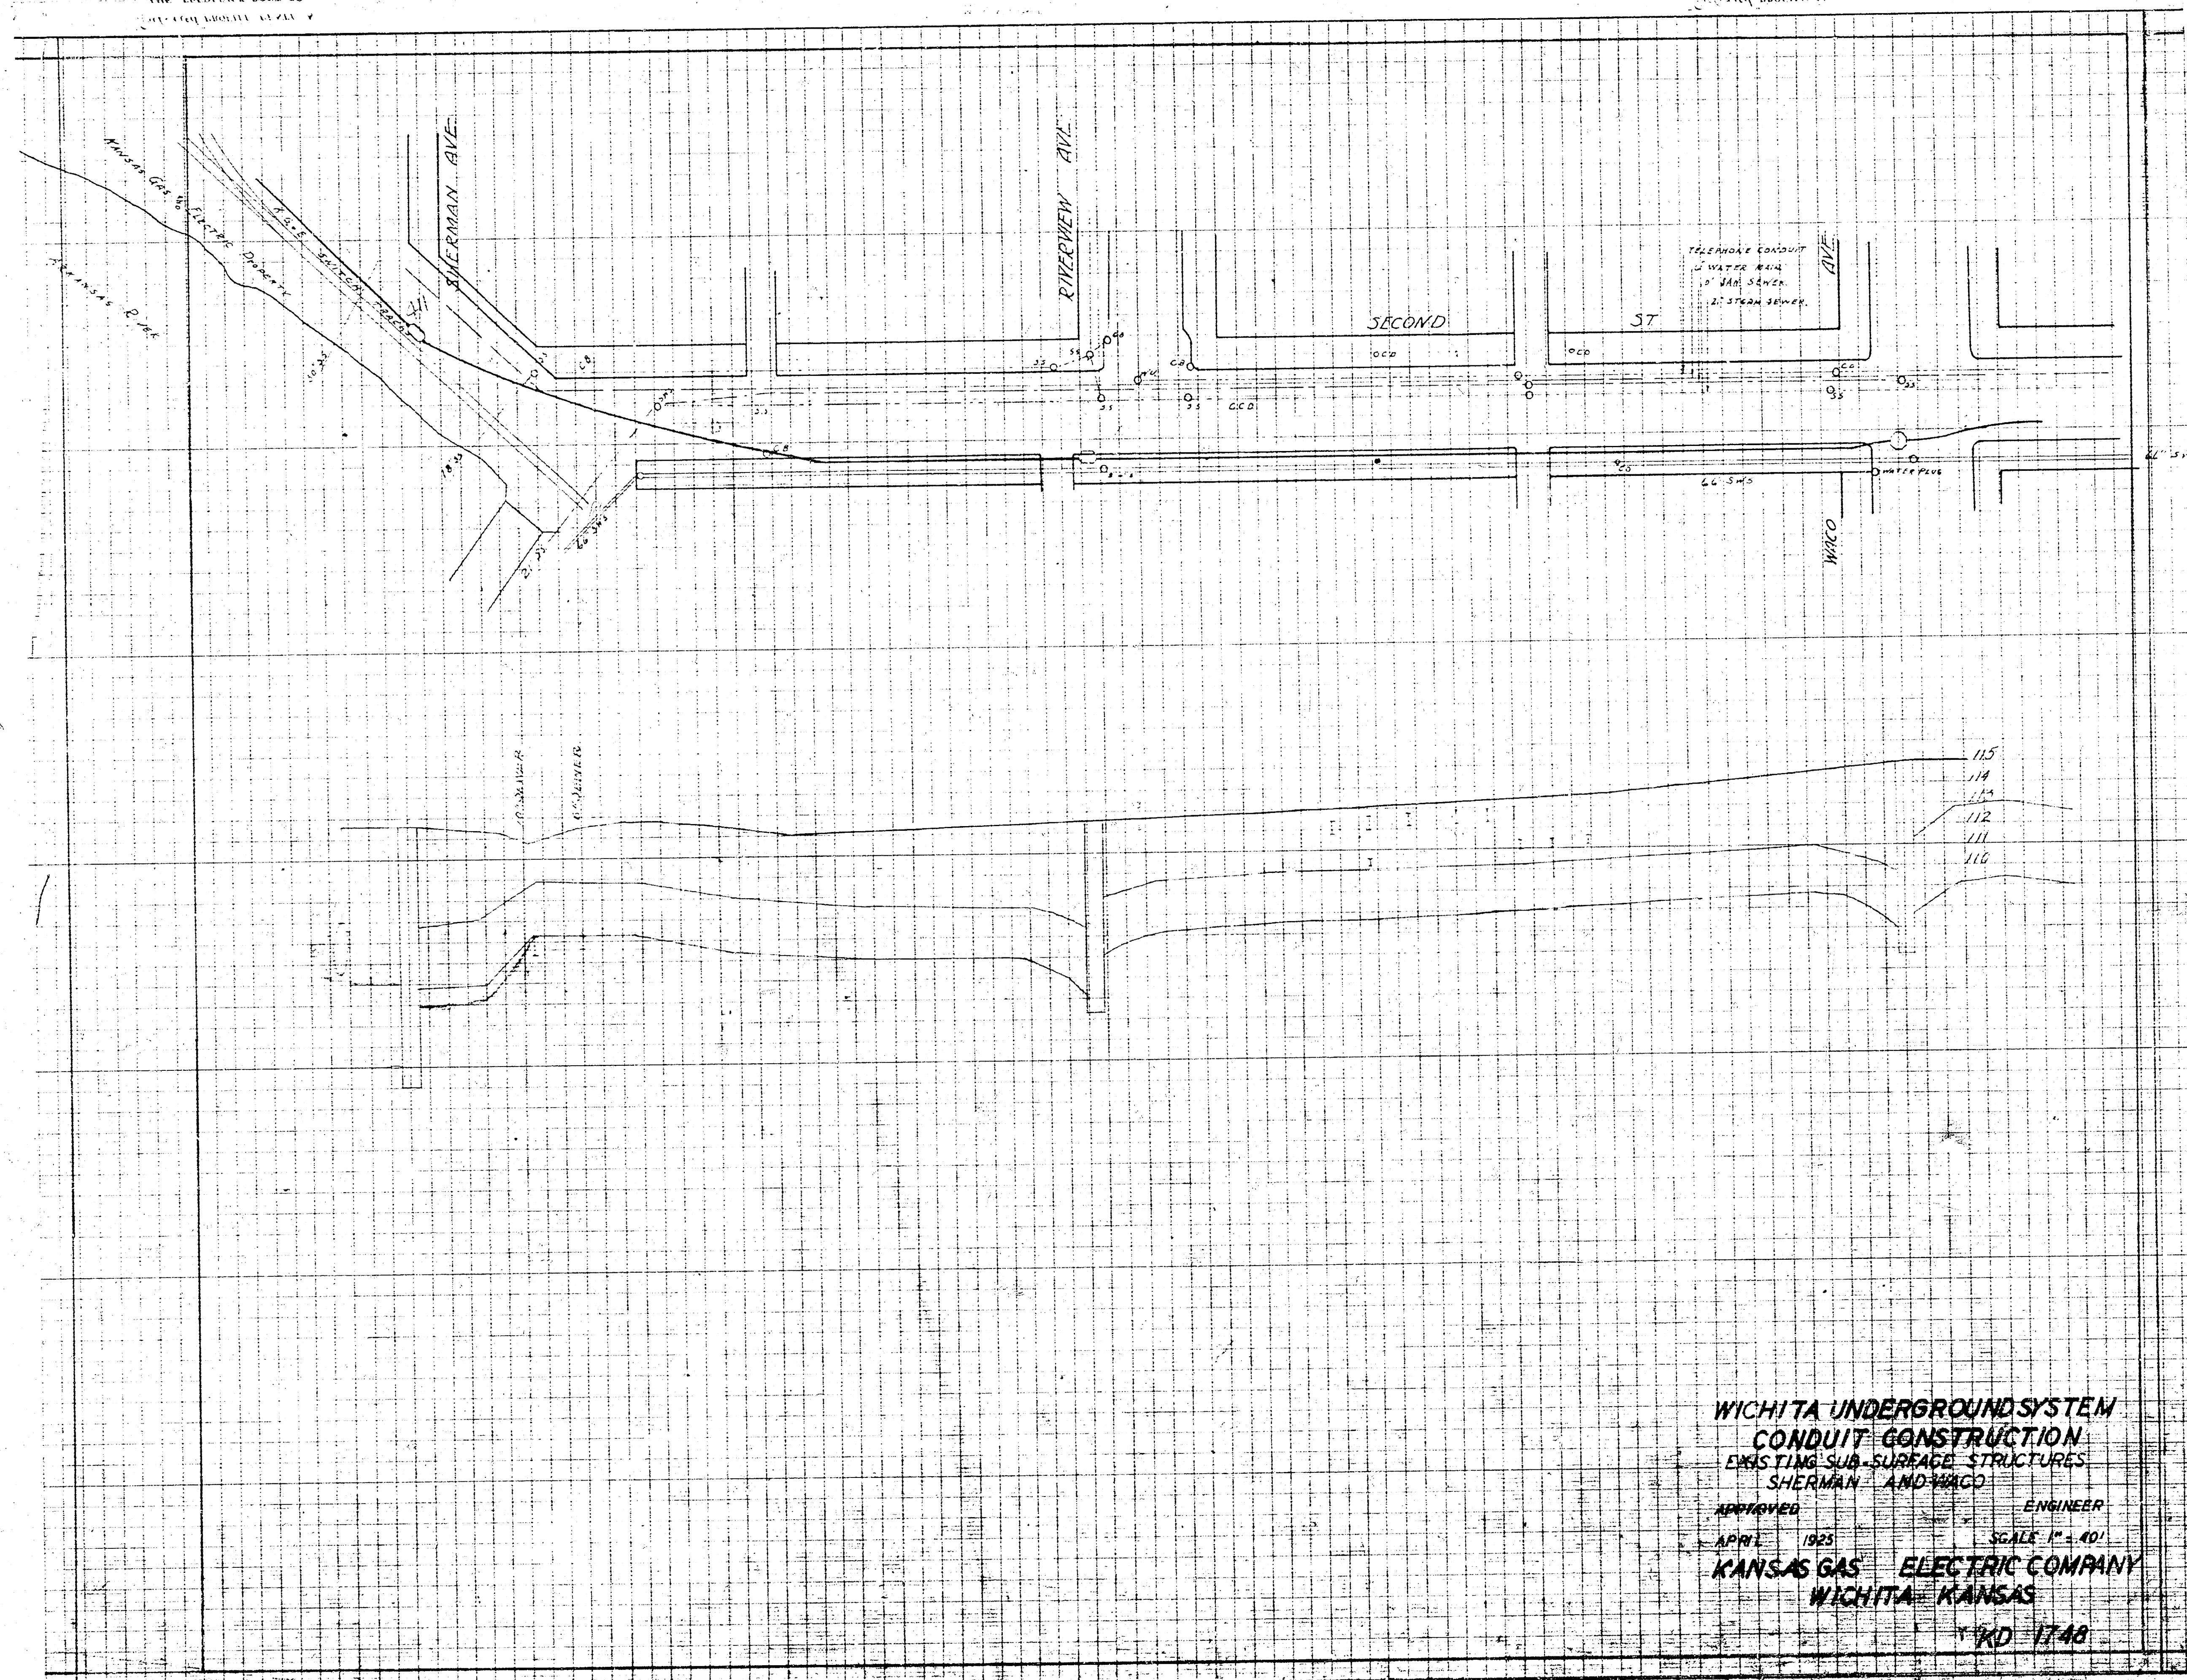

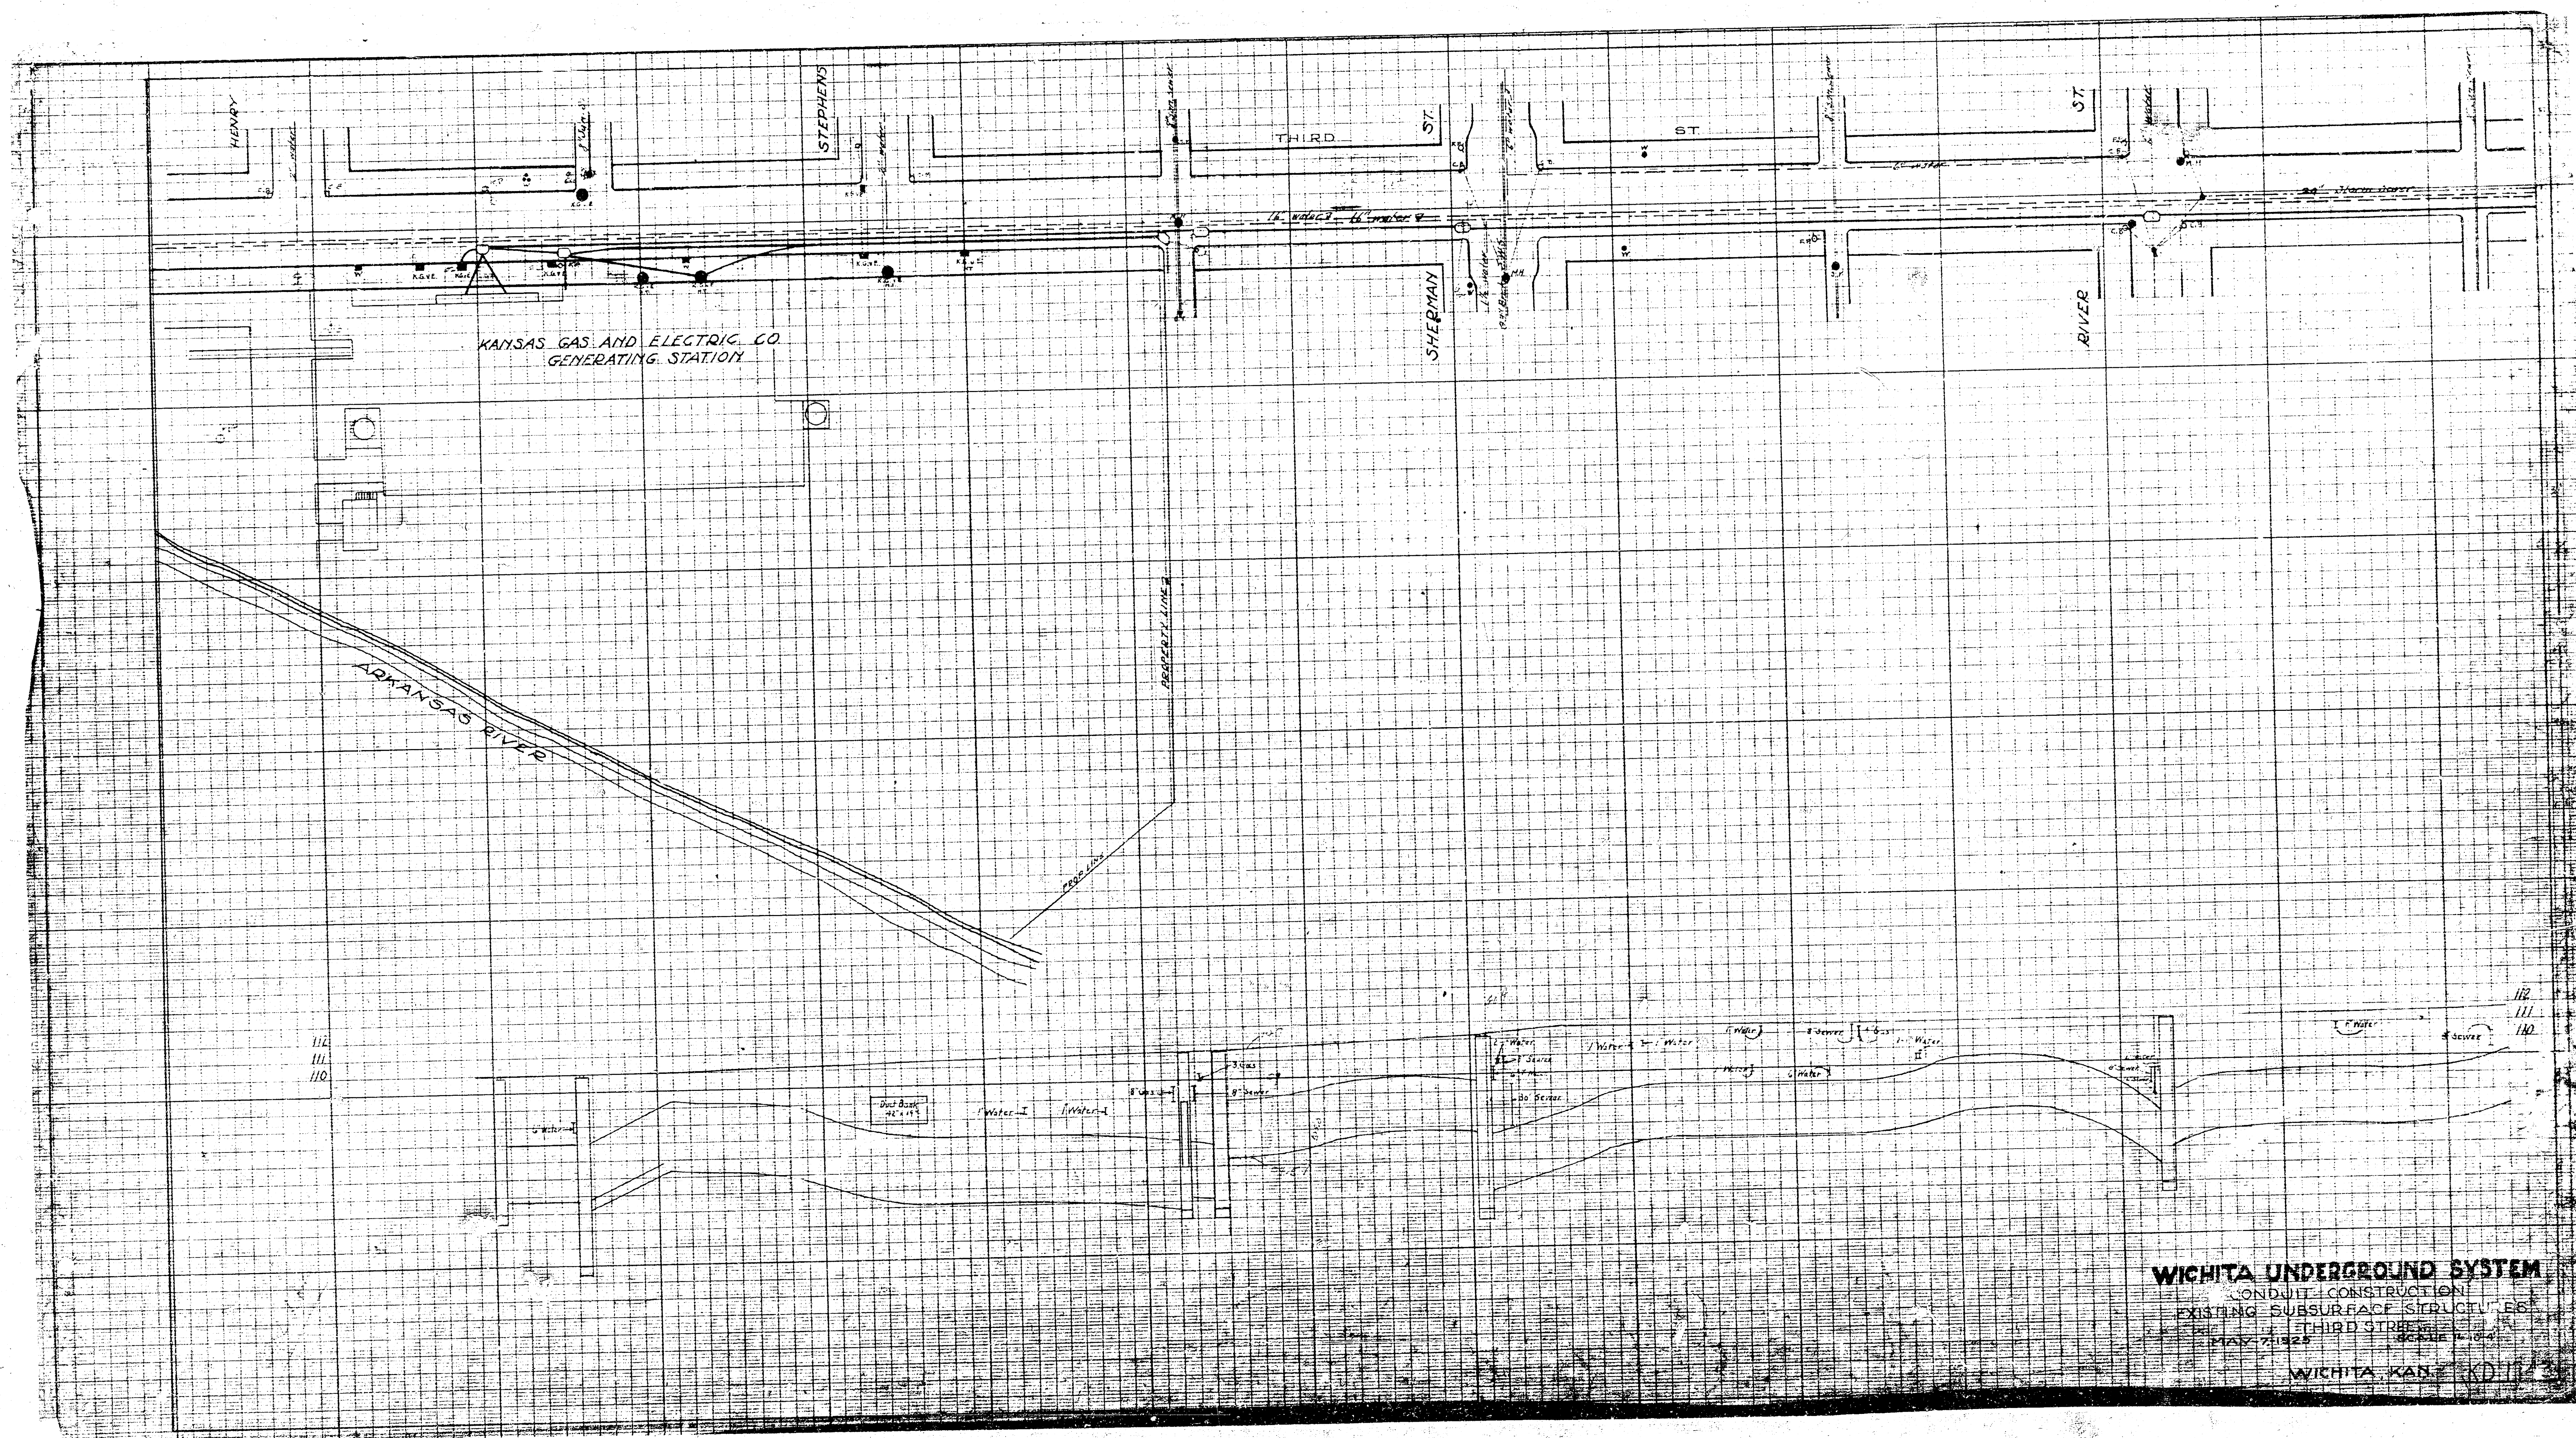

**WICHITA UNDERGROUND SYSTEM**

CONDUIT CONSTRUCTION

EXISTING SUBSURFACE STRUCTURES

THIRD STREET

MAY 7, 1925

WICHITA, KAN. (KD 1123)

