

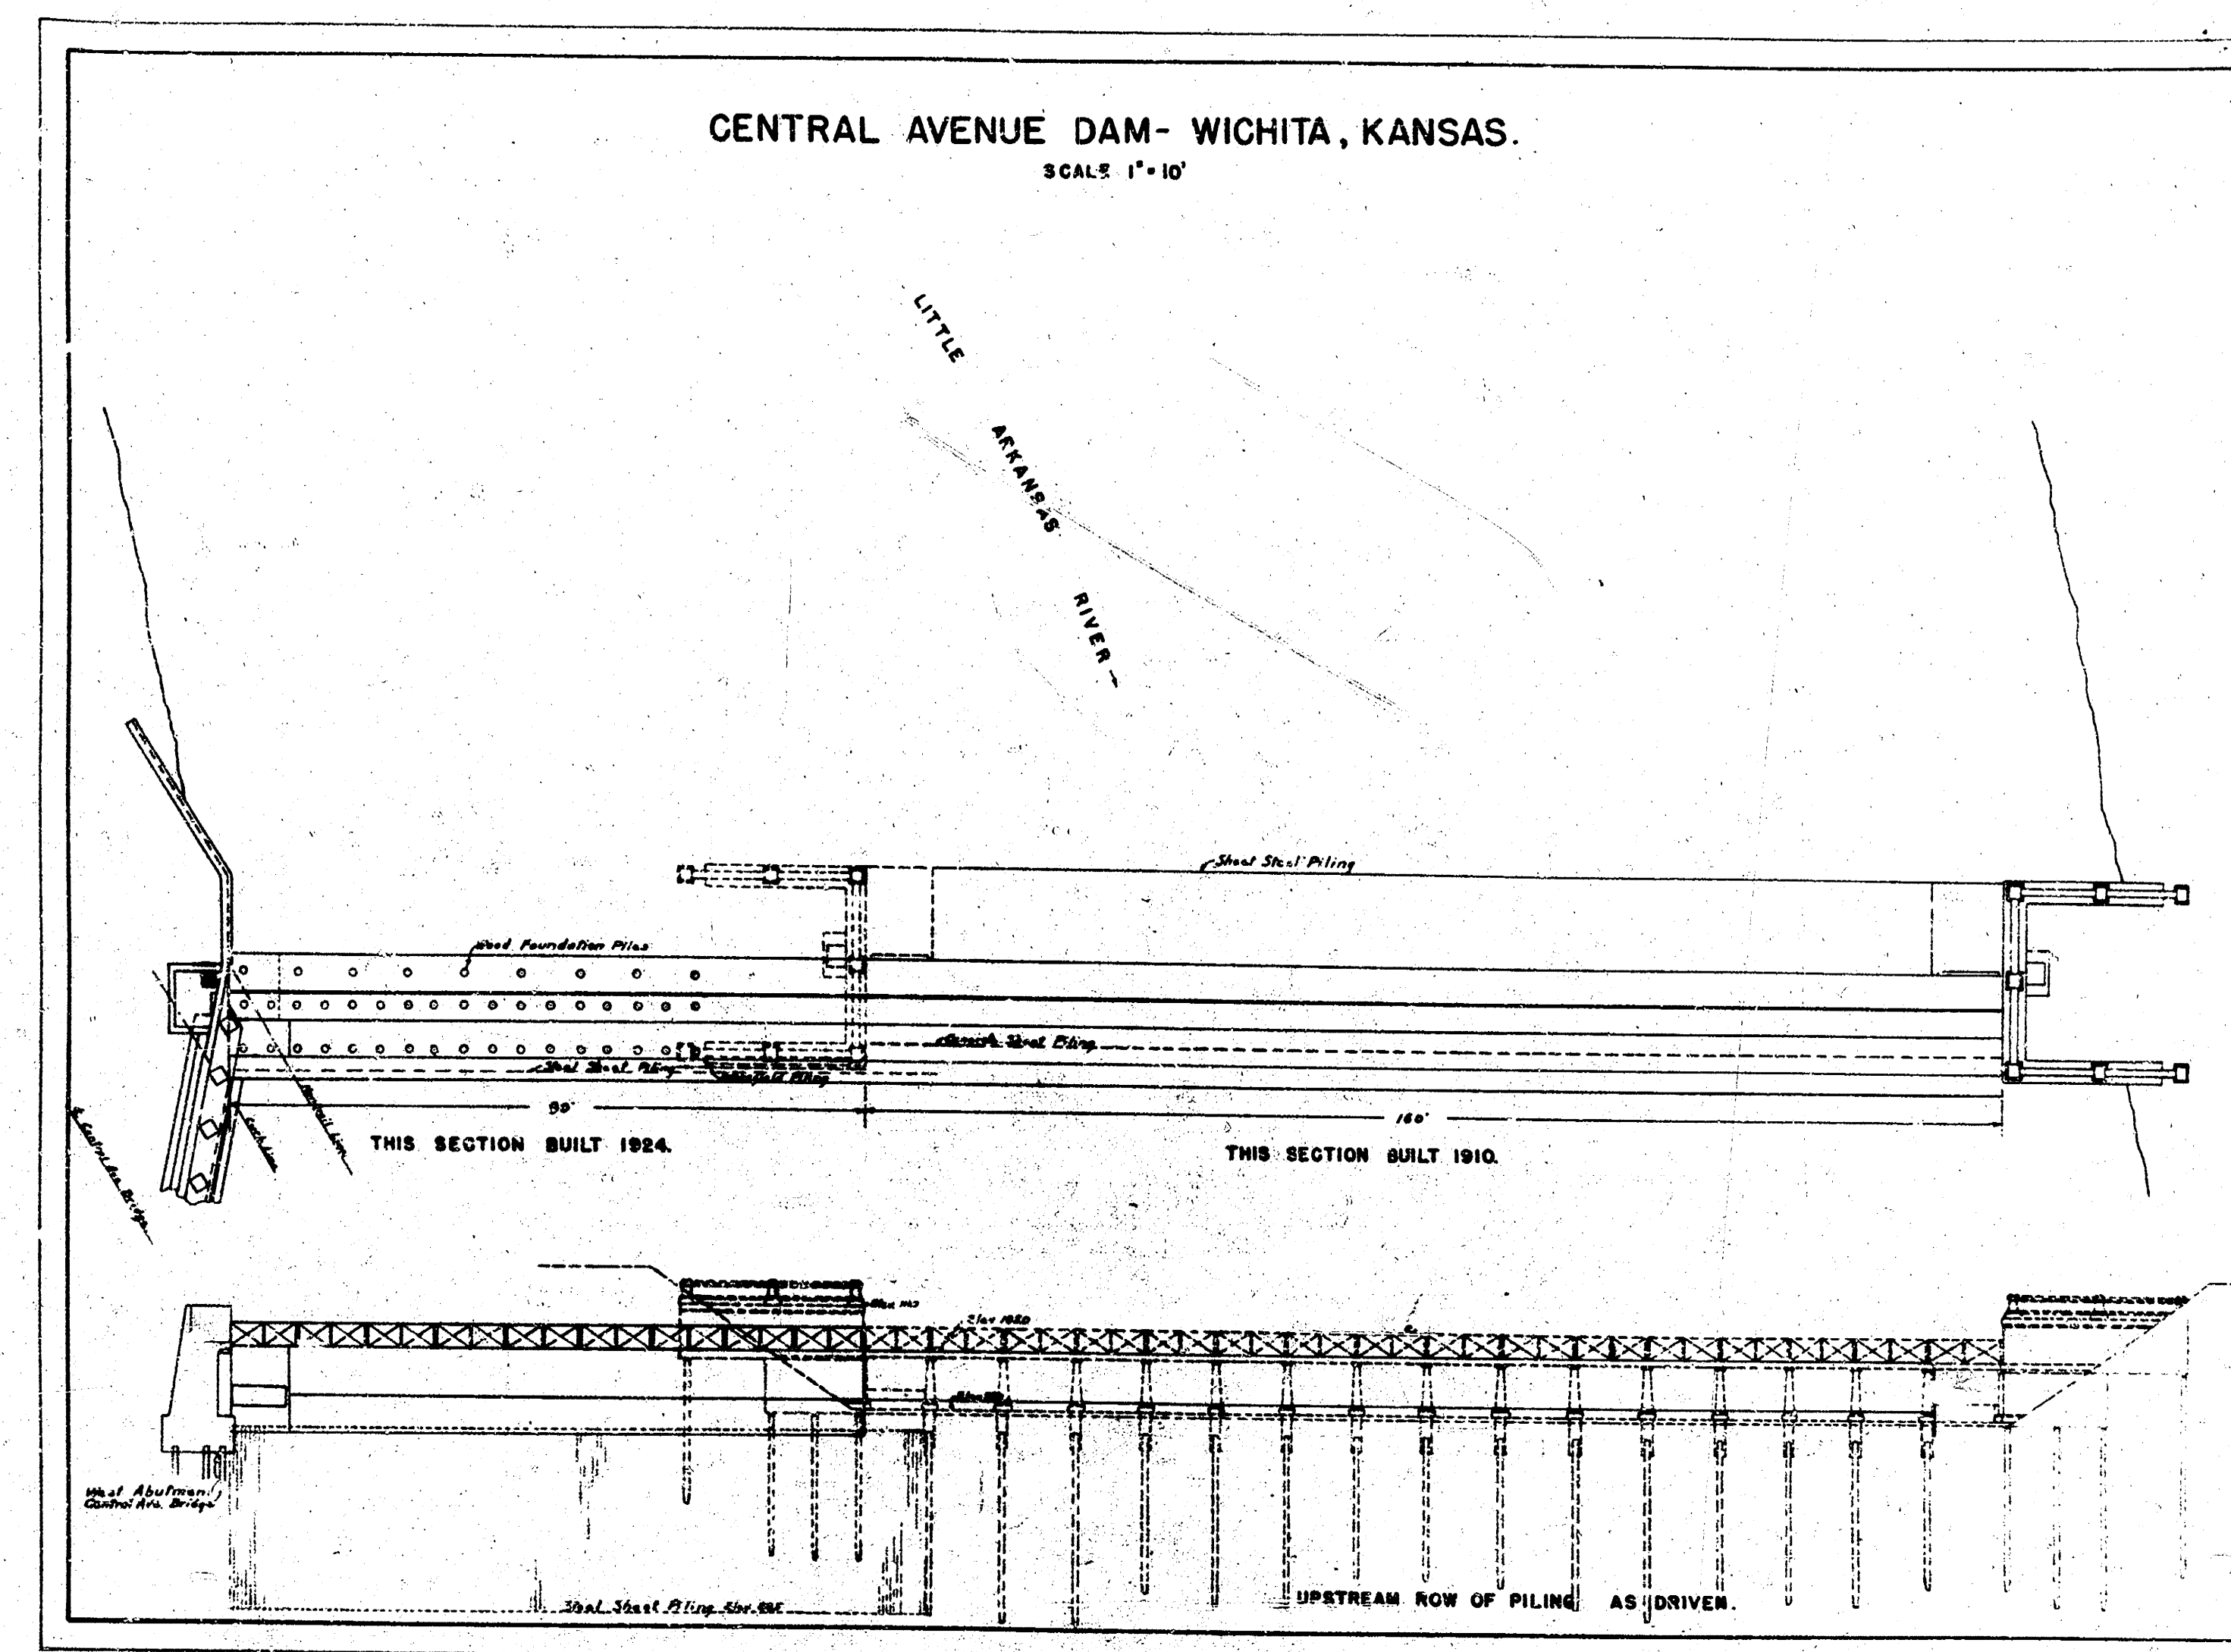


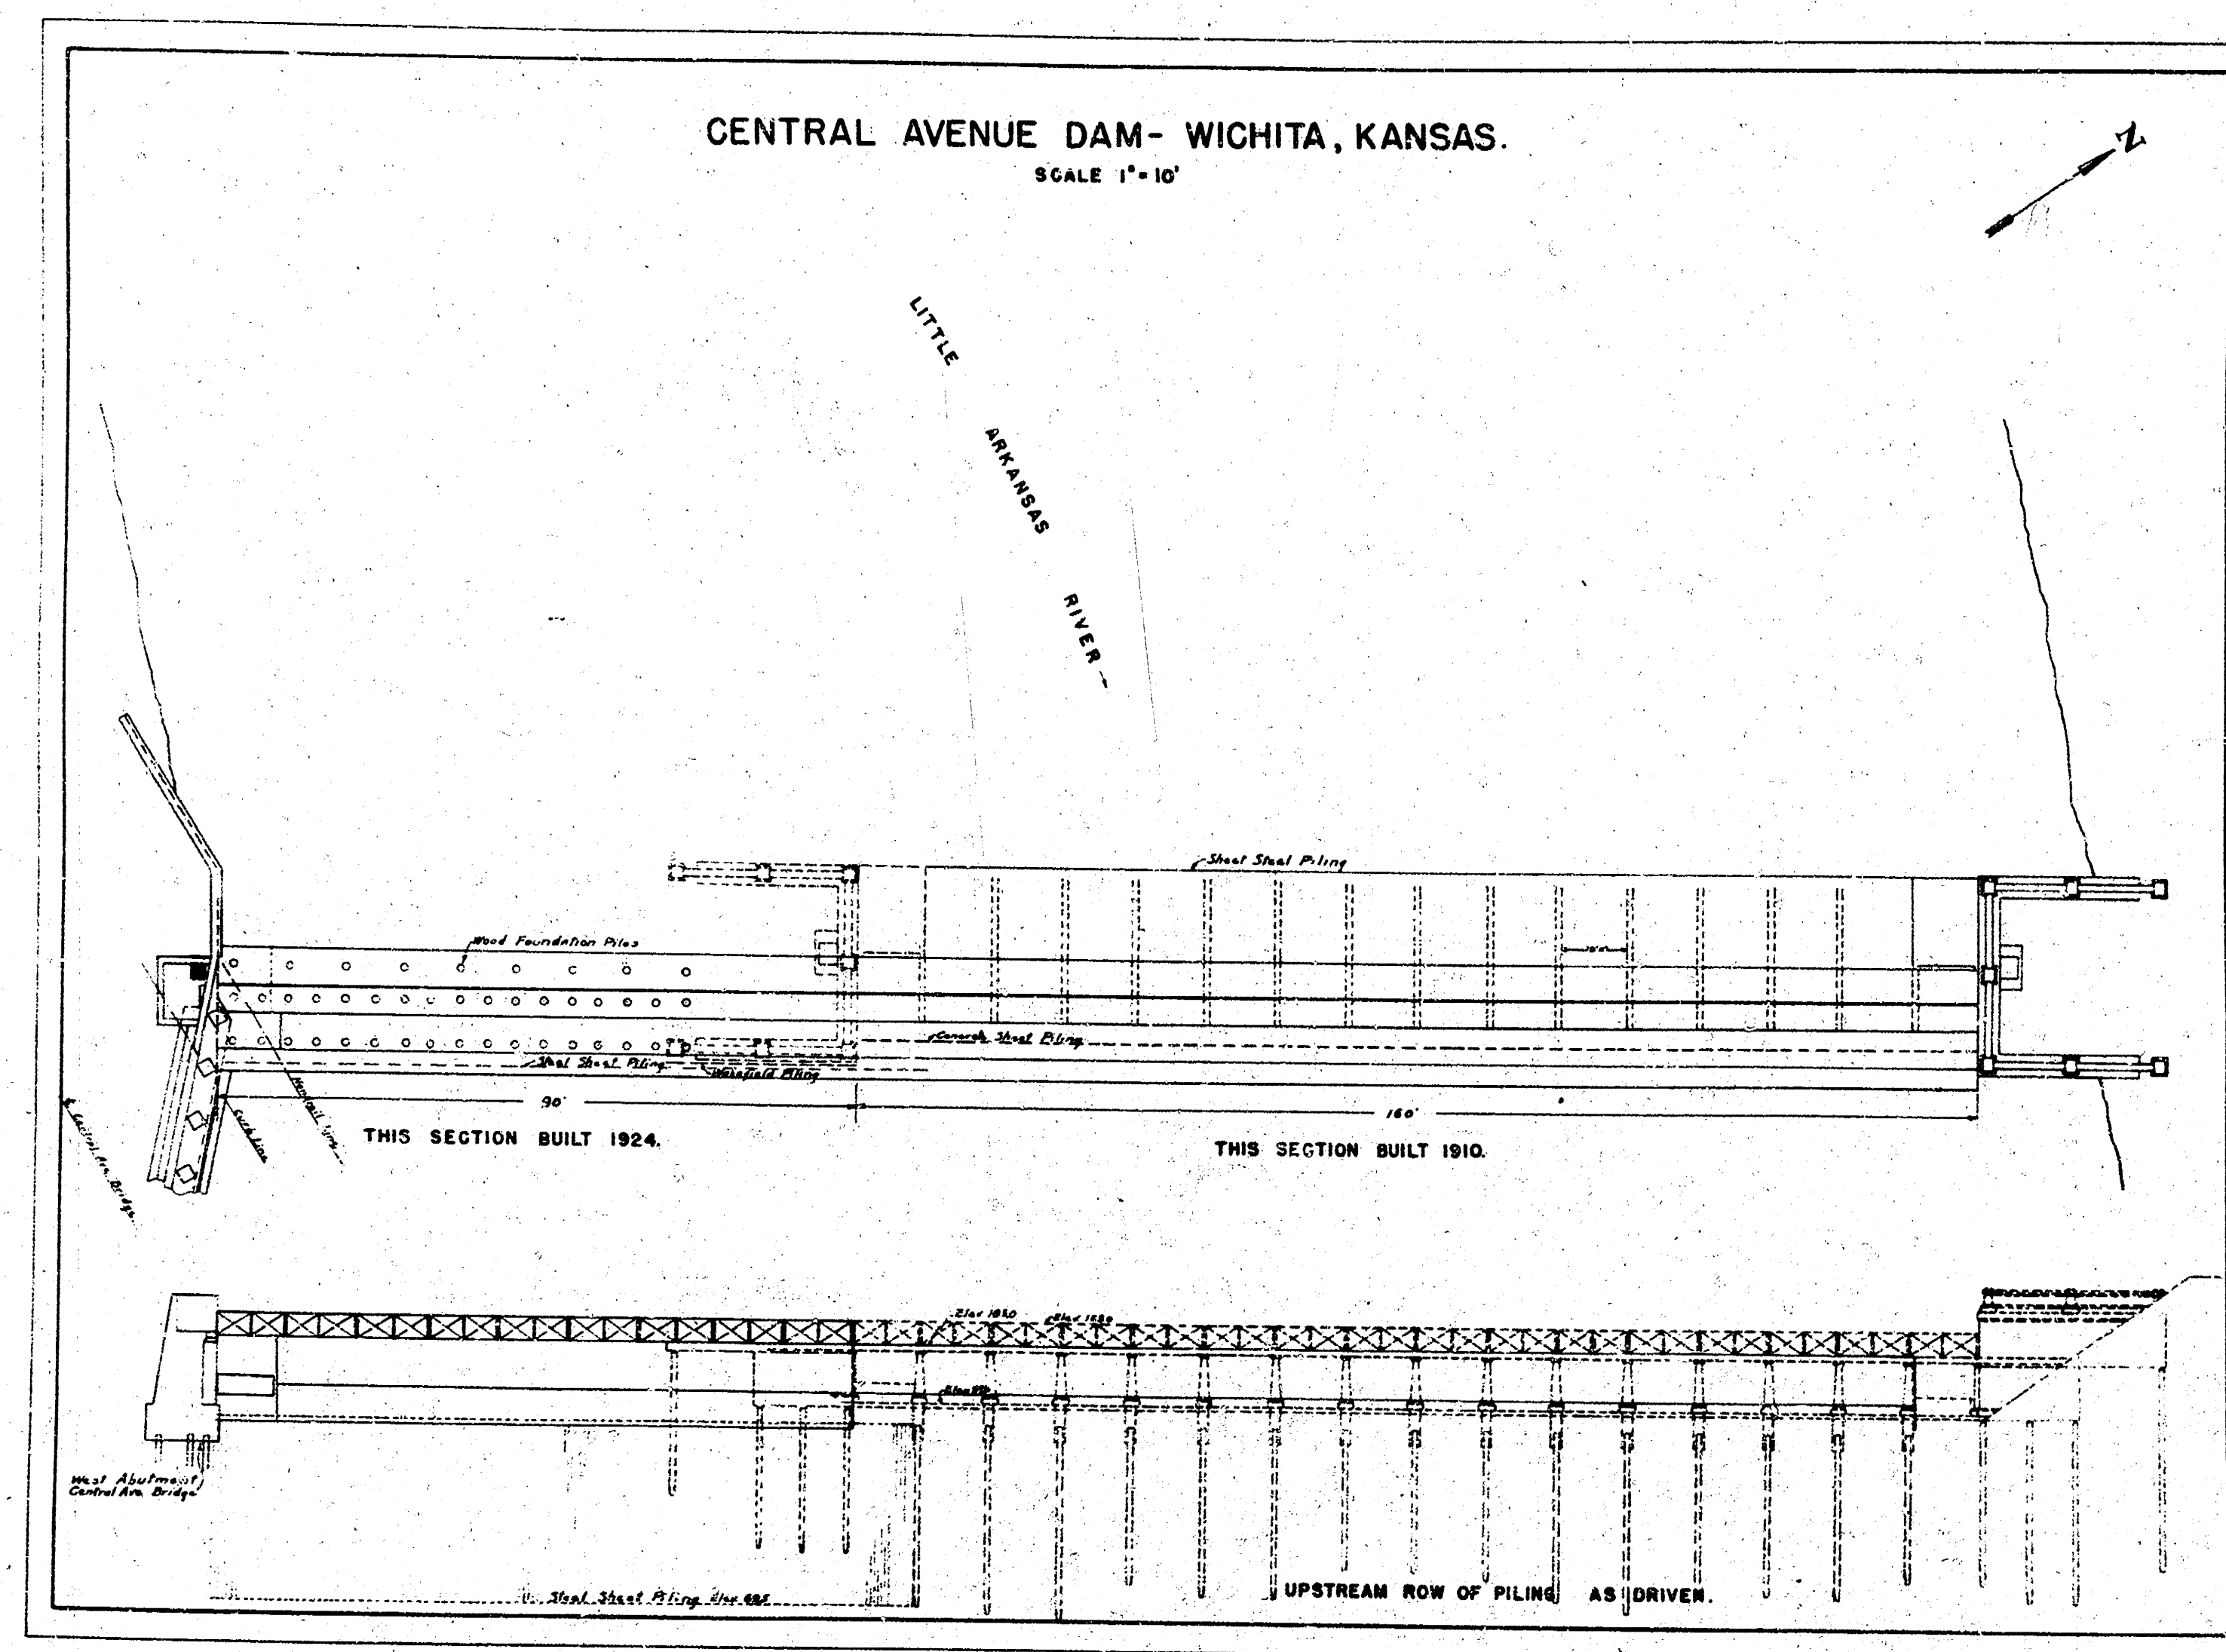


CENTRAL AVENUE DAM - WICHITA, KANSAS.

SCALE 1"=10'

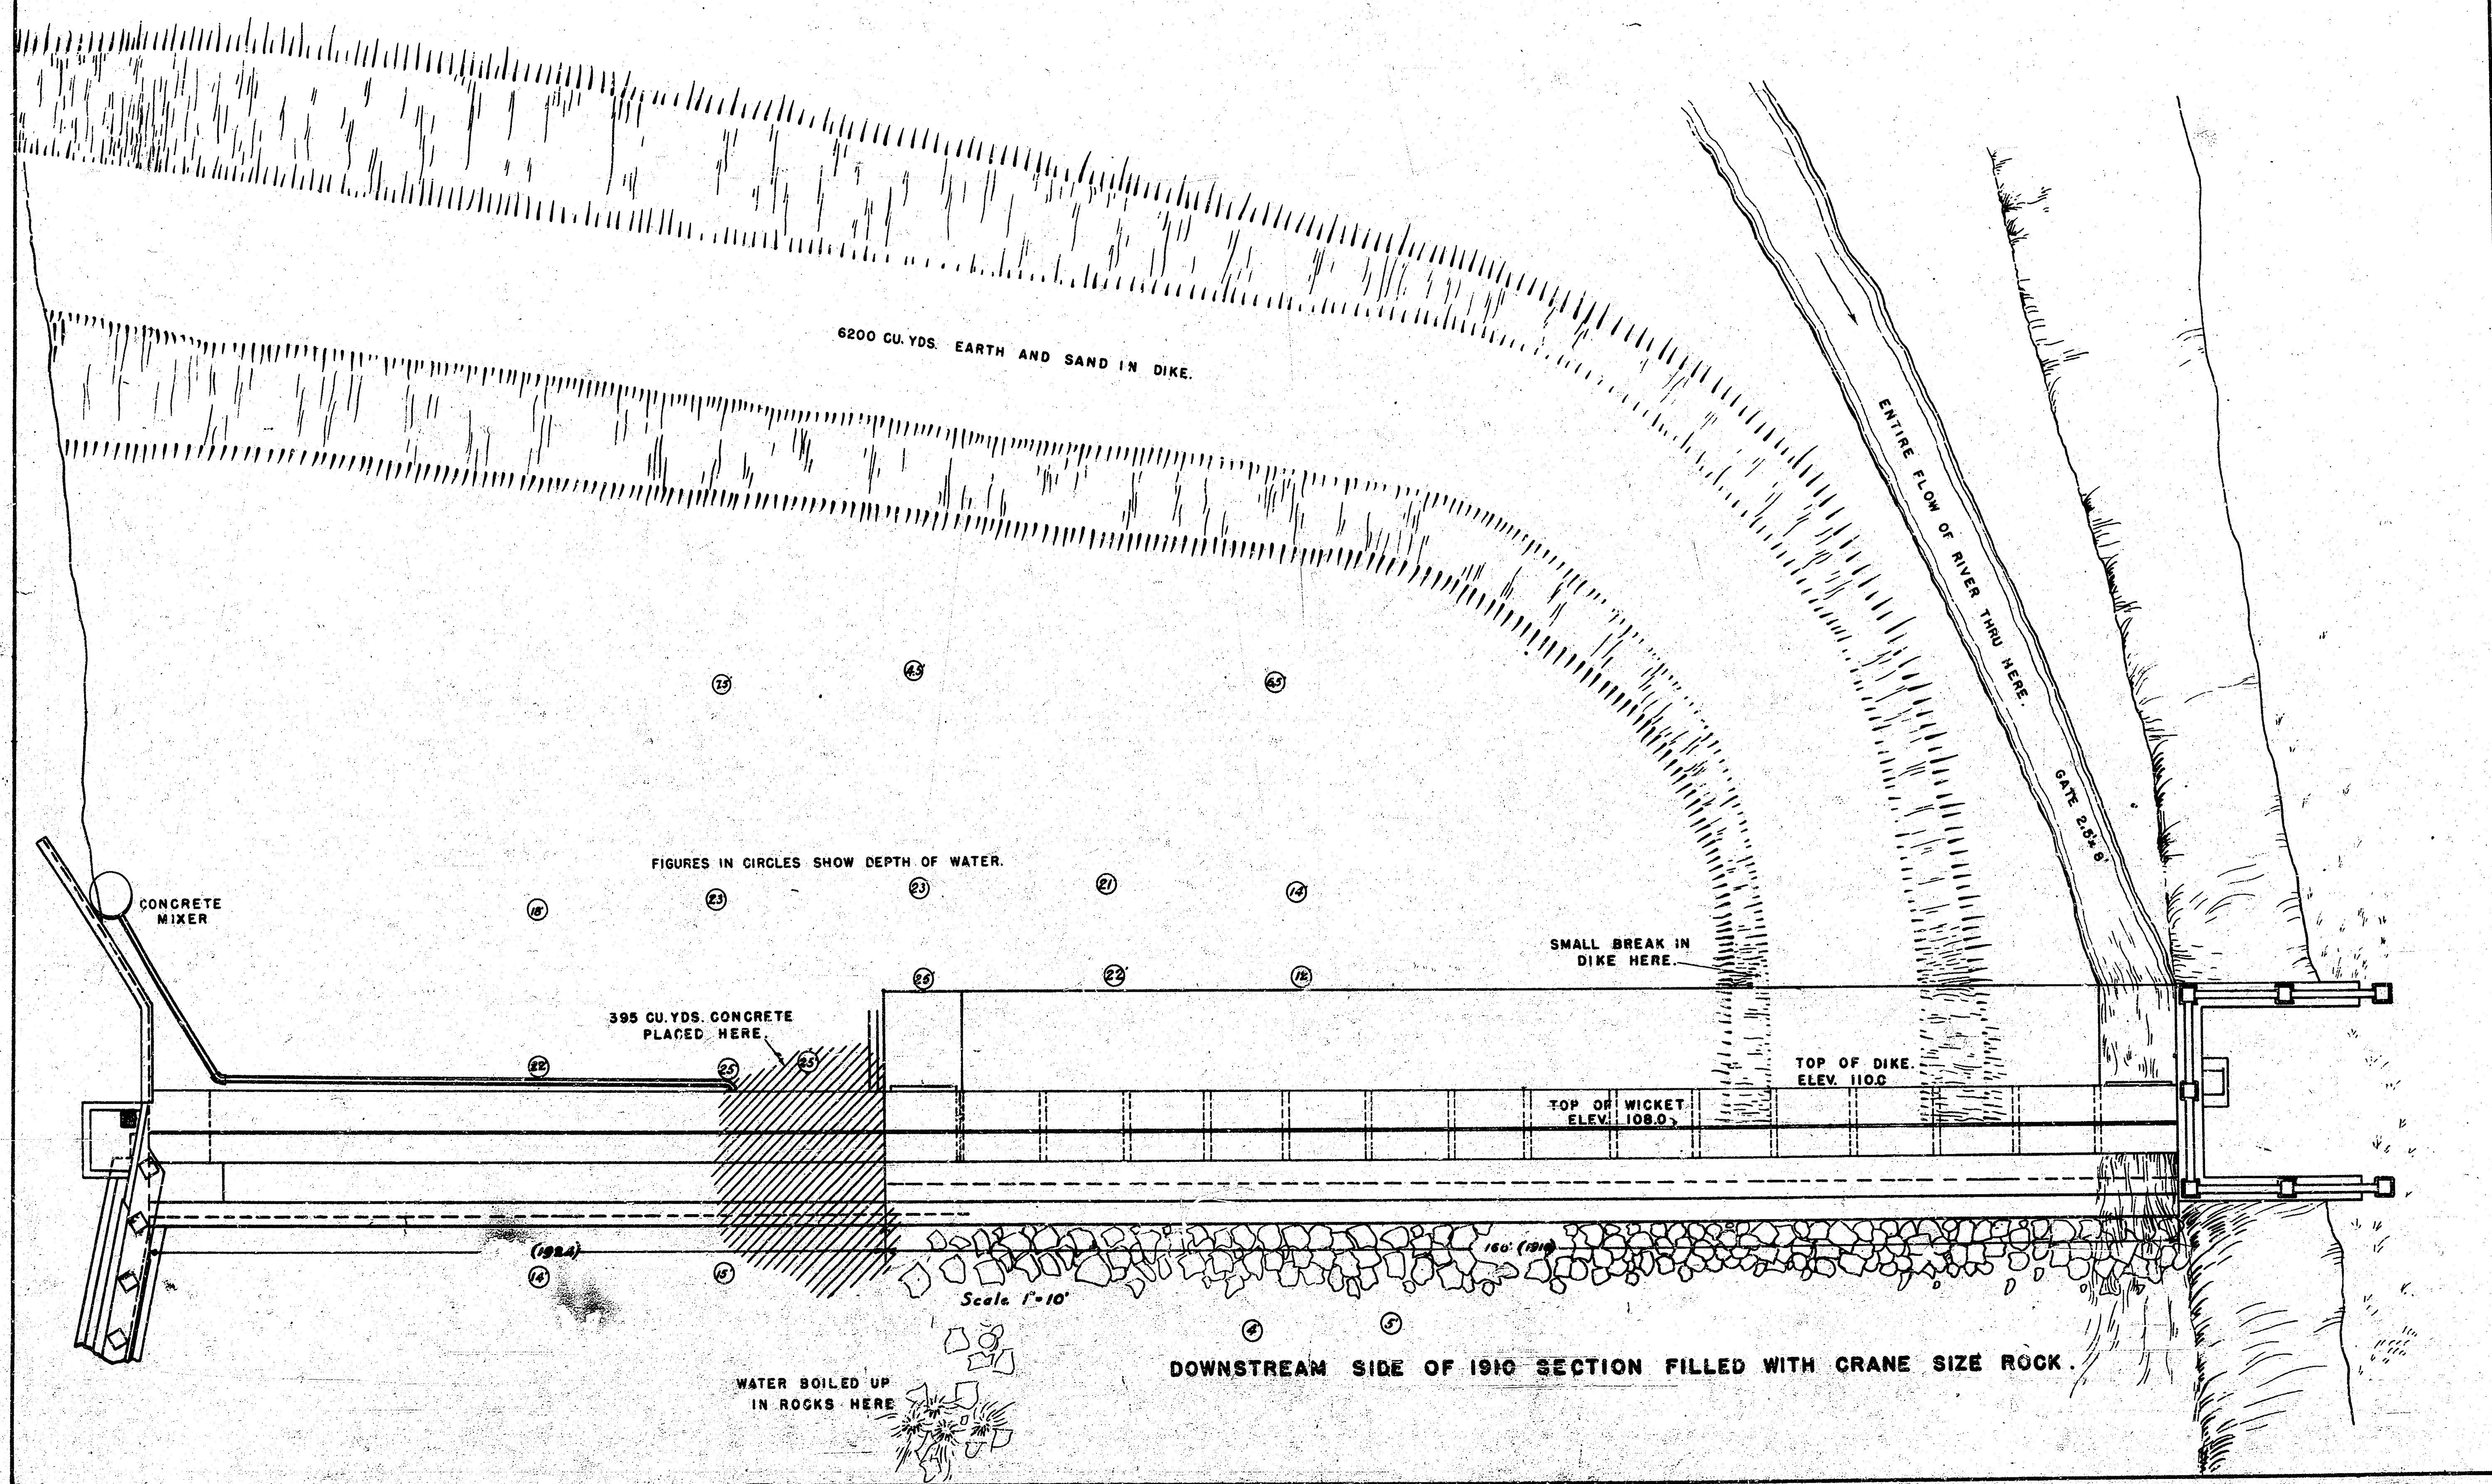


CENTRAL AVENUE DAM - WICHITA, KANSAS.


SCALE 1"=10'

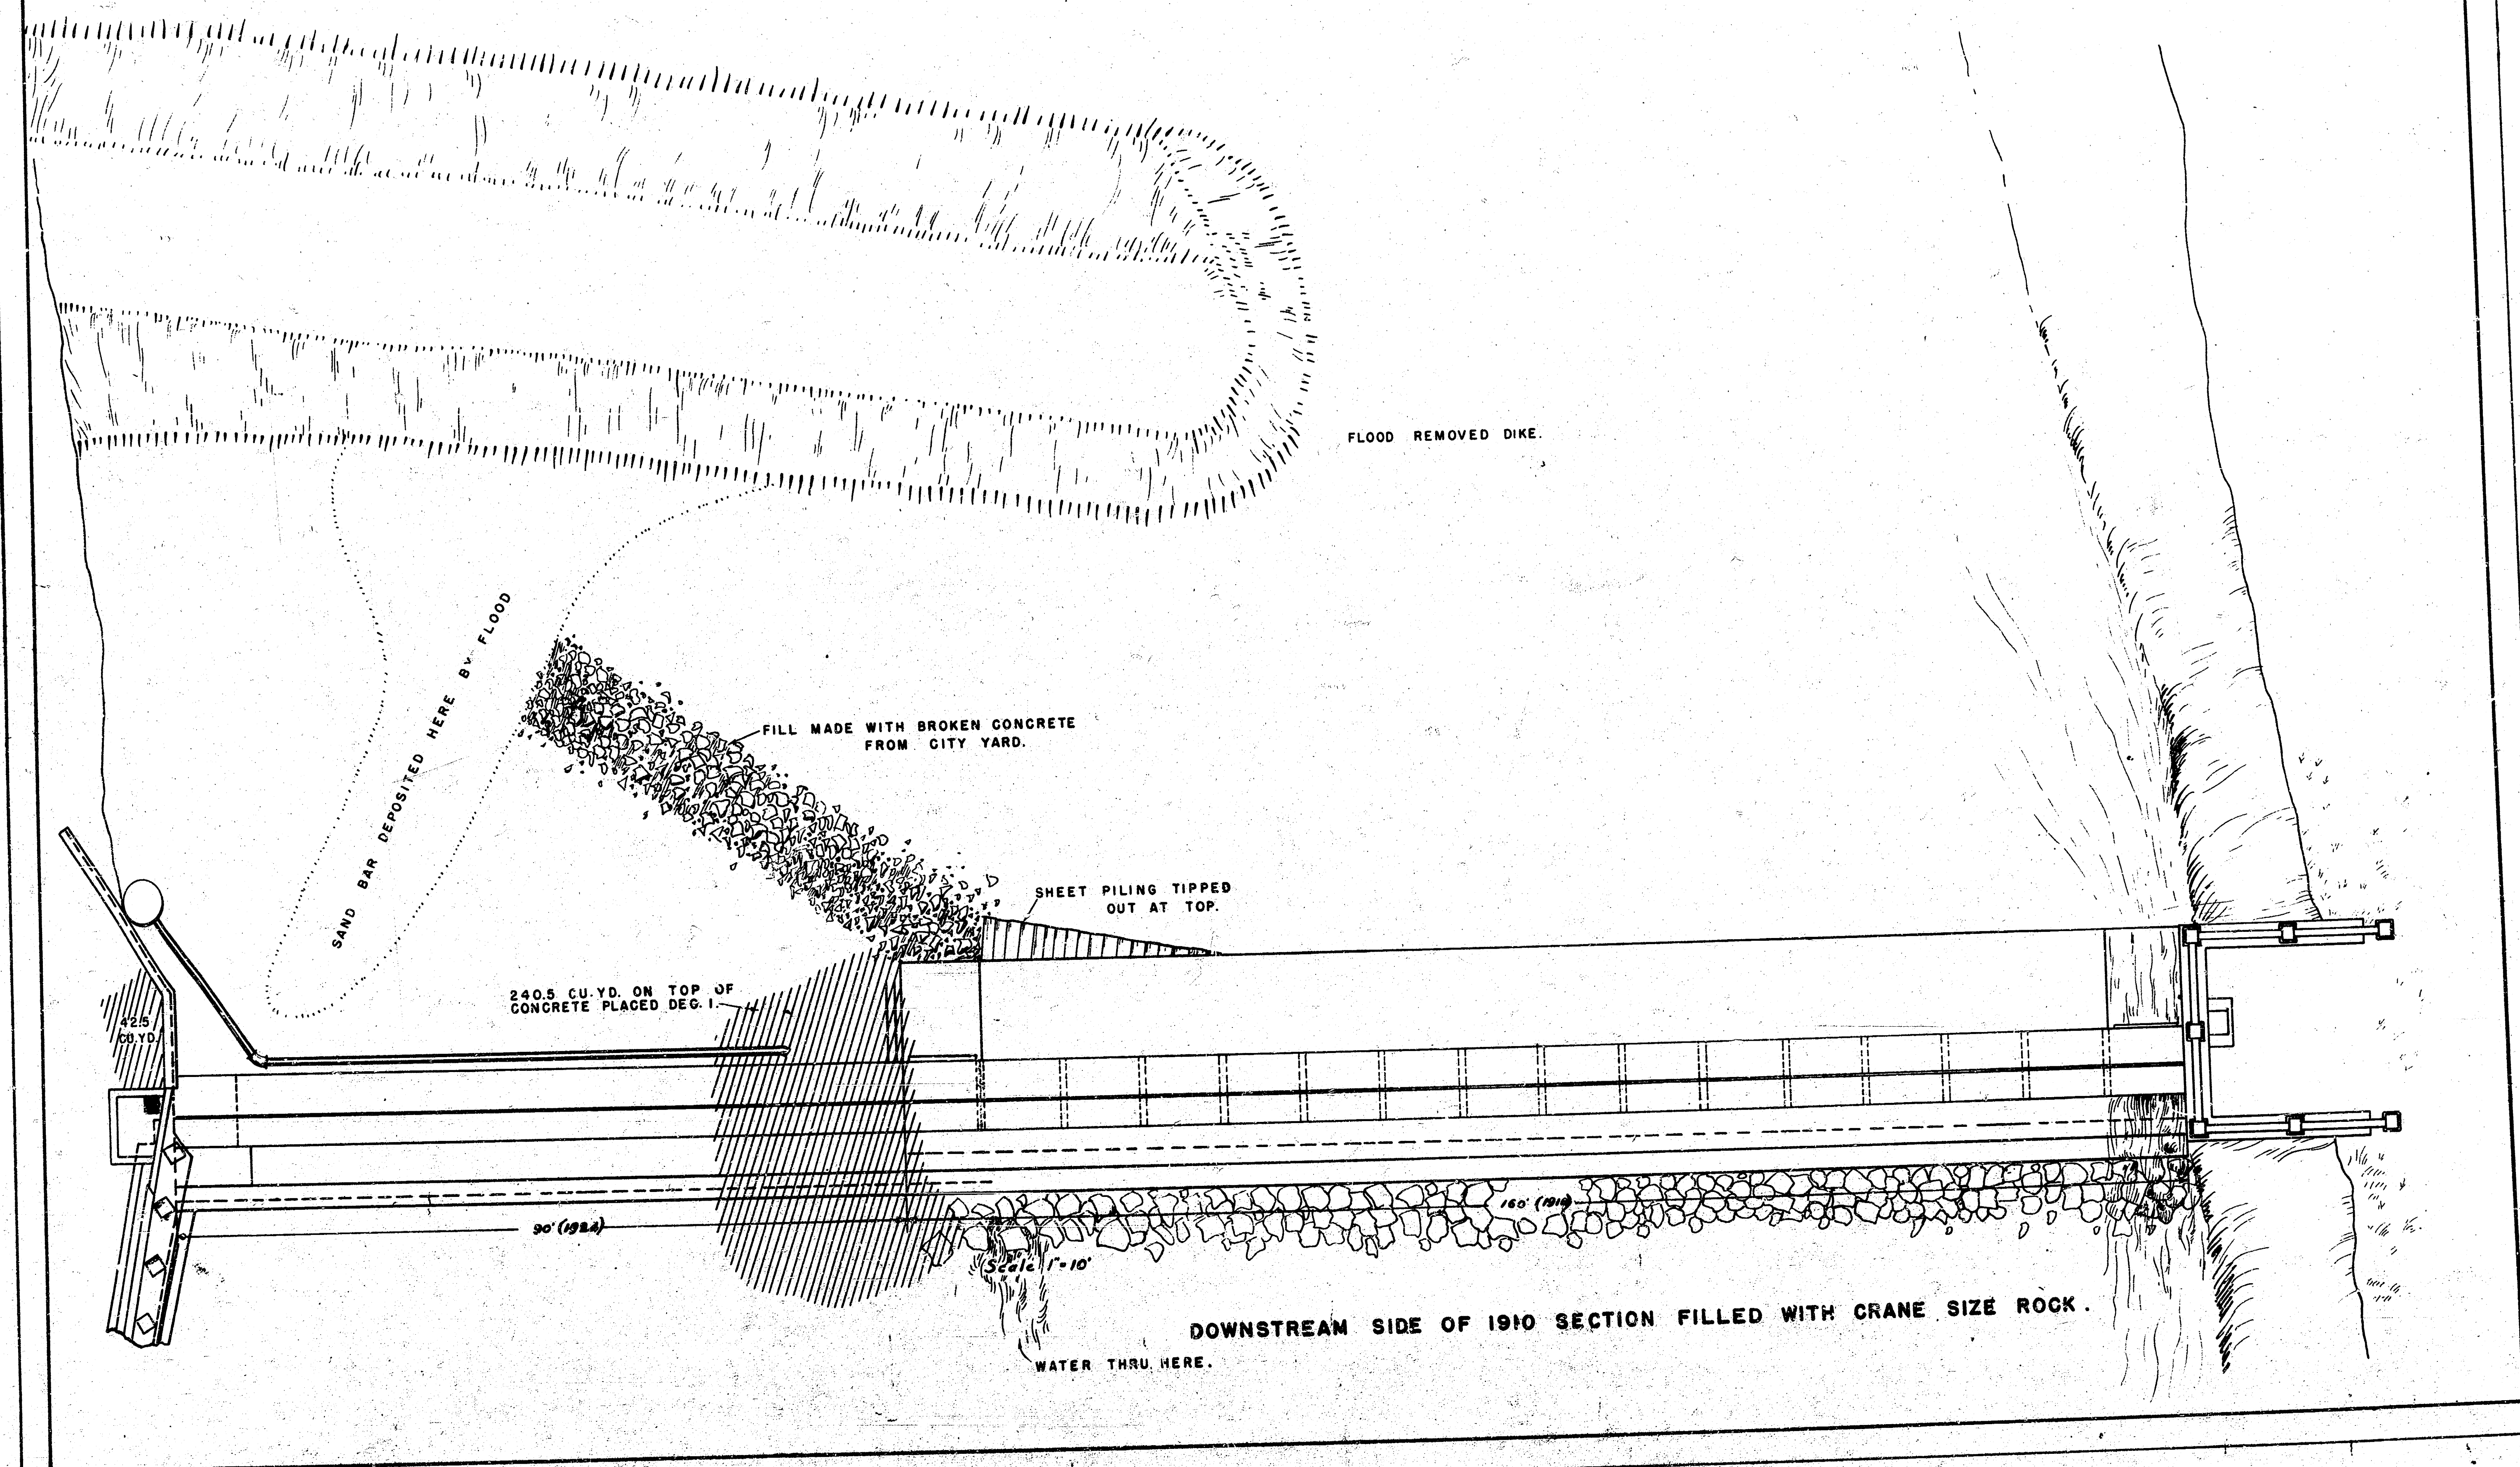

CENTRAL AVENUE DAM - WICHITA, KANSAS.

SCALE 1"=10'

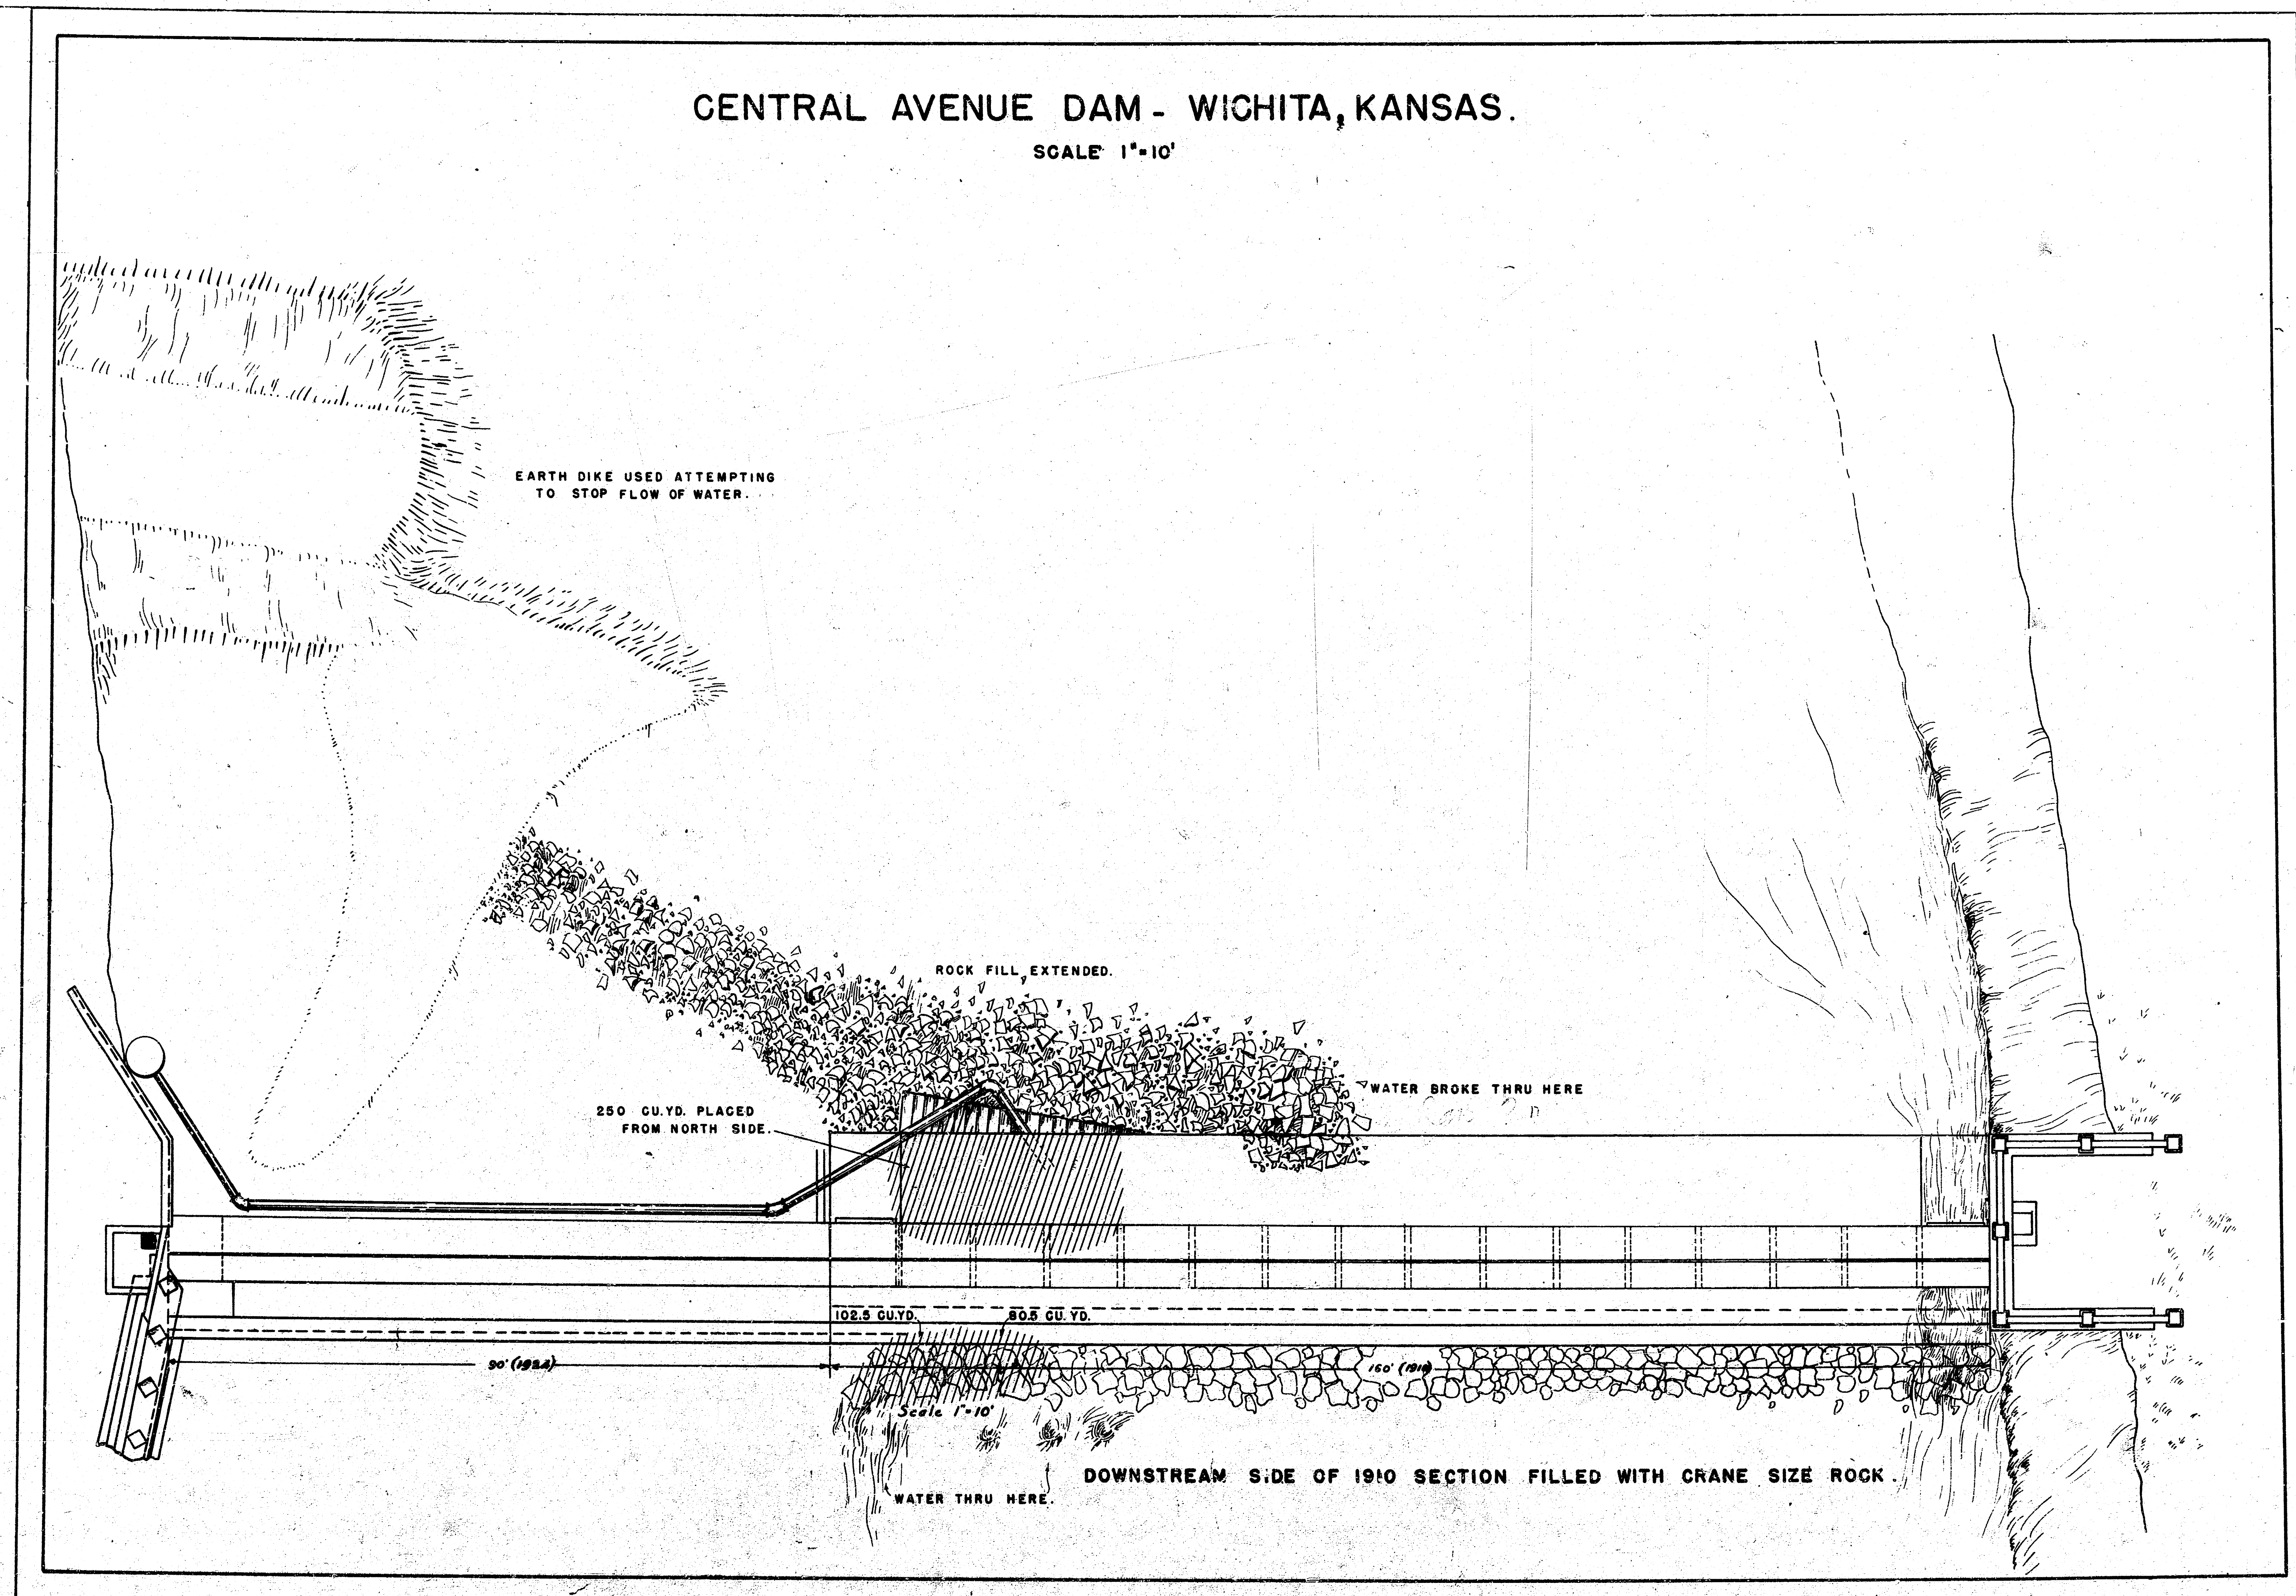


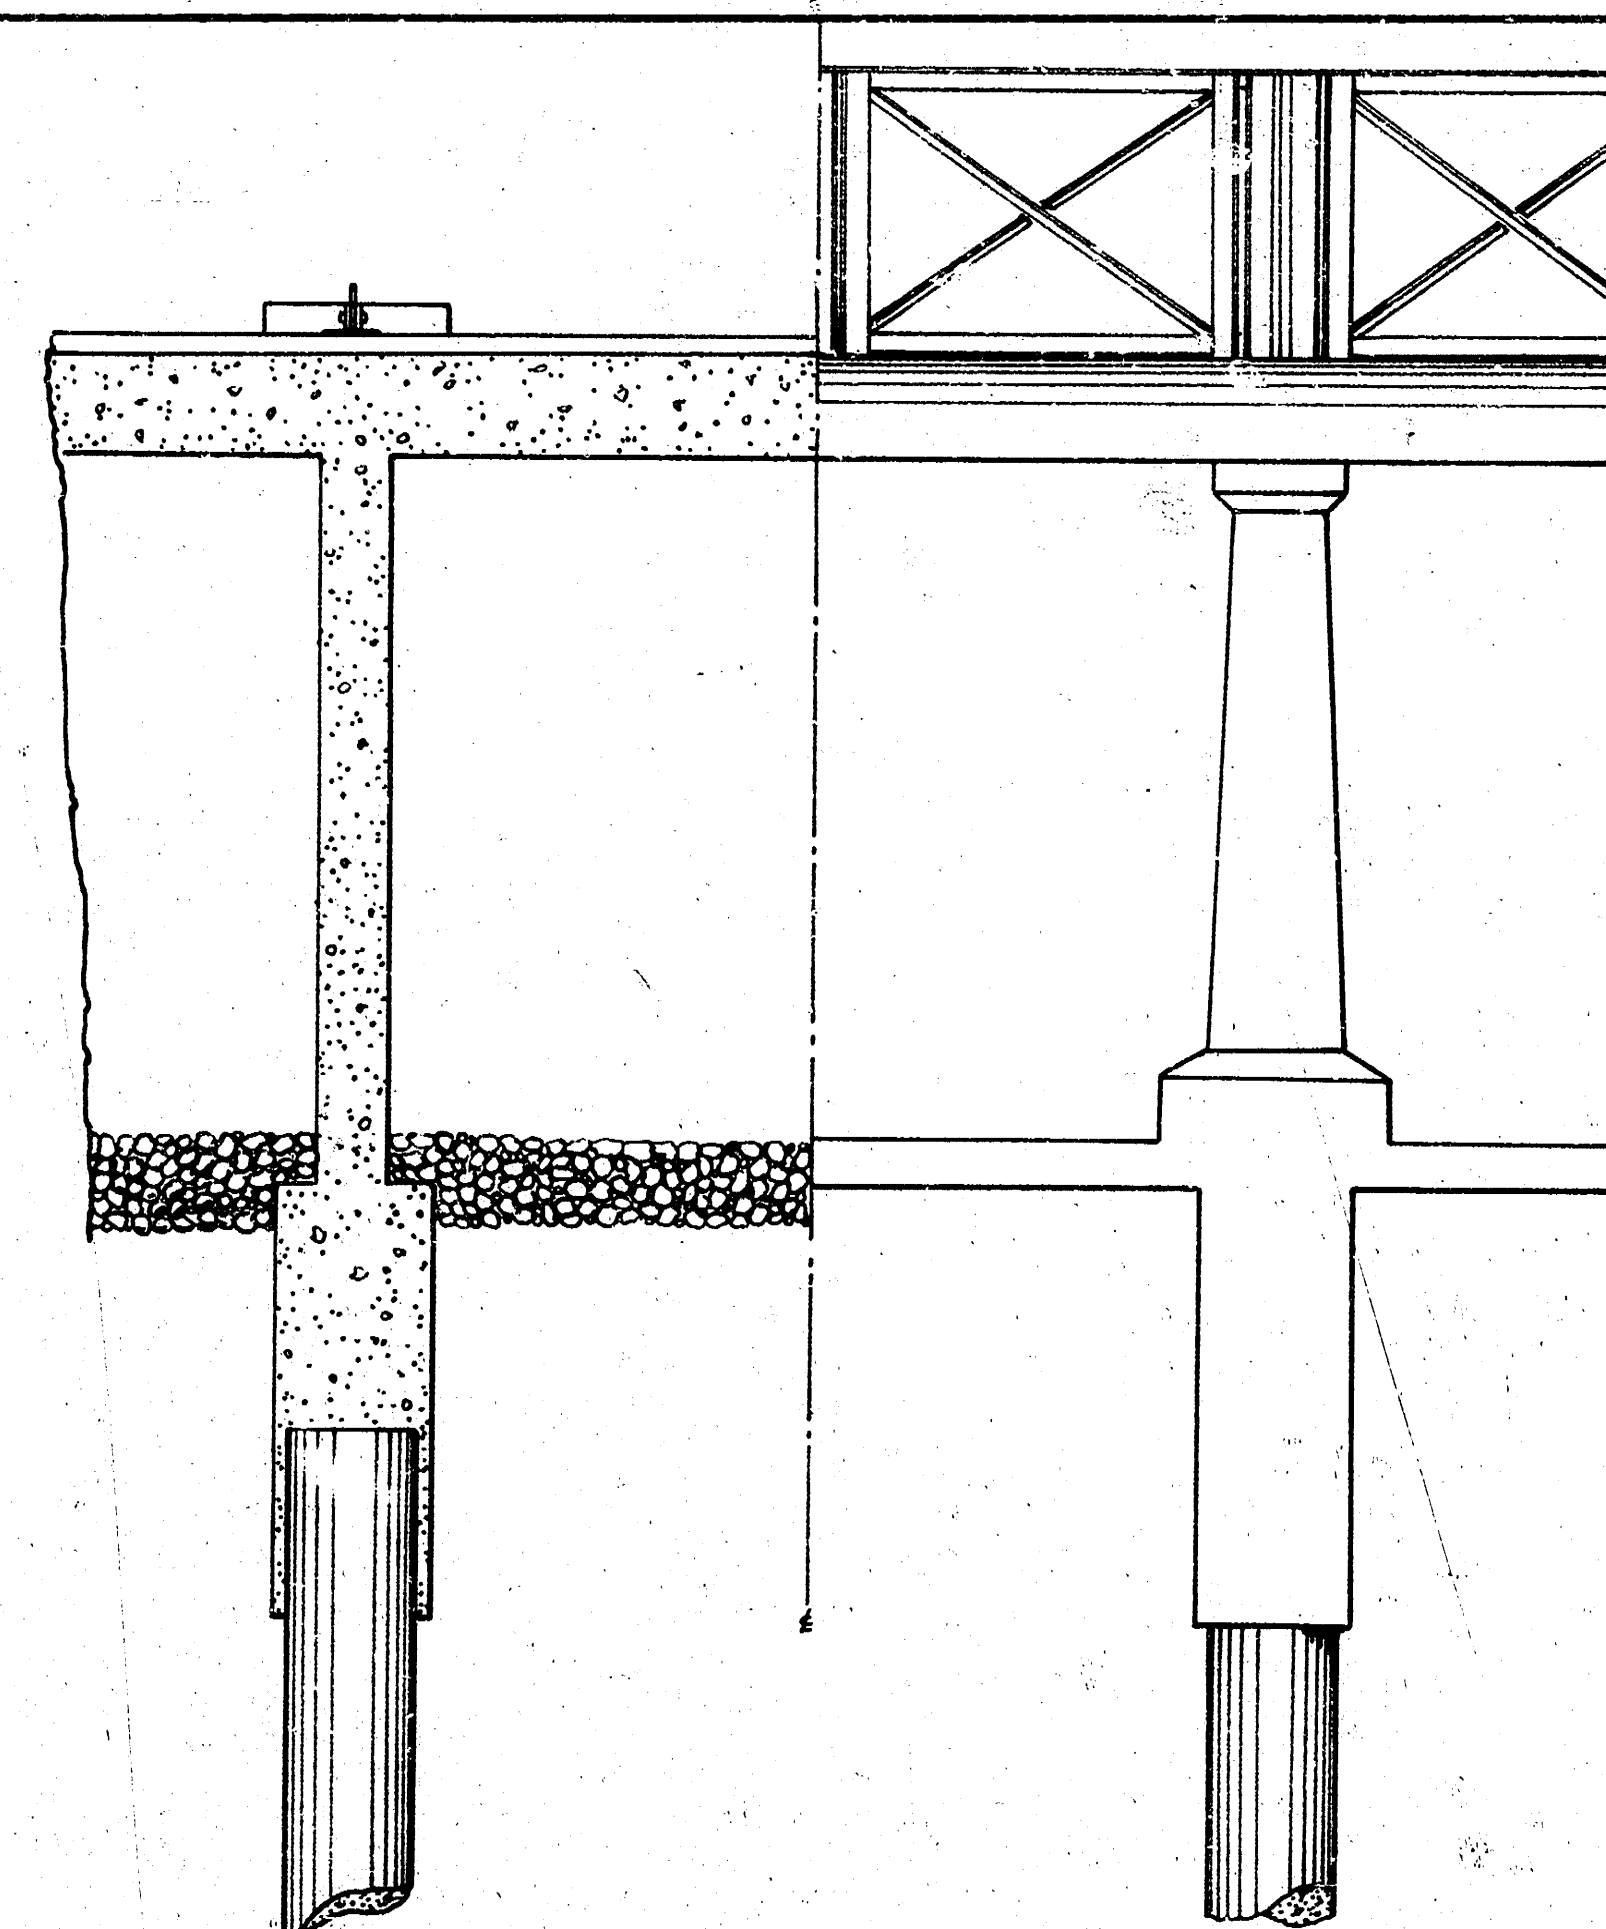

ELEVATION & SECTION - DOWNSTREAM SIDE.
BUILT 1910.

CENTRAL AVENUE DAM - WICHITA, KANSAS.

SCALE $\frac{1}{2}'' = 1'$

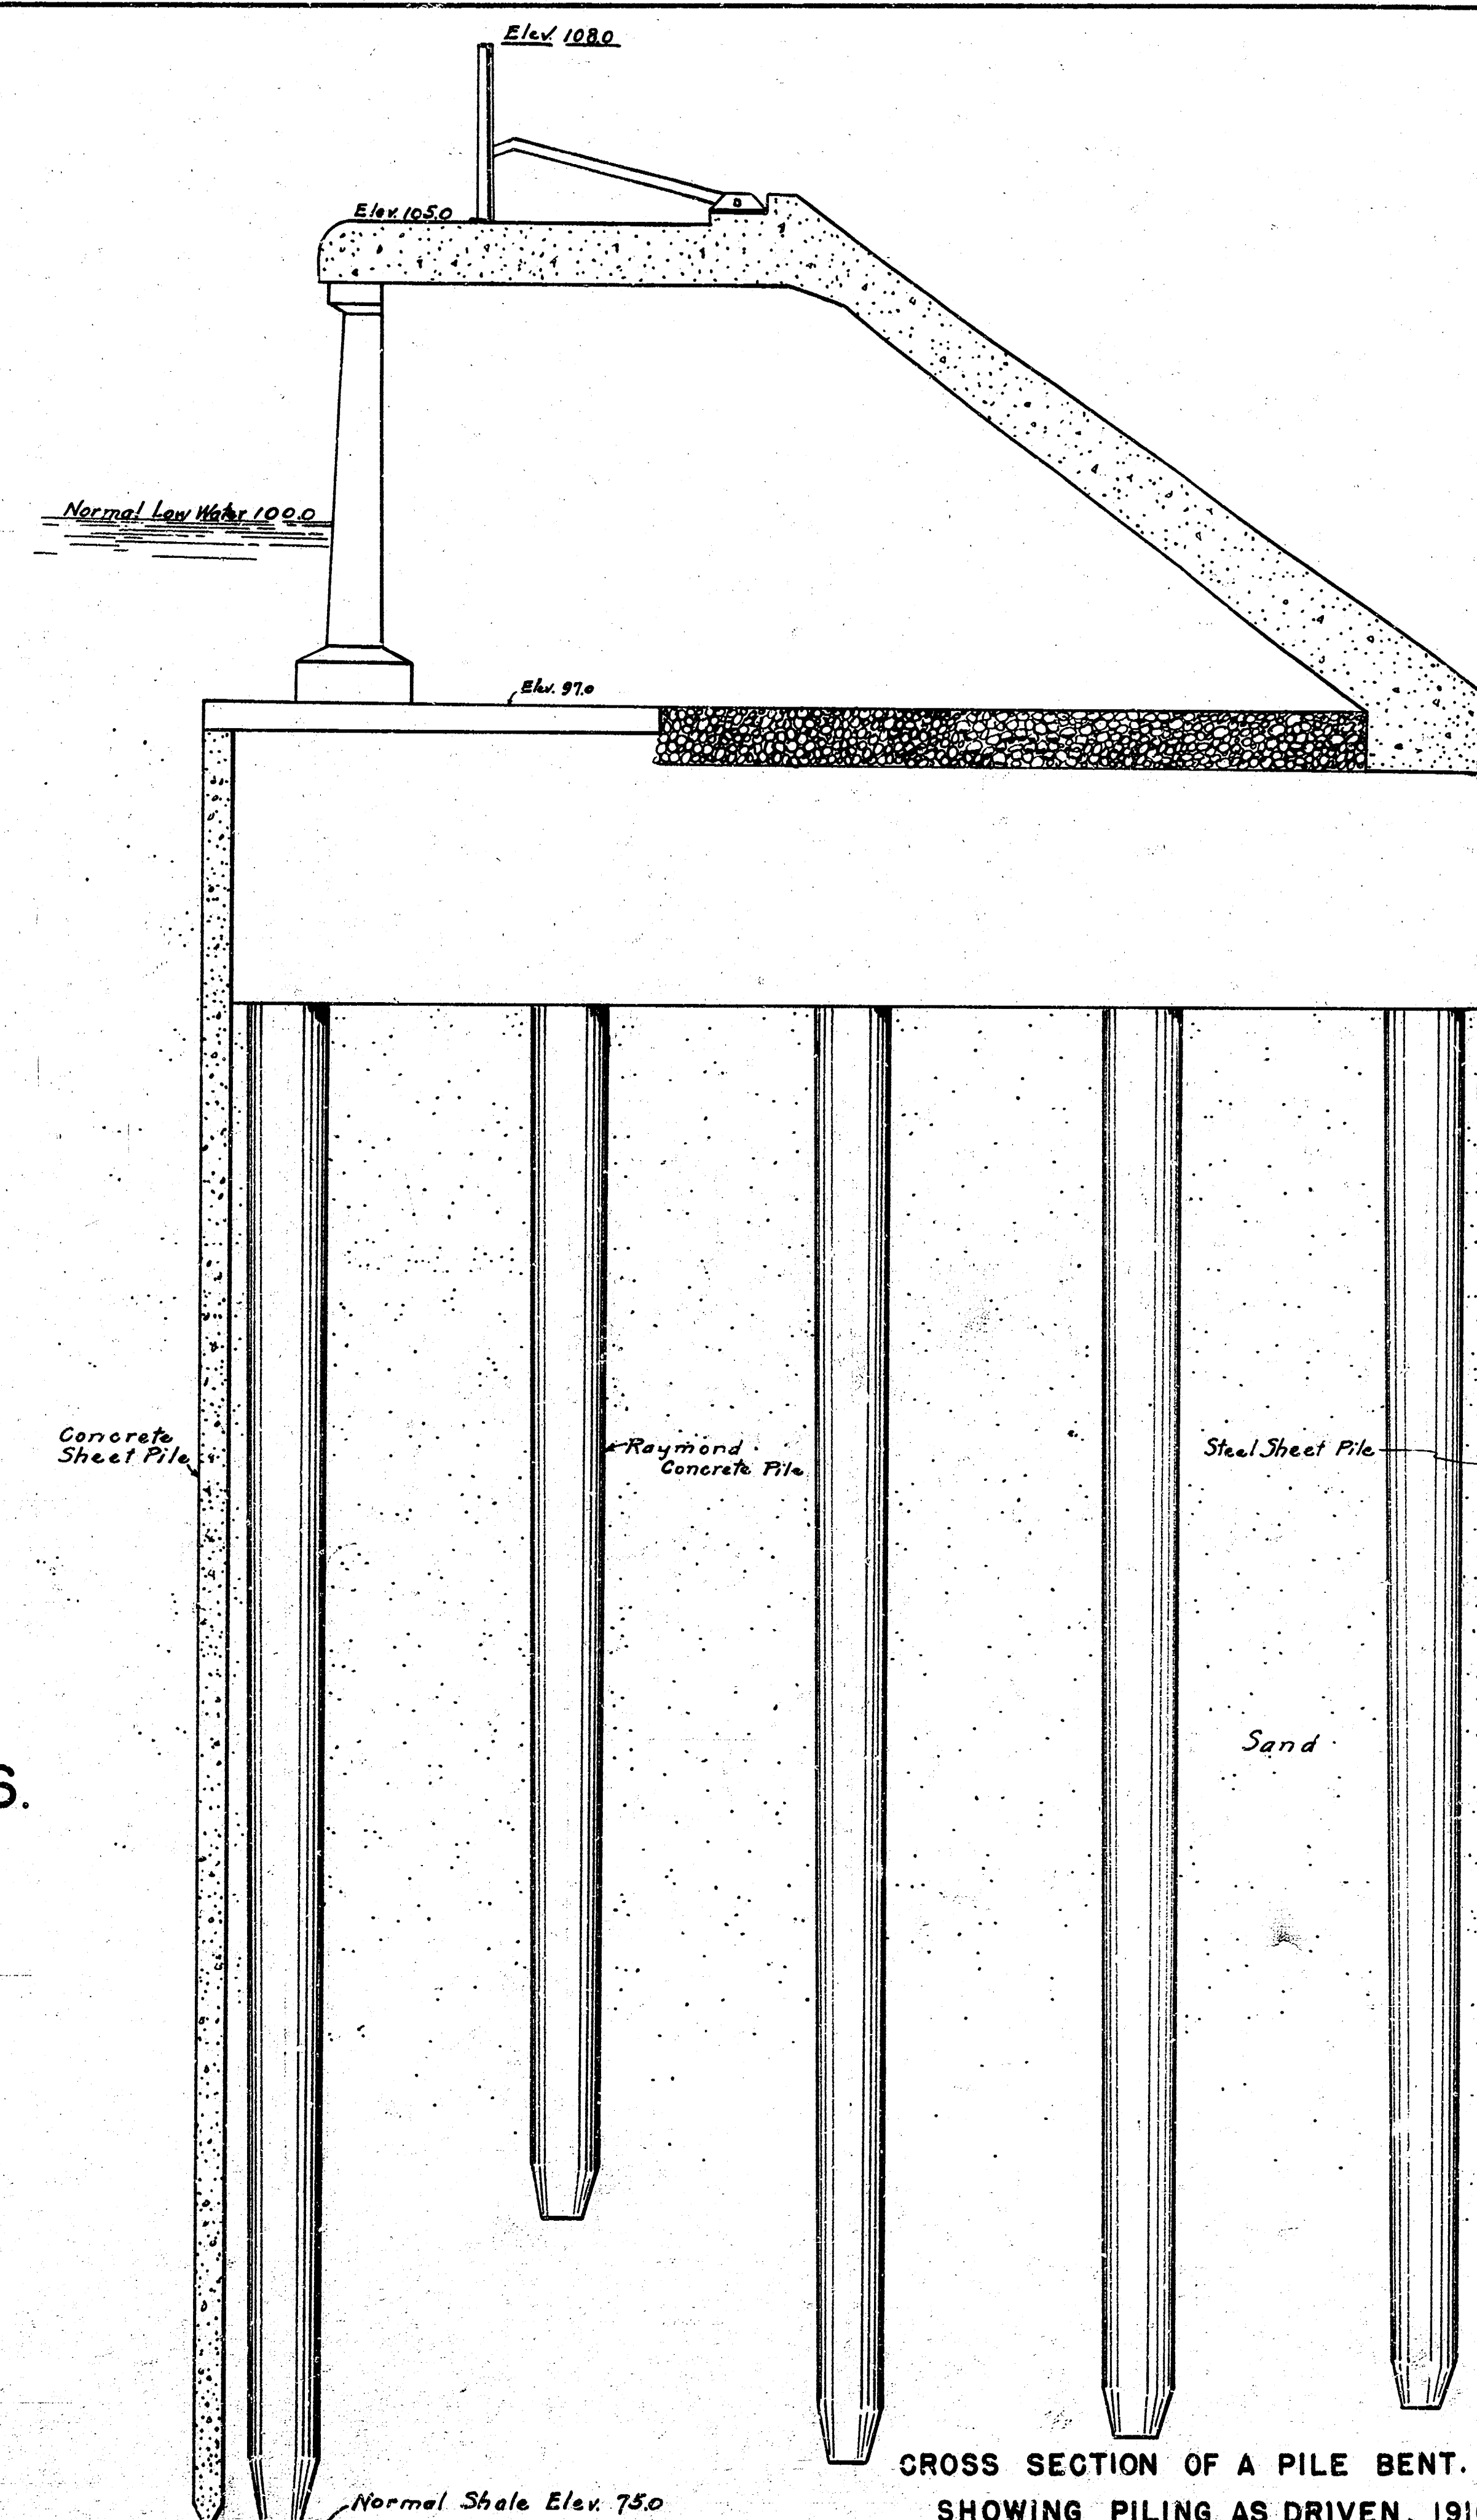


CROSS SECTION OF A PILE BENT.
SHOWING PILING AS DRIVEN, 1910.

Elevation and Section Downstream side
1911


Cross Section of a Pile bent showing piling as driven

CENTRAL AVENUE DAM - WICHITA, KANSAS.

SCALE $\frac{1}{2}$ " = 1'

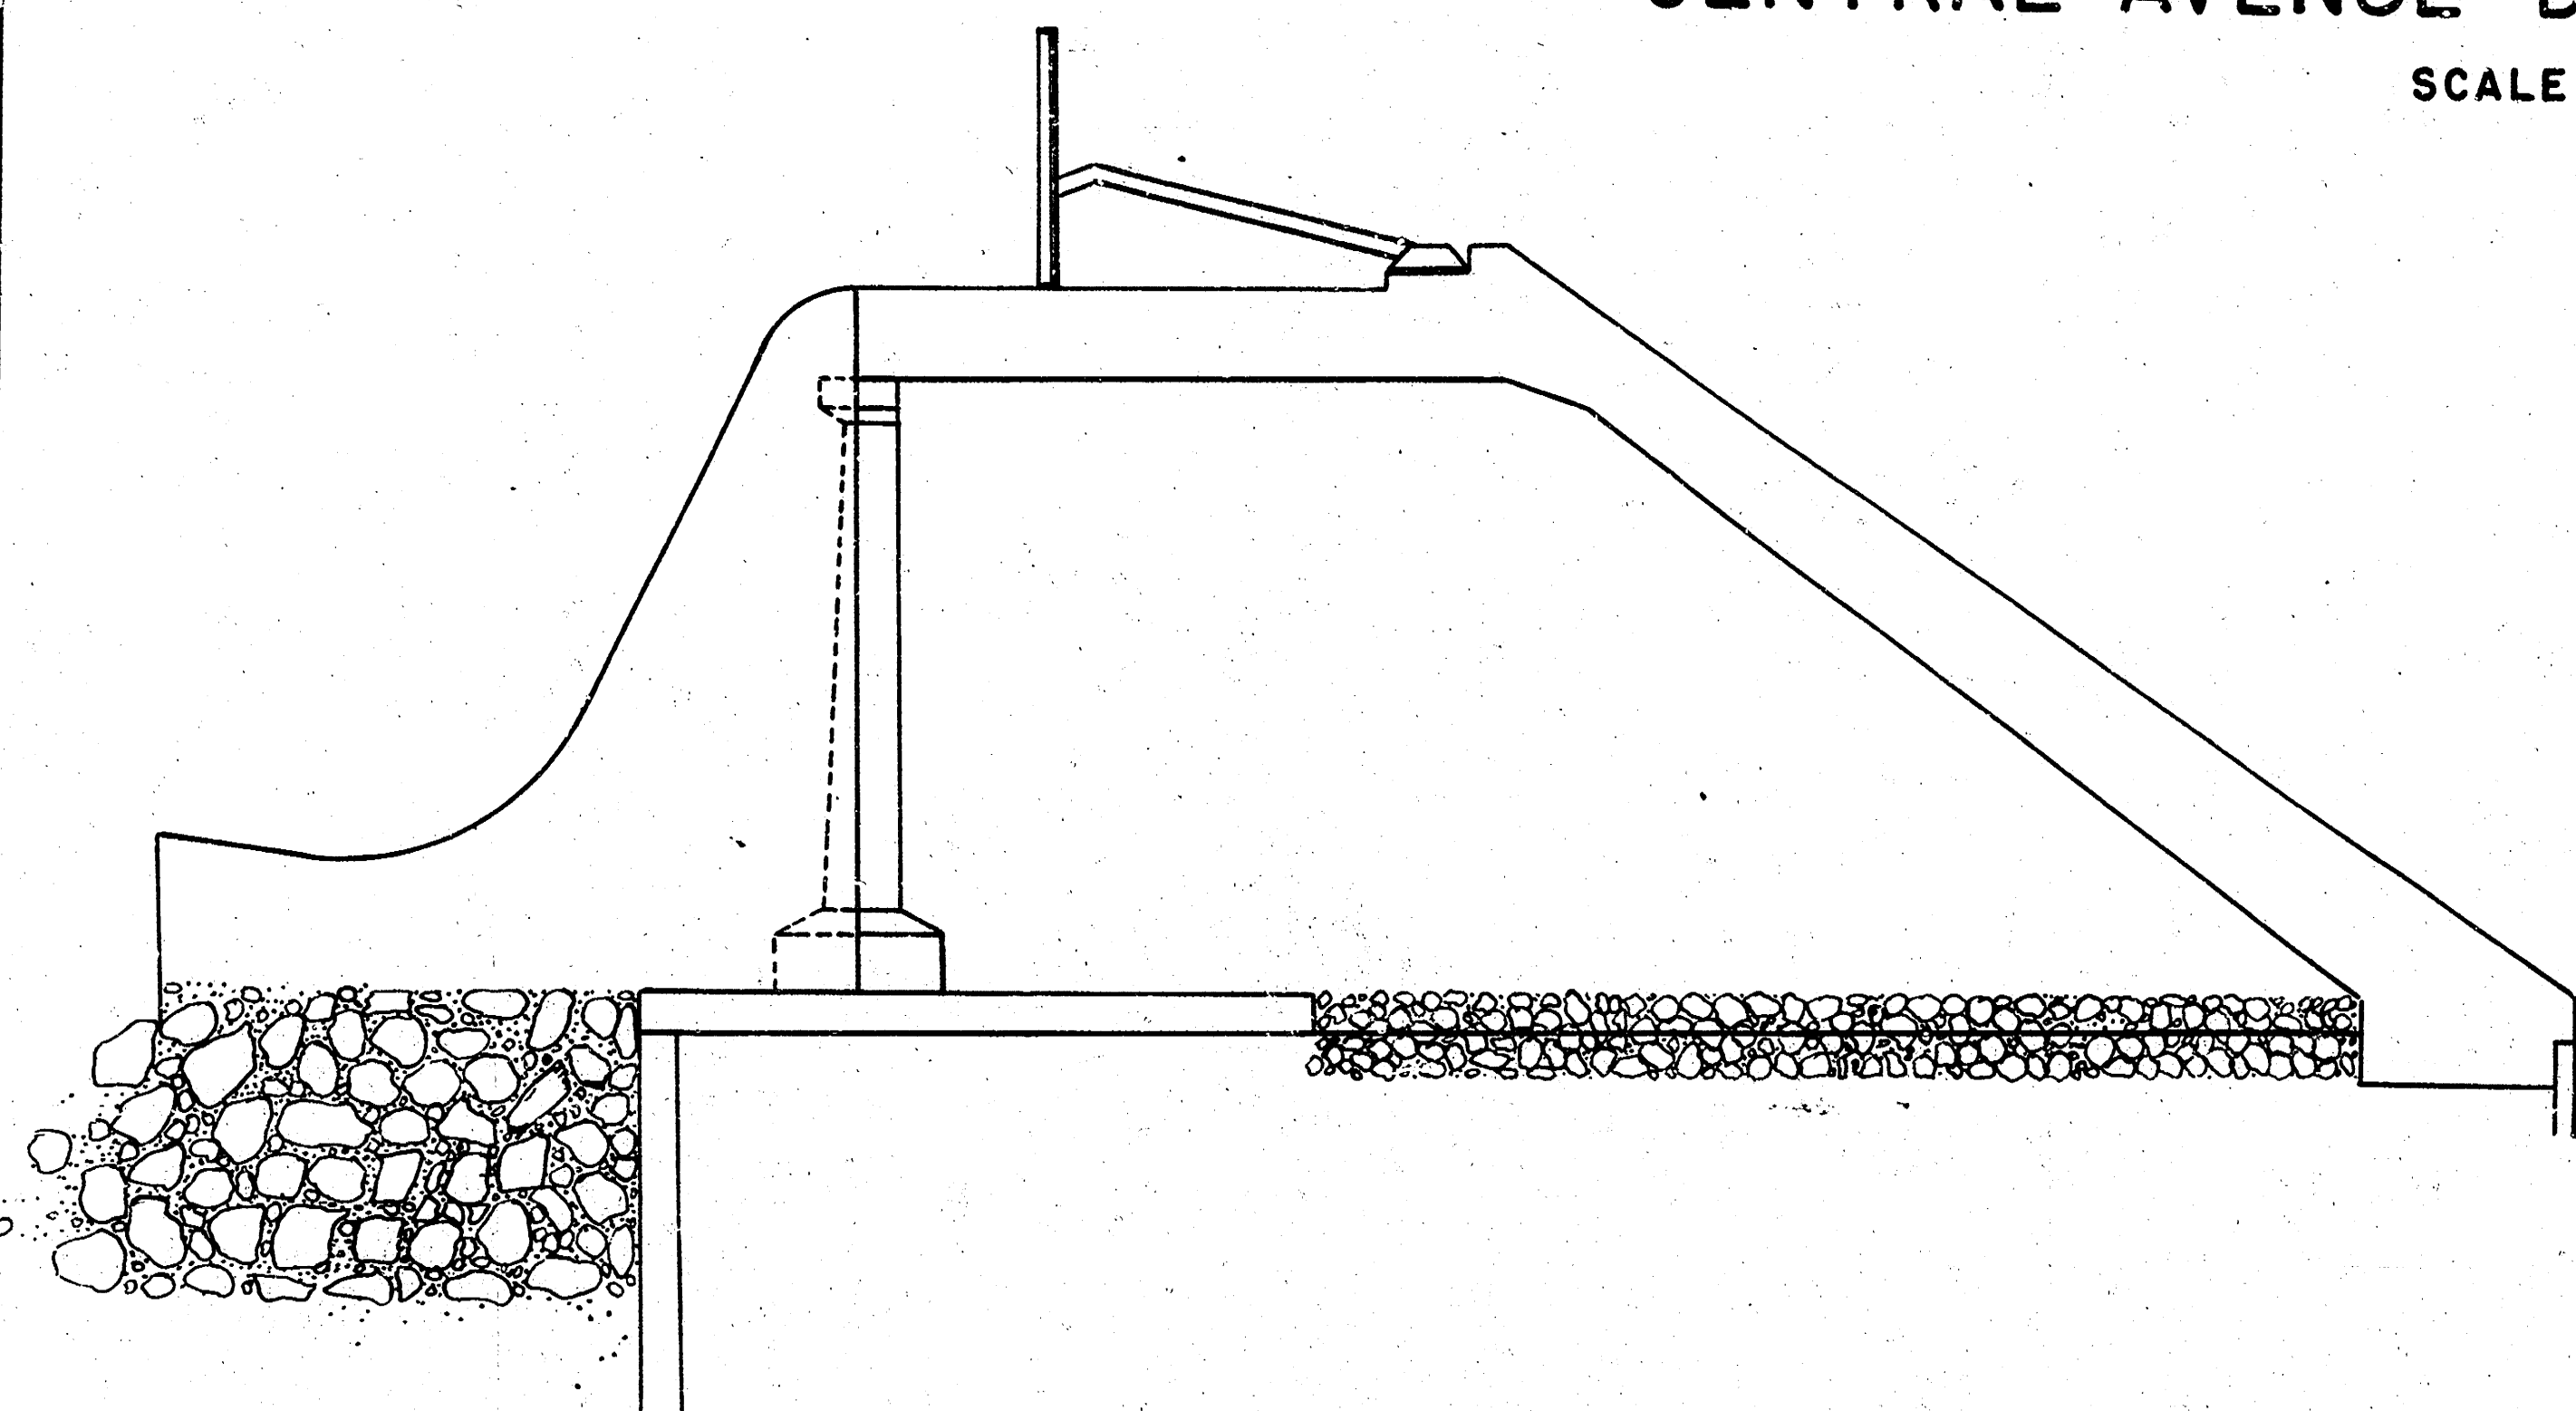


CROSS SECTION OF OGEE SECTION ADDED TO FIRST SECTION IN 1924.

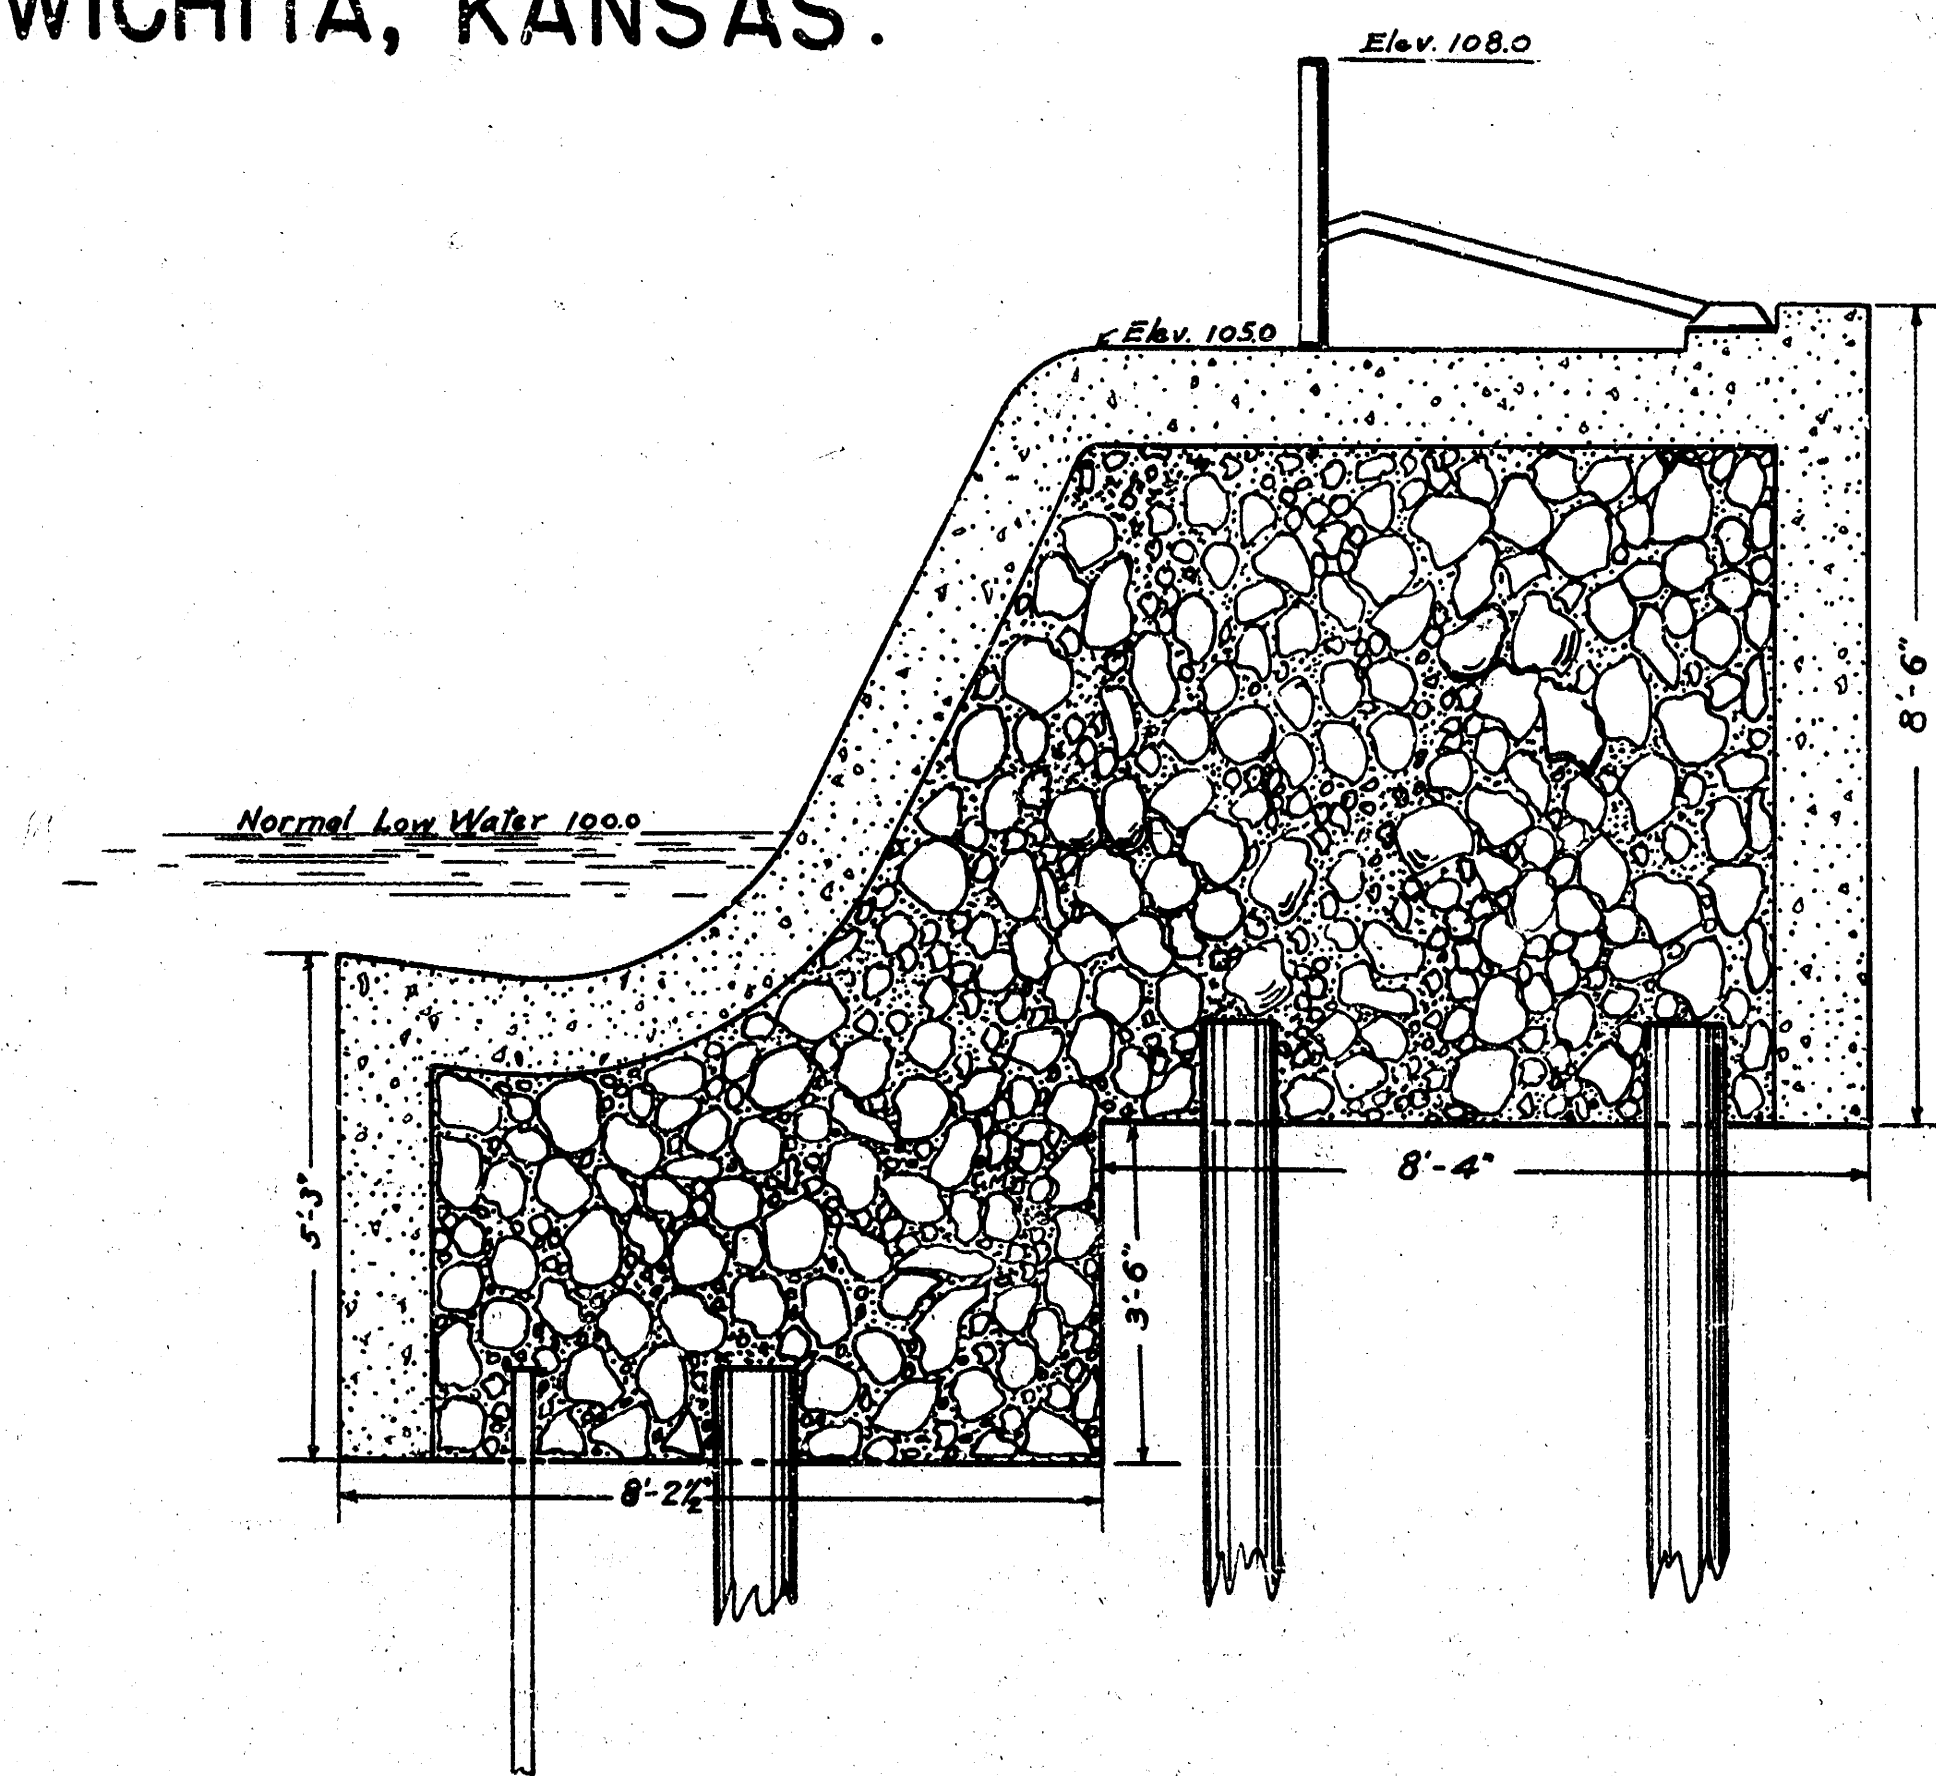

CROSS SECTION 1924 ADDITION.


CENTRAL AVENUE DAM - WICHITA, KANSAS.

SCALE 1"=10'

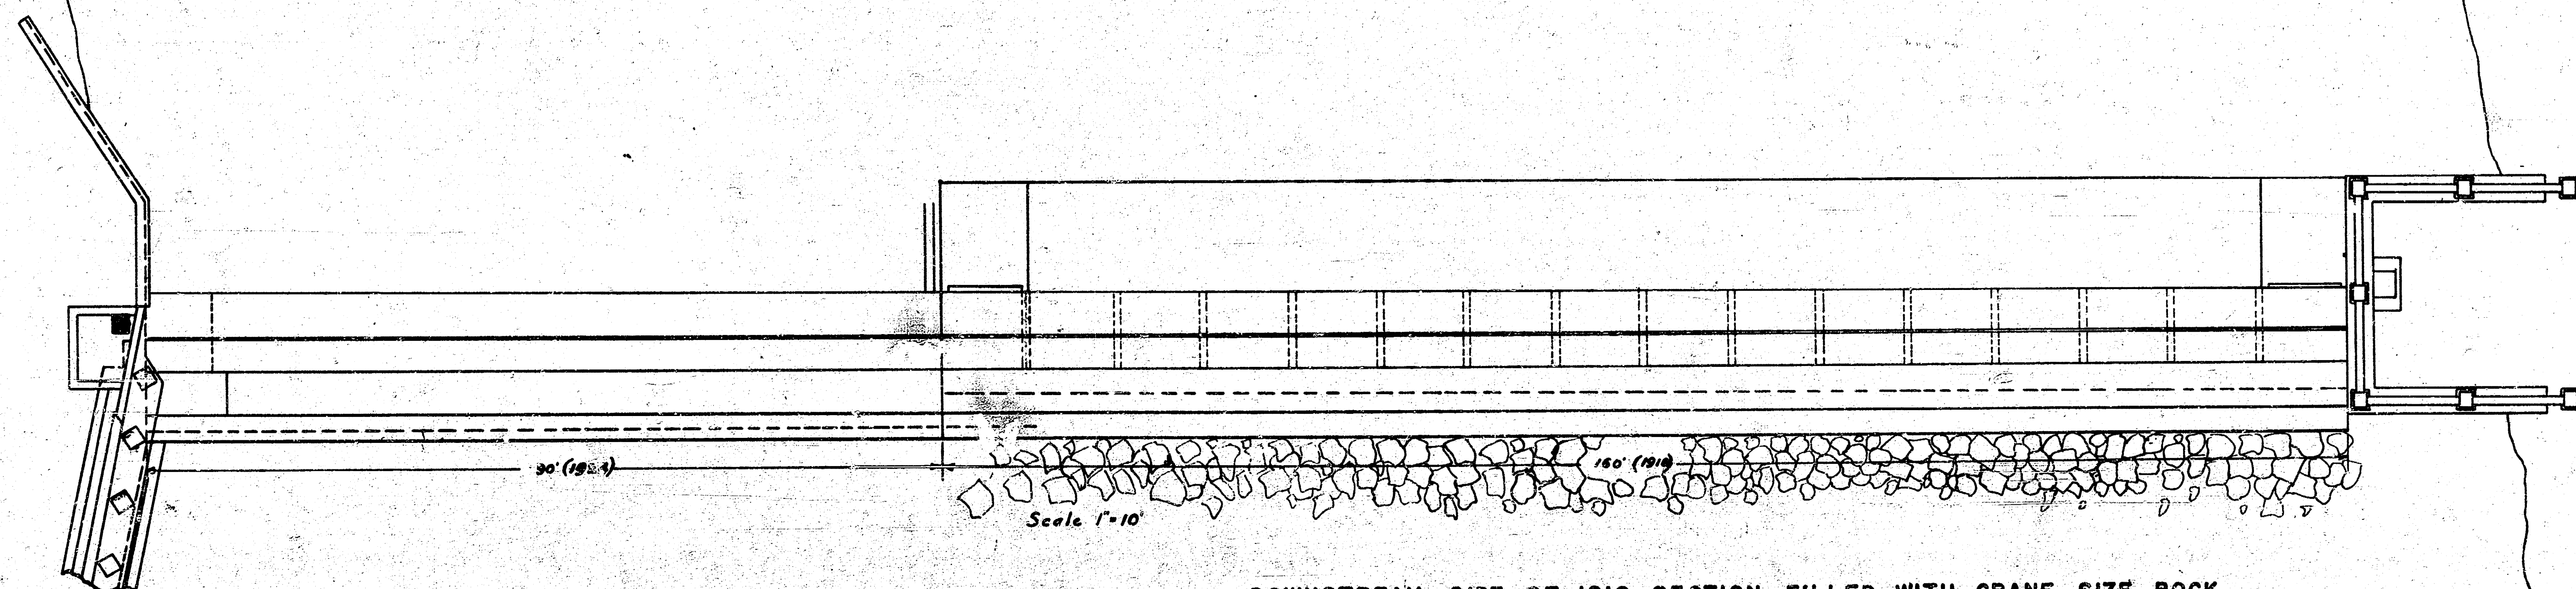


DOWNSTREAM SIDE OF 1910 SECTION FILLED WITH CRANE SIZE ROCK.

SCALE 1" = 10'

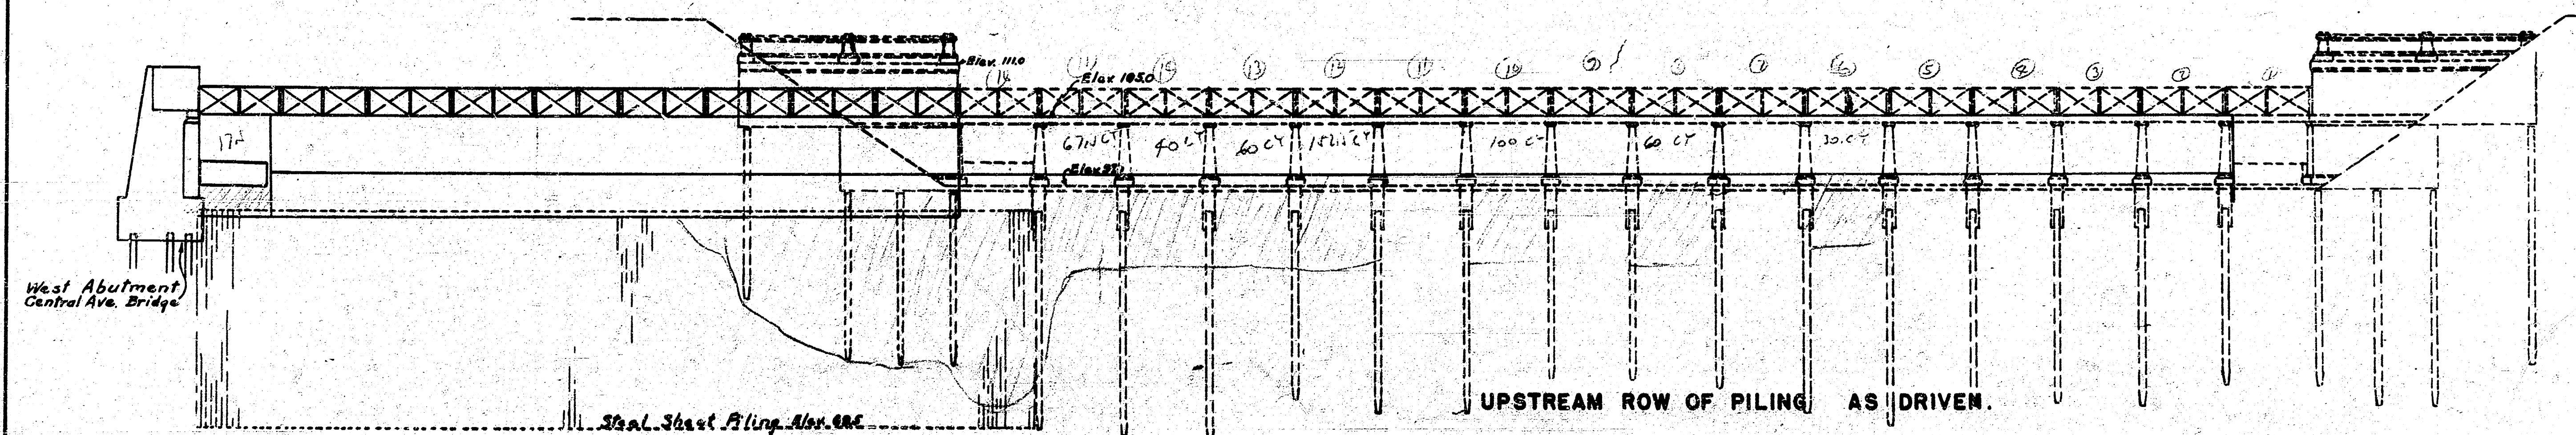

CENTRAL AVENUE DAM - WICHITA, KANSAS.

SCALE 1"=10'


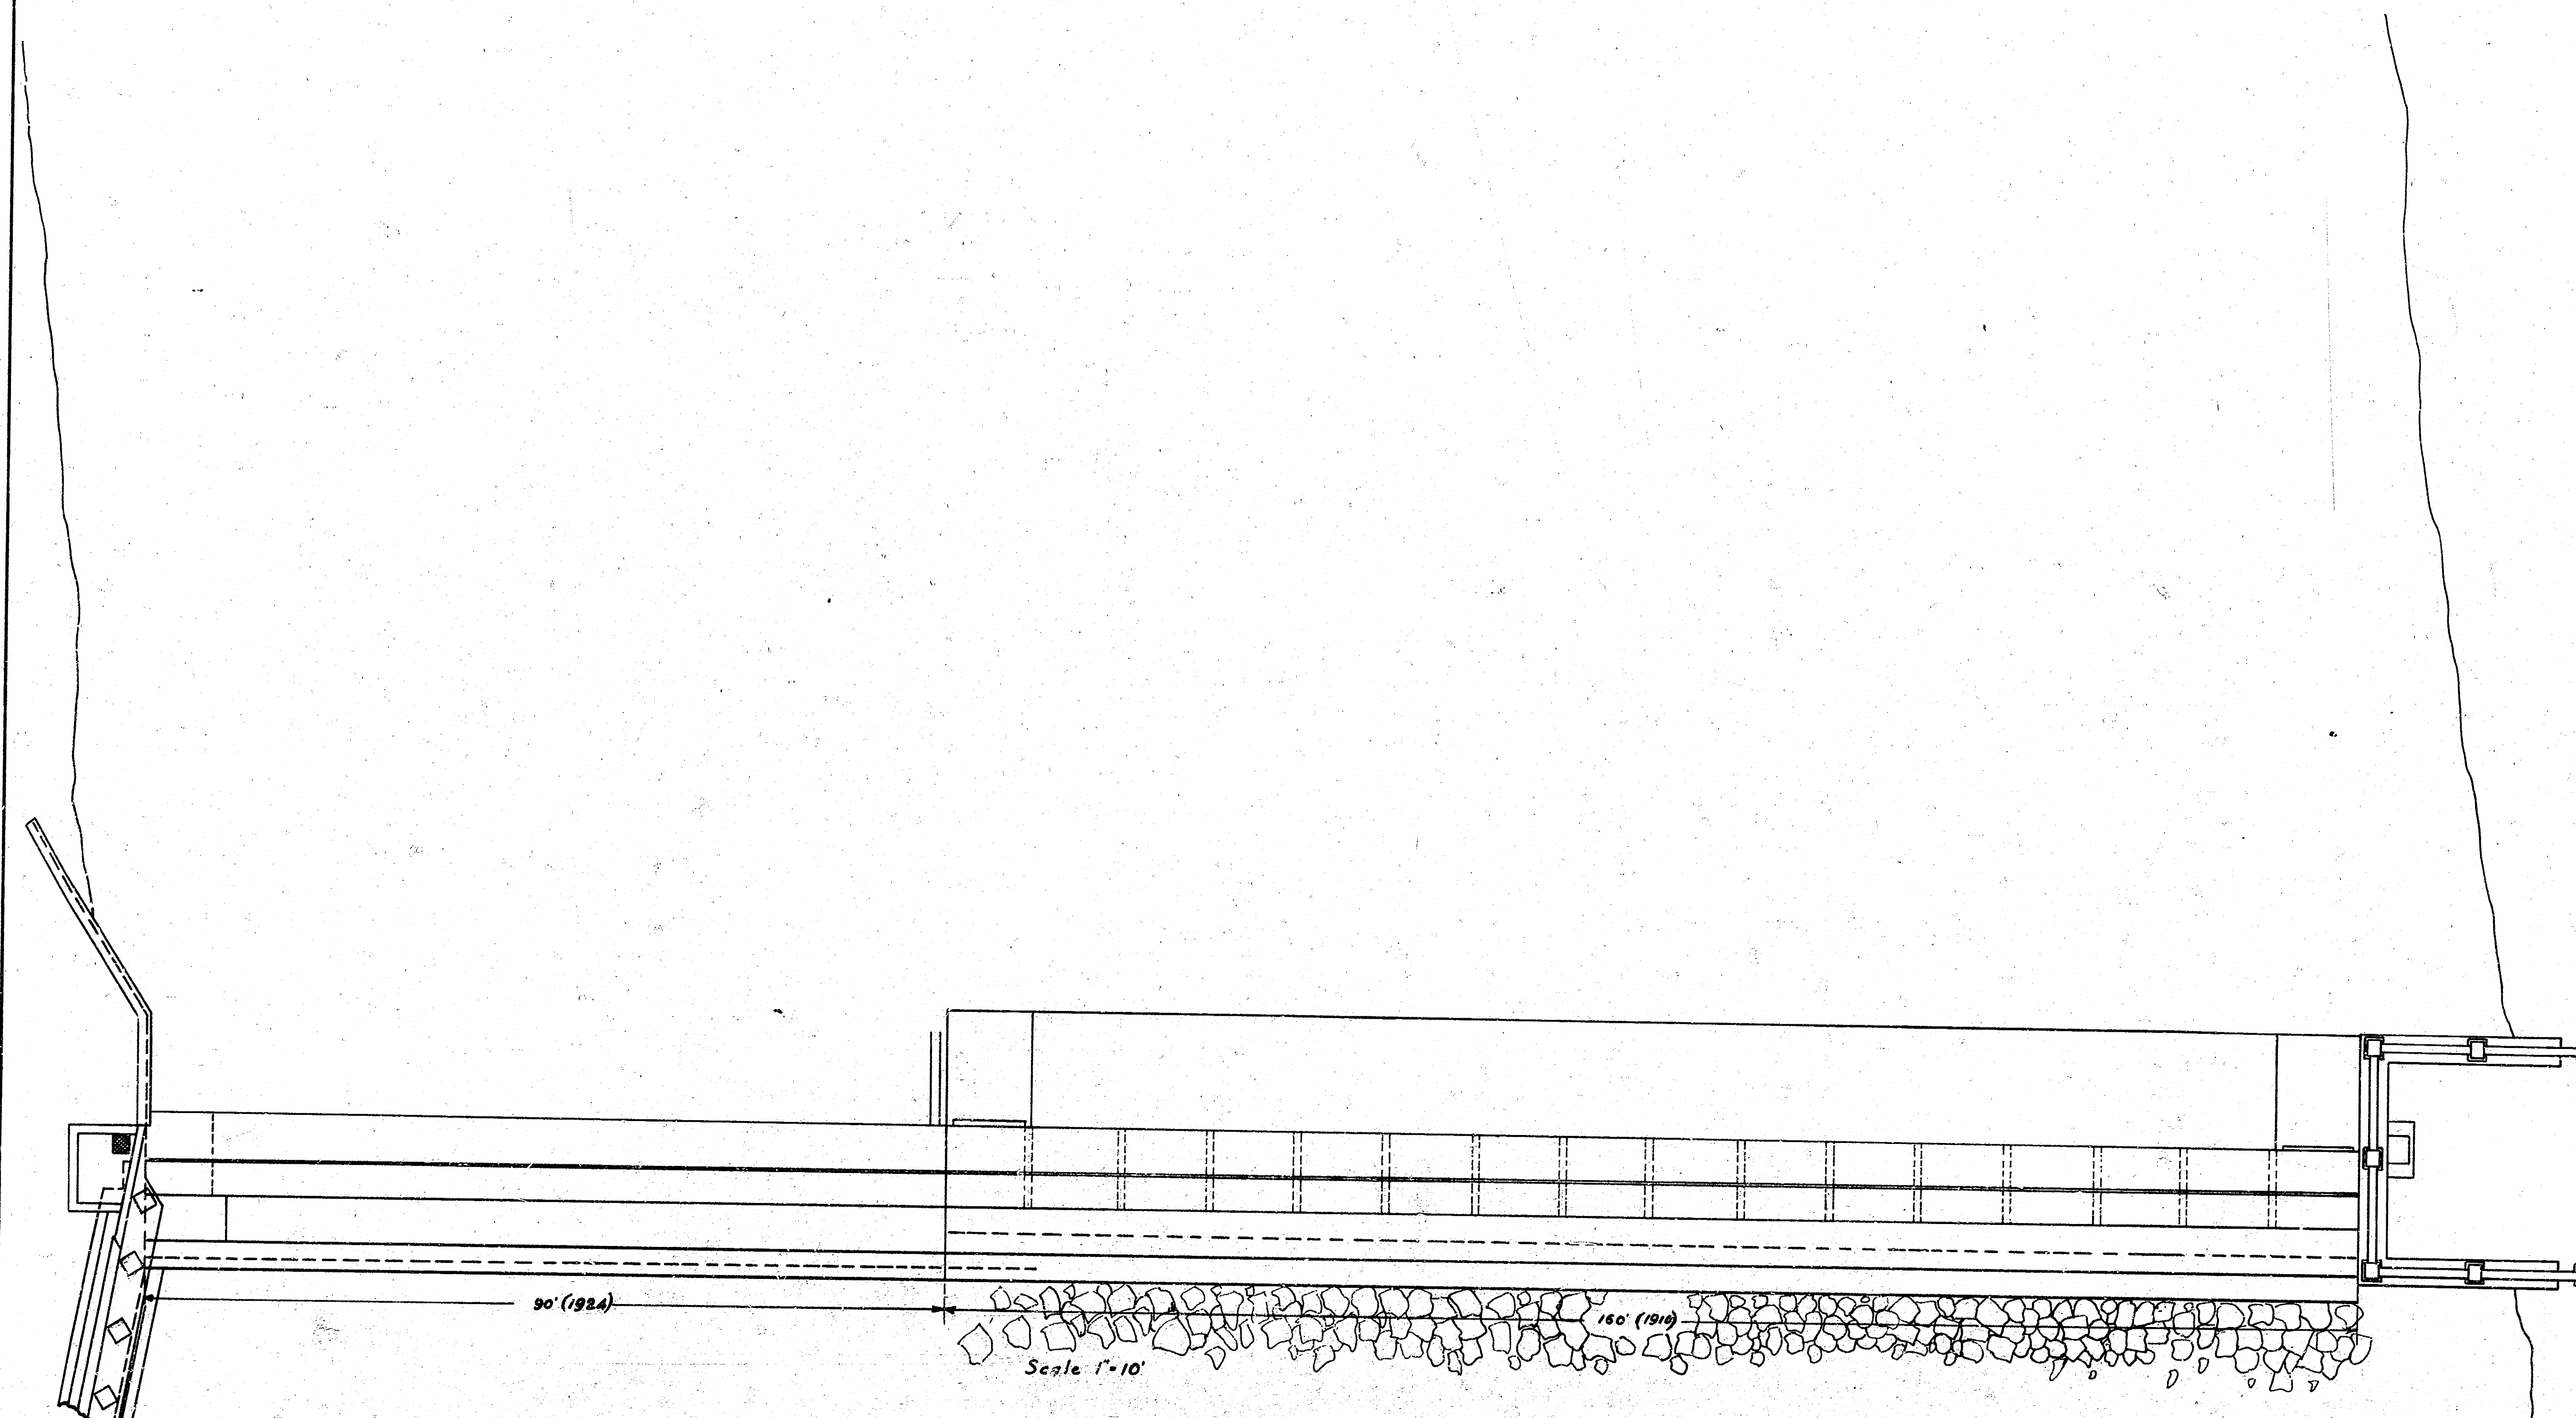


DOWNSTREAM SIDE OF 1910 SECTION FILLED WITH CRANE SIZE ROCK.

CENTRAL AVENUE DAM - WICHITA, KANSAS

CENTRAL AVENUE DAM- WICHITA, KANSAS.
SCALE 1" = 10'

LITTLE
ARKANSAS
RIVER

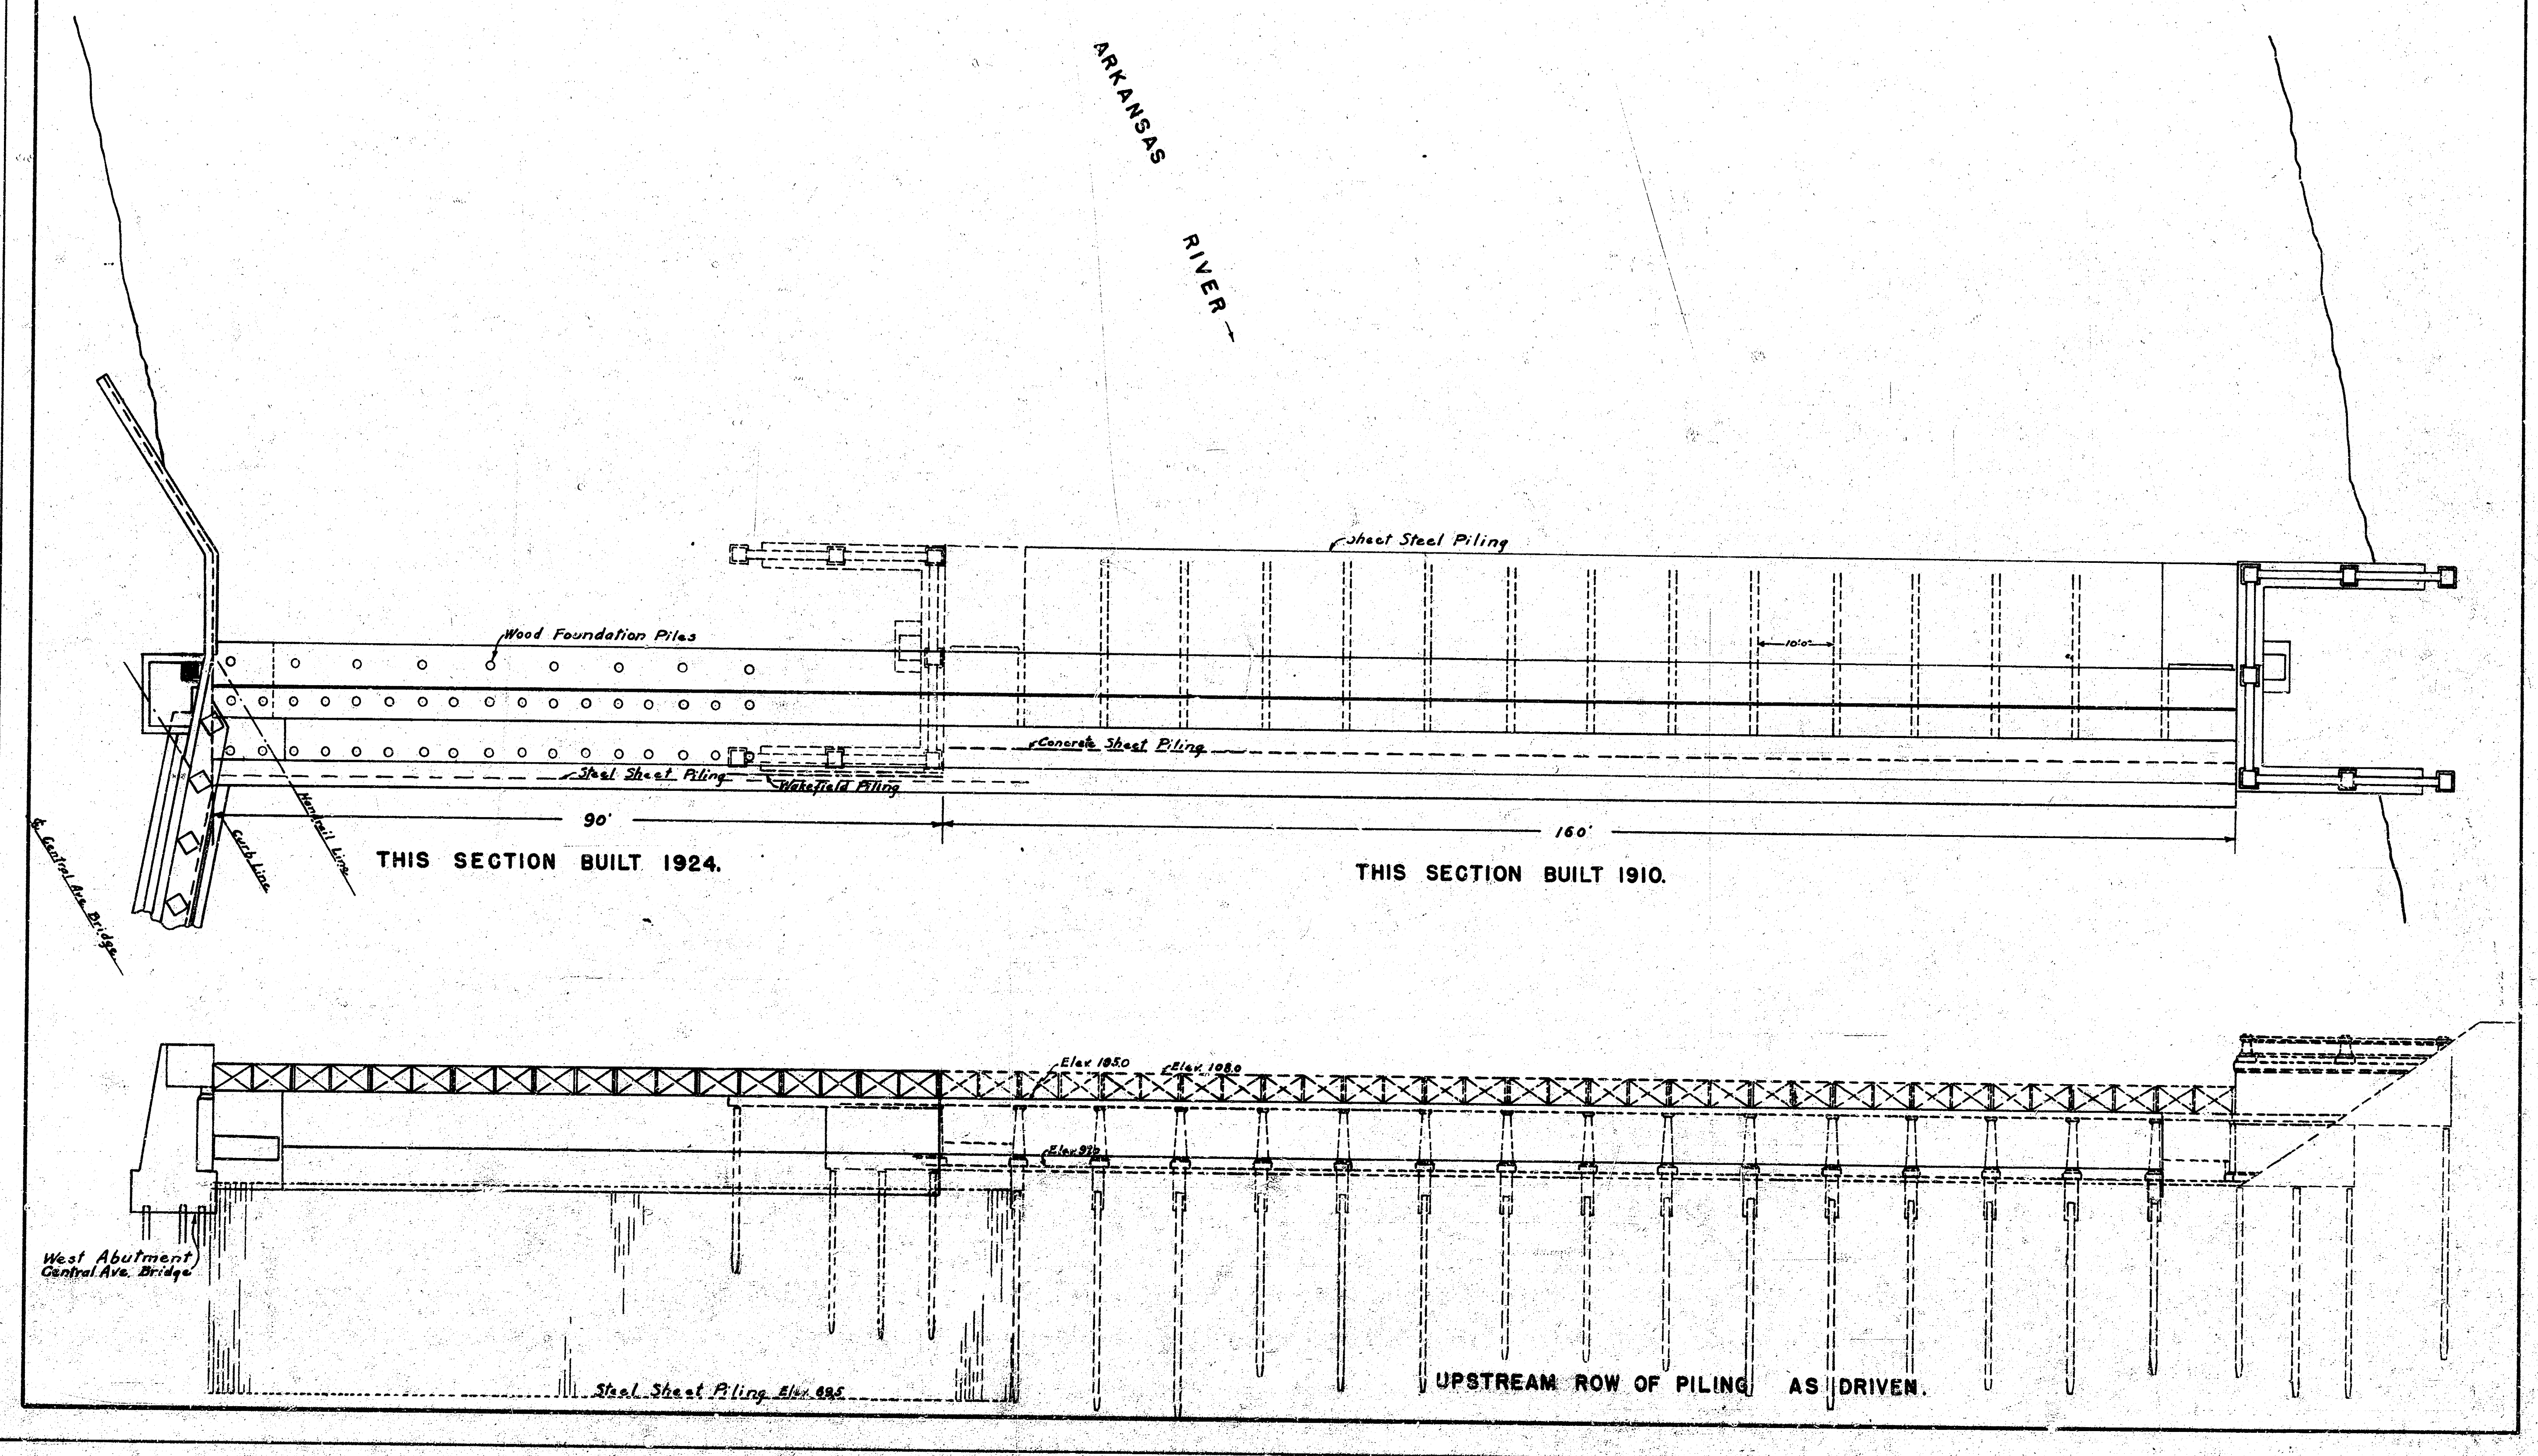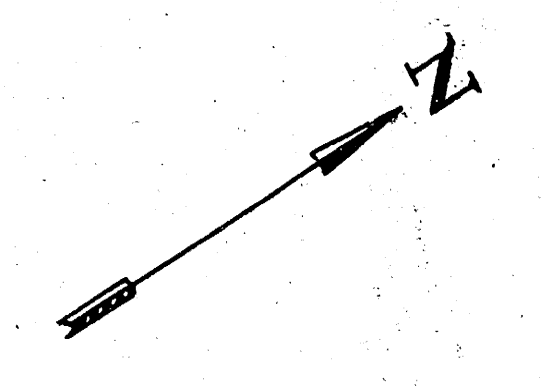

CENTRAL AVENUE DAM - WICHITA, KANSAS.

SCALE 1"=10'

