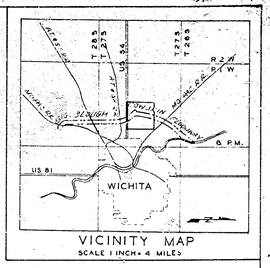

VICINITY MAP
SCALE 1 INCH = 4 MILES

Augusta Dersheidt

P.I. 800+91.05

Δ = 74°46'25"
D = 1° 00'
R = 5729.58
T = 4737.31
L = 7474.03

H.H. Stephenson

Center of Section 22

N 10°49'W 1457.17

N 0°51'W 4,591.11

N 17°19'W 352.25

N 12°39'W 280.33

N 12°39'W 333.03

N 7°36'W 332.23

N 13°18'W 17.98

N 13°18'W 324.36

N 7°36'W 781.81.10

N 7°36'W 324.36

N 7°36'W 332.20

N 7°36'W 332.20

N 11°22'E 94.62

N 11°22'E 208.18

N 11°22'E 332.20

N 32°22'E 392.02

N 32°22'E 160.19

N 32°22'E 332.20

N 27°21'E 532.20

Marcus D. Guw

Leonard Clupny

N 27°21'E 532.20

N 40°41'E 209.67

N 41°39'E 346.36

N 0°51'W 246.15

S 89°55'E 1320.00

Mary Kuhn Torres

N 09°20'W 392.62

704.90

Stream

20.00

PL 757+15

Right Levee "C"

Chalmer "B"

Left Levee "D"

Wm. Chapman

Henry A. Horney

Lee O. Shoemaker

S 2°51'W 407.35

S 11°36'E 407.35

S 11°36'E 90.00

S 11°36'E 317.01

S 12°38'E 491.21

S 12°38'E 354.03

S 12°38'E 137.18

S 12°38'E 35.63

S 11°36'E 147.51

S 11°36'E 22.85

S 33°00'E 1758.50

S 33°00'E 355.23

S 33°00'E 196.69

S 33°00'E 111.81

S 33°00'E 1005.

N 44°00'E 1181.

S 51°00'E 1005.

S 5°00'E 1165.97

S 0°23'E 551.30

S 0°23'E 1165.97

S 0°23'E 1165.97

S 0°23'E 1165.97

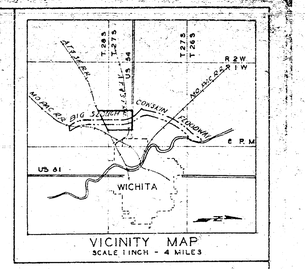

VICINITY MAP
SCALE 1 INCH = 4 MILES

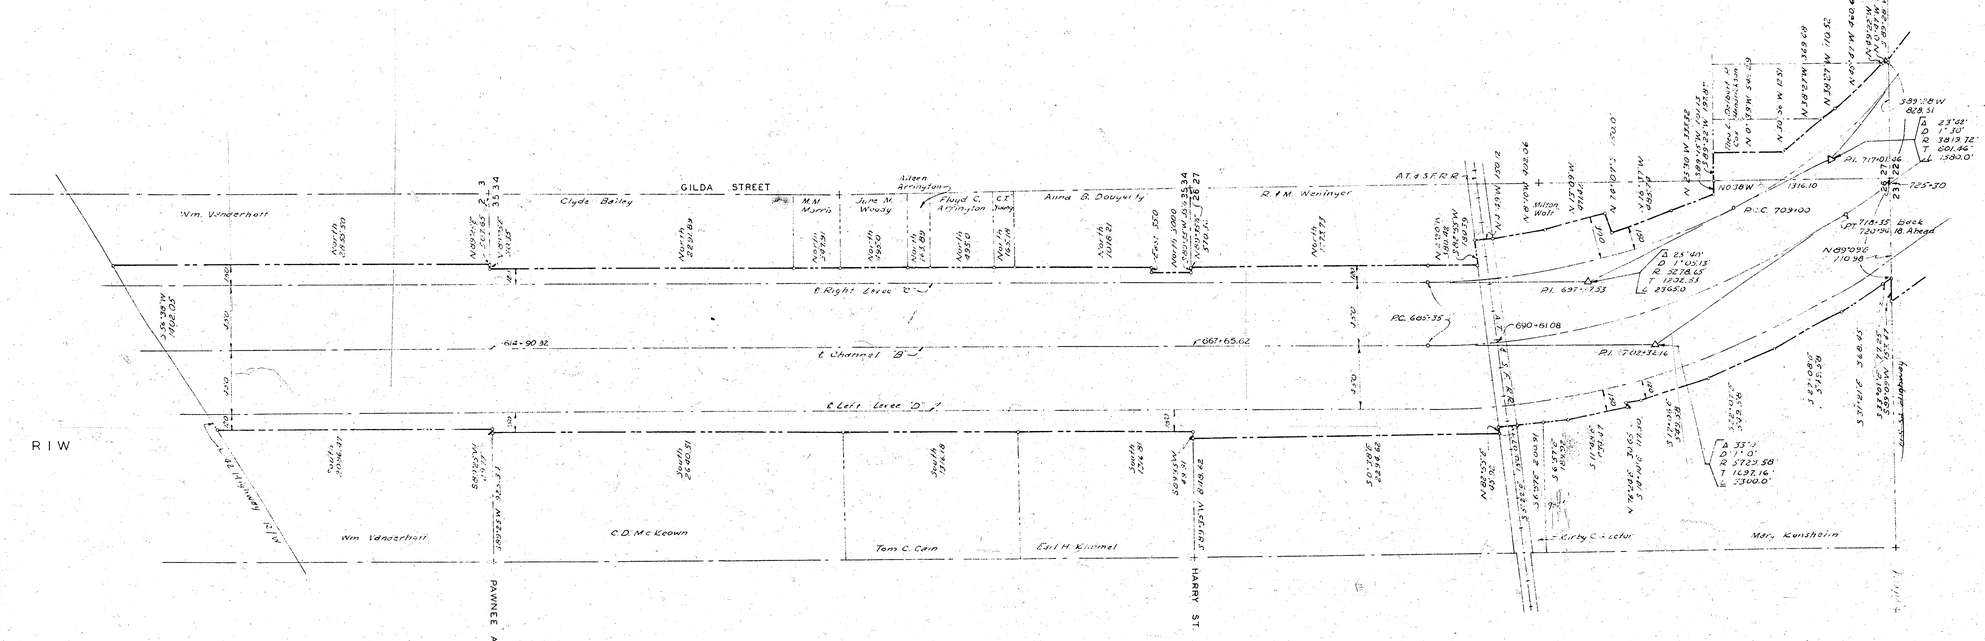

LEGEND

- ○ CONCRETE MONUMENTS
- △ P.I. OF CURVES
- ——— CENTER LINES OF LEVEES & CHANNELS
- ——— PROPERTY LINES
- ——— RIGHT OF WAY LIMITS

ARKANSAS RIVER BASIN
WICHITA AND VALLEY CENTER
FLOOD CONTROL PROJECT
BIG SLOUGH-COWSKIN CREEK FLOODWAY
PARCEL "B" PART I & II
RIGHT OF WAY PLAN

SCALE: 1 INCH = 400 FEET
CITY-COUNTY ENGINEER OFFICE, WICHITA, KANSAS

APPROVED:
ENGINEER-IN-CHARGE

DATE	DESCRIPTION	CHKD.	REC.	APPR.
	REVISIONS			

DRAWN
TRACED
CHECKED

SHEET 2 OF 4 SHEETS

Course	Bearing	Distance
1	N60°34'E	194.63
2	N52°30'E	167.50
3	N39°50'E	99.00
4	N30°09'E	99.98
5	N20°09'E	99.98
6	N10°39'E	99.98
7	N01°43'E	99.98
8	N8°50'W	99.98
9	N18°34'W	99.98
10	N27°18'W	99.98
11	N36°02'W	198.63
12	N51°31'W	416.21
13	N53°38'W	148.41
14	N49°13'W	163.32
15	N42°19'W	99.96
16	N36°45'W	99.96
17	N31°11'W	99.96
18	N25°11'W	99.94
19	N20°03'W	99.96
20	N14°10'W	99.96
21	N8°06'W	99.96
22	N1°17'W	99.96
23	N4°43'E	99.96
24	N9°01'E	57.95
25	N7°11'E	338.20
26	N8°39'E	5.00
27	N8°11'E	33.97
28	N83°39'W	5.00
29	N8°01'E	349.03
30	N89°39'E	108.36
31	N82°10'E	586.37
32	S0°52'E	167.56
33	S39°09'W	63.98
34	S3°04'W	472.06
35	S9°30'W	103.50
36	S0°52'E	99.90
37	S9°18'E	99.10
38	S16°43'E	99.00
39	S27°41'E	99.00

Course	Bearing	Distance
40	S36°37'E	50.81
41	S36°37'E	99.77
42	S44°19'E	117.19
43	S5°14'E	1022.61
44	S47°09'E	86.58
45	S0°11'E	66.00
46	N89°49'E	59.61
47	S30°30'E	53.98
48	S2°39'E	99.90
49	S8°13'E	53.67
50	S0°11'E	816.79
51	S3°32'W	5.70
52	S3°08'W	137.76
53	S3°35'W	99.98
54	S9°01'W	99.98
55	S13°27'W	99.98
56	S15°58'W	99.98
57	S20°59'W	99.98
58	S25°39'W	44.26
59	S29°39'W	55.72
60	S34°30'W	99.98
61	S37°21'W	99.96
62	S39°18'W	76.79
63	S39°27'W	40.79
64	S40°39'W	99.96
65	S42°51'W	99.96
66	S46°34'W	53.70
67	S49°49'E	104.48
68	S46°05'E	616.54
69	N49°50'E	5.82
70	S53°09'E	3.60
71	S67°03'E	59.74
72	S82°23'E	99.09
73	S85°30'E	99.71
74	S71°27'E	170.76
75	S77°11'E	41.01
76	S0°11'E	2031.45
77	S0°16'E	1113.29
78	N77°29'W	416.91

Course	Bearing	Distance
79	S89°15'W	152.54'
80	N0°43'W	44.25
81	N77°27'W	286.35
82	N73°40'W	90.34
83	N65°16'W	99.98
84	N54°00'W	99.98
85	N0°53'W	5.93
86	N5°53'W	48.93
87	N9°43'W	85.03
88	N7°10'W	60.01
89	N0°03'E	56.26
90	N76°32'W	109.96
91	S85°36'W	64.60
92	S42°39'W	30.78
93	S64°51'W	30.54
94	S60°34'W	1584.93
95	S0°59'E	53.07
96	S89°55'W	99.52
97	S80°36'W	71.01
98	S67°39'W	174.97
99	S60°36'W	310.92
100	N54°48'W	46.42
101	S80°09'W	60.33
102	S60°02'W	193.45
103	S49°48'W	143.9
104	S60°34'W	898.04
105	S62°39'W	112.46
106	S75°59'W	98.16
107	S62°19'W	45.97
108	S62°15'W	56.64
109	S25°07'E	258.53
110	S60°39'W	150.98
111	S0°11'E	691.31
112	S0°16'E	293.73
113	S74°33'E	246.31
114	S15°39'E	51.83
115	S1°17'E	114.51
116	S60°03'W	120.37
117	S60°59'W	1.98
118	S0°16'E	77.36
119	S89°53'W	153.74

R I W R I E
T 26 S
T 27 S
Right R/W Arkansas River Levees
Left R/W Arkansas River Levees

VICINITY MAP
SCALE 1 INCH = 4 MILES

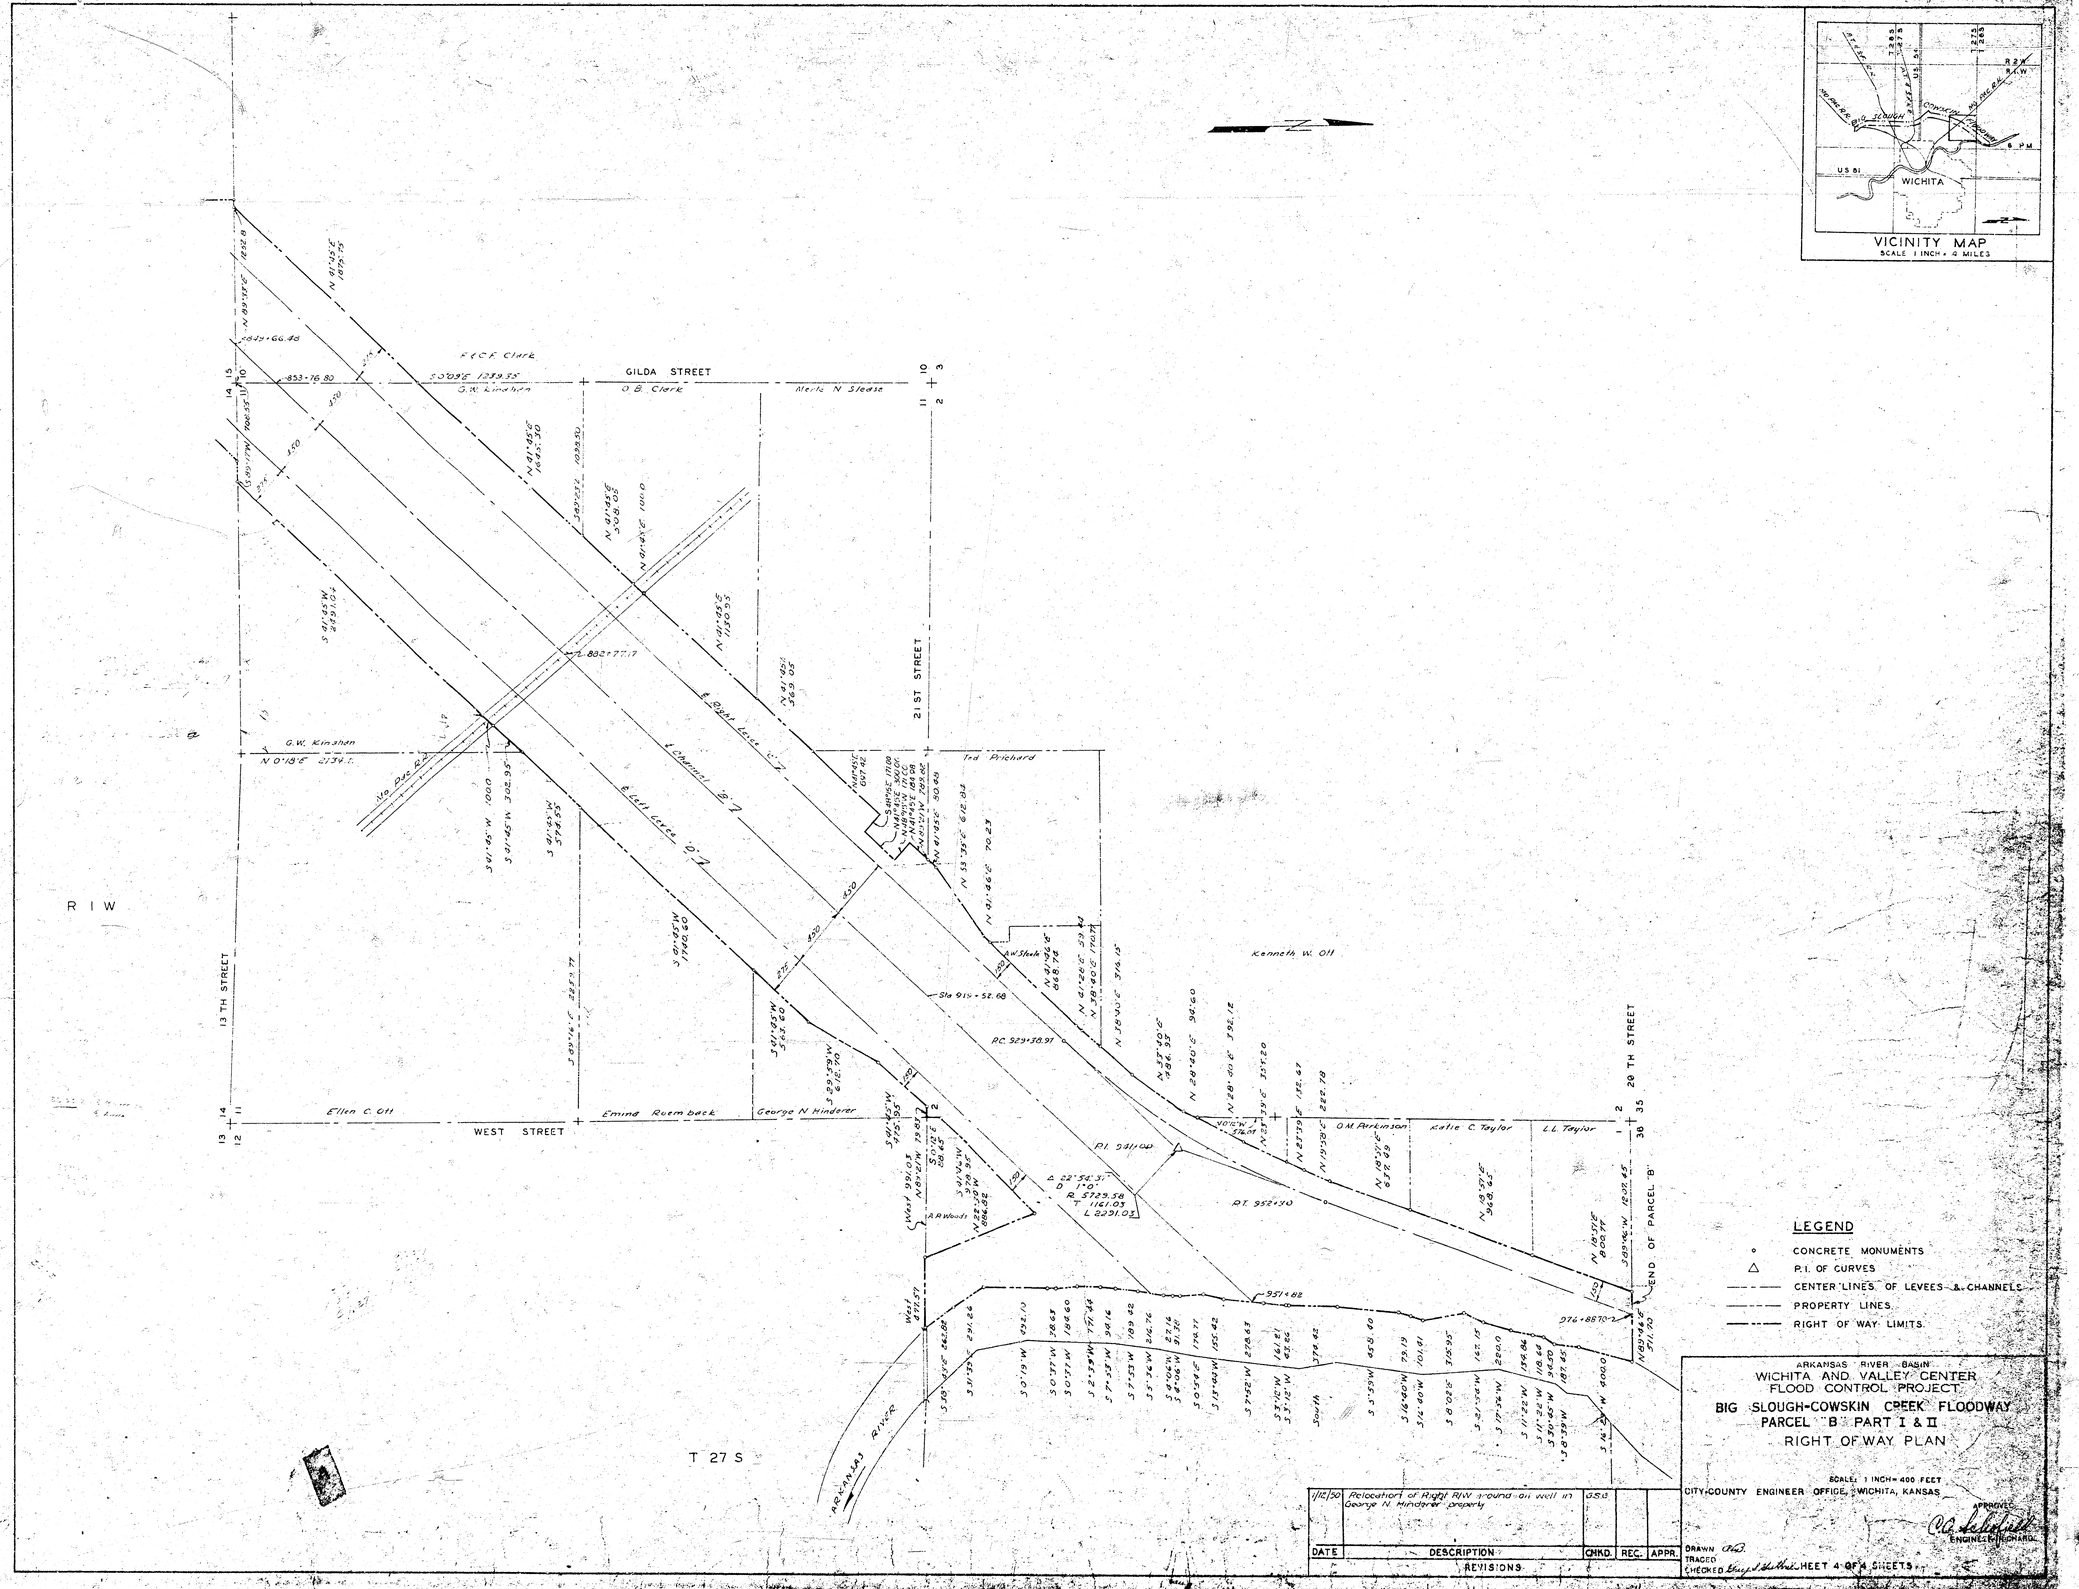
GILDA STREET
21 ST STREET
13 TH STREET
WEST STREET
20 TH STREET
F.C.F. Clark
G.W. Kinahan
O.B. Clark
Merle N. Steele
Ted Pritchard
Kenneth W. Ott
Ellen C. Ott
Emma Ruemback
George N. Hinderer
A.R. Woods
A.W. Stark
O.M. Parkinson
Katie C. Taylor
L.L. Taylor
Voigt's Tank
Well
ARKANSAS RIVER
R 1 W
T 27 S
P.I. 931+00
P.T. 952+30
931+62
976+88.70
END OF PARCEL "B"
RC 529+38.91
Sta 915+52.68
L 22°54.3'
D 1°0'
R 5729.58
T 1161.03
L 2291.03
S 31°45' W 302.95'
S 31°45' W 1000'
