



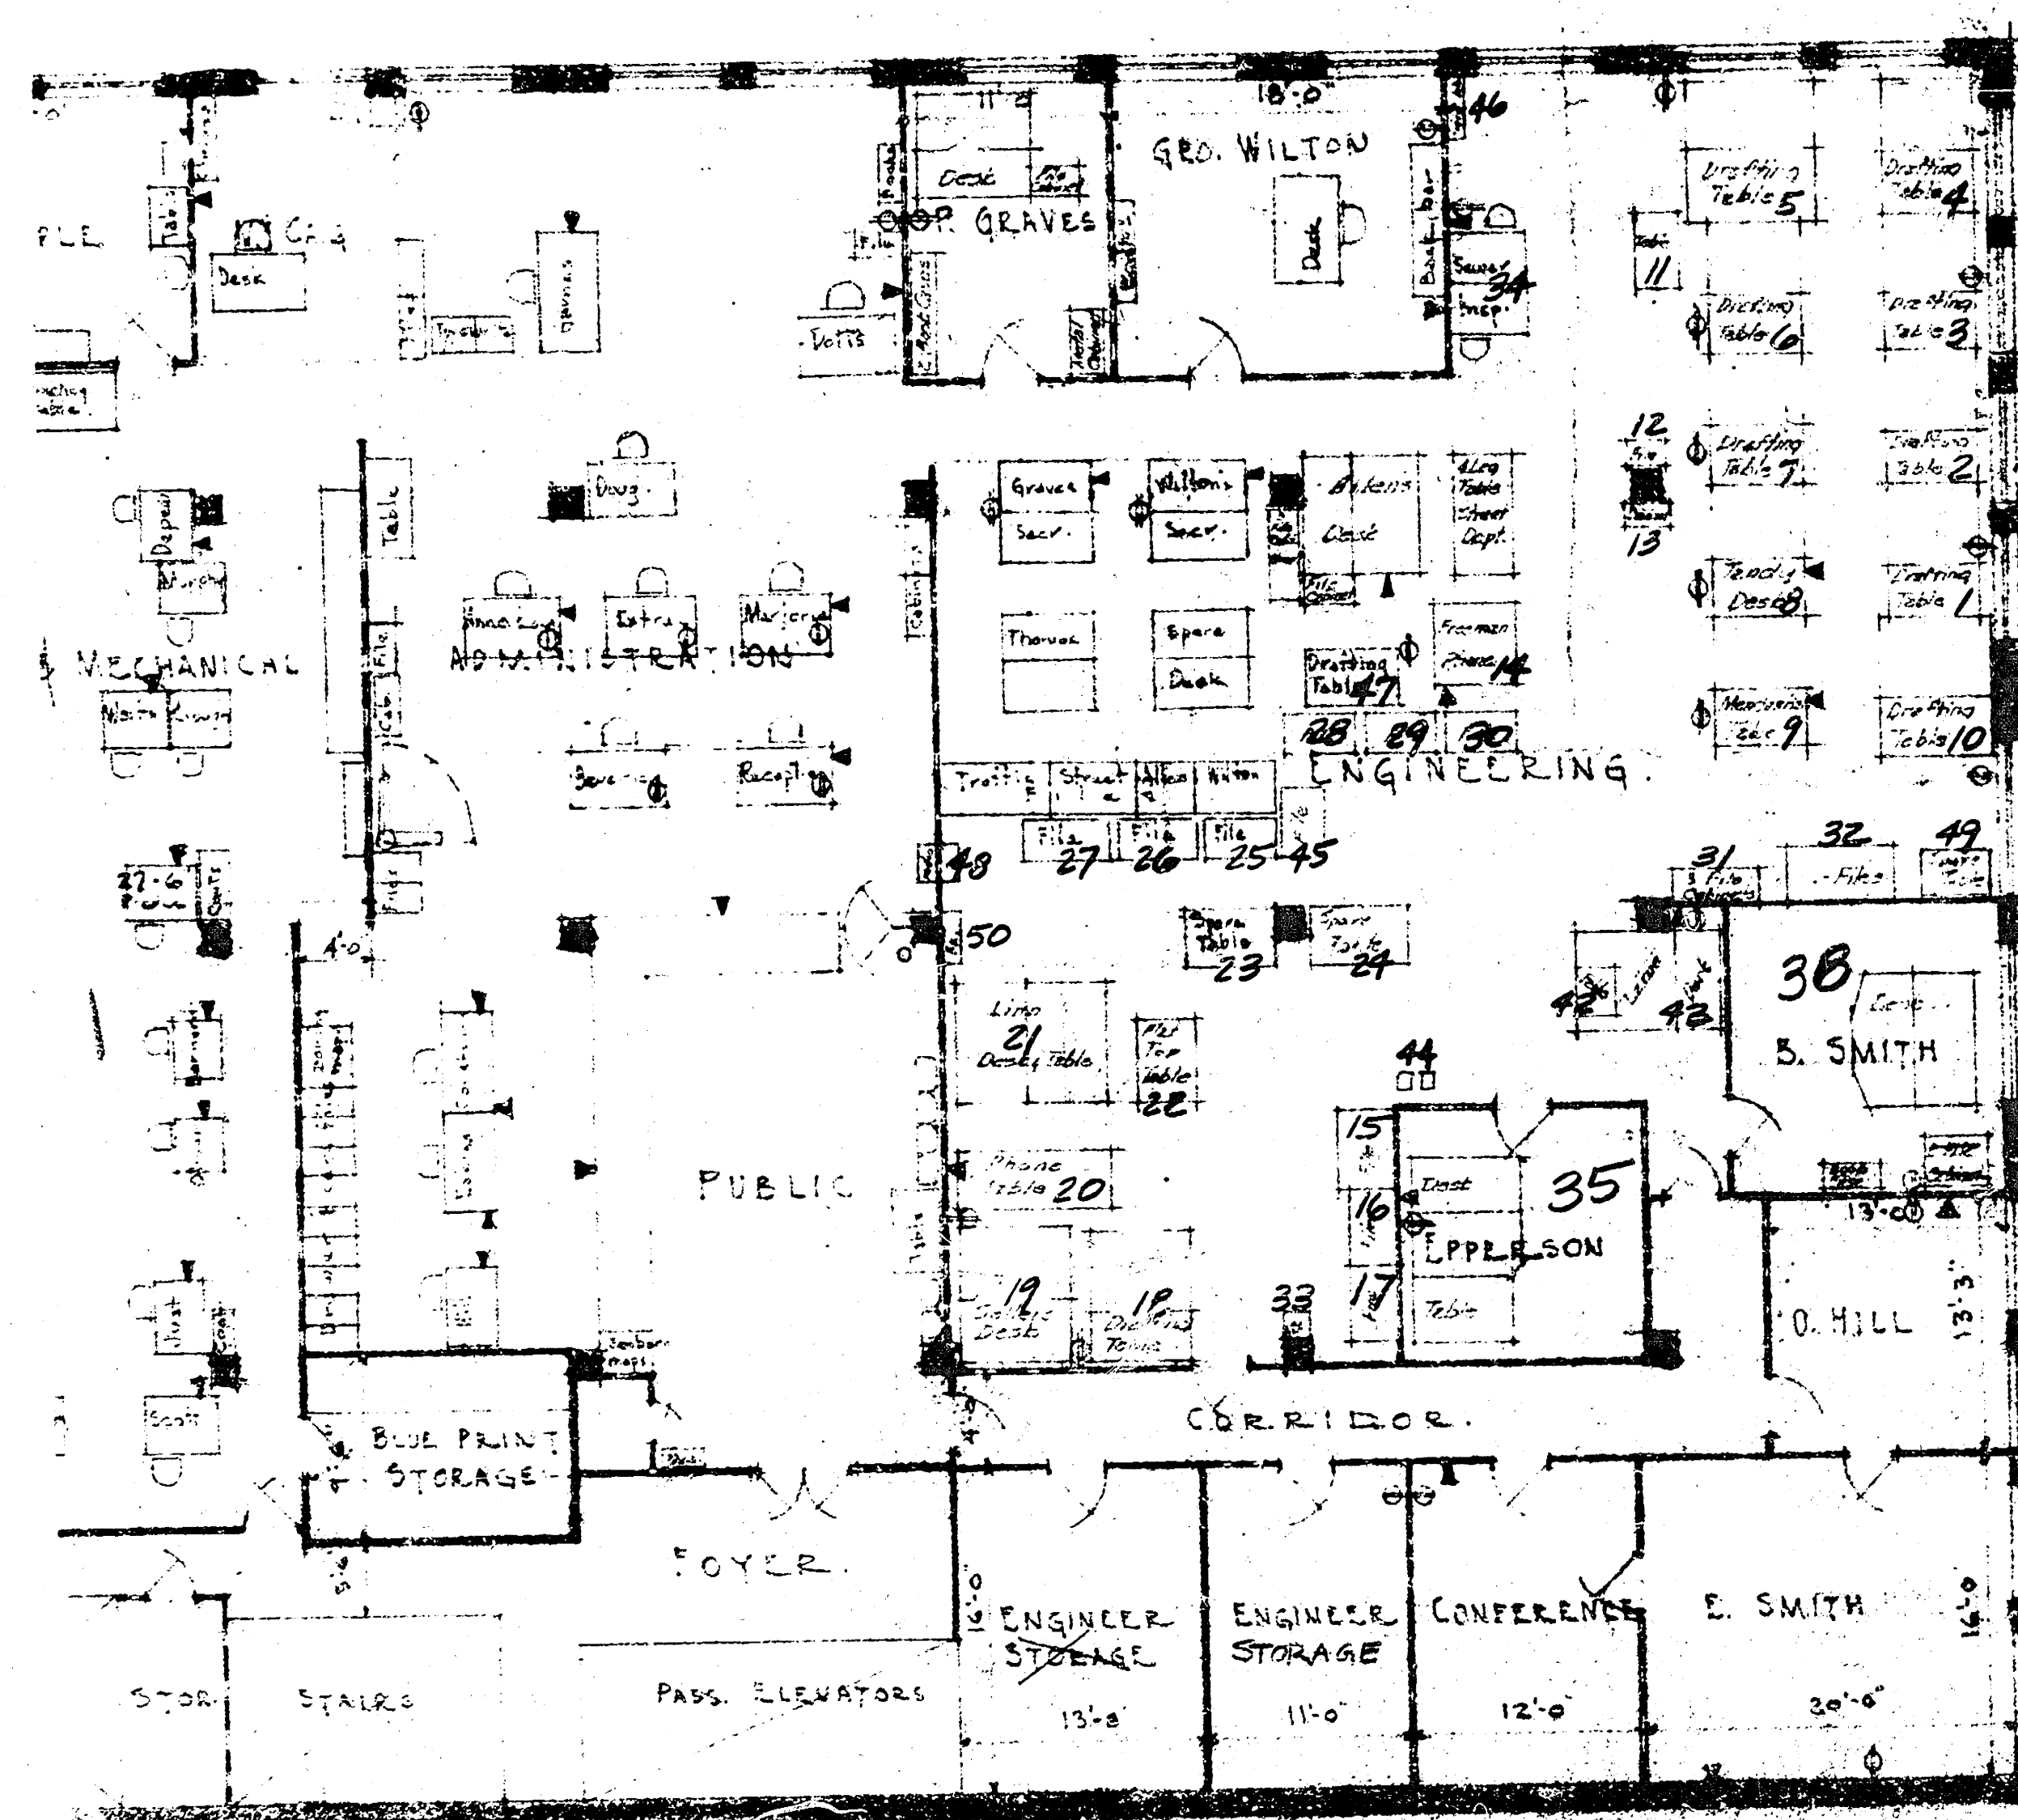

KEY TO PARTITION HEIGHT
To ceiling _____
5'-0" HIGH _____
5'-6" HIGH _____
12-18-57 - 14-21-59

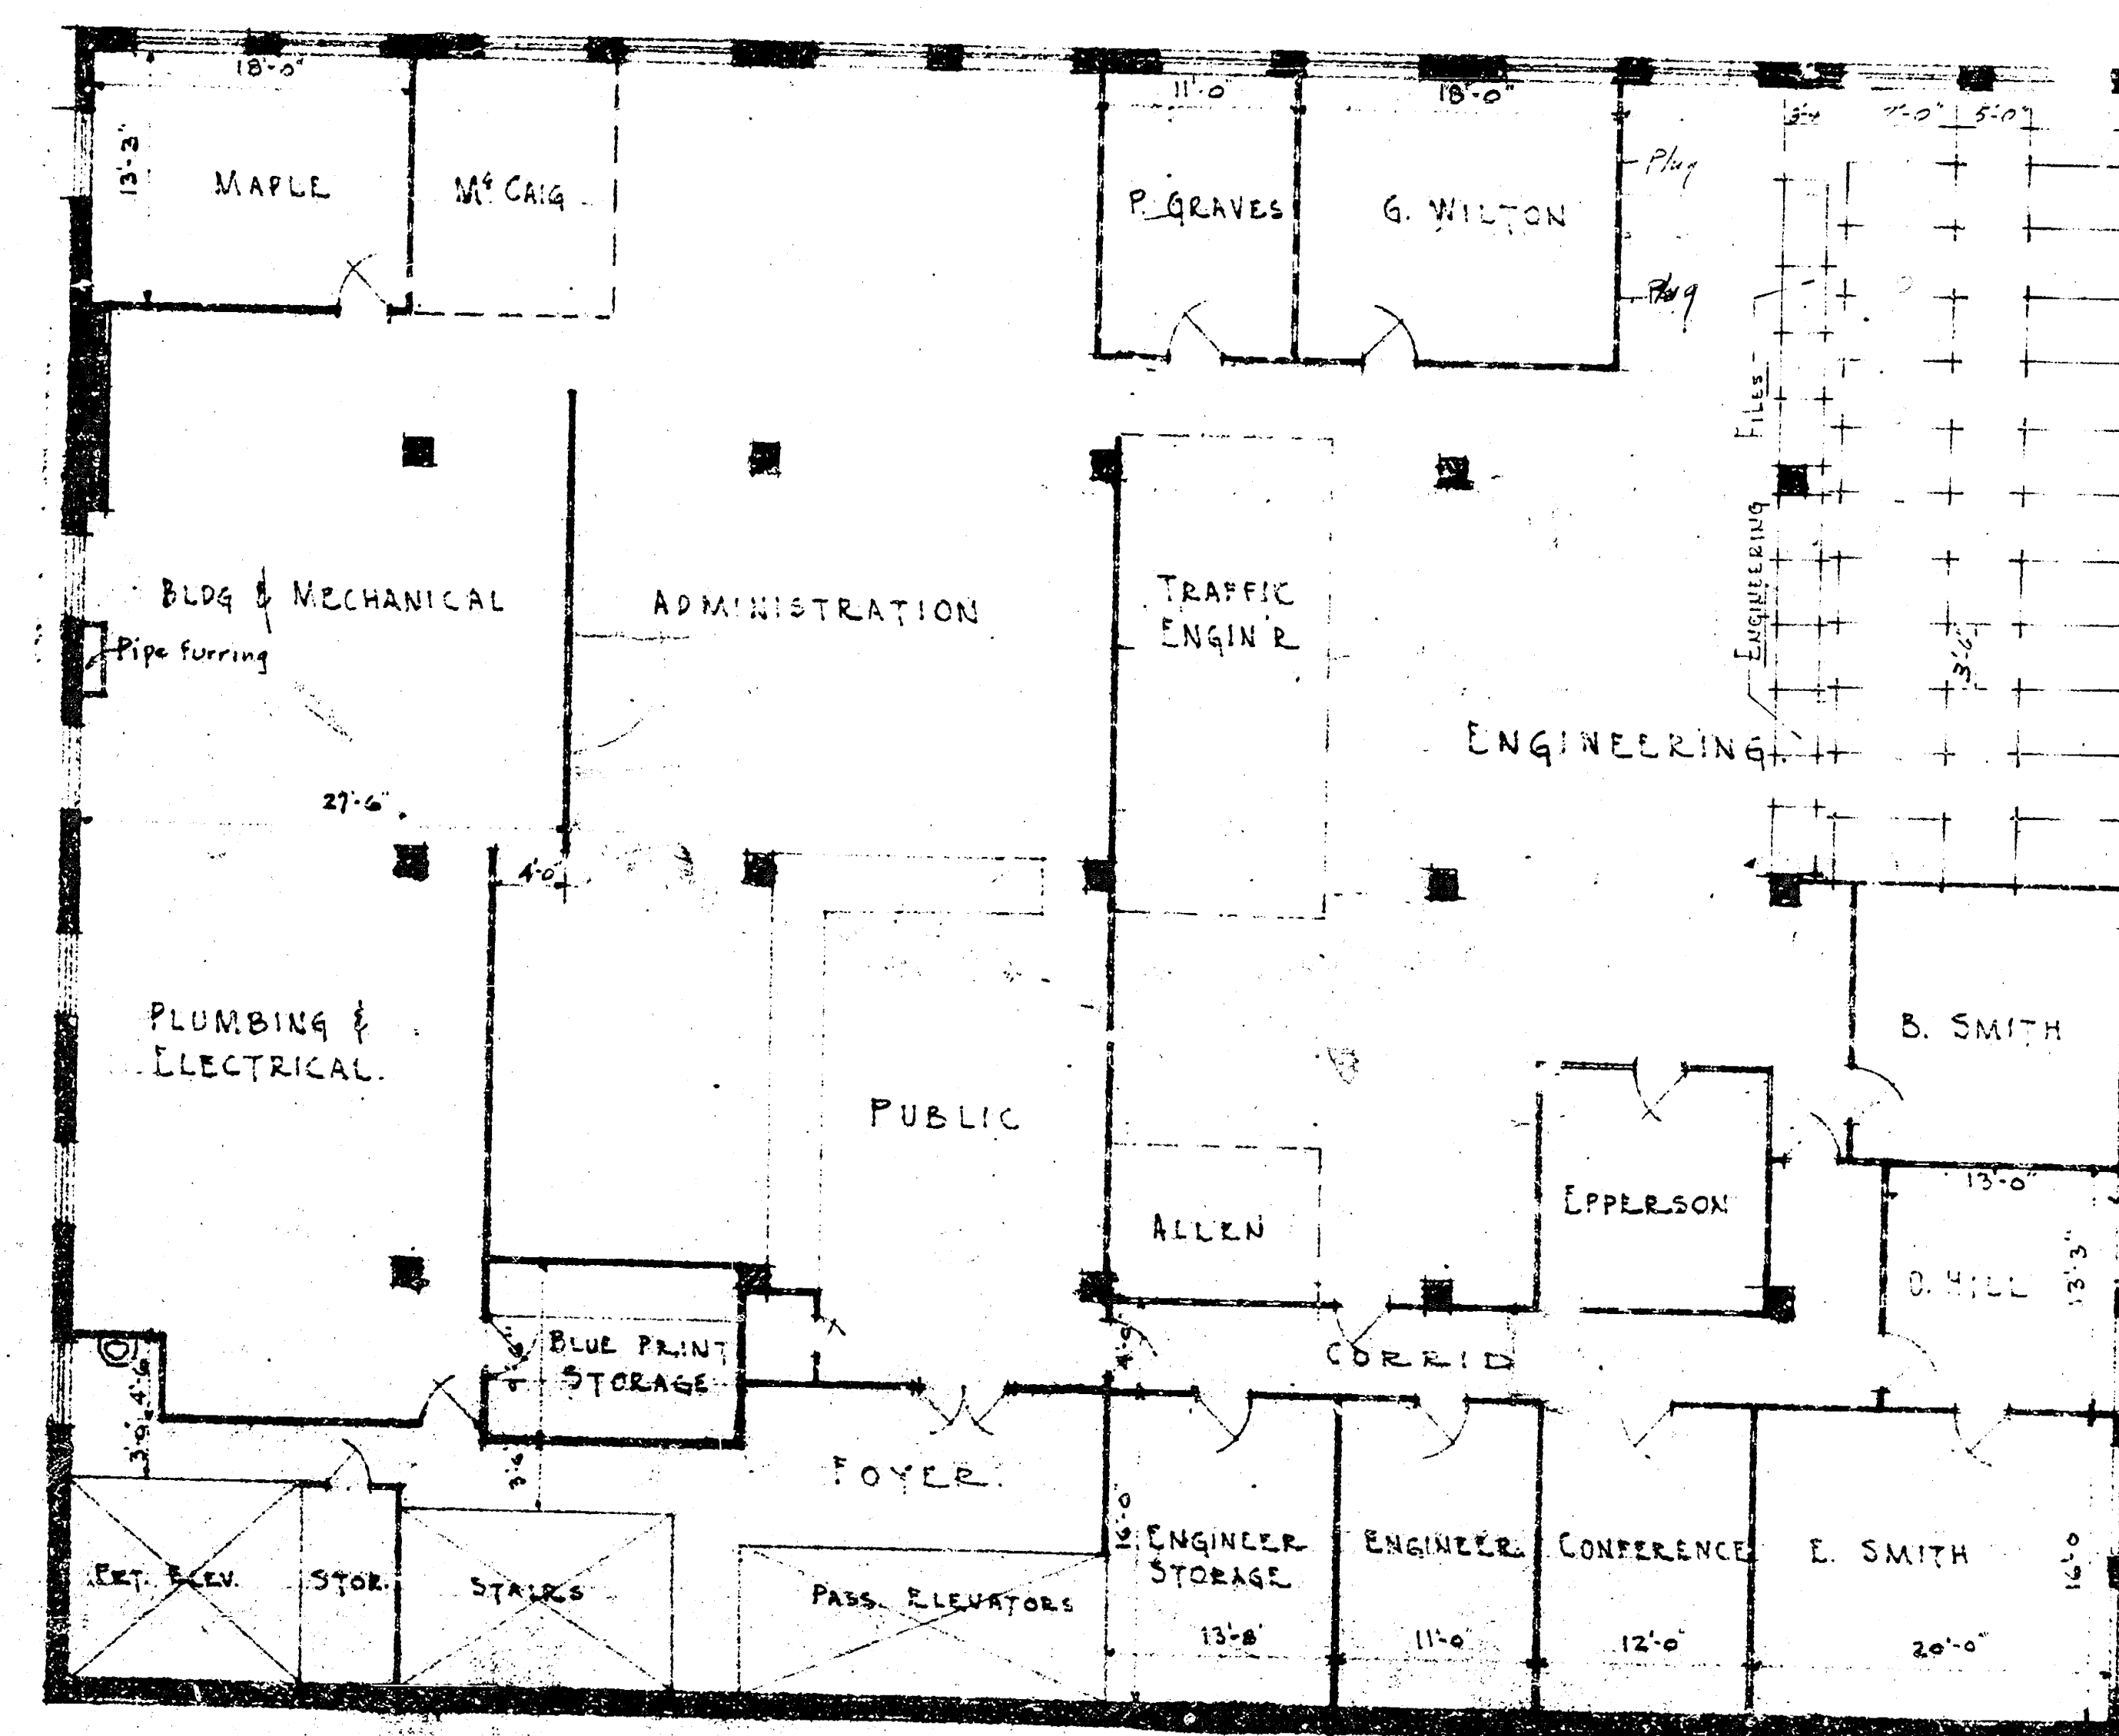

KEY TO PARTITION HEIGHT

To ceiling	=====
8'-0" HIGH	=====
5'-6" HIGH	=====

12-13-57.