PROFILE OF HIGH WATER LEVEL OF JUNE 1921 IN BIG ARKANSAS RIVER.

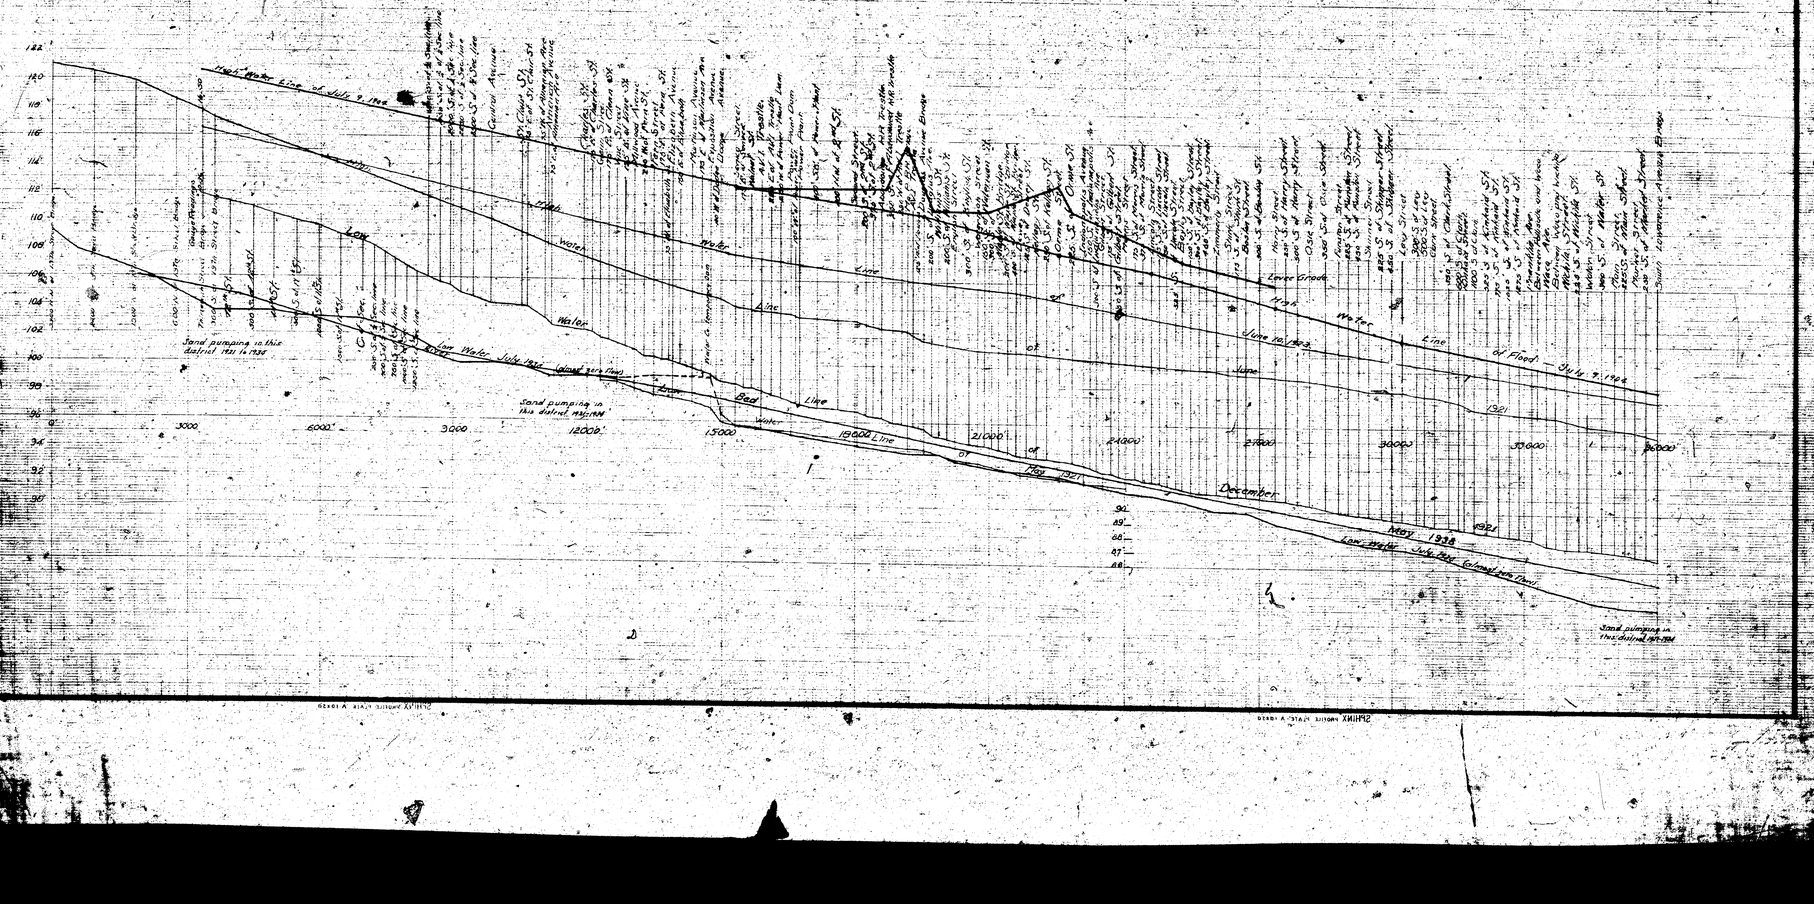

PROFILE OF HIGH WATER LEVEL OF JUNE 1921 IN BIG ARKANSAS RIVER.