

WYE BRANCH MAP OF THE
SEWER DISTRIBUTION SYSTEM
FOR


EASTBOROUGH ESTATES

SCALE 1"=100'

CONTOUR INTERVALS 2'-0"

DON C. MOEHRING

CONSULTING CIVIL ENGINEER
WICHITA, KANSAS.

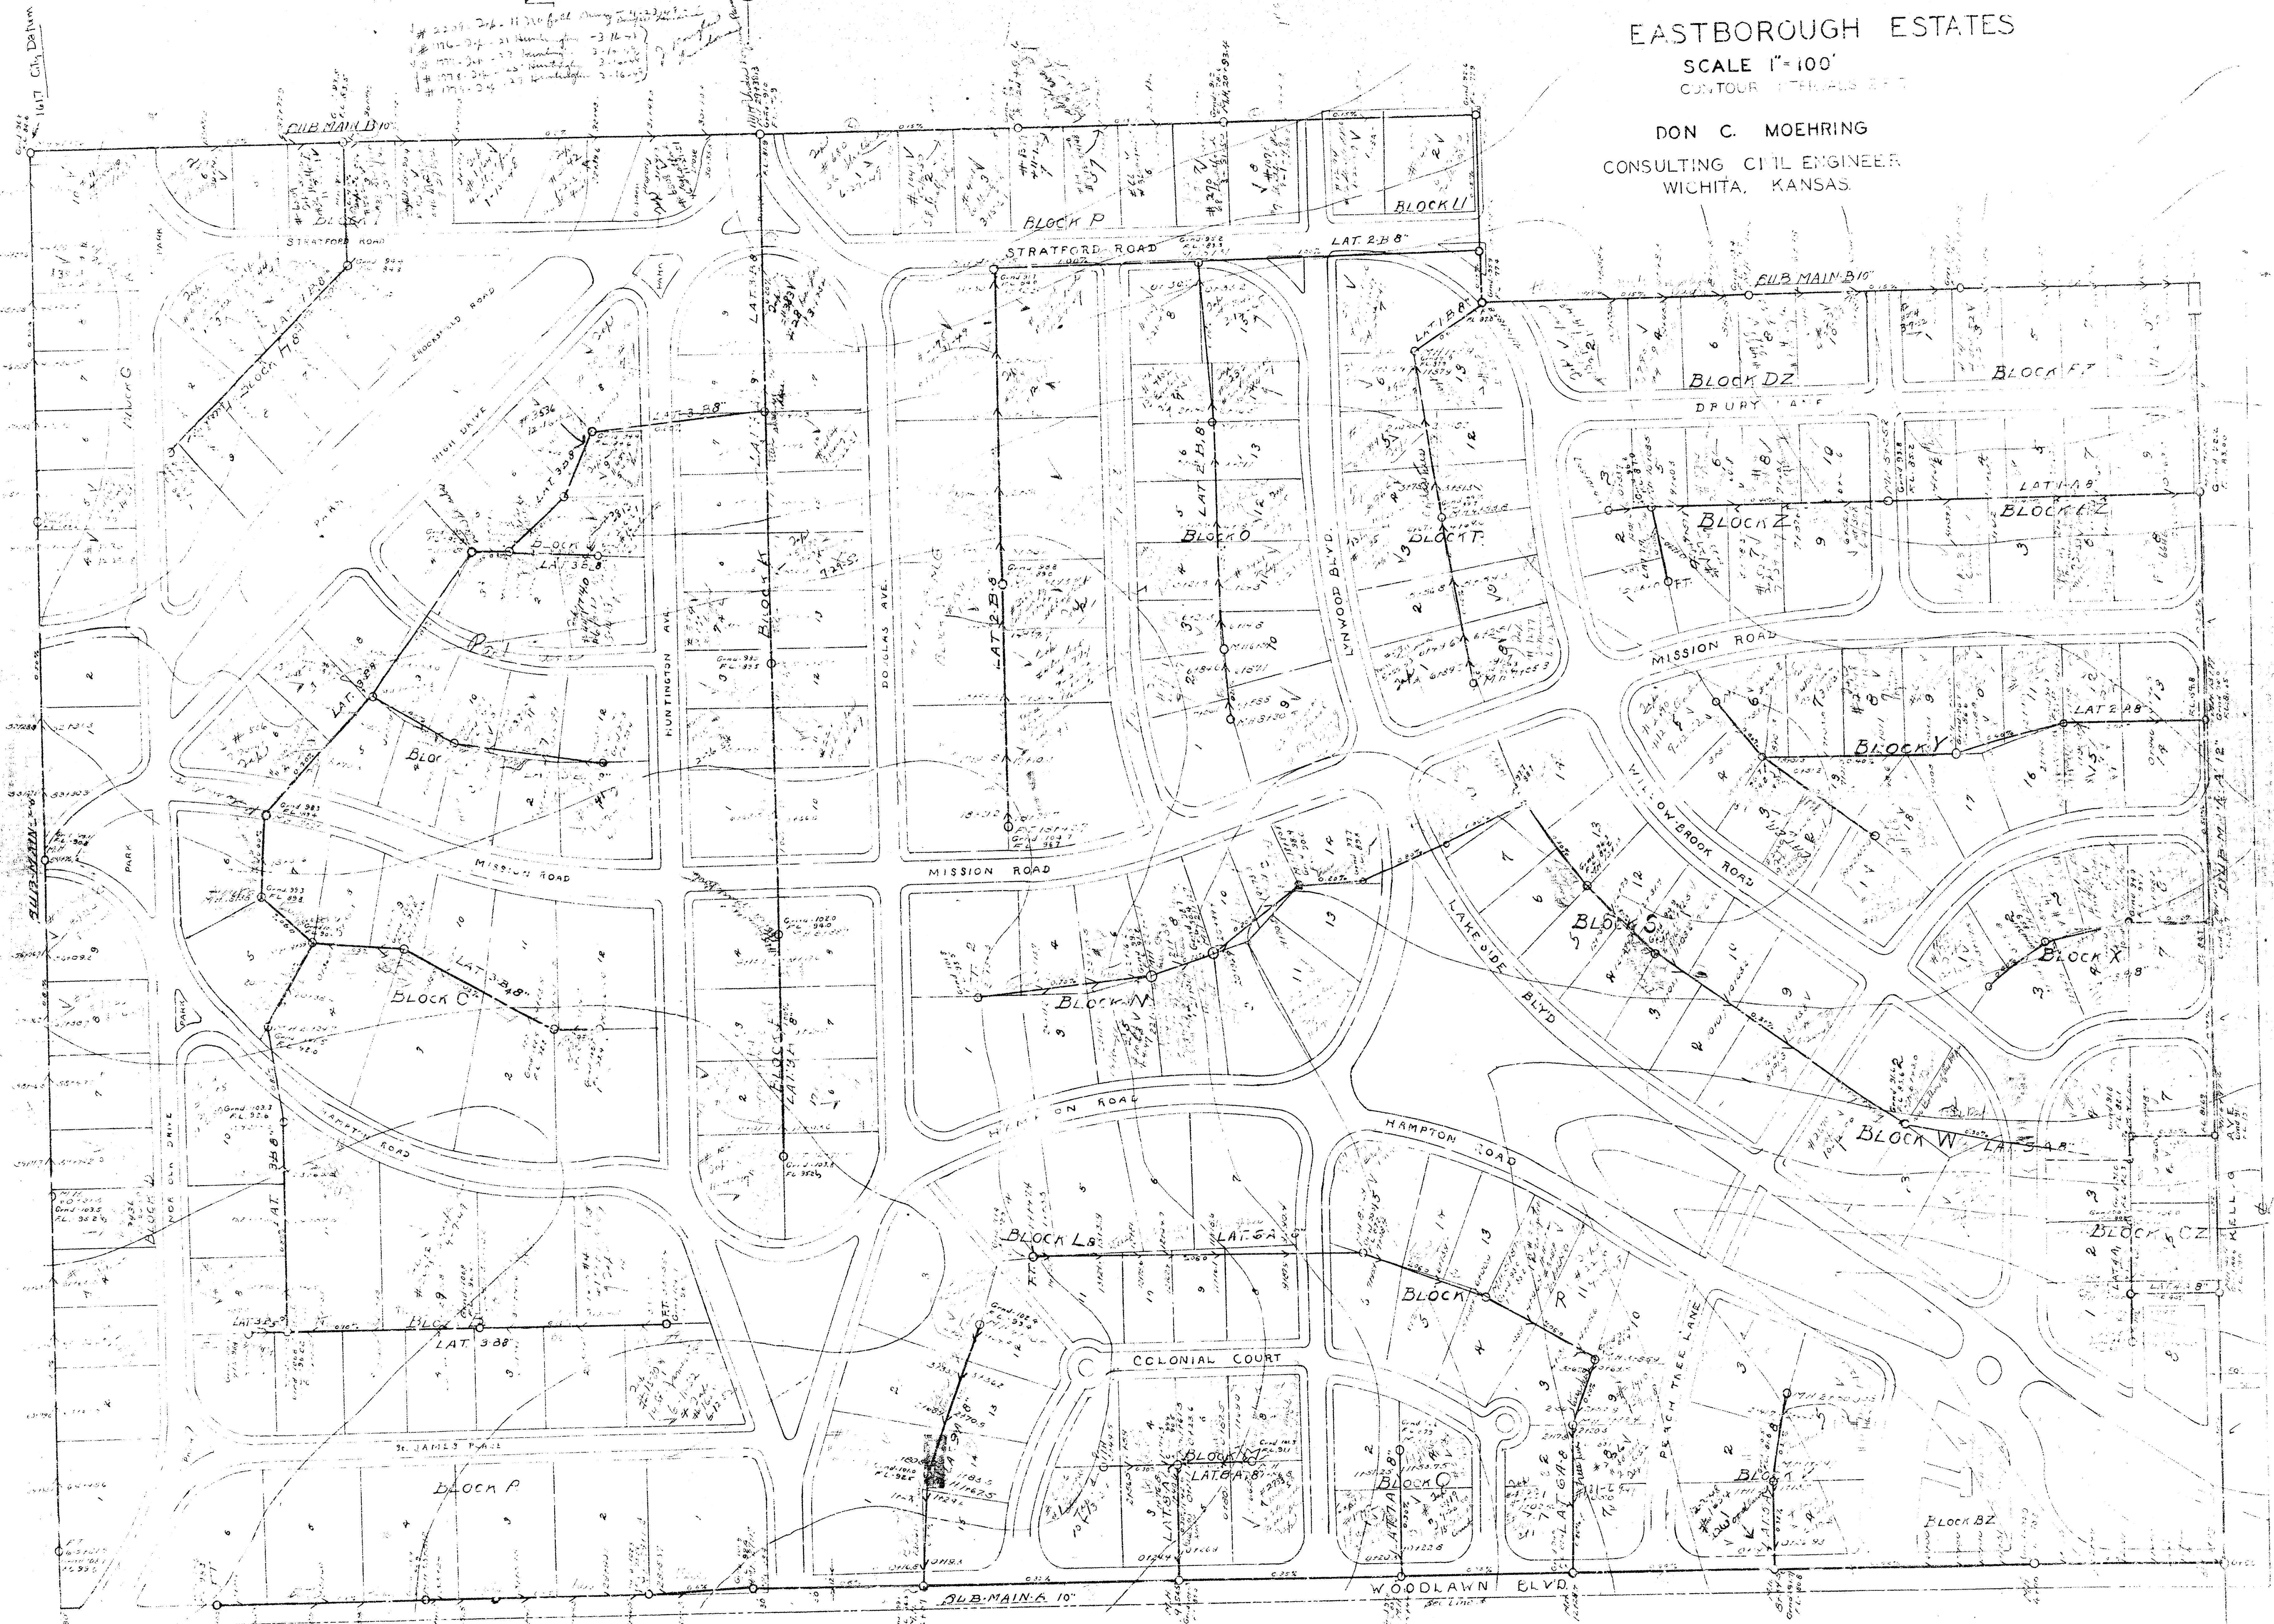


WORKS BRANCH MAP OF THE
SEWER DISTRIBUTION SYSTEM
FOR

EASTBOROUGH ESTATES

SCALE 1"=100'
CONTINUOUS

DON C. MOEHRING
CONSULTING CIVIL ENGINEER
WICHITA, KANSAS

