Field Notes of Survey of Mill Pond
and in Little Arkansas River in
Sec. 29 Township 26 South Range 1 East
of 6 P. M. Beg at S W Cor of SE¼
SW¼ Sec. 29 Township 26 South Range
1 East of 6th P.M.

Thence North			2933	2933 feet	
N	57° - 12	E	273	273 ft to N bank of Mill Pond	
N	13° - 27	W	155	left " Little Ark river	
N	53 - 53	E	255	with meanders of river	
N	32 - 33	E	245	" " " "	
N	42 - 33	E	117	" " " "	
N	61 - 53	E	277	" " " "	
N	37 - 33	E	66	" " " "	
N	13 - 03	E	163	" " " "	
N	22 - 03	E	600	" " " "	
N	61 - 13	E	117	feet	
N	13 - 51	E	130	"	to the hedge
N	33 - 34	W	190	"	
N	12 - 09	W	65	"	
N	33 - 24	W	180	"	
N	60 - 24	W	230	"	
N	31 - 24	W	136	"	
N	53 - 44	W	563	"	
N	20 - 44	W	190	"	
N	64 - 24	W	635	"	
N	15 - 36	E	725	"	
N	9 - 51	E	412	"	
N	6 - 09	W	230	"	
N	45 - 31	E	82	"	
N	8 - 54	W	263	"	
N	22 - 14	W	293	"	2919 feet on the run then with bearing
S	79 - 09	E	1315	feet	to W sec. Cor. on S. line Sec. 29
N	41 - 44	W	418	"	
N	54 - 14	W	260	"	
S	79 - 31	W	410	"	
S	10 - 29	E	75	"	
N	76 - 31	E	372	"	
S	43 - 14	E	252	"	
S	41 - 04	E	291	"	
S	19 - 04	E	287	"	
S	6 - 44	E	611	"	
S	13 - 56	W	430	"	
S	38 - 11	W	215	"	
S	11 - 21	W	528	"	
S	62 - 37	E	666	"	
S	0 - 21	W	290	"	
S	29 - 09	E	113	"	
S	53 - 19	E	845	"	
S	0 - 21	W	796	"	
S	27 - 56	W	241		
S	73 - 16	W	128	"	
S	42 - 16	W	336	"	to the W line of S. E. ¼ S. W. ¼ 29.26.
S	63 - 41	W	355	"	
Thence South			545 ft	to point	293.3 North of beginning

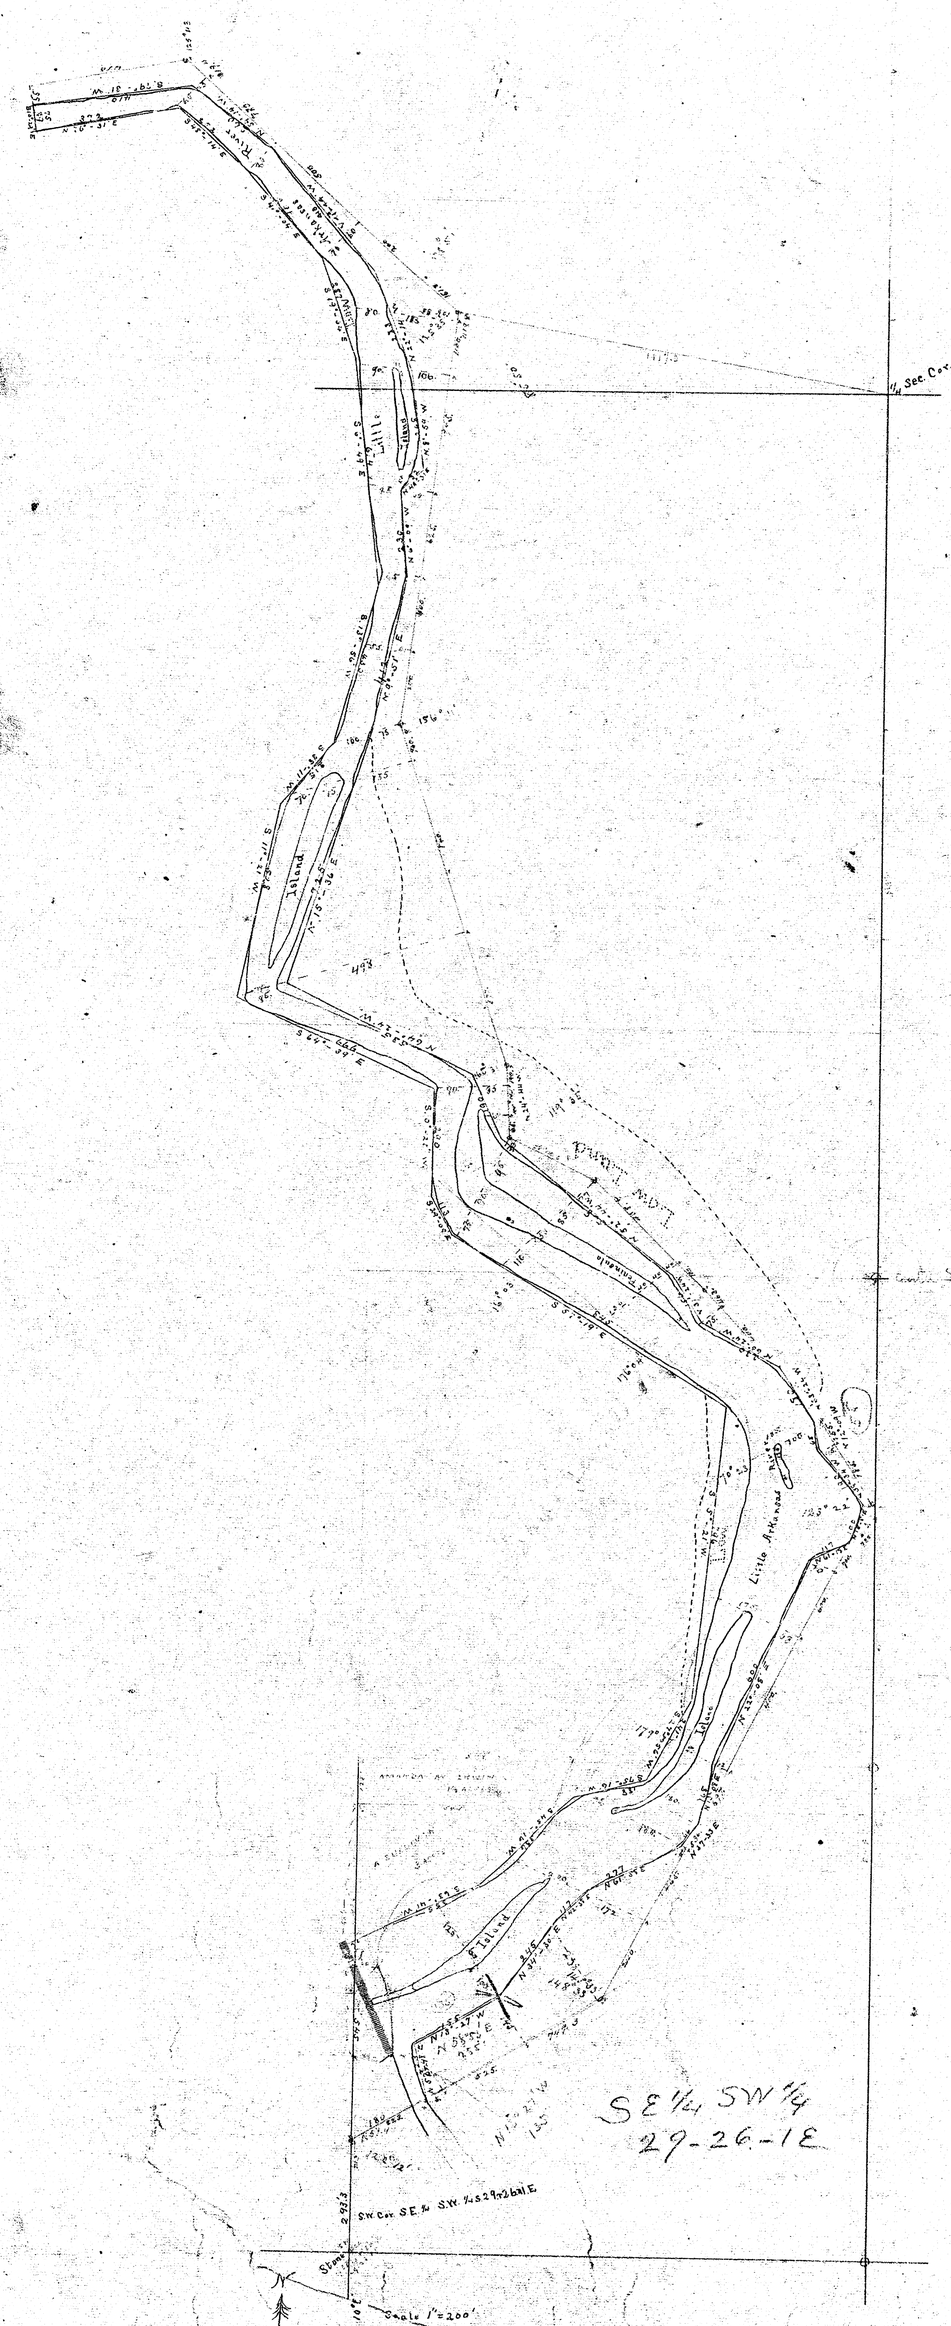

Map of Mill Pond
and
Little Arkansas River
North from the Dam.
in Sec. 29. Tows. 26 S. Range 1 E. of 6 P.M.