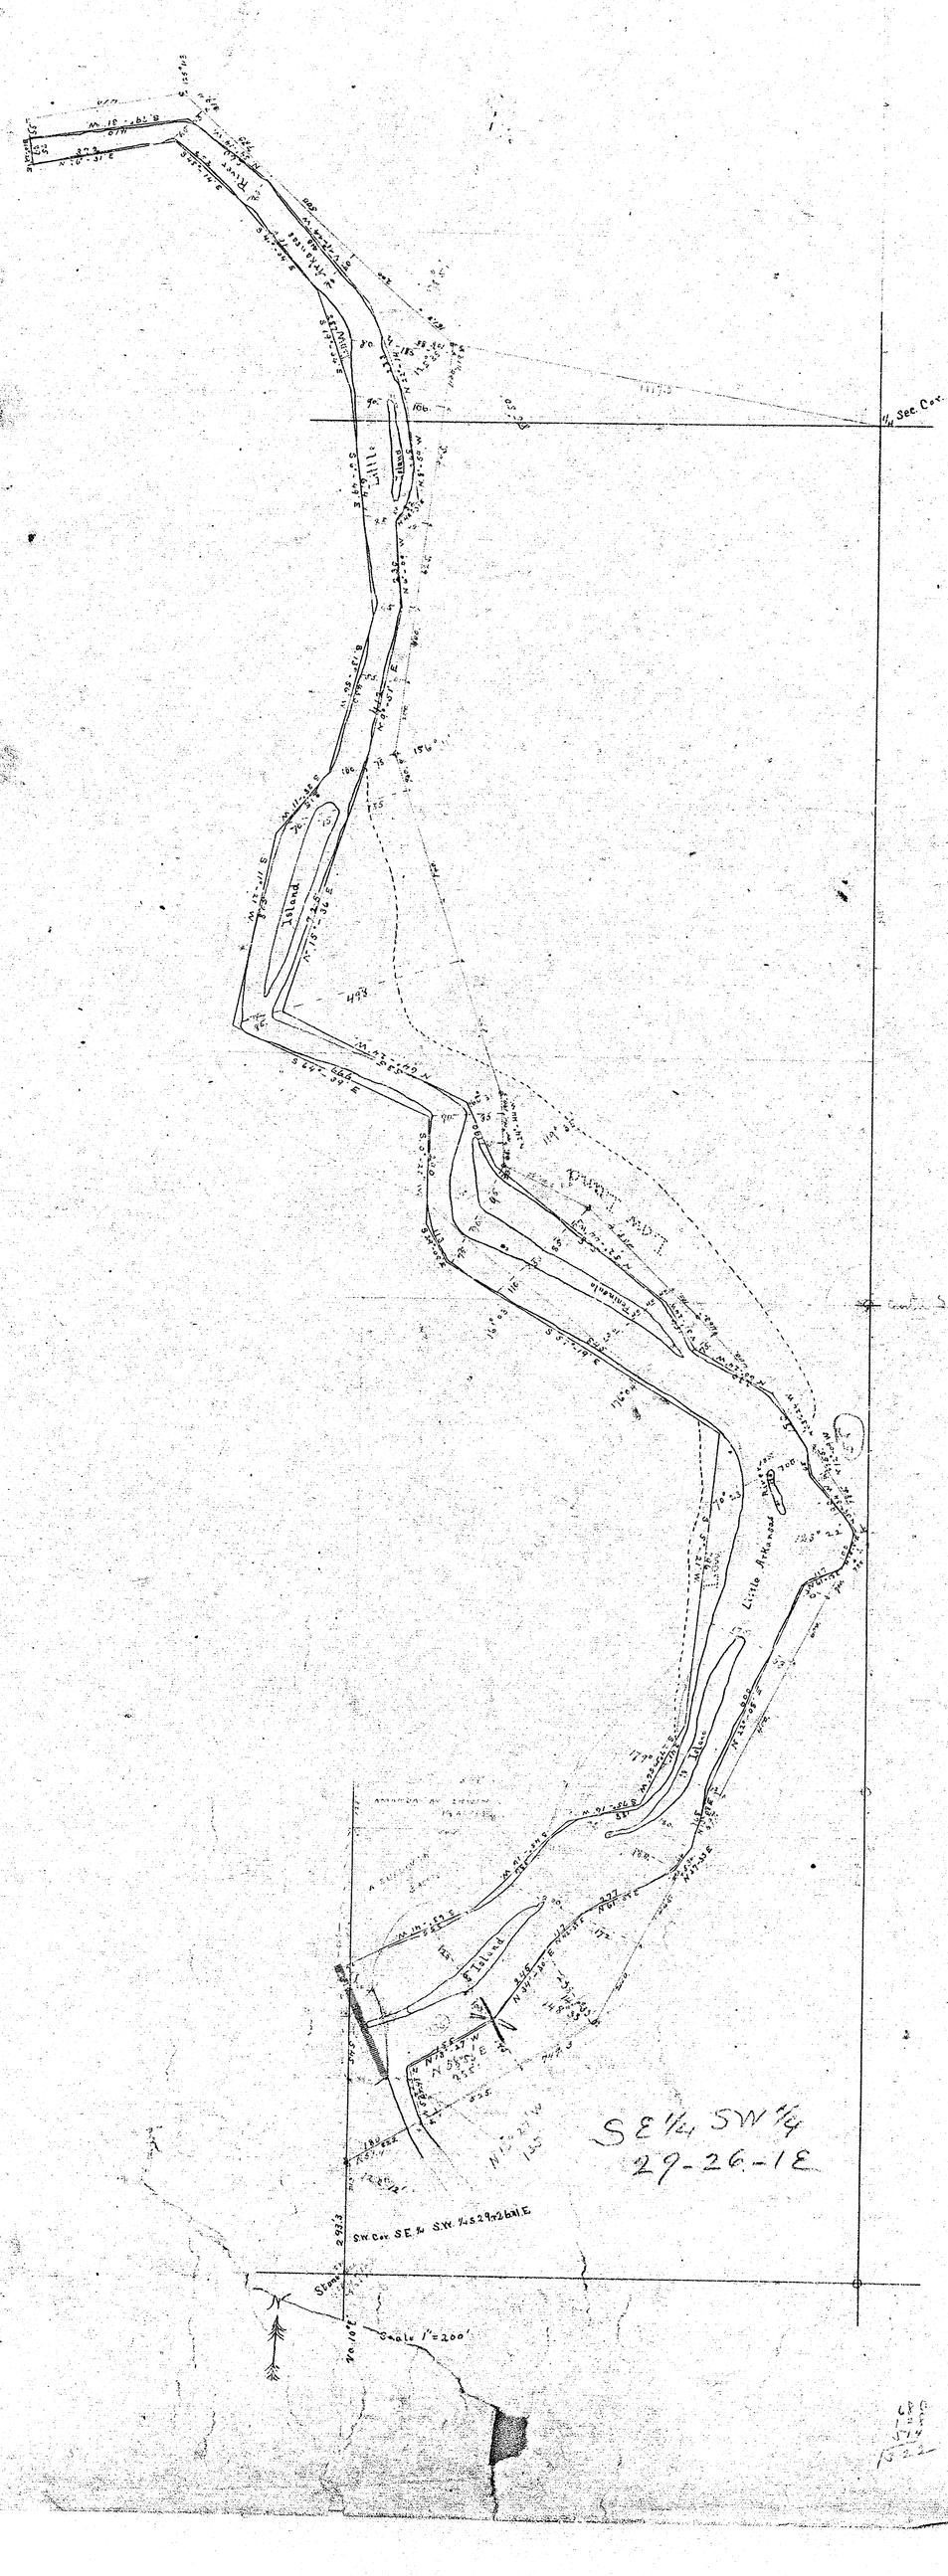
Field Notes of Survey of Mill Pond
and in Little Arkansas River in
Sec. 29 Township 26 South Range 1 East
of 6 P.M. Beg at S.W. Cor of Sec
S.W.¼ Sec. 29 Township 26 South Range
1 East of 6 P.M.

Thence	South		1938	2933 feet
N	57°	15'	E	273 ft to N. bank of Mill race
N	13°	27'	W	158 " Little Ark. river
N	58°	53'	E	255 with meanders of river
N	32°	33'	E	245 " " " "
N	42°	33'	E	117 " " " "
N	61°	58'	E	277 " " " "
N	37°	33'	E	66 " " " "
N	13°	28'	E	168 " " " "
N	22°	28'	E	600 " " " "
N	61°	12'	E	117 feet
N	13°	51'	E	130 " to the hedge
N	33°	24'	W	190 "
N	12°	09'	W	65 "
N	33°	24'	W	180 "
N	60°	24'	W	230 "
N	31°	24'	W	136 "
N	58°	44'	W	563 "
N	20°	44'	W	190 "
N	64°	24'	W	635 "
N	15°	36'	E	725 "
N	9°	51'	E	412 "
N	6°	09'	W	230 "
N	45°	31'	E	82 "
N	8°	54'	W	263 "
N	22°	14'	W	293 " 2210 feet on this run then with bearing
S	78°	29'	E	1315 feet to N.W. Sec. Cor. on S. line Sec. 29
N	41°	44'	W	418 "
N	54°	14'	W	260 "
S	79°	31'	W	410 "
S	10°	29'	E	75 "
N	76°	31'	E	372 "
S	43°	14'	E	252 "
S	41°	04'	E	291 "
S	19°	04'	E	287 "
S	6°	44'	E	611 "
S	13°	56'	W	430 "
S	38°	11'	W	215 "
S	11°	21'	W	528 "
S	65°	37'	E	666 "
S	0°	21'	W	290 "
S	29°	09'	E	113 "
S	53°	19'	E	845 "
S	5°	21'	W	796 "
S	27°	56'	W	241 "
S	73°	16'	W	148 "
S	42°	16'	W	336 " to the W. line of S.E. ¼ S.W. ¼ 29-26.
S	63°	41'	W	365 " to point 295.3 North of beginning
Thence South				1545 ft to point 295.3 North of beginning


Mill Pond
Island
Island
Island