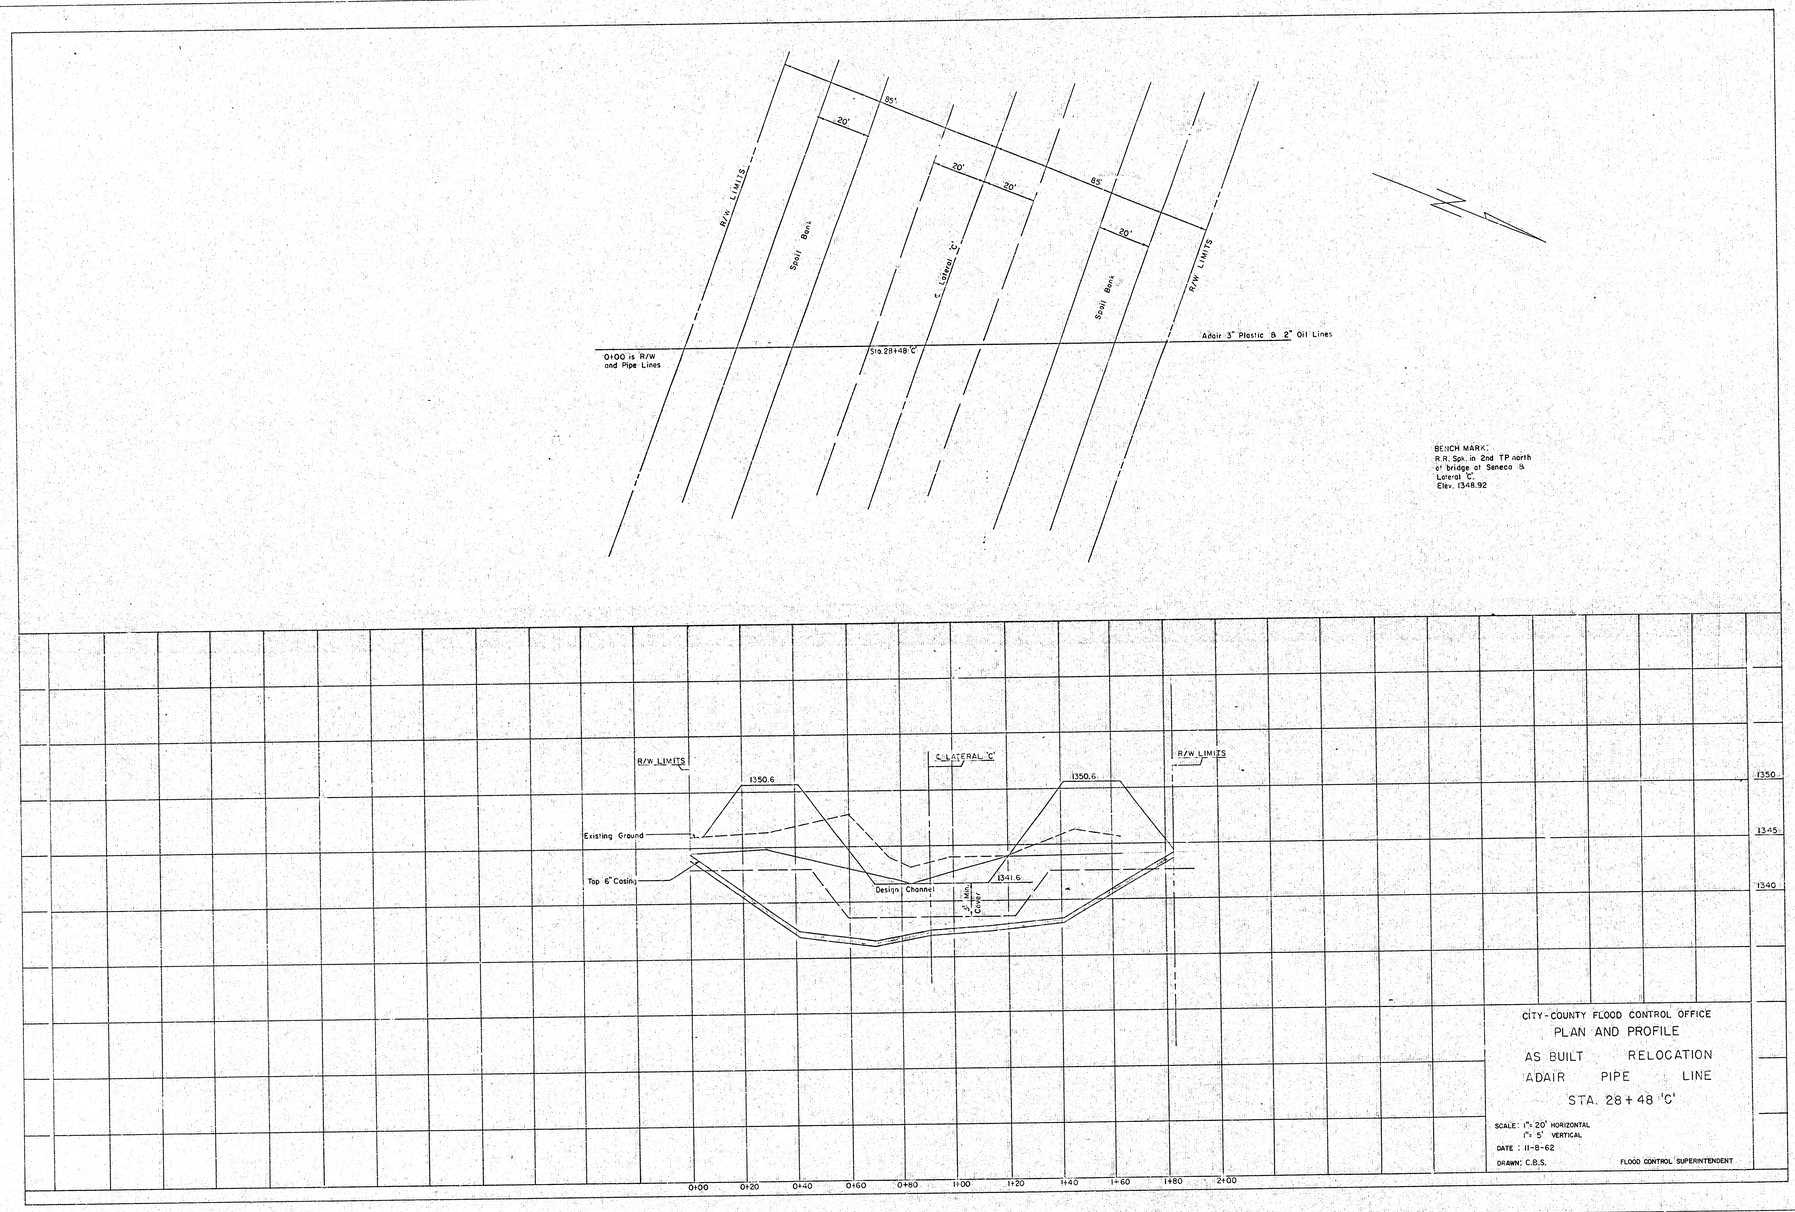
R/W LIMITS
Spoil Bank
20'
85'
20'
20'
85'
20'
℄ Lateral 'C'
Spoil Bank
R/W LIMITS
0+00 is R/W and Pipe Lines
Sta. 28+48 'C'
Adair 3" Plastic & 2" Oil Lines
BENCH MARK:
R.R. Spk. in 2nd TP north of bridge at Seneca & Lateral 'C'.
Elev. 1348.92
R/W LIMITS
℄ LATERAL 'C'
R/W LIMITS
1350.6
1350.6
Existing Ground
Top 6" Casing
Design Channel
1341.6
5' Min. Cover
1350
1345
1340
0+00
0+20
0+40
0+60
0+80
1+00
1+20
1+40
1+60
1+80
2+00
CITY-COUNTY FLOOD CONTROL OFFICE
PLAN AND PROFILE
AS BUILT RELOCATION
ADAIR PIPE LINE
STA. 28+48 'C'
SCALE: 1" = 20' HORIZONTAL
1" = 5' VERTICAL
DATE: 11-8-62
DRAWN: C.B.S.
FLOOD CONTROL SUPERINTENDENT