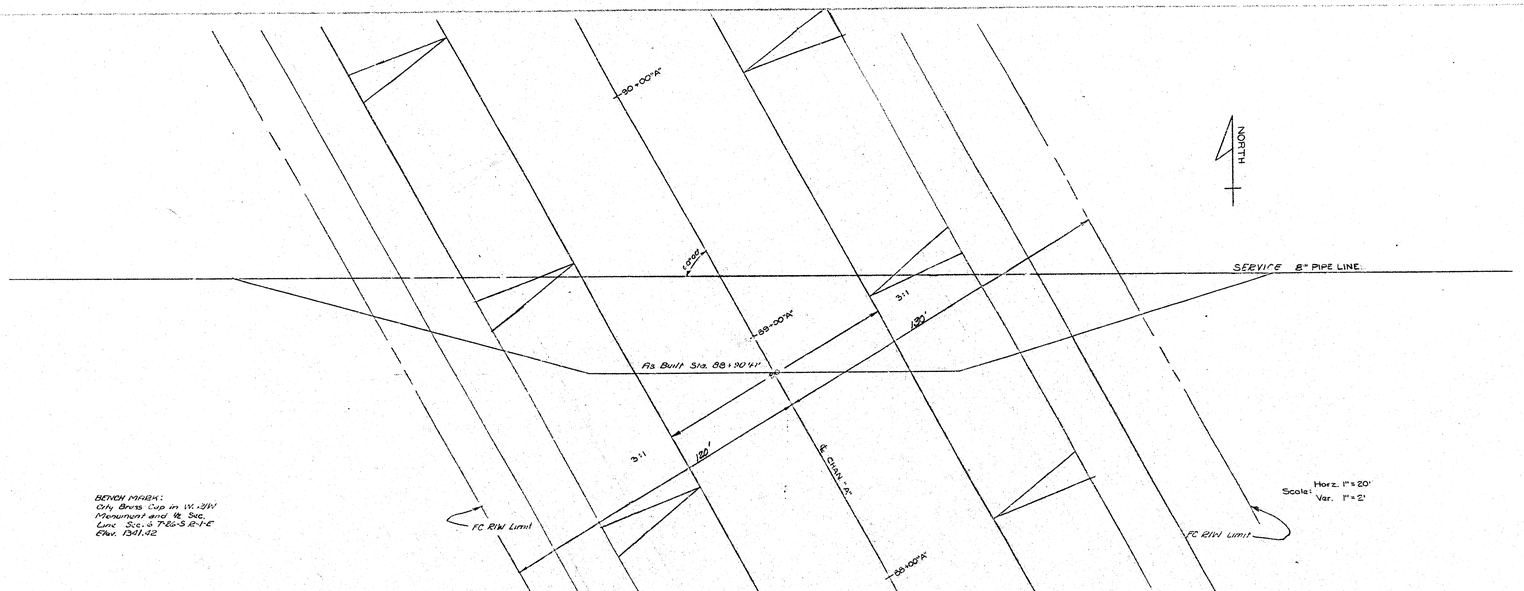

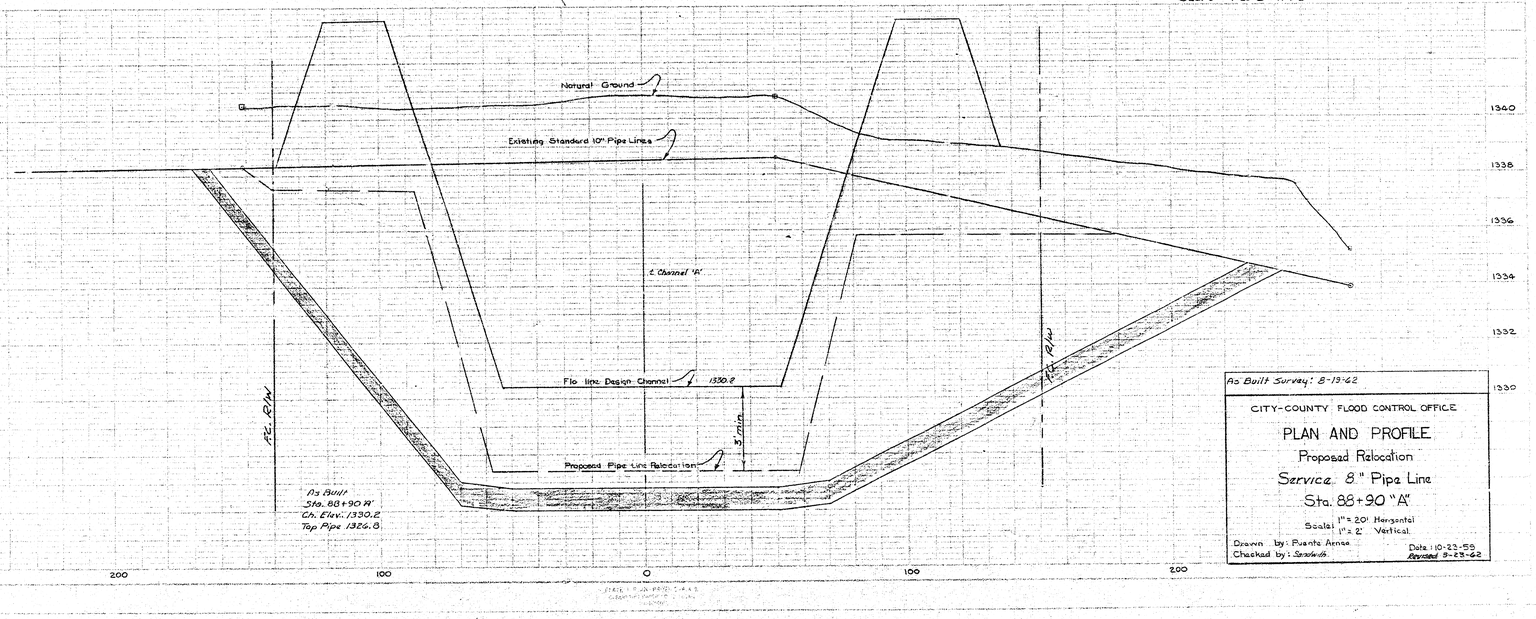

As Built Survey: 8-19-62

CITY-COUNTY FLOOD CONTROL OFFICE

PLAN AND PROFILE

Proposed Relocation

Service 8" Pipe Line

Sta. 88+90 "A"

Scale: 1"=20' Horizontal
1"=2' Vertical

Drawn by: Puente Arnao Date: 10-23-58
Checked by: Sandvik Revised 9-25-62