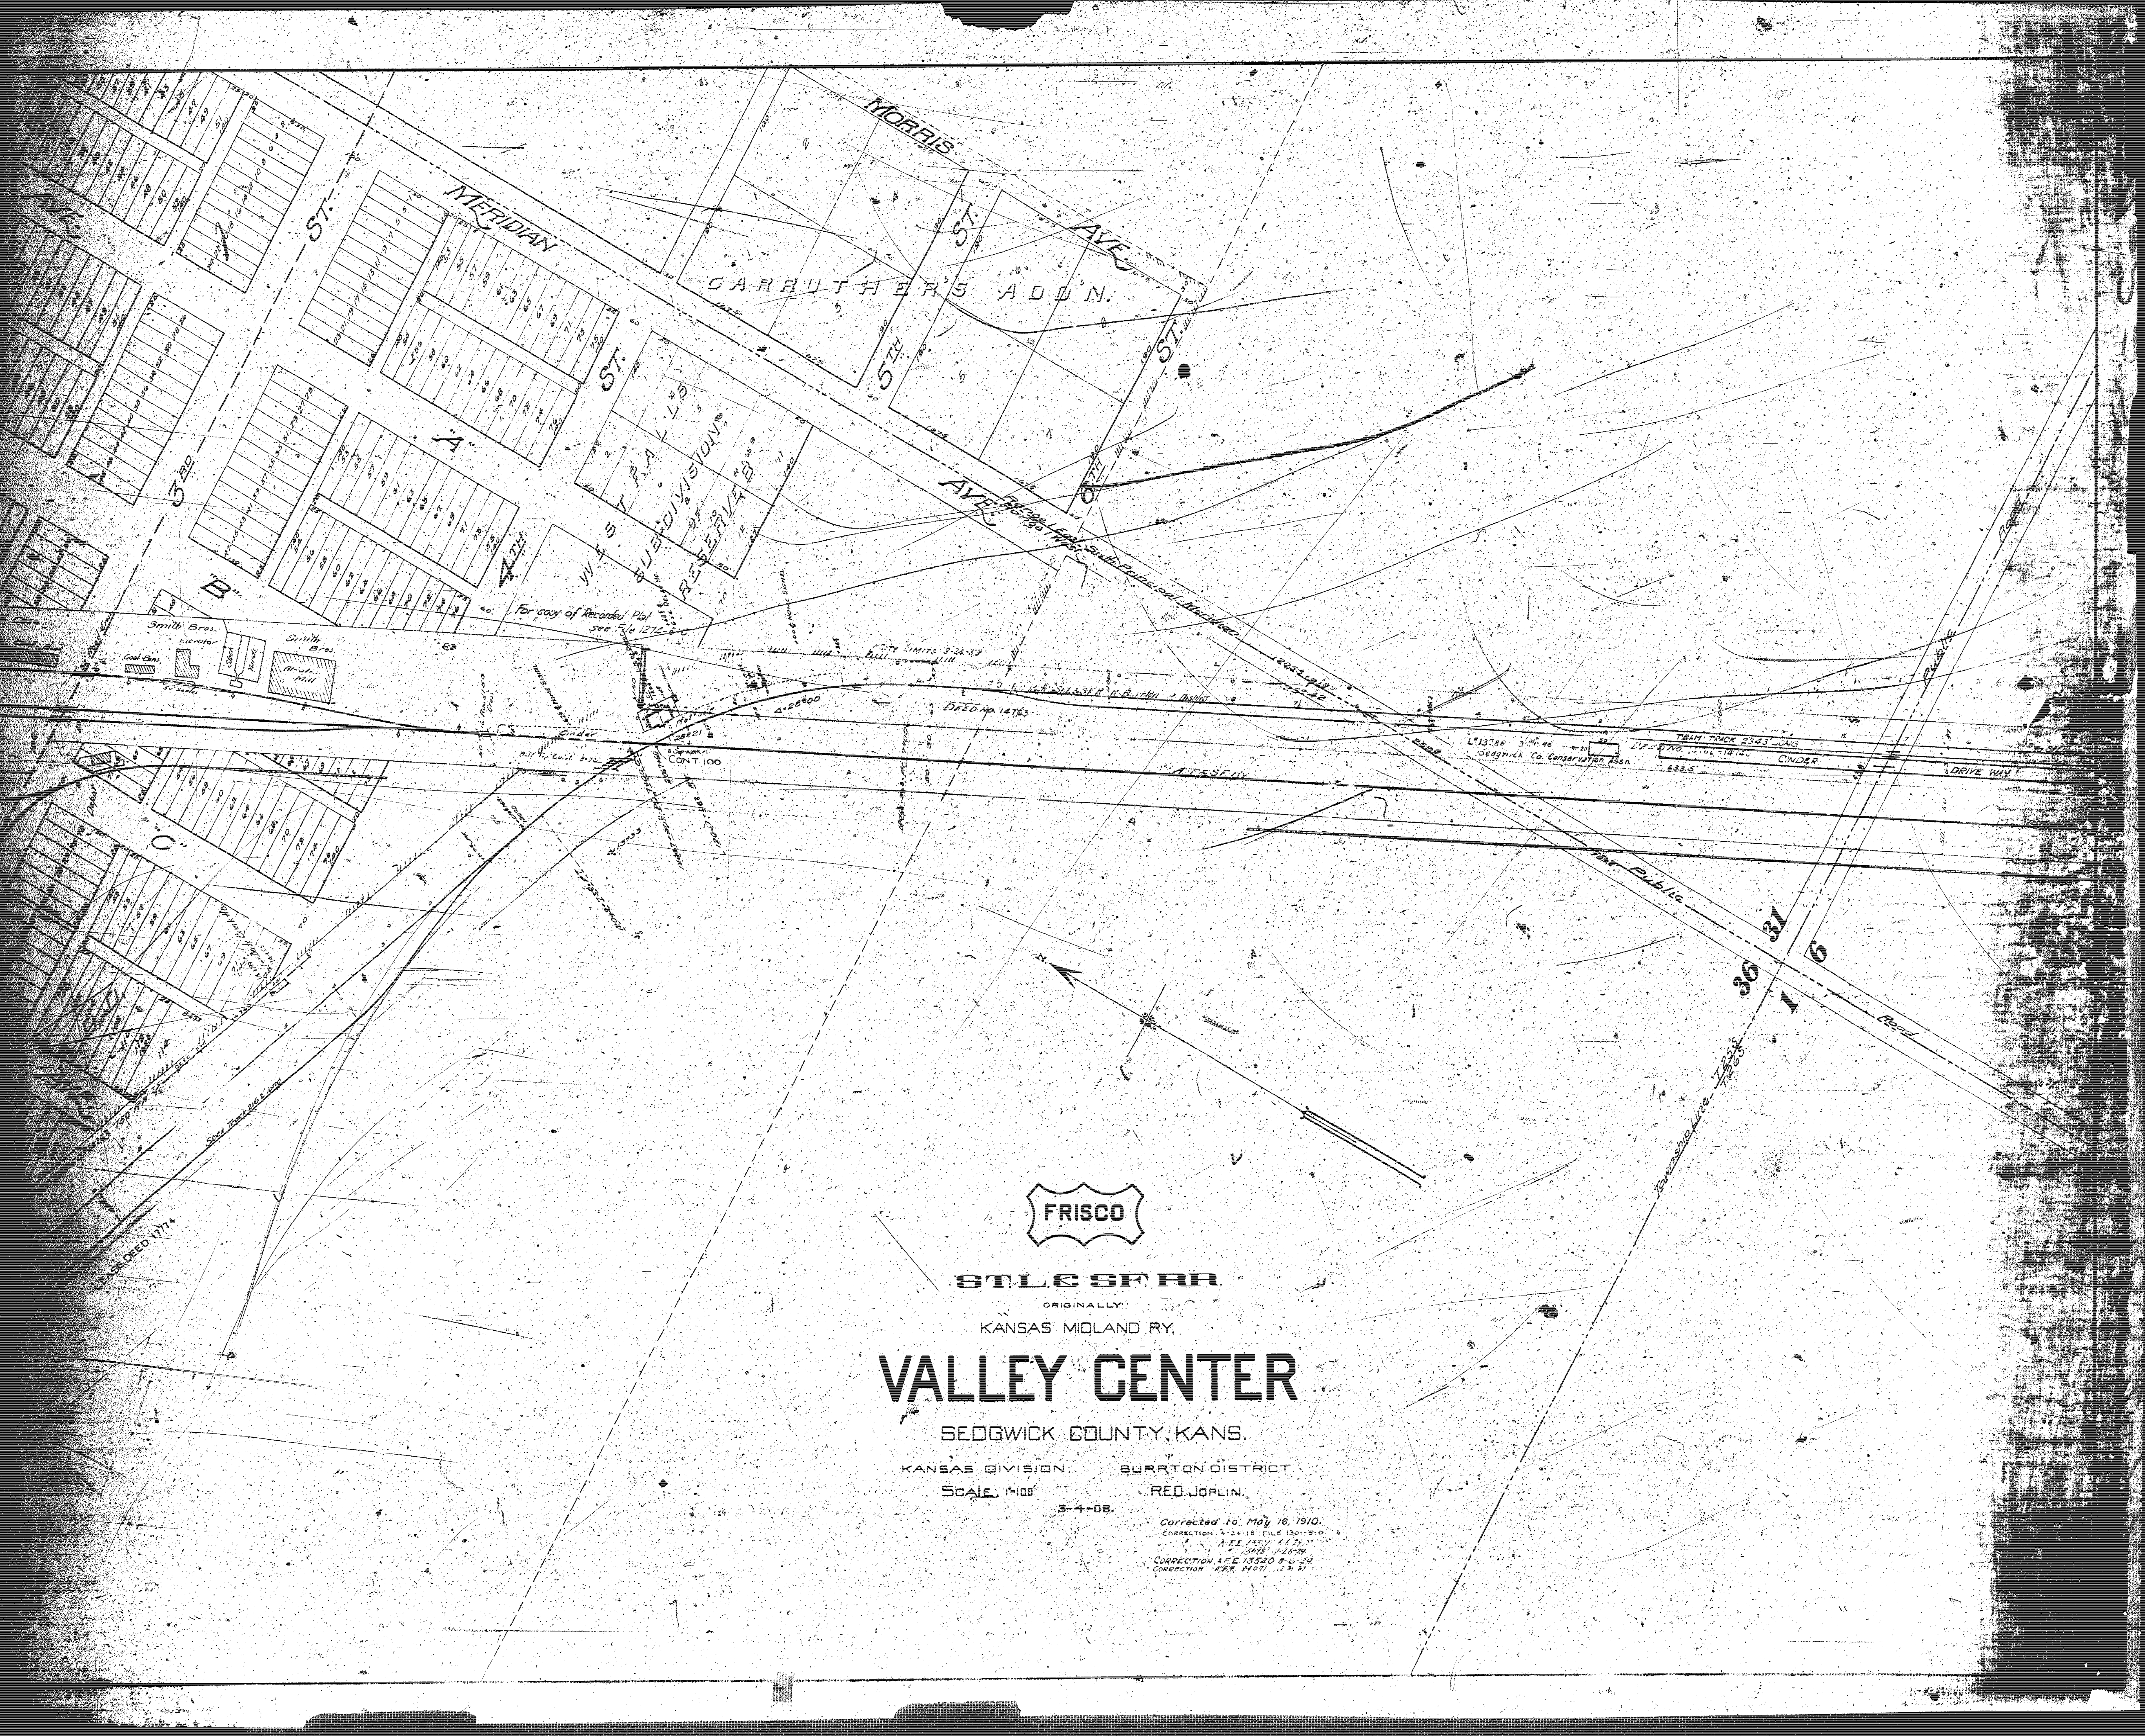
MORRIS AVE.
MERIDIAN AVE.
CARRUTHER'S ADD'N.
3RD ST.
4TH ST.
5TH ST.
6TH ST.
"A"
"B"
"C"
WEST FALLS SUBDIVISION OF RESERVE "B"
For copy of Recorded Plat see File 1274-B-C
Smith Bros. Elevator
Coal Bins
Smith Bros.
Stock Yards
Mill
50' Scales
Cinder
CONT. 100
City Limits 3-24-57
Deed No. 14763
Range Line East–West
Sixth Principal Meridian
A.T.&S.F. Ry.
Sedgwick Co. Conservation Assn.
TEAM TRACK 2343' LONG
CINDER
DRIVE WAY
Public Road
Public Road
36
31
1
6

FRISCO

ST. L. & S.F. R.R.

ORIGINALLY

KANSAS MIDLAND RY.

VALLEY CENTER

SEDGWICK COUNTY, KANS.

KANSAS DIVISION. BURRTON DISTRICT.

SCALE. 1"=100' R.E.D. JOPLIN.

3-4-08.

Corrected to May 16, 1910.
CORRECTION 4-24-18 FILE 1301-5-D
A.F.E. 13714 4-1-29
13693 7-26-29
CORRECTION A.F.E. 13520 8-6-29
CORRECTION A.F.E. 24071 12-31-37