


PLAN
 PROJECT: T-26-S, R.T.E. CHIS-CREEK II

PROFILE

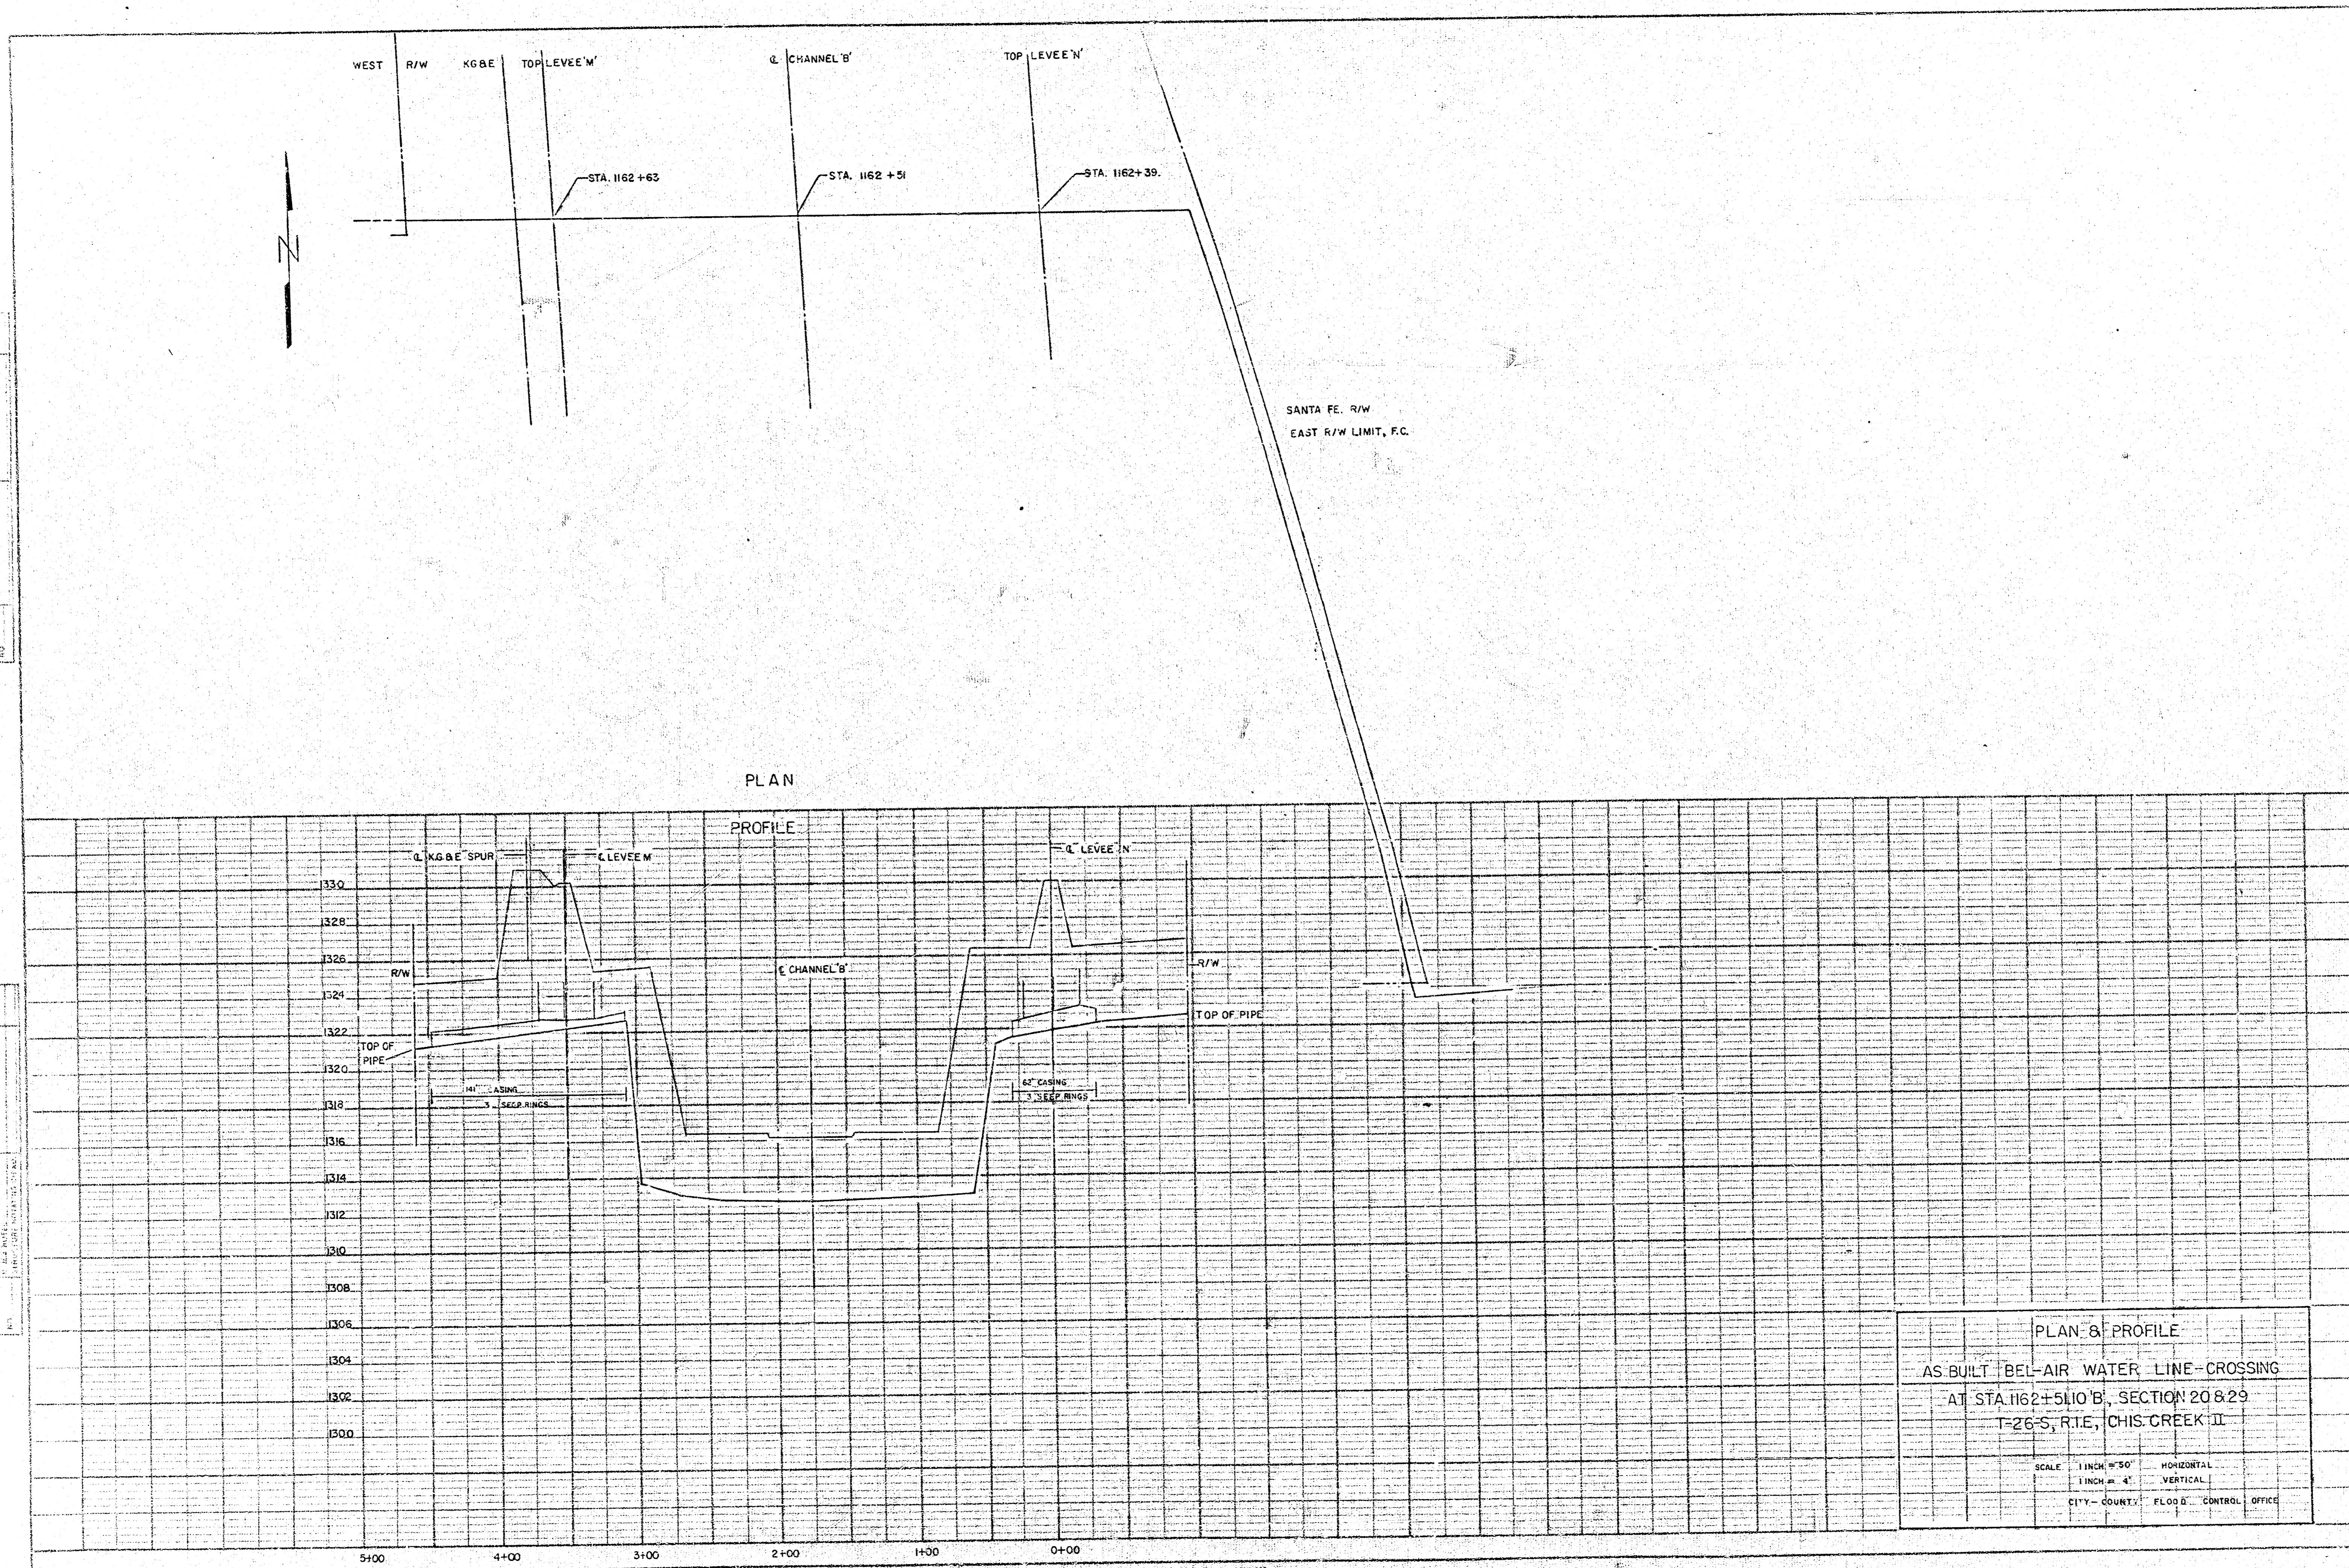

PLAN & PROFILE
 AS BUILT BEL-AIR WATER LINE CROSSING
 AT STA 1162+51.0' B, SECTION 20 & 29
 T-26-S, R.T.E. CHIS-CREEK II

SCALE: HORIZONTAL 1" = 50'
 VERTICAL 1" = 4'

CITY-COUNTY FLOOD CONTROL OFFICE

