


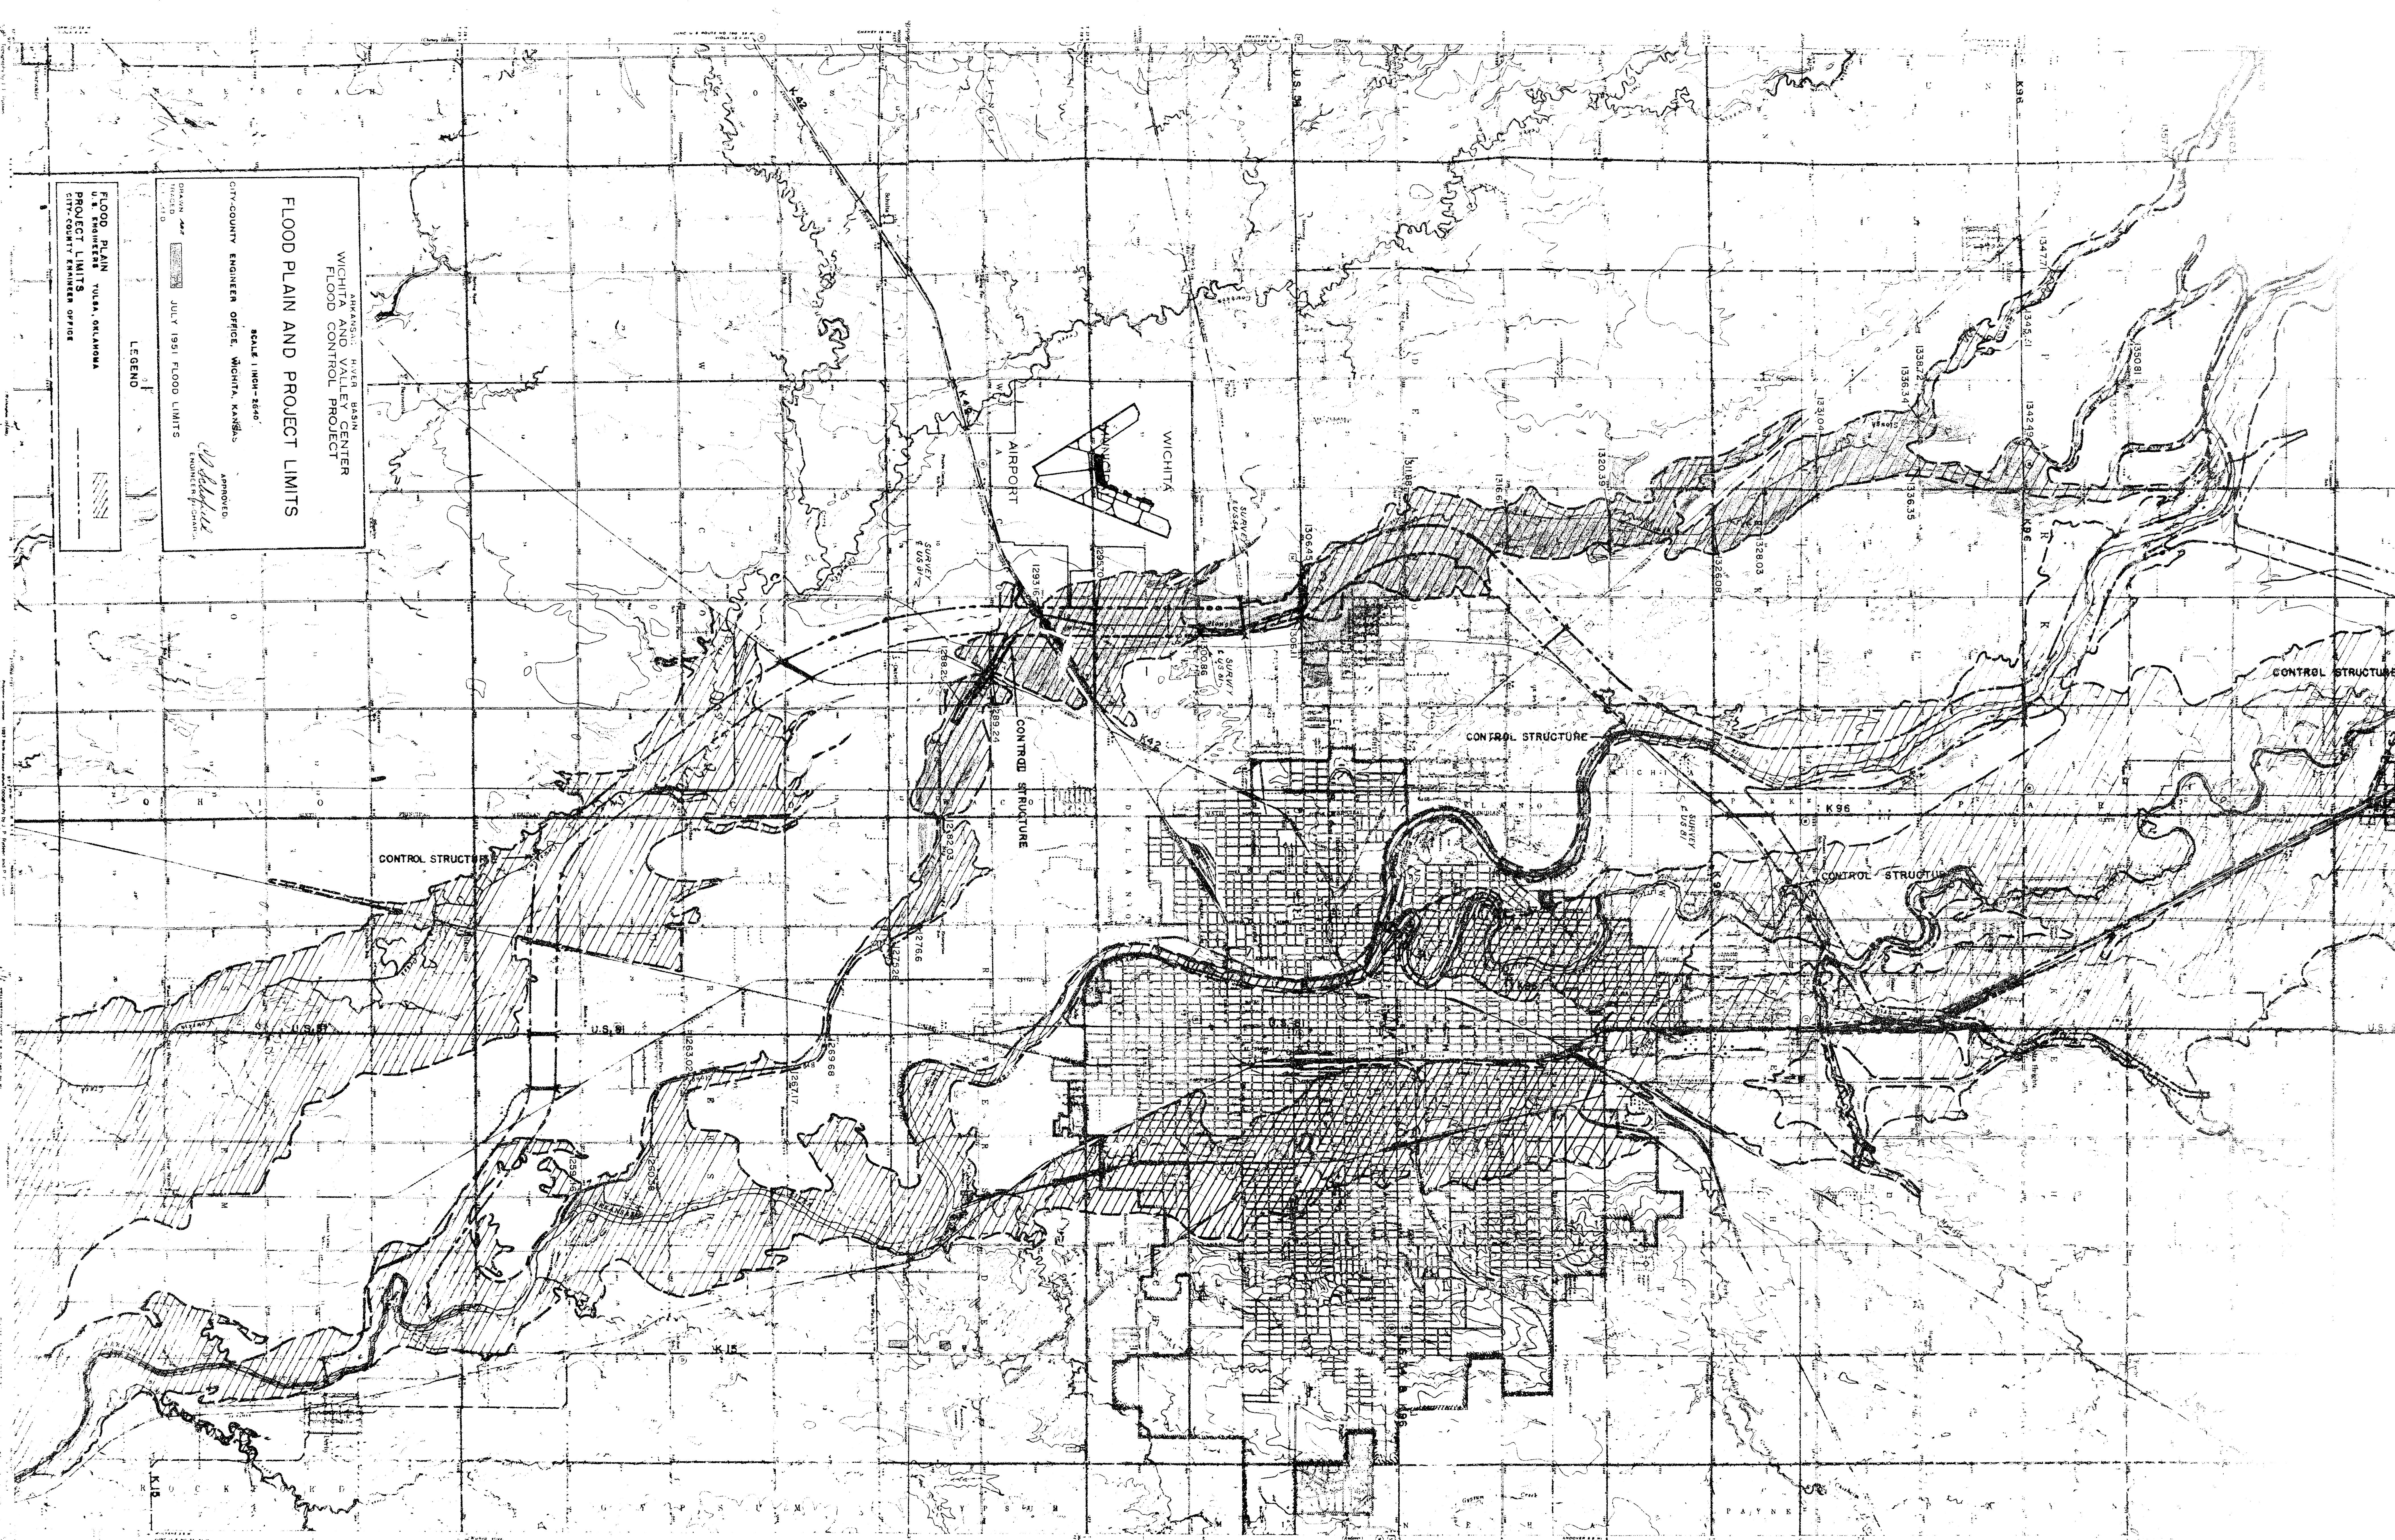

FLOOD PLAIN AND PROJECT LIMITS

WICHITA WATER DISTRICT  
WICHITA, KANSAS  
FLOOD CONTROL PROJECT

SCALE 1 INCH = 2500'

CITY-COUNTY ENGINEER OFFICE, WICHITA, KANSAS

APPROVED:

*[Signature]*

DRAWN BY: JULY 1951 FLOOD LIMITS


ENGINEER: *[Signature]*

LEGEND

FLOOD PLAIN  
U.S. ENGINEERING  
PROJECT LIMITS  
PROJECT LIMITS OFFICE

WICHITA, KANSAS  



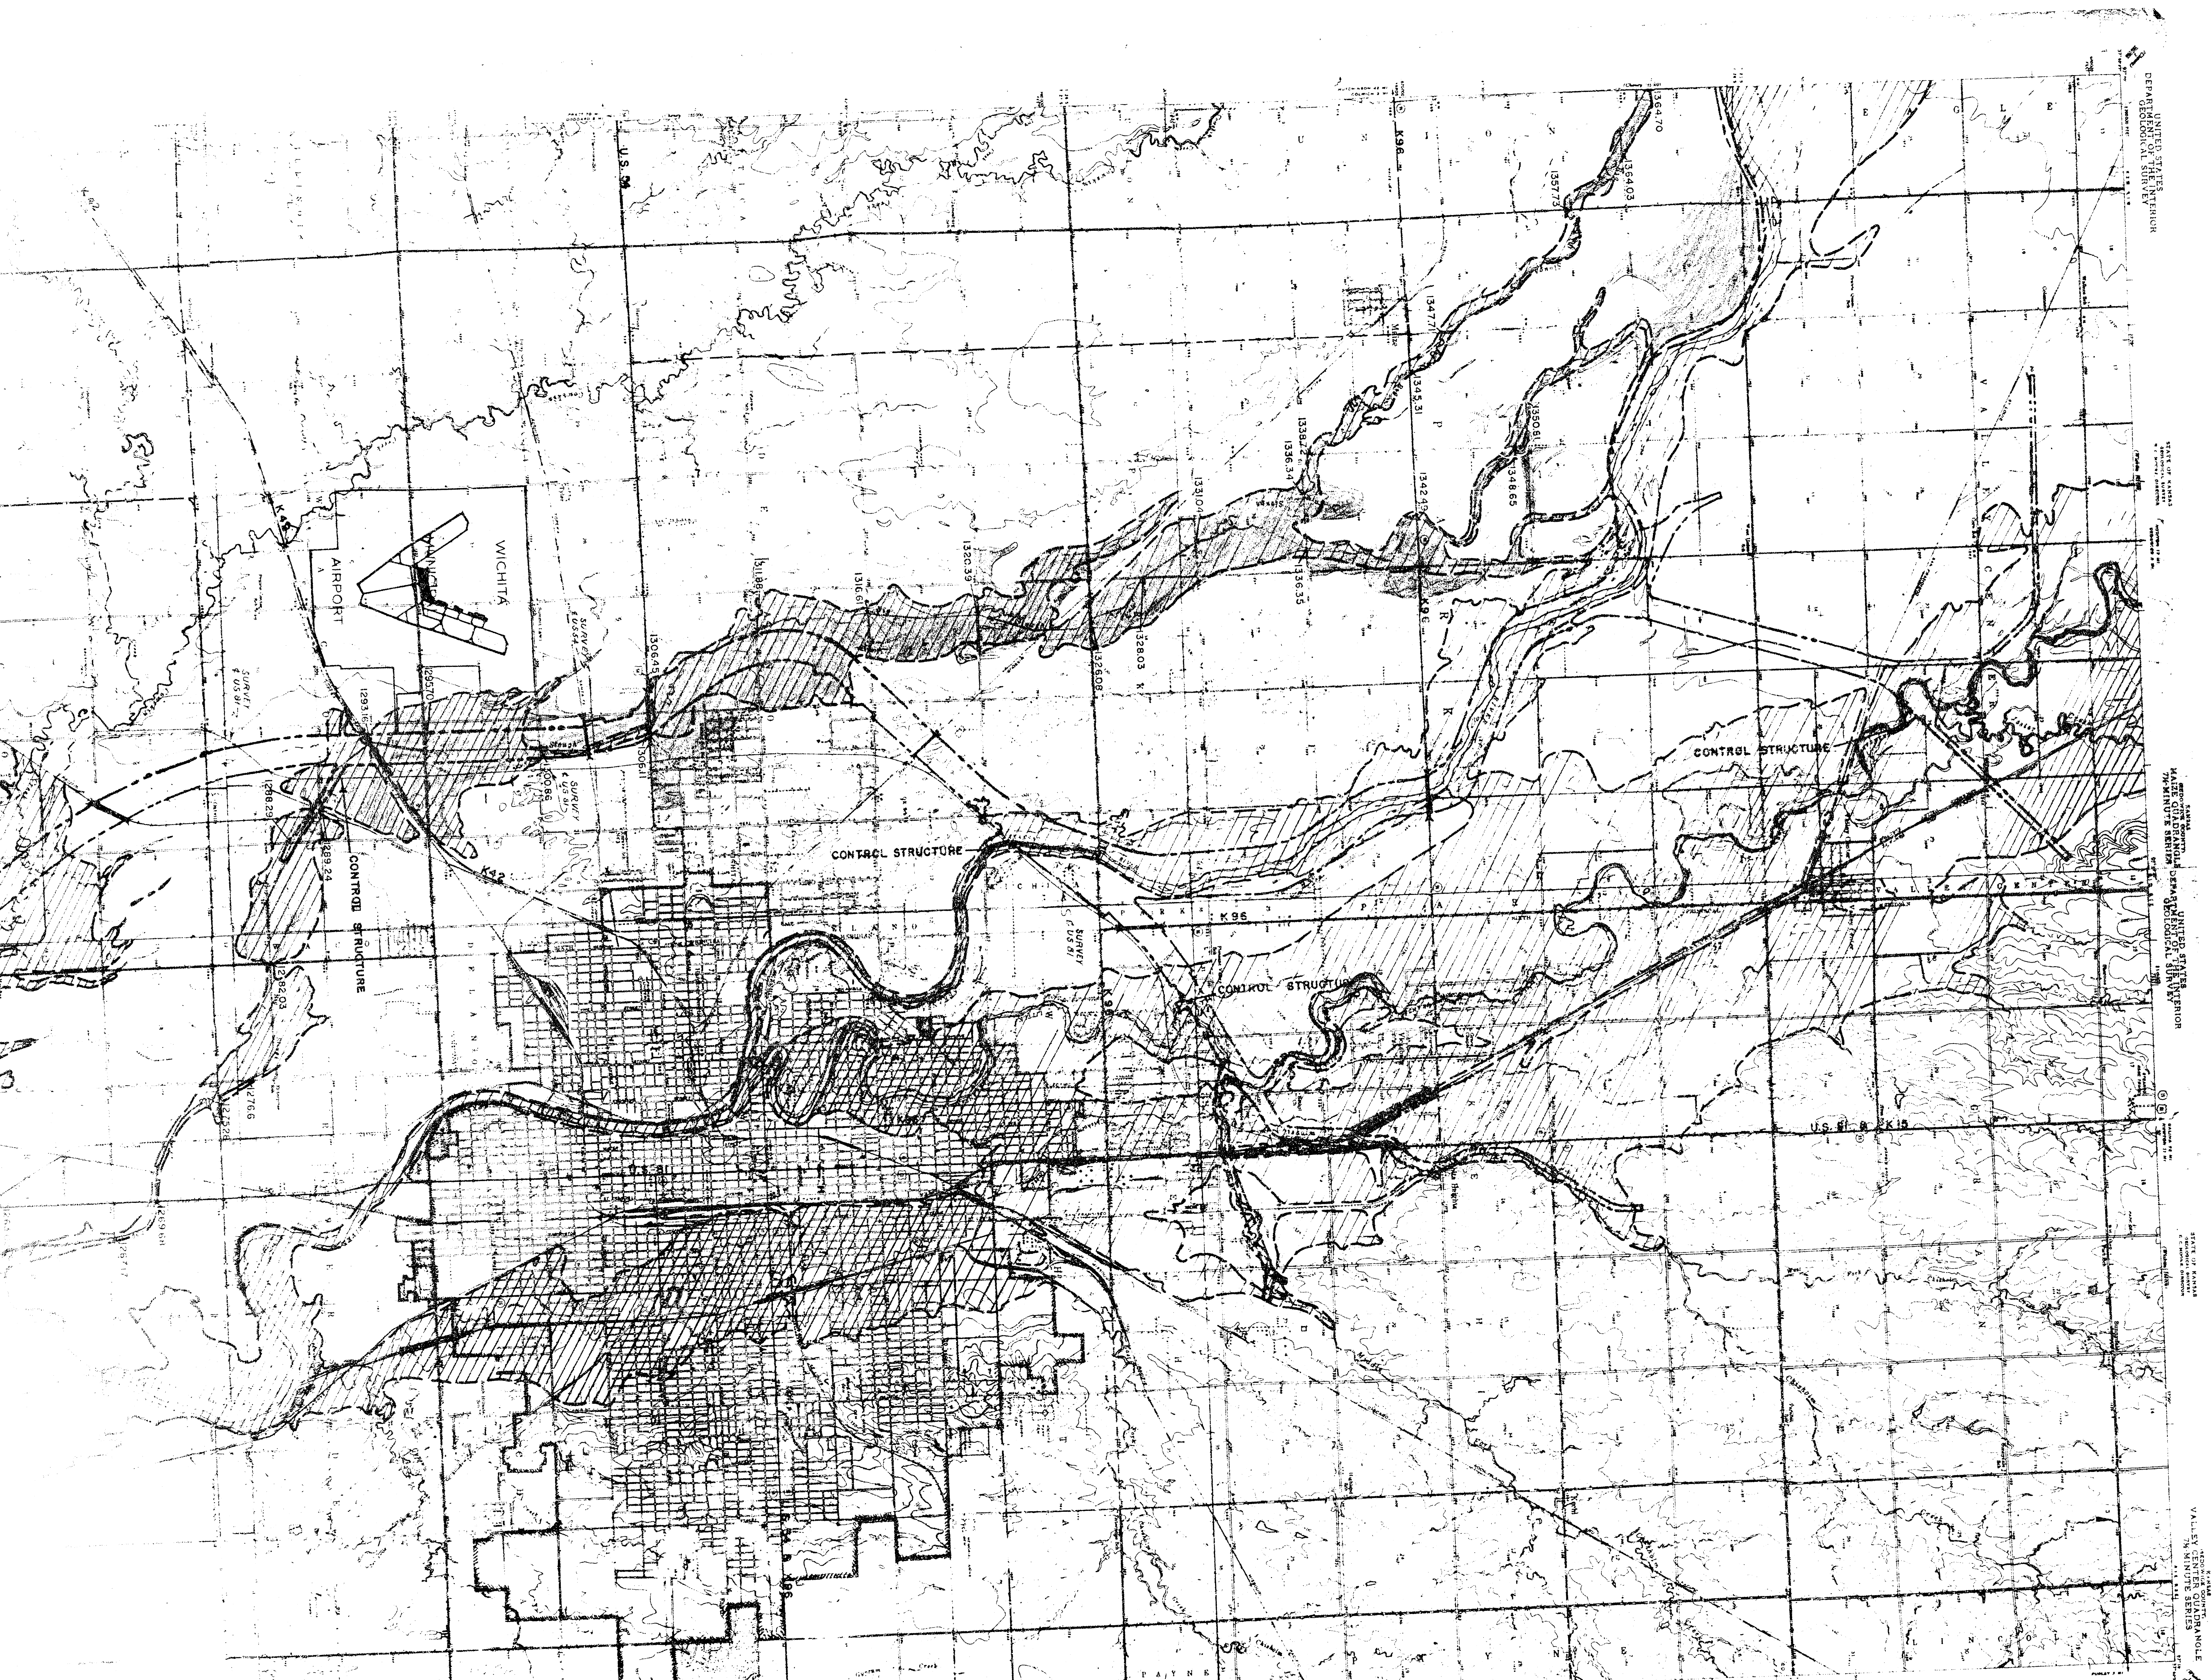



| REVISED AS TO           | SOURCE               | DATE          | THAT ISMAN  |
|-------------------------|----------------------|---------------|-------------|
| Br No 256 Filled        | 22505 1537-B Report  | 1122 6-24-24  | H. H. H. H. |
| Fe Converged road       | 26457 1537-B         | 9-26-19-27-24 | W. W. W. W. |
| Br No 253 Reconst. str. | 37047 1537-B         | 131 2-4-31    | W. W. W. W. |
| Br No 255 Reconst. str. | 47444 26457-19-20-21 | 235 4-21-32   | A. A. A. A. |
| Br No 254 Reconst. str. | 38184 1537-B         | 6-30 7-22-33  | A. A. A. A. |
| Trk No 1000 Wood Beams  | 41310 1537-B         | 1-41 3-14-31  | A. A. A. A. |
| Trk No 1001 Wood Beams  | 41310 1537-B         | 1-41 3-14-31  | A. A. A. A. |
