


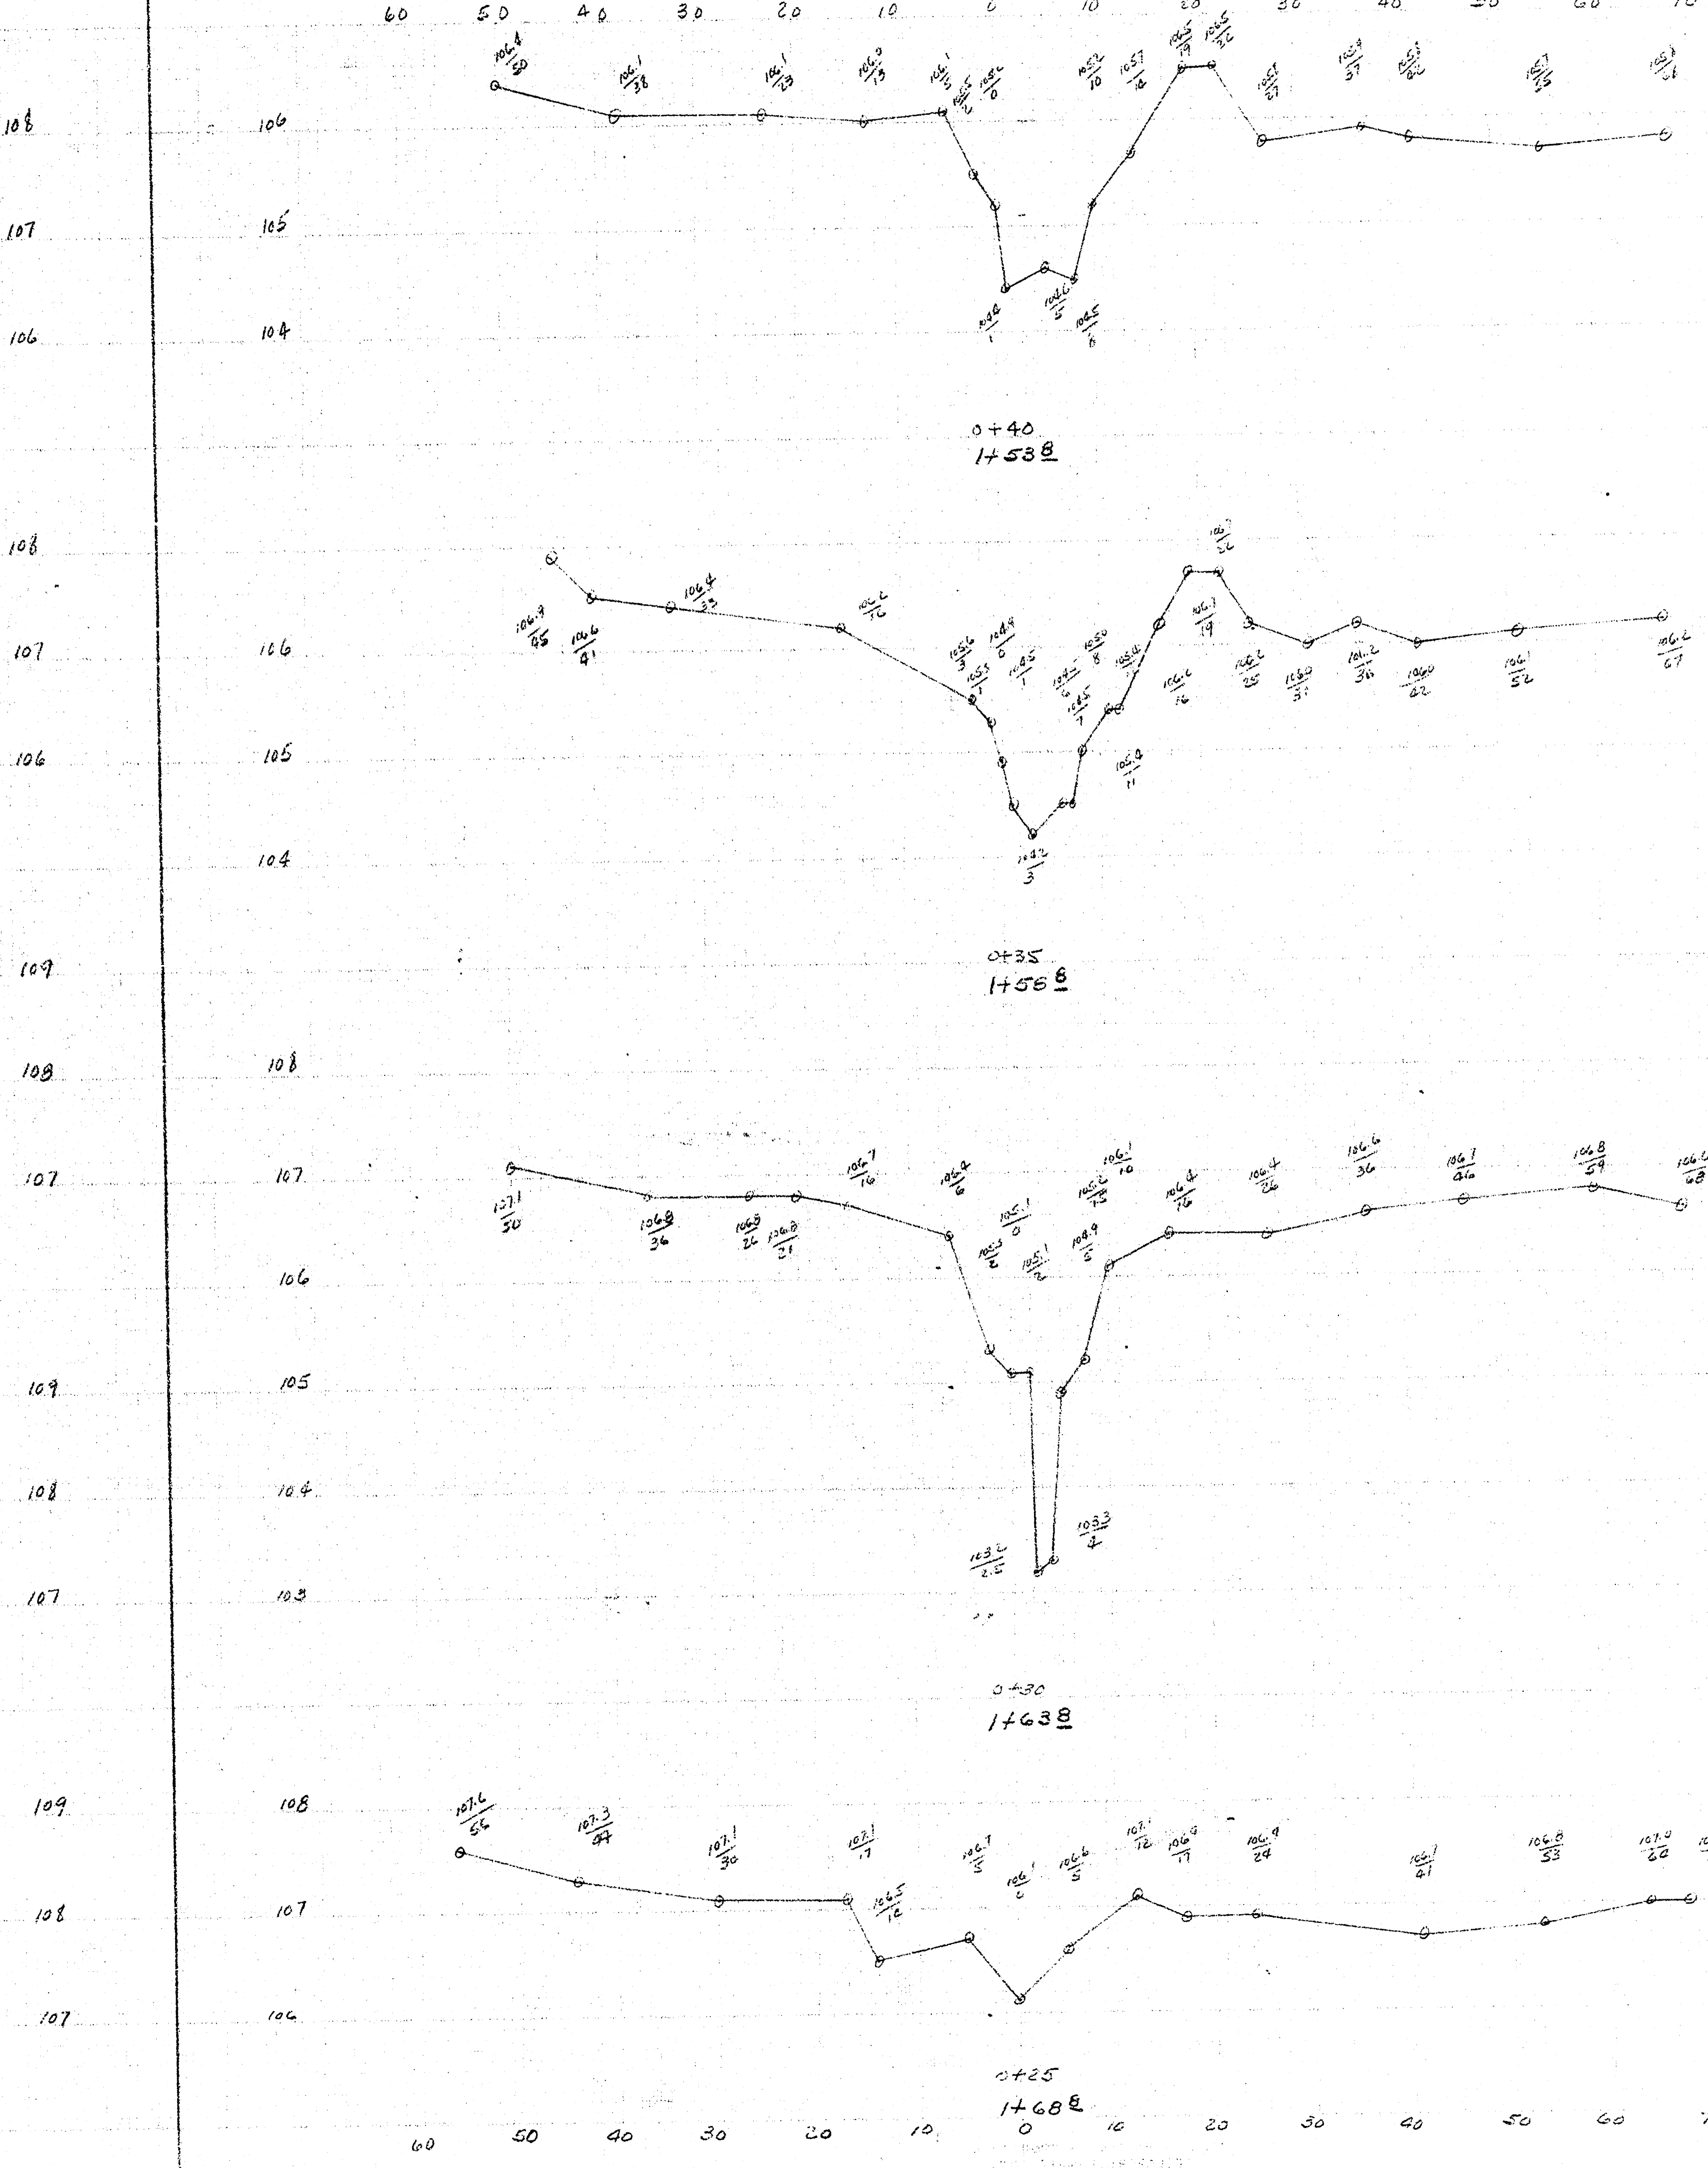
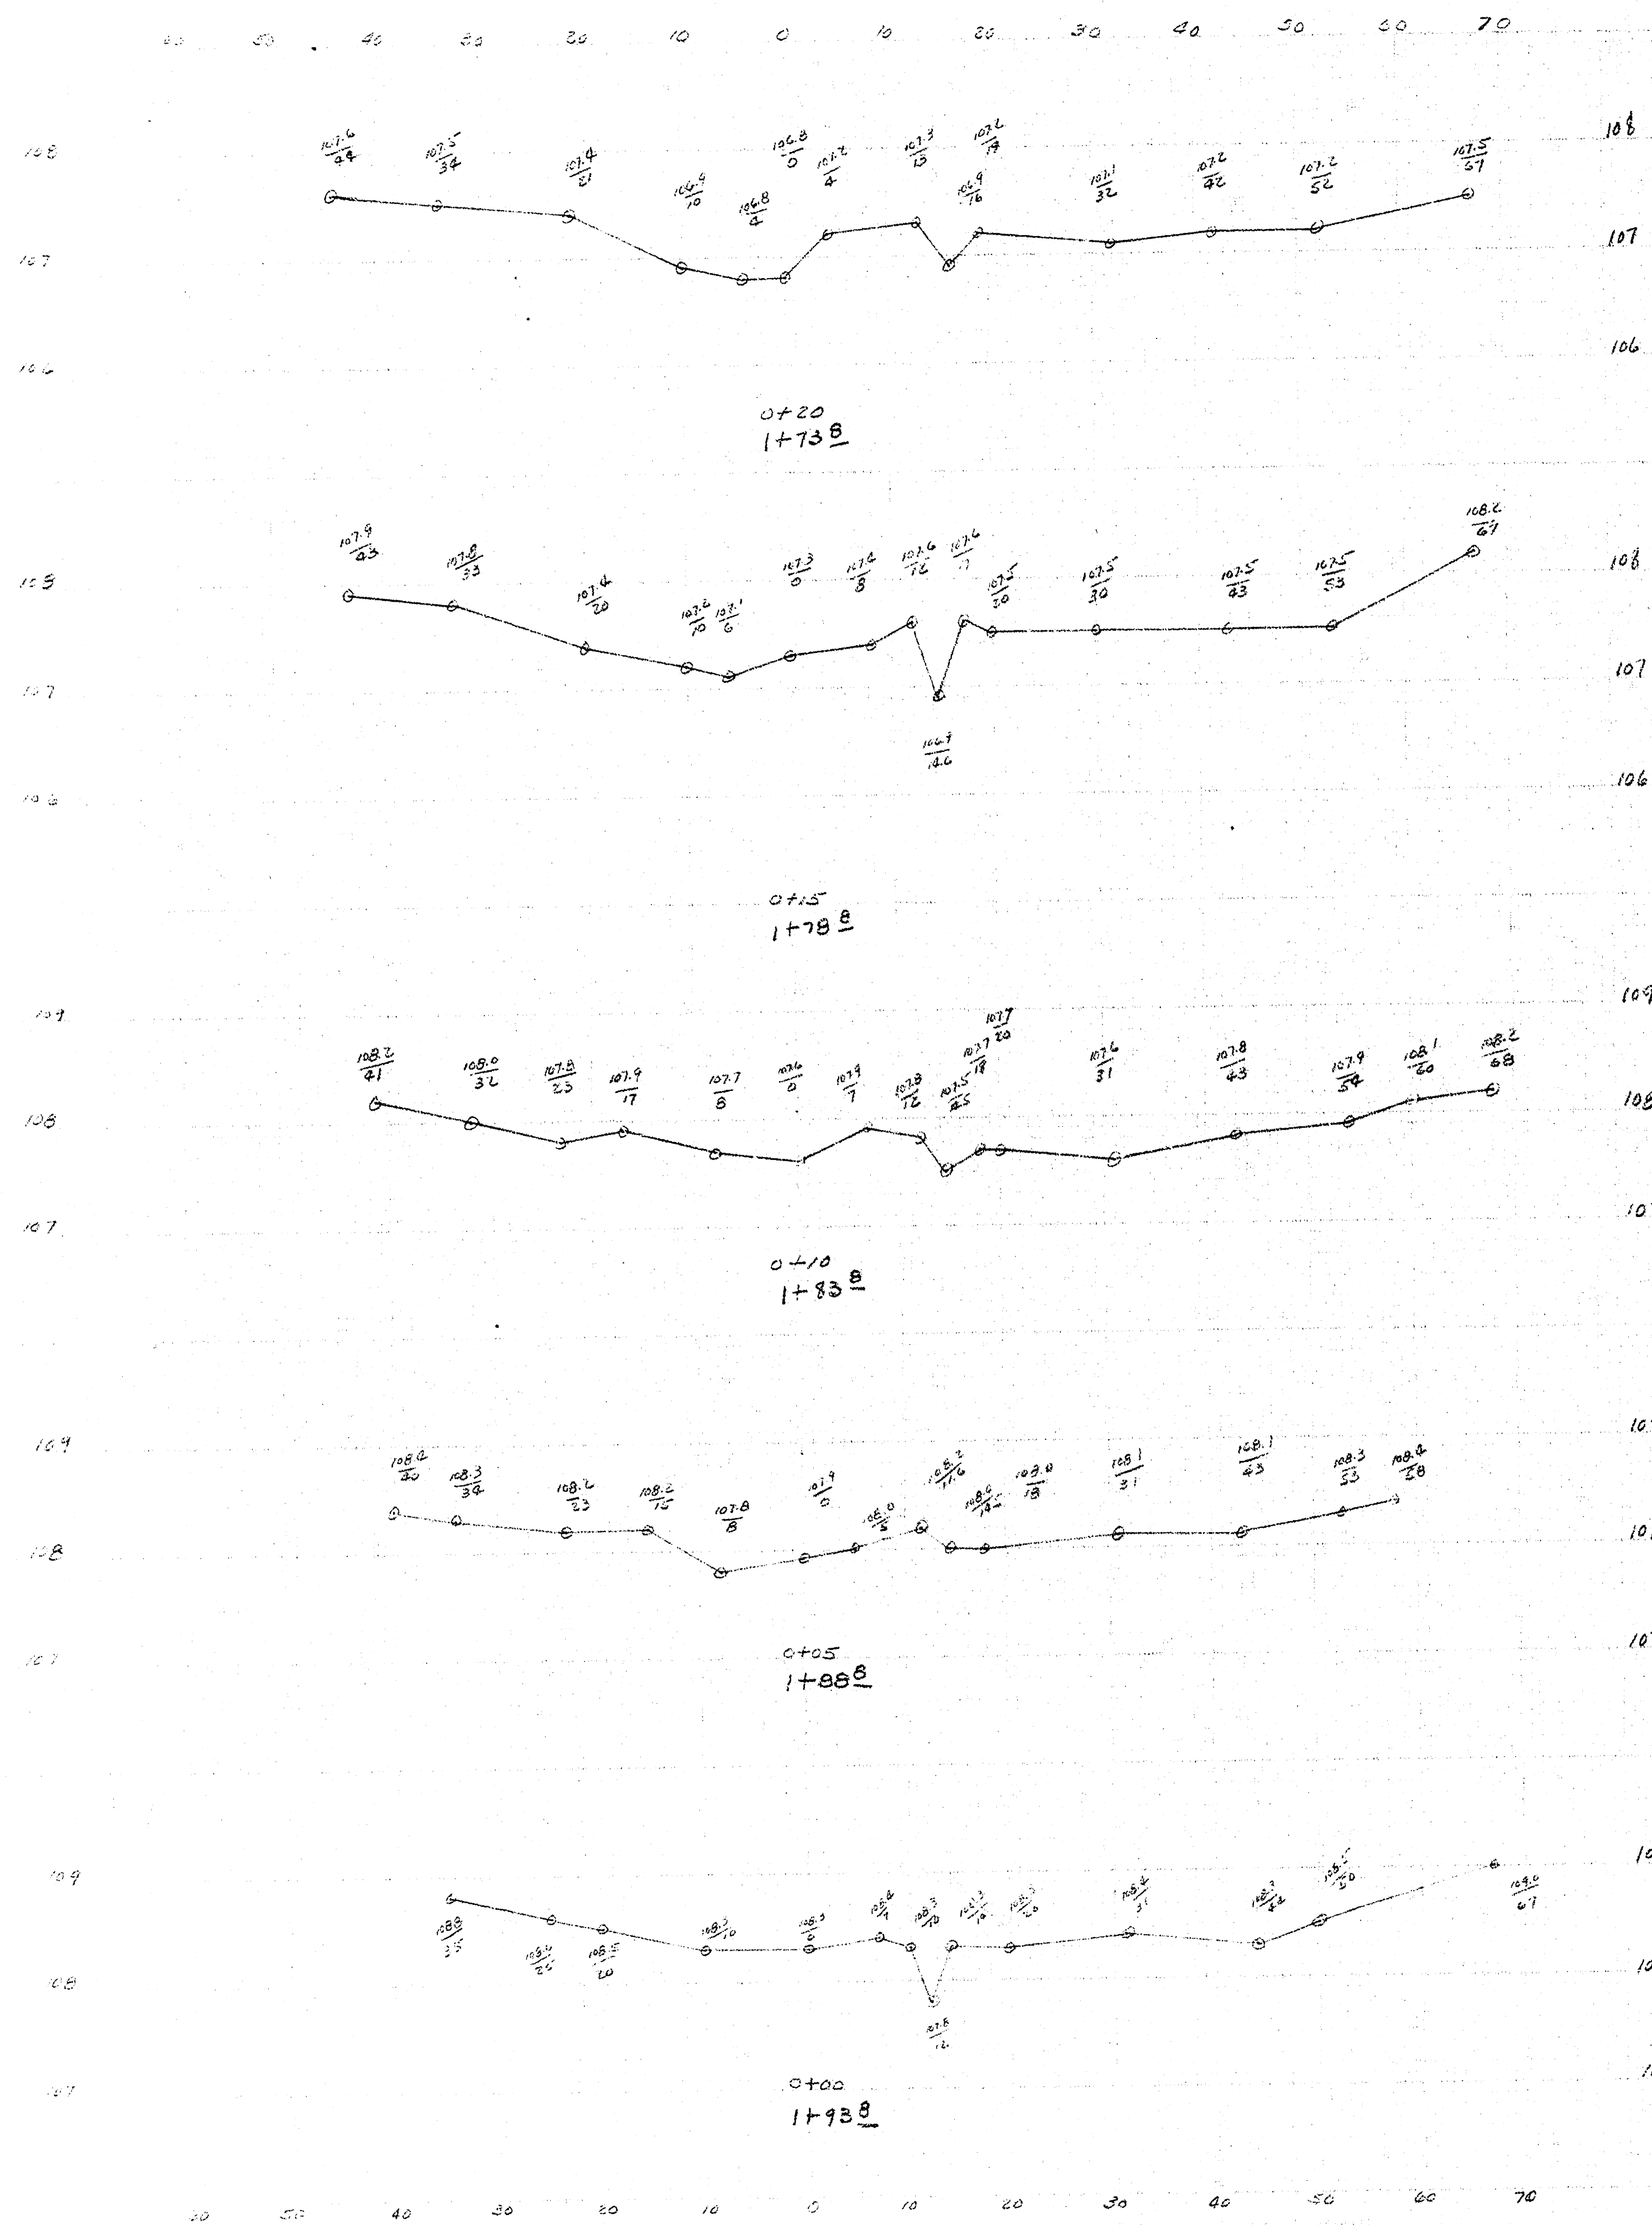
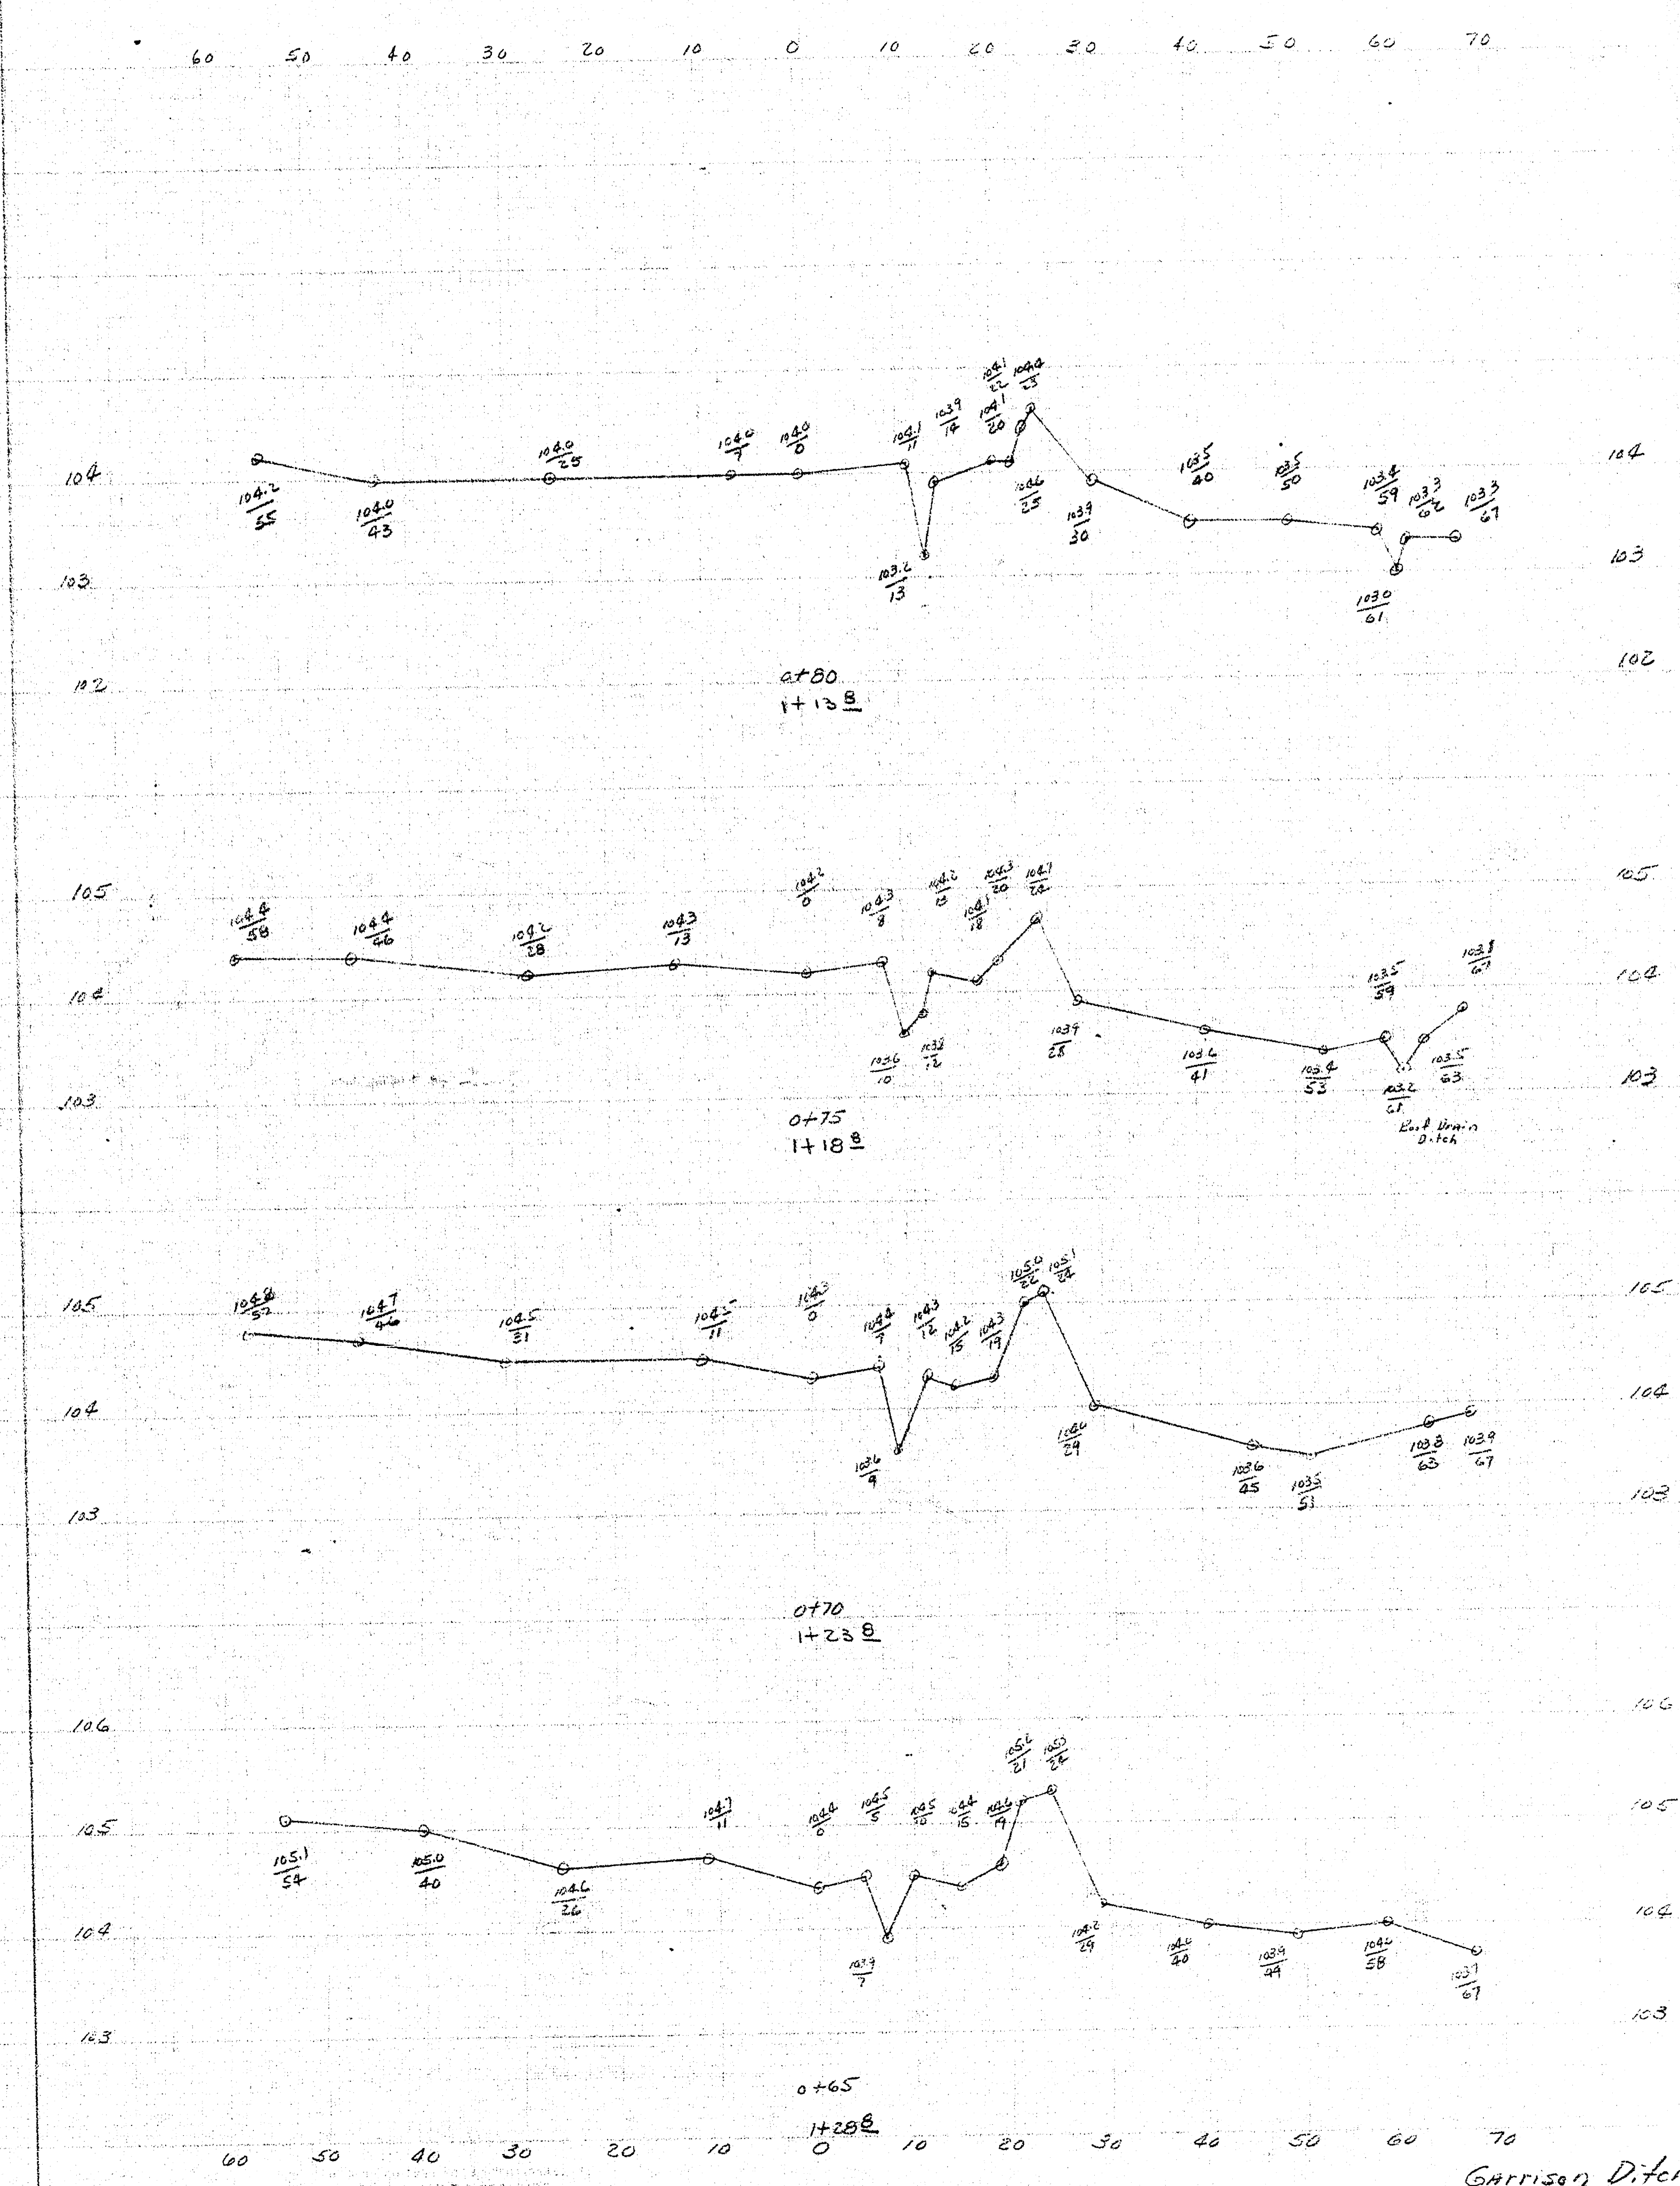


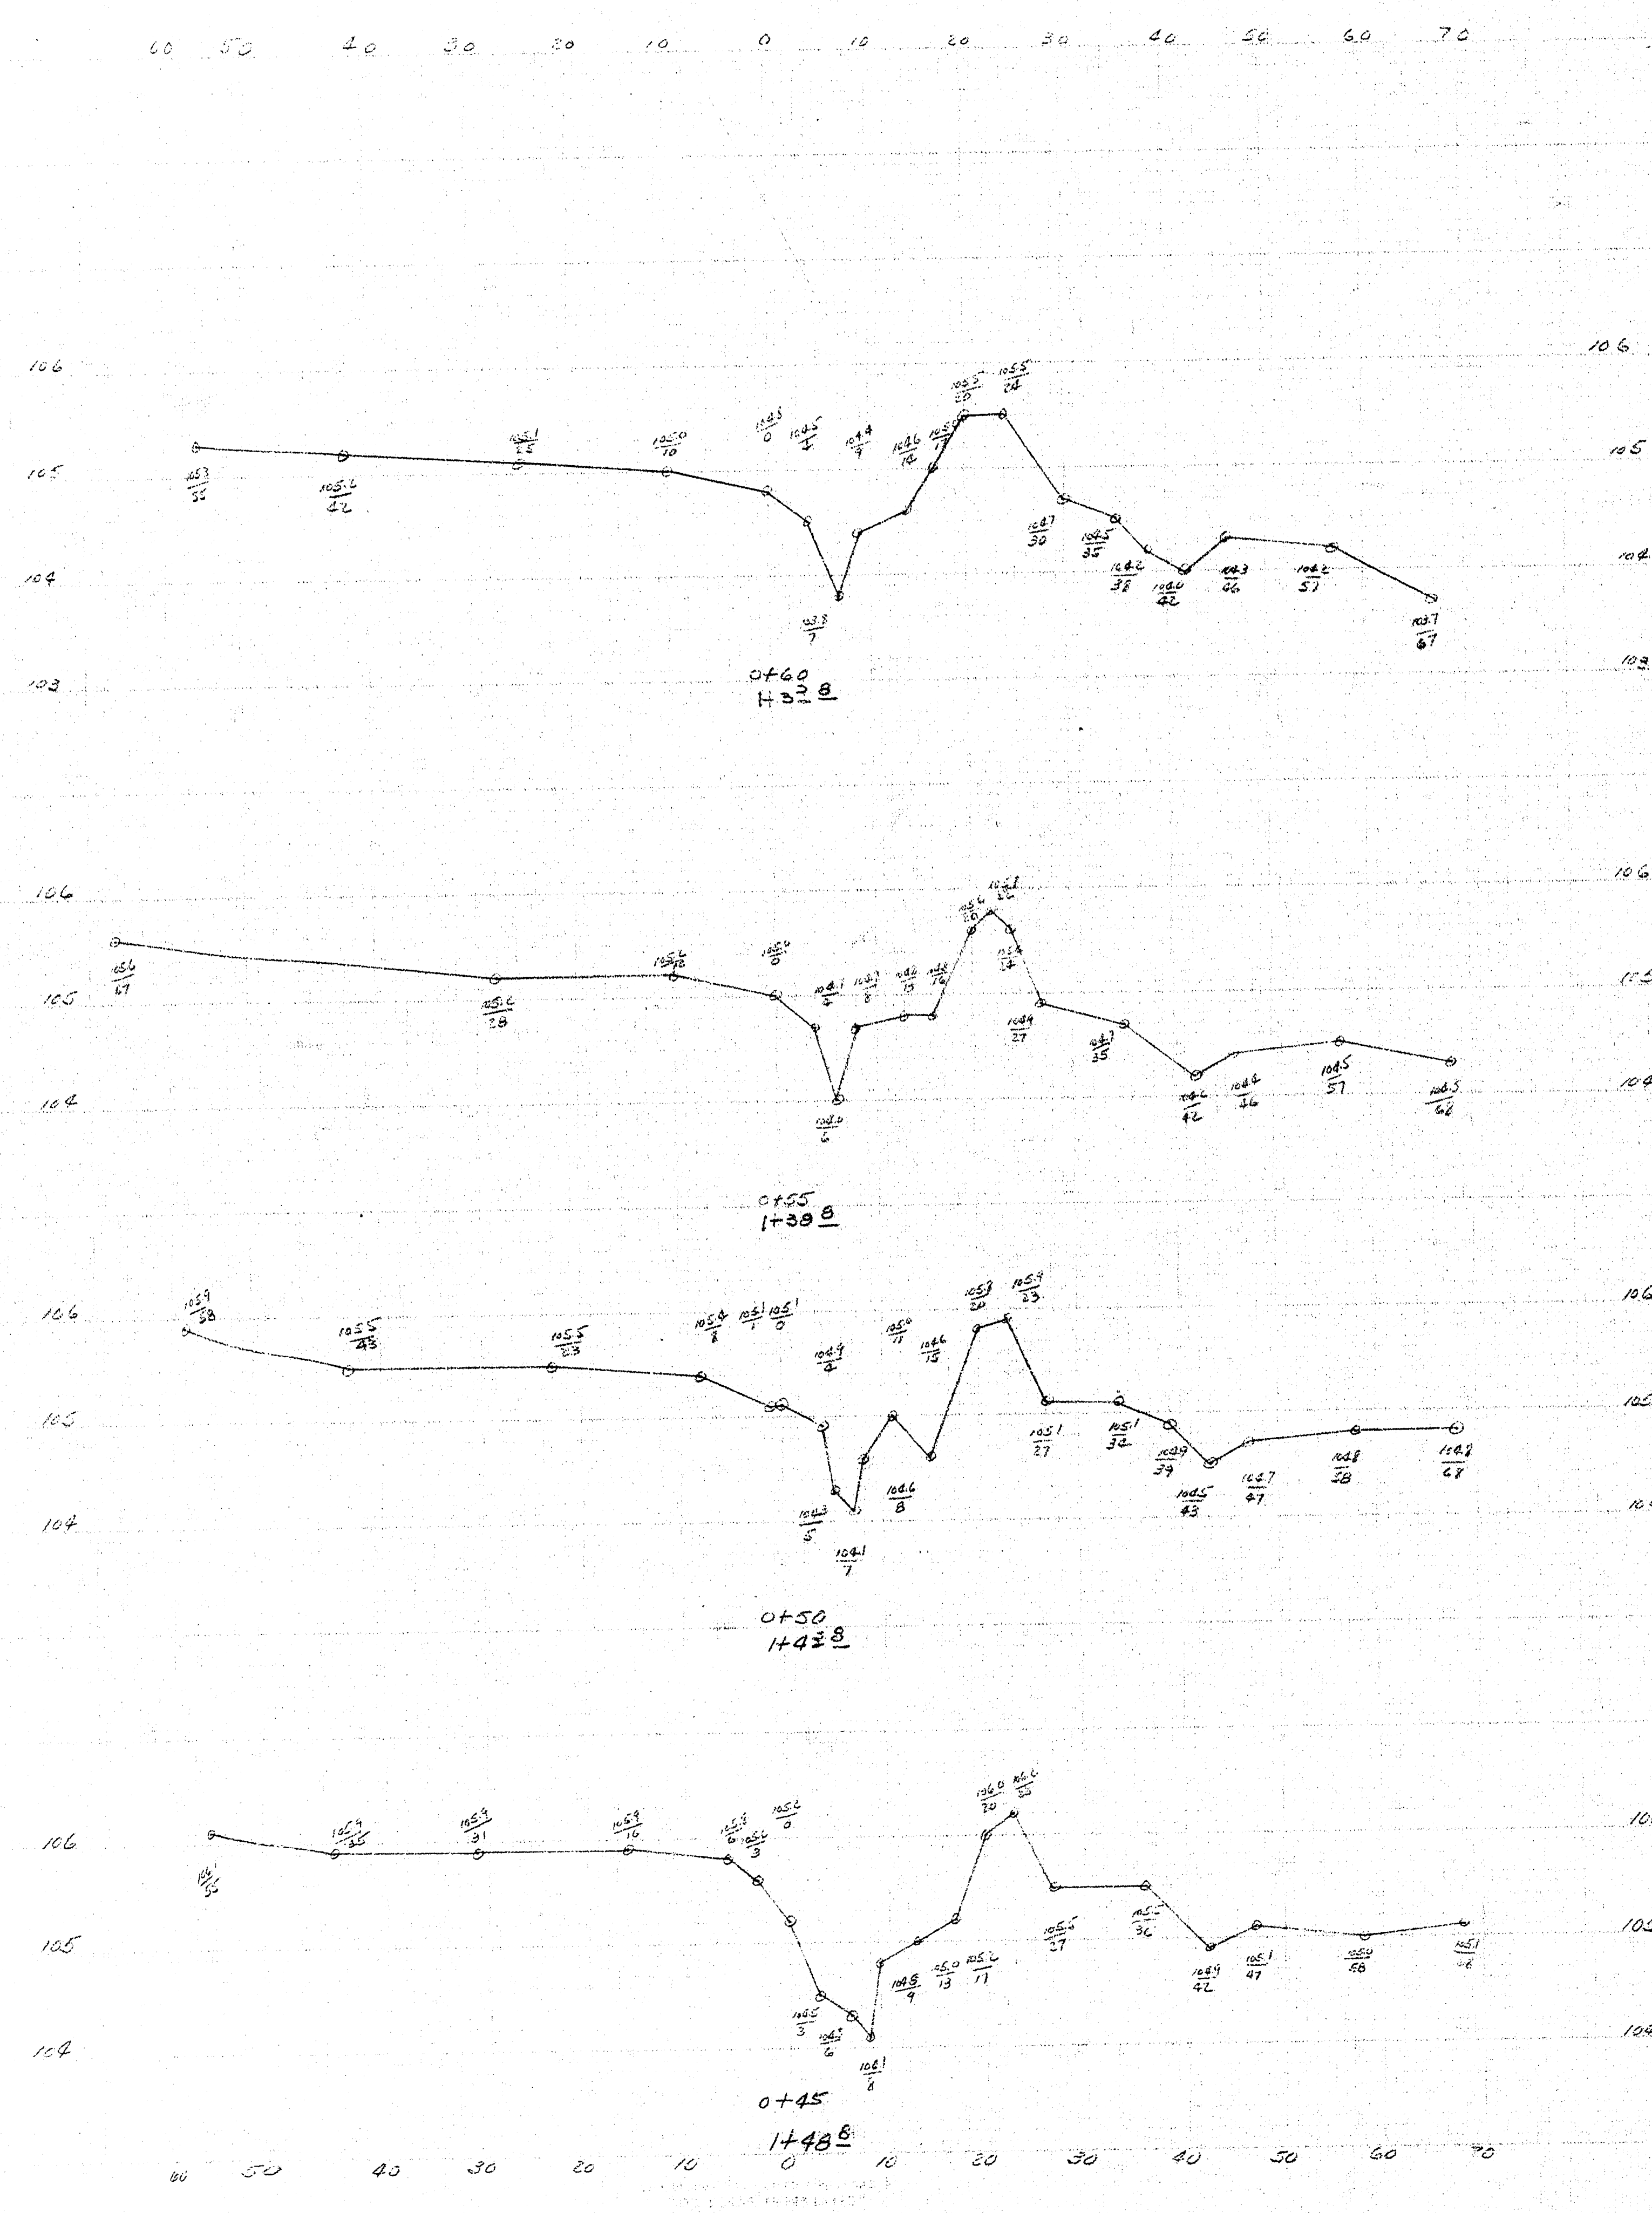

X-500 (GARRISON)
 Ditch
 30th E.S. H. H. H.
 Sheet # 1 of 5
 Sept 29, 1967

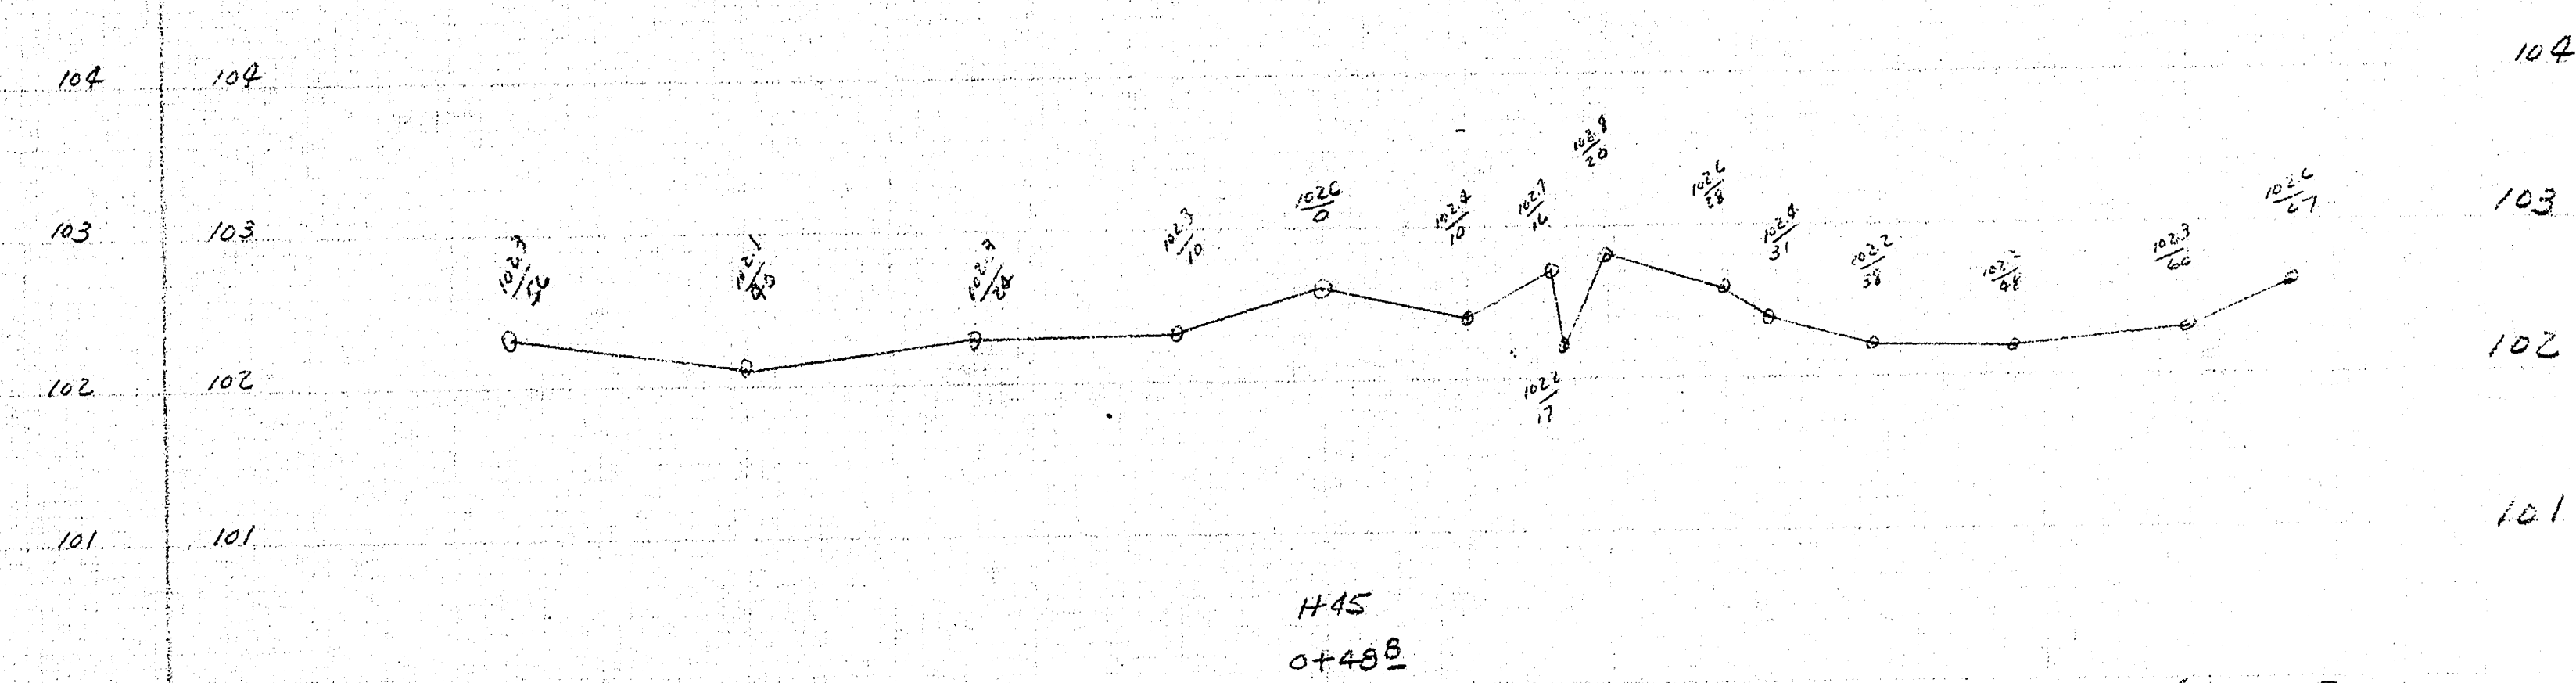

Garrison Ditch
Sheet #2 of 5

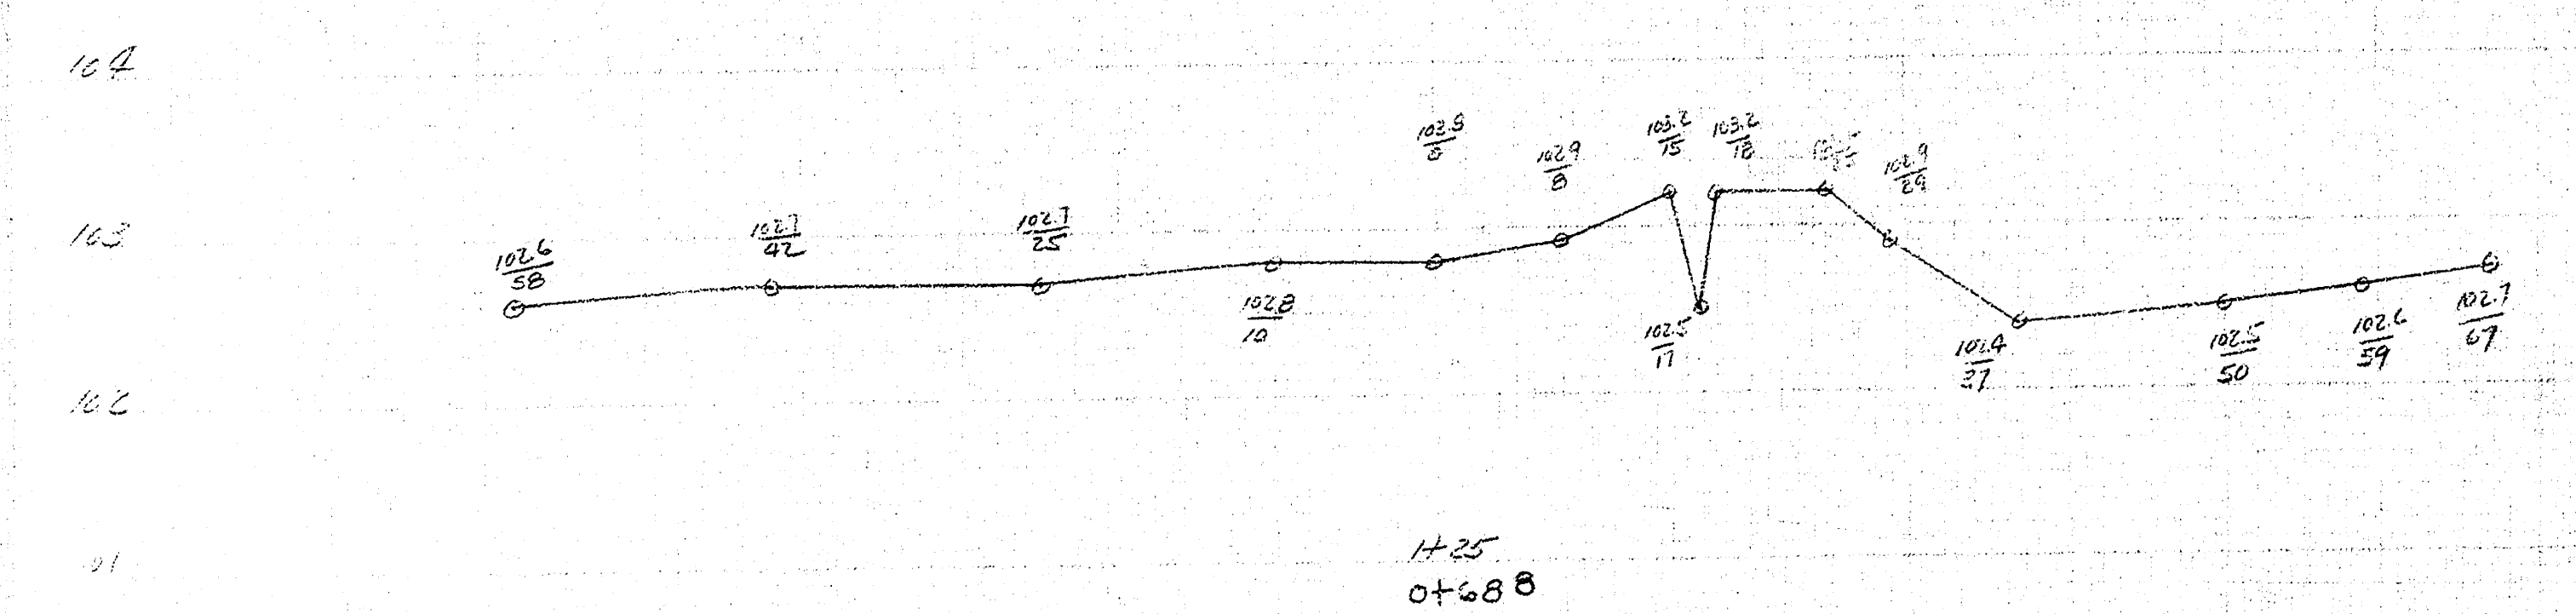

Garrison Ditch
Sheet #4 of 5

