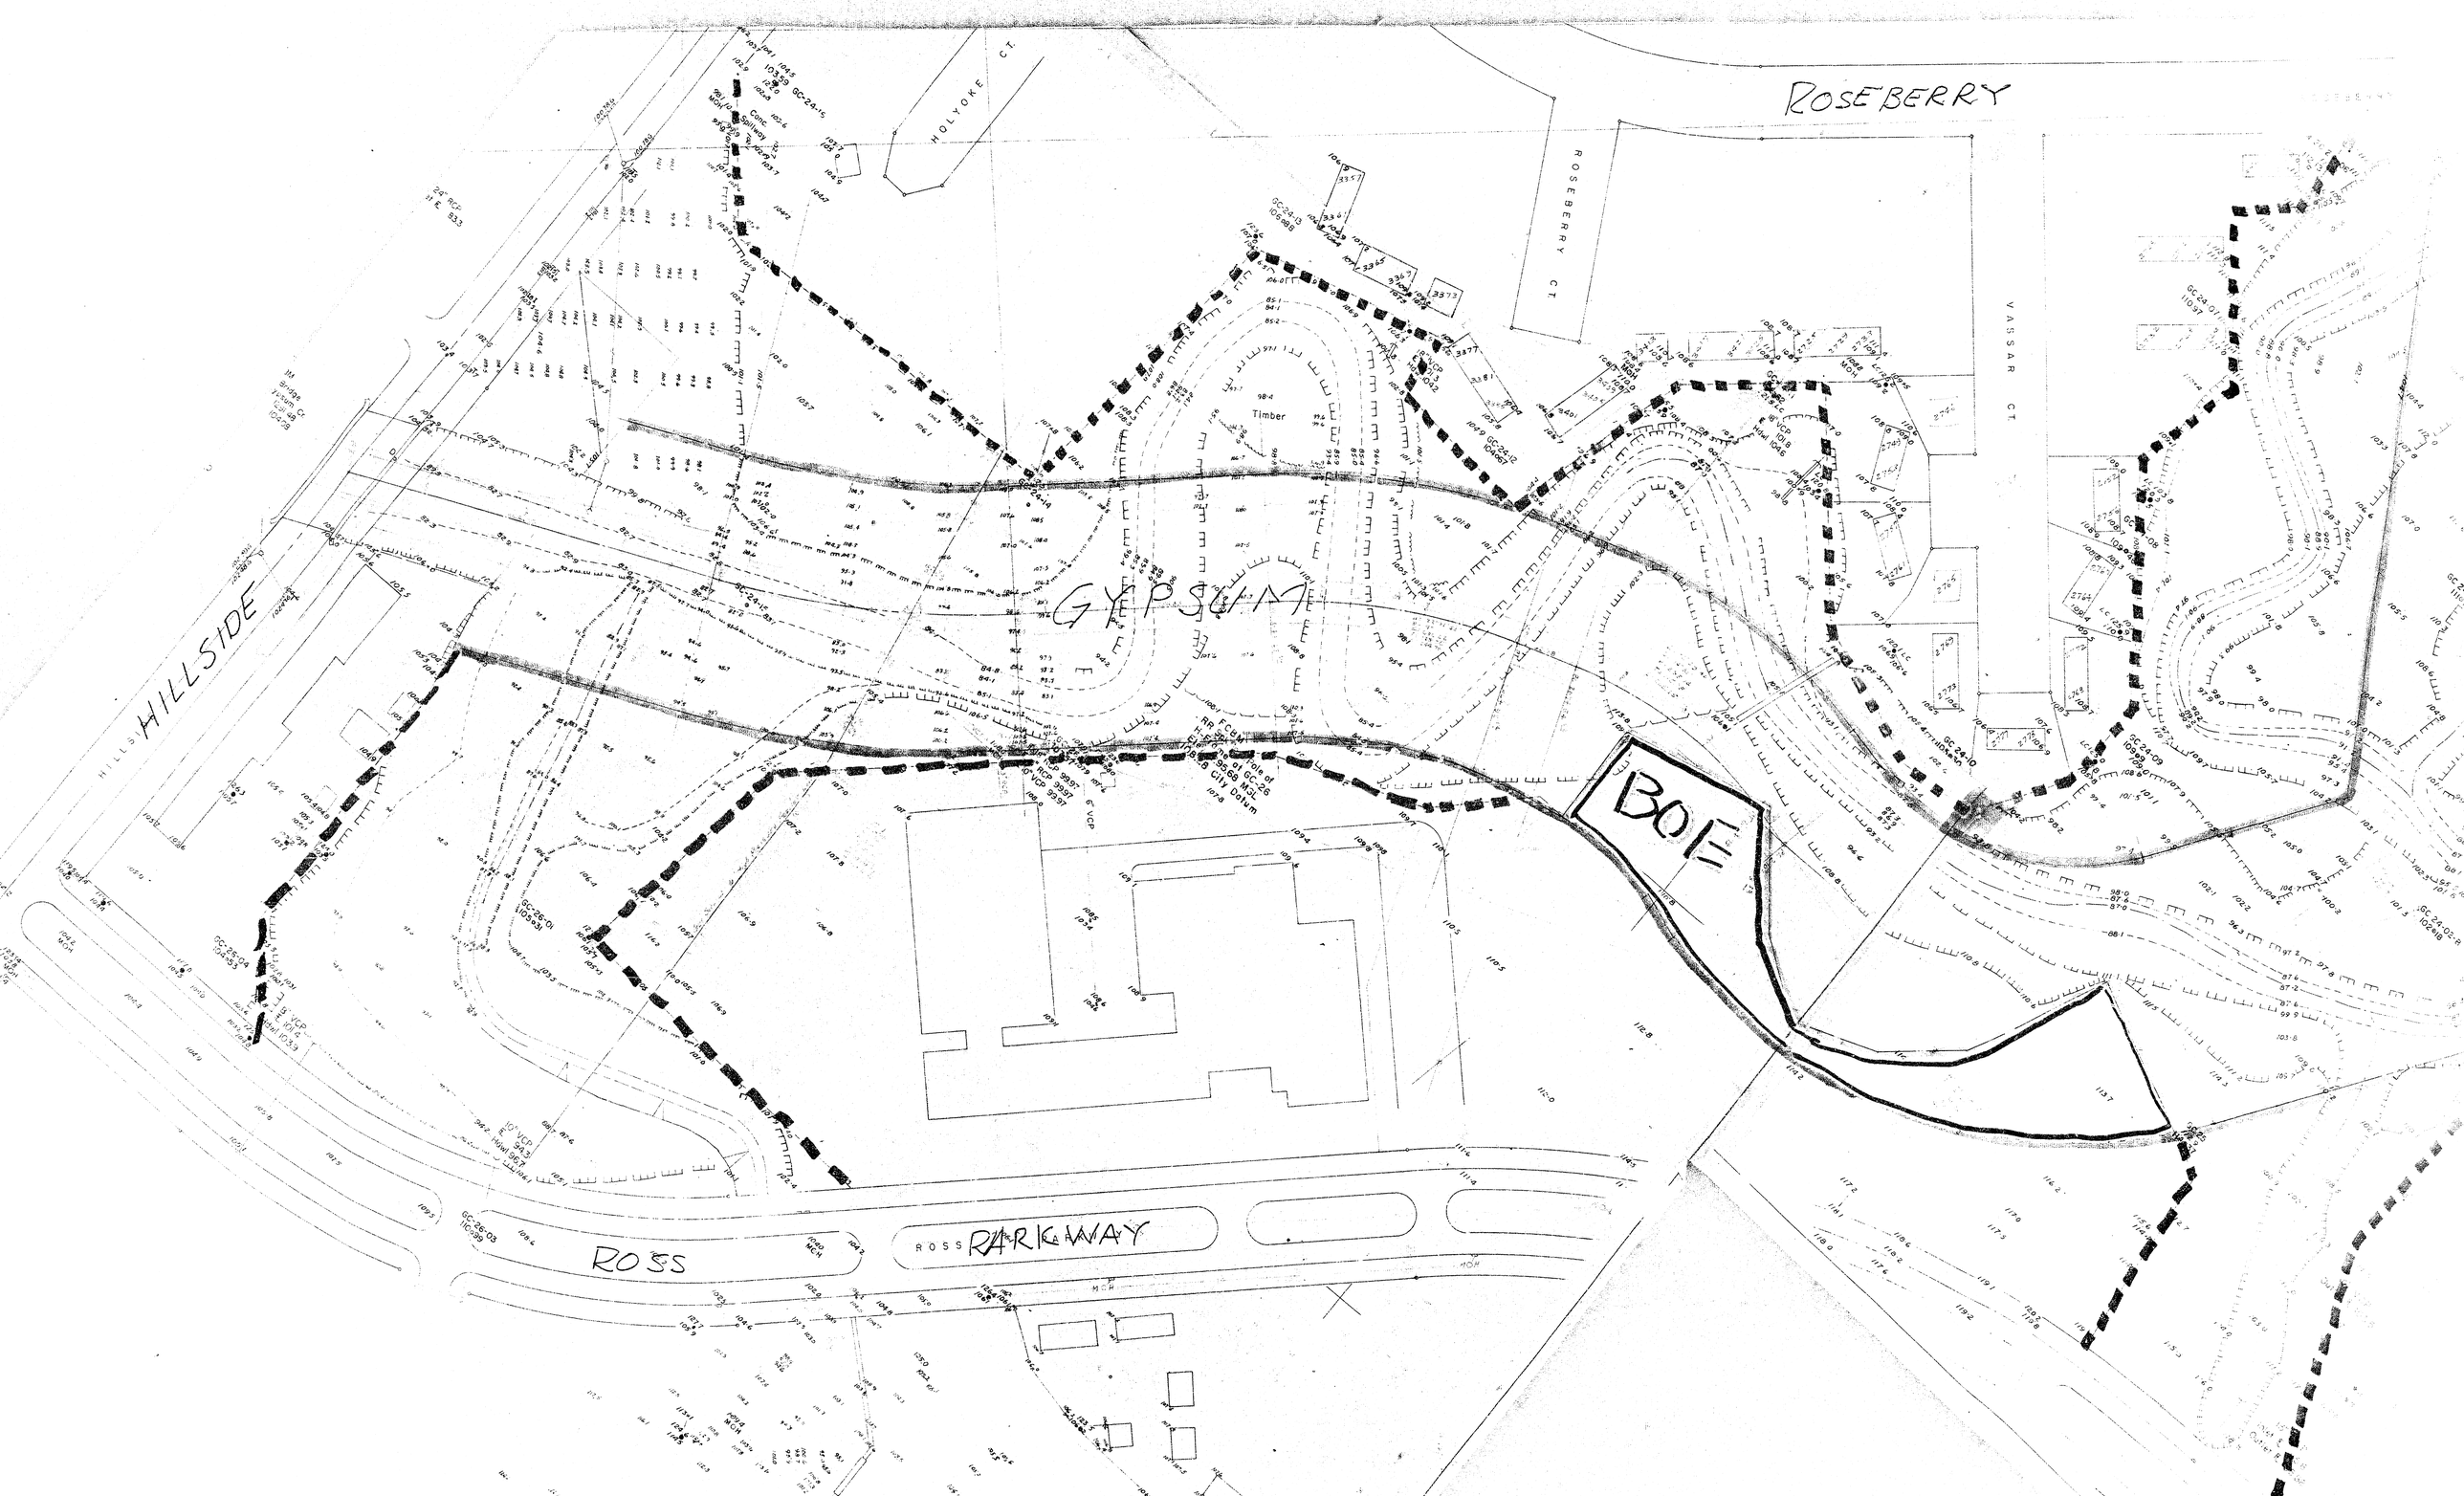
ROSEBERRY
HOLYOKE CT.
ROSEBERRY CT.
VASSAR CT.
HILLSIDE
GYPSUM
BOE
ROSS
ROSS PARKWAY
Timber
Conc. Spillway

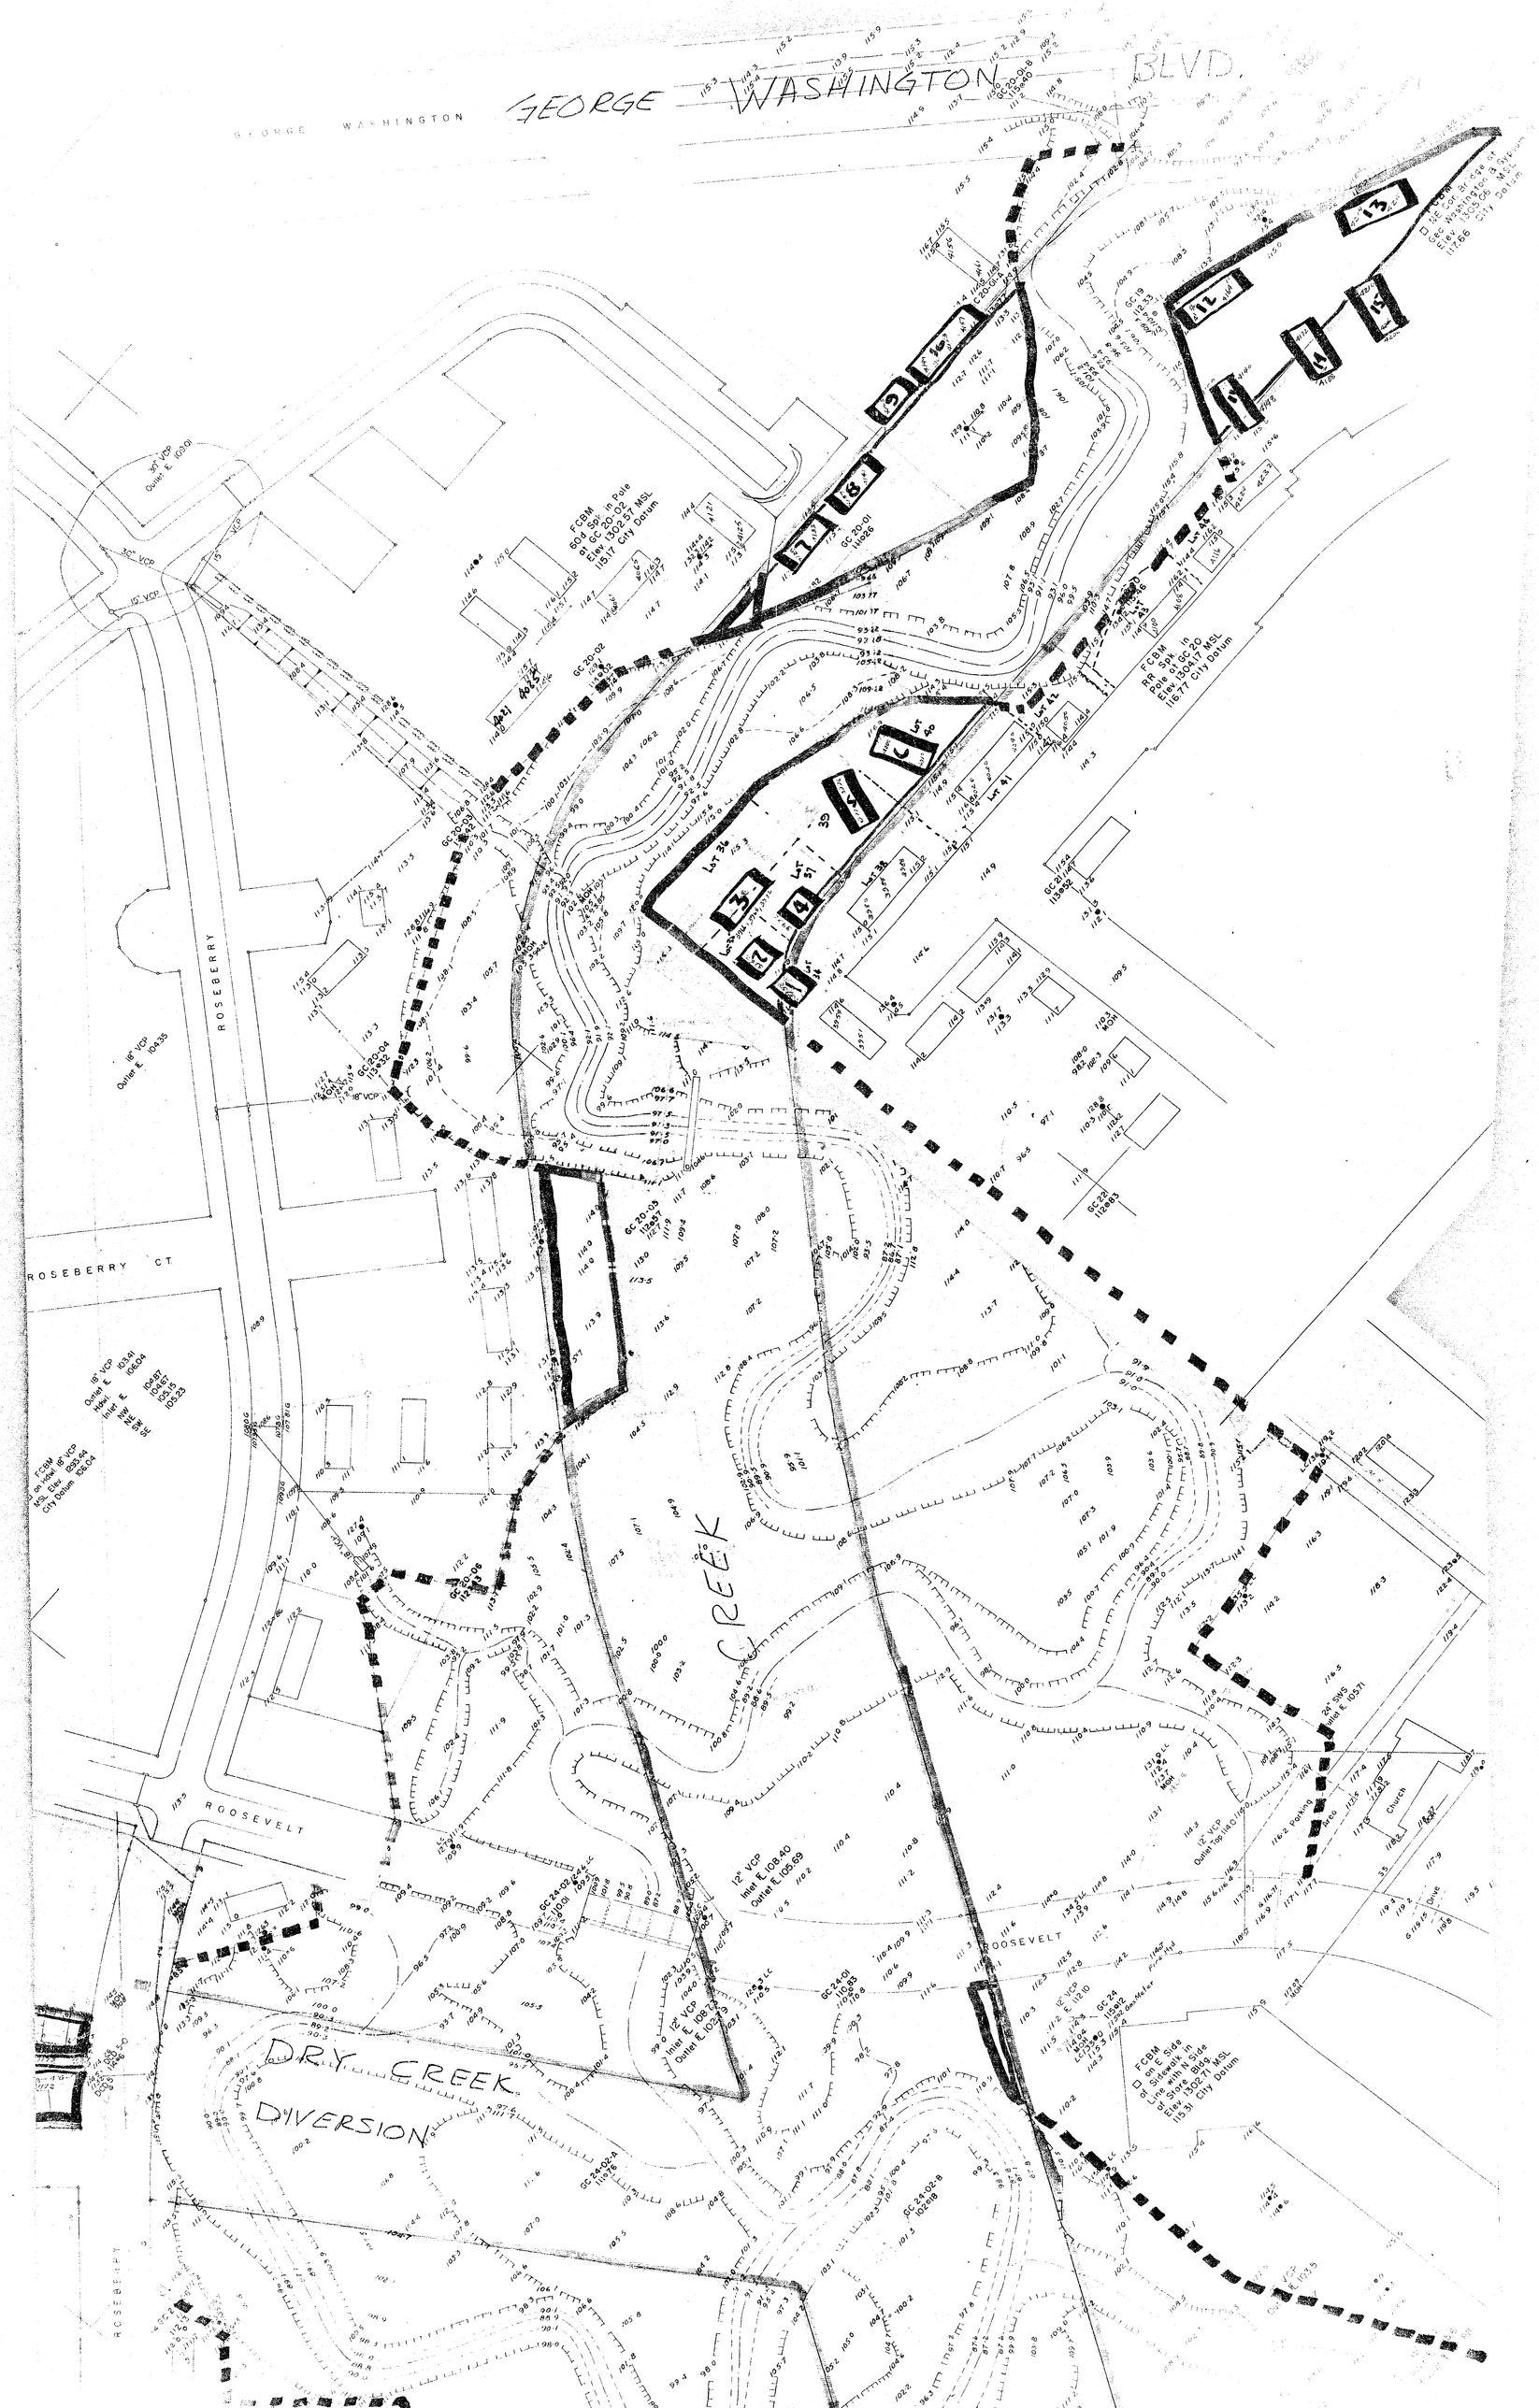
GEORGE WASHINGTON BLVD.
GEORGE WASHINGTON
ROSEBERRY
ROSEBERRY CT
ROOSEVELT
DRY CREEK
DIVERSION
DRY CREEK
FCBM 504 Spk in Pole at GC 20-02 Elev 102.57 MSL 115.17 City Datum
FCBM in RR Spk on Pole at GC 20 Elev 130.47 MSL 116.77 City Datum
FCBM on Sidewalk in Line with N Side of Store Bldg Elev 130.71 MSL 115.31 City Datum
12" VCP Inlet E. 108.40 Outlet E. 105.69
12" VCP Inlet E. 109.72 Outlet E. 105.23
Church
Drive
Parking

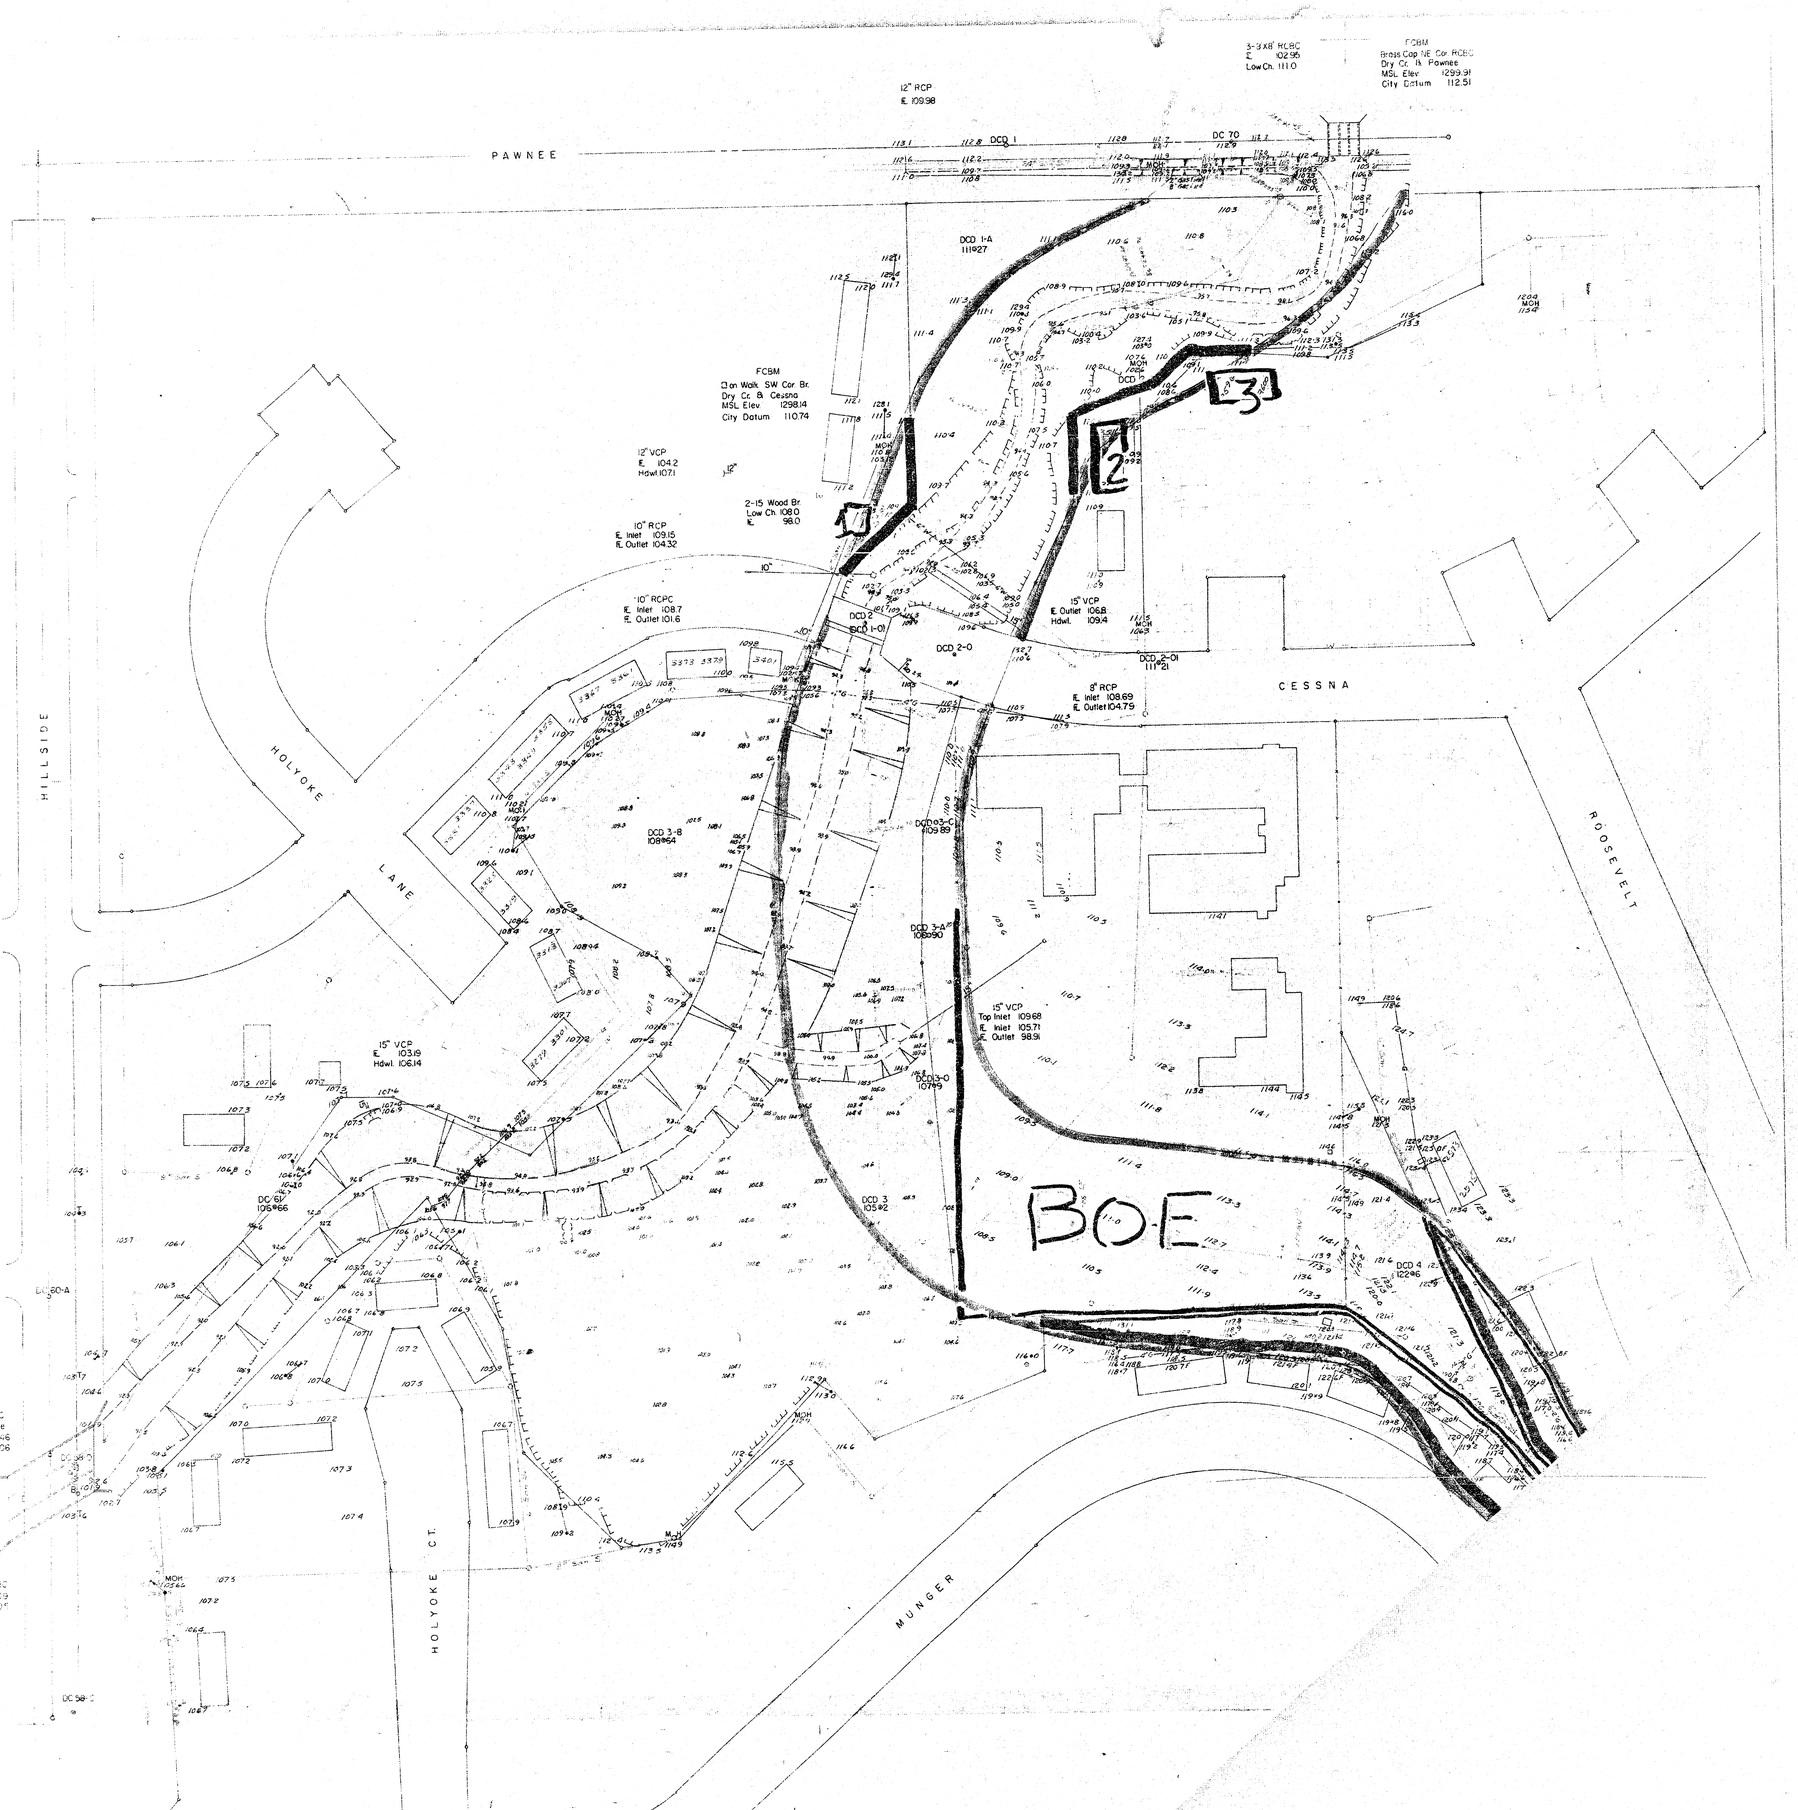
PAWNEE
HILLSIDE
HOLYOKE
LANE
CESSNA
ROOSEVELT
HOLYOKE CT.
MUNGER
BOE
12" RCP
IE 109.98
3-9'X8' RCBC
IE 102.95
Low Ch. 111.0
FCBM
Brass Cap NE Cor RCBC
Dry Cr. B Pawnee
MSL Elev 1299.91
City Datum 112.51
DCD 1
DC 70
DCD 1-A
111.27
FCBM
On Walk SW Cor. Br.
Dry Cr. B Cessna
MSL Elev 1298.14
City Datum 110.74
12" VCP
IE 104.2
Hdwl. 107.1
2-15 Wood Br.
Low Ch. 108.0
IE 98.0
10" RCP
IE Inlet 109.15
IE Outlet 104.32
10" RCPC
IE Inlet 108.7
IE Outlet 101.6
DCD 2
DCD 1-01
DCD 2-0
15" VCP
IE Outlet 106.8
Hdwl. 109.4
DCD 2-01
111.21
8" RCP
IE Inlet 108.69
IE Outlet 104.79
DCD 3-B
108.62
DCD 3-C
109.89
DCD 3-A
108.90
15" VCP
Top Inlet 109.68
IE Inlet 105.71
IE Outlet 98.91
DCD 3-0
107.49
15" VCP
IE 103.19
Hdwl. 106.19
DC 61
106.66
DCD 3
105.42
DCD 4
122.46
1
2
3

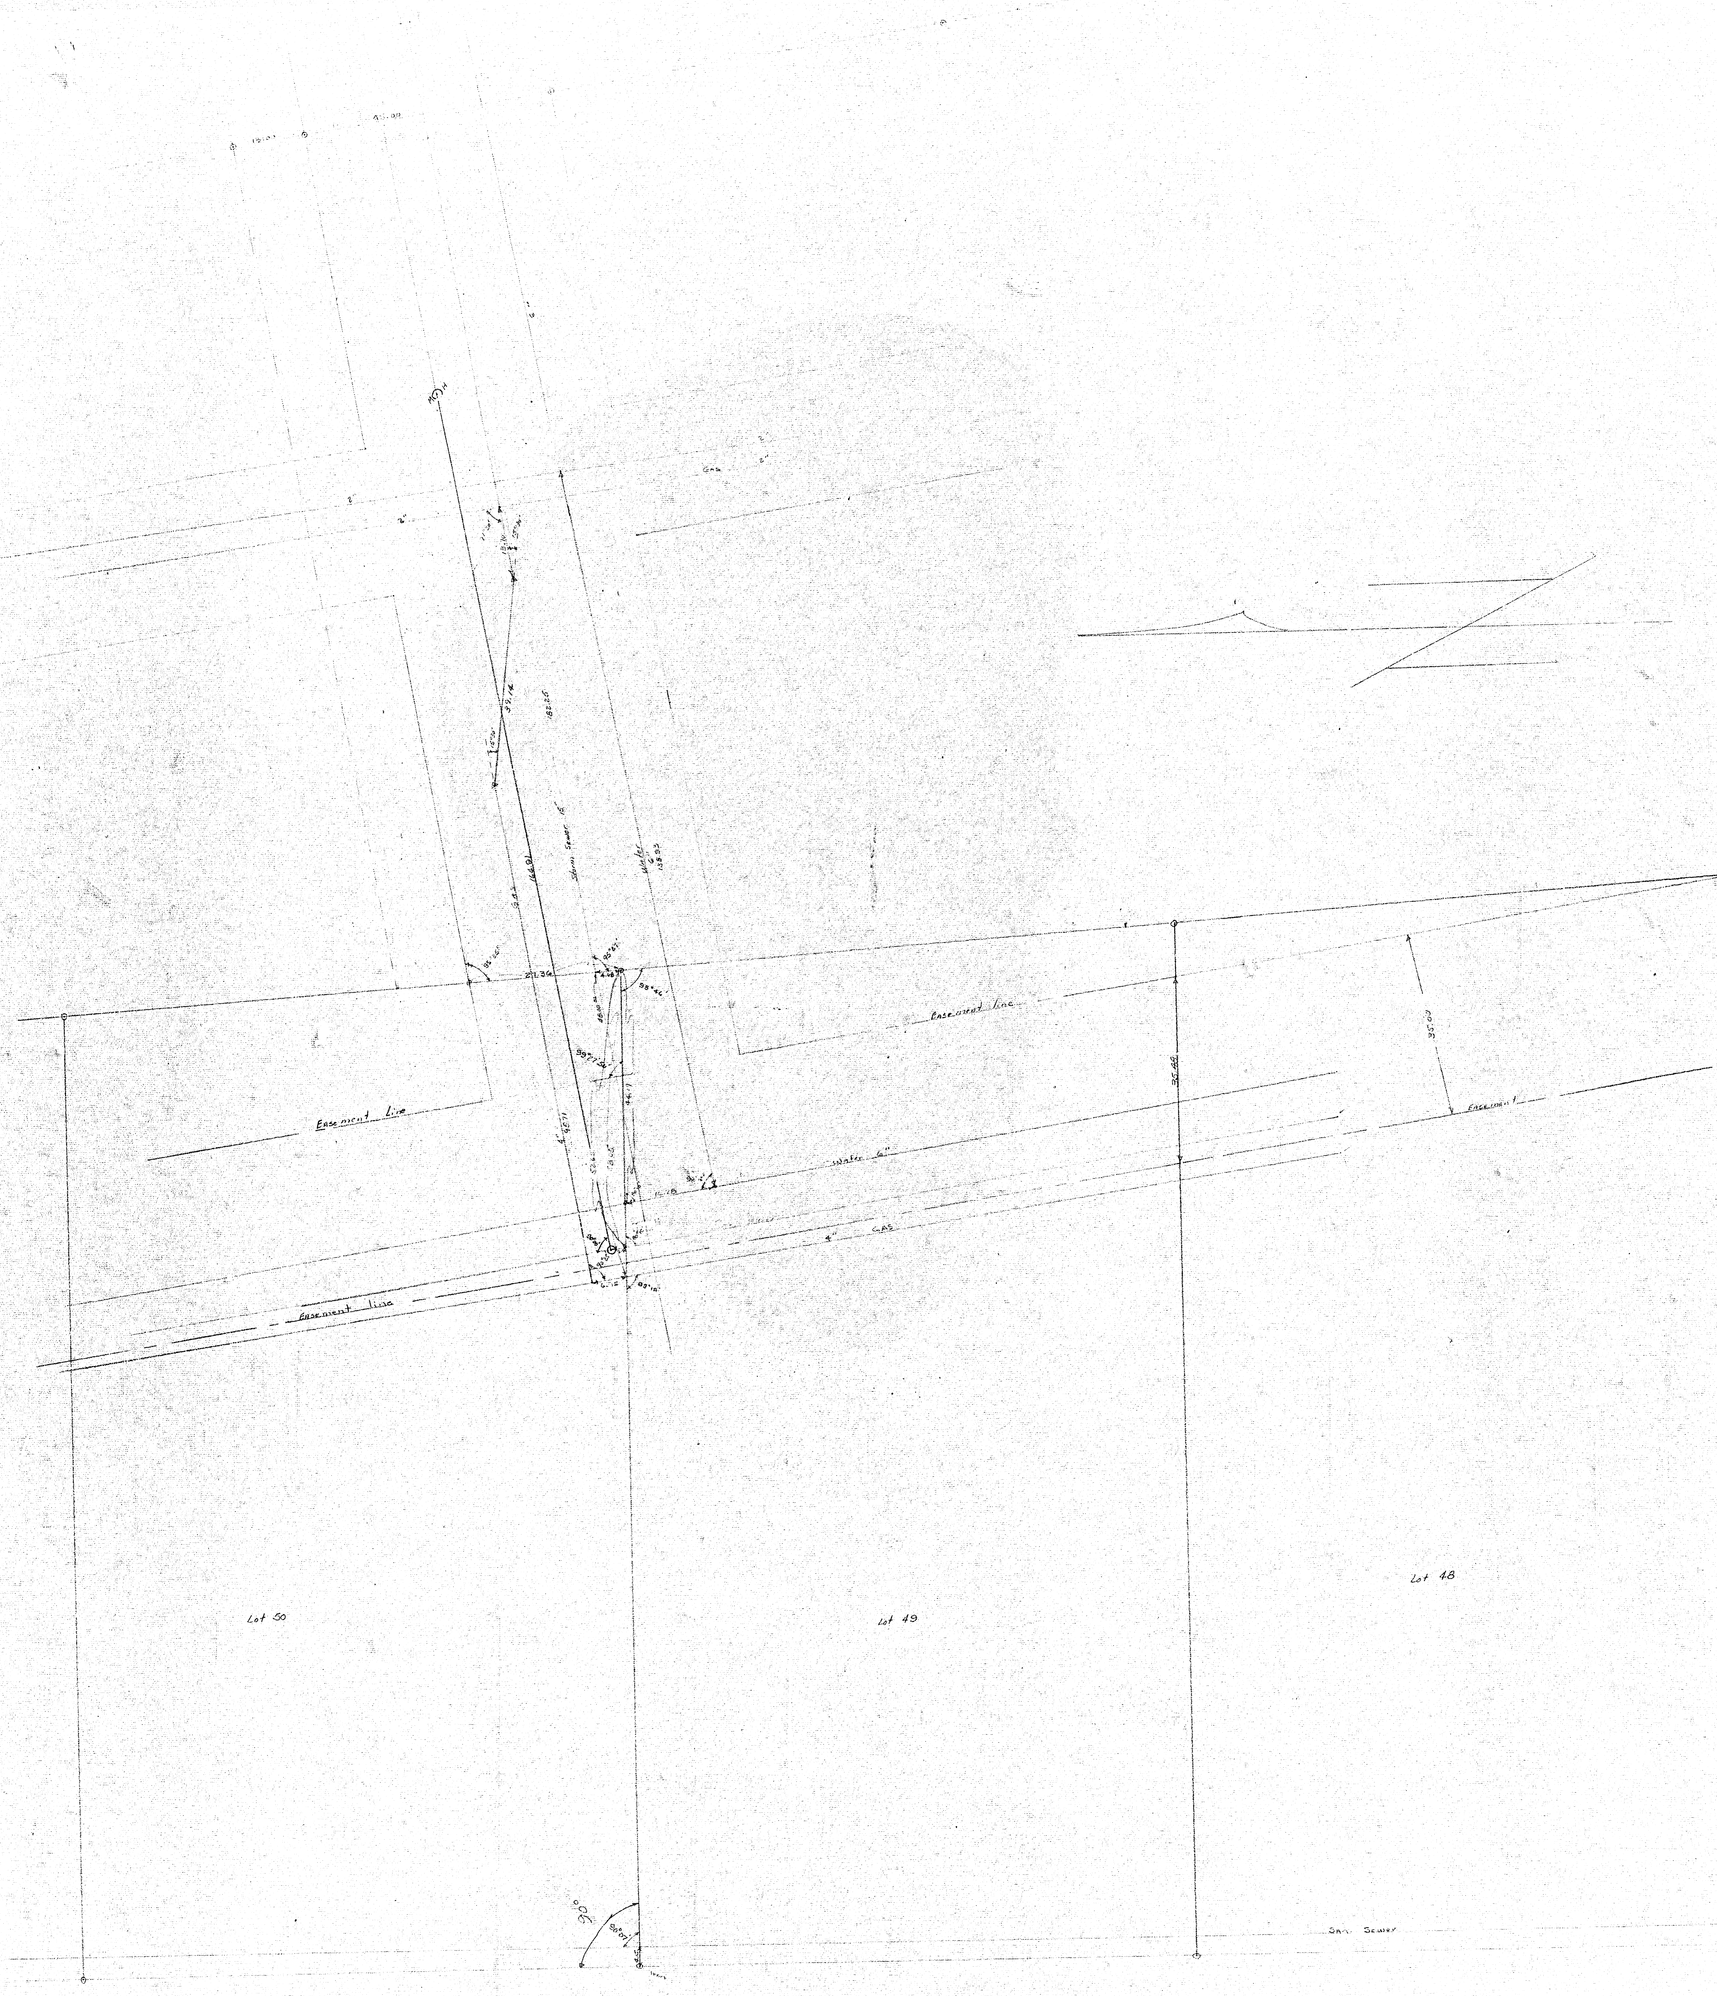
Easement line
Easement line
Easement line
Easement line
Water 6"
4" GAS
Lot 50
Lot 49
Lot 48
Sani. Sewer
N 88°01'
300'

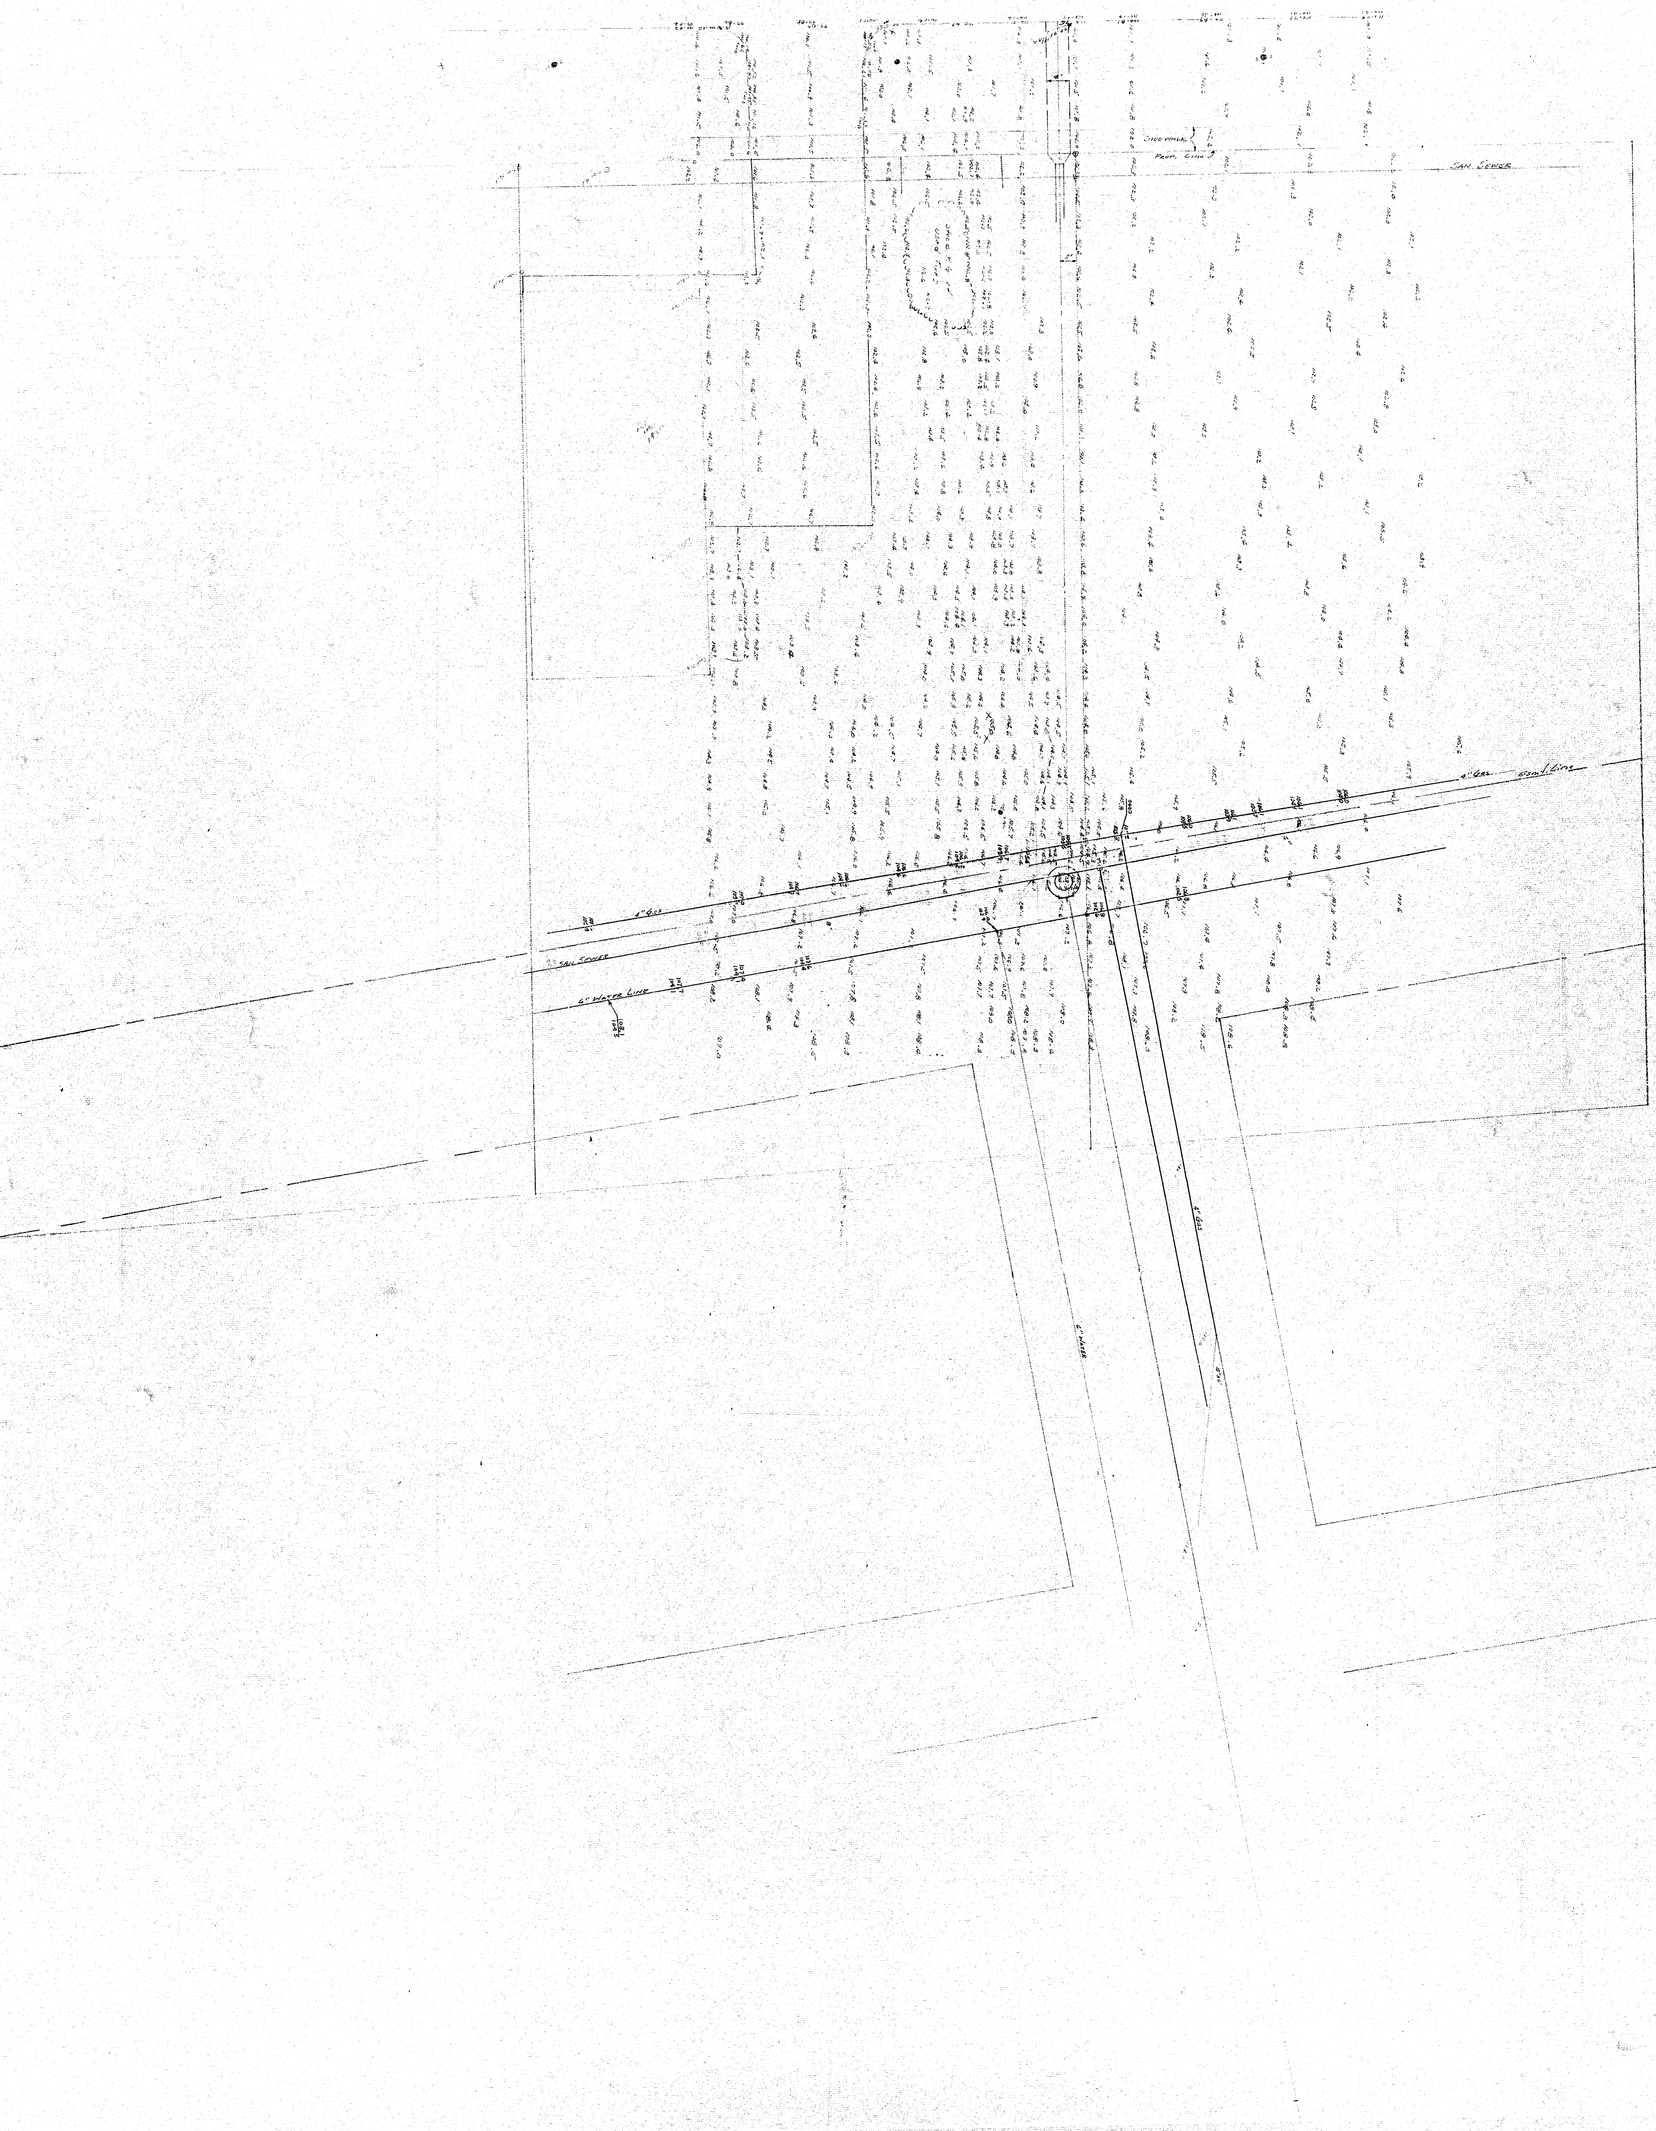
SIDEWALK
PROP. LINE
SAN. SEWER
6" GAS
6" GAS
SAN. SEWER
6" WATER LINE
6" GAS
6" GAS