





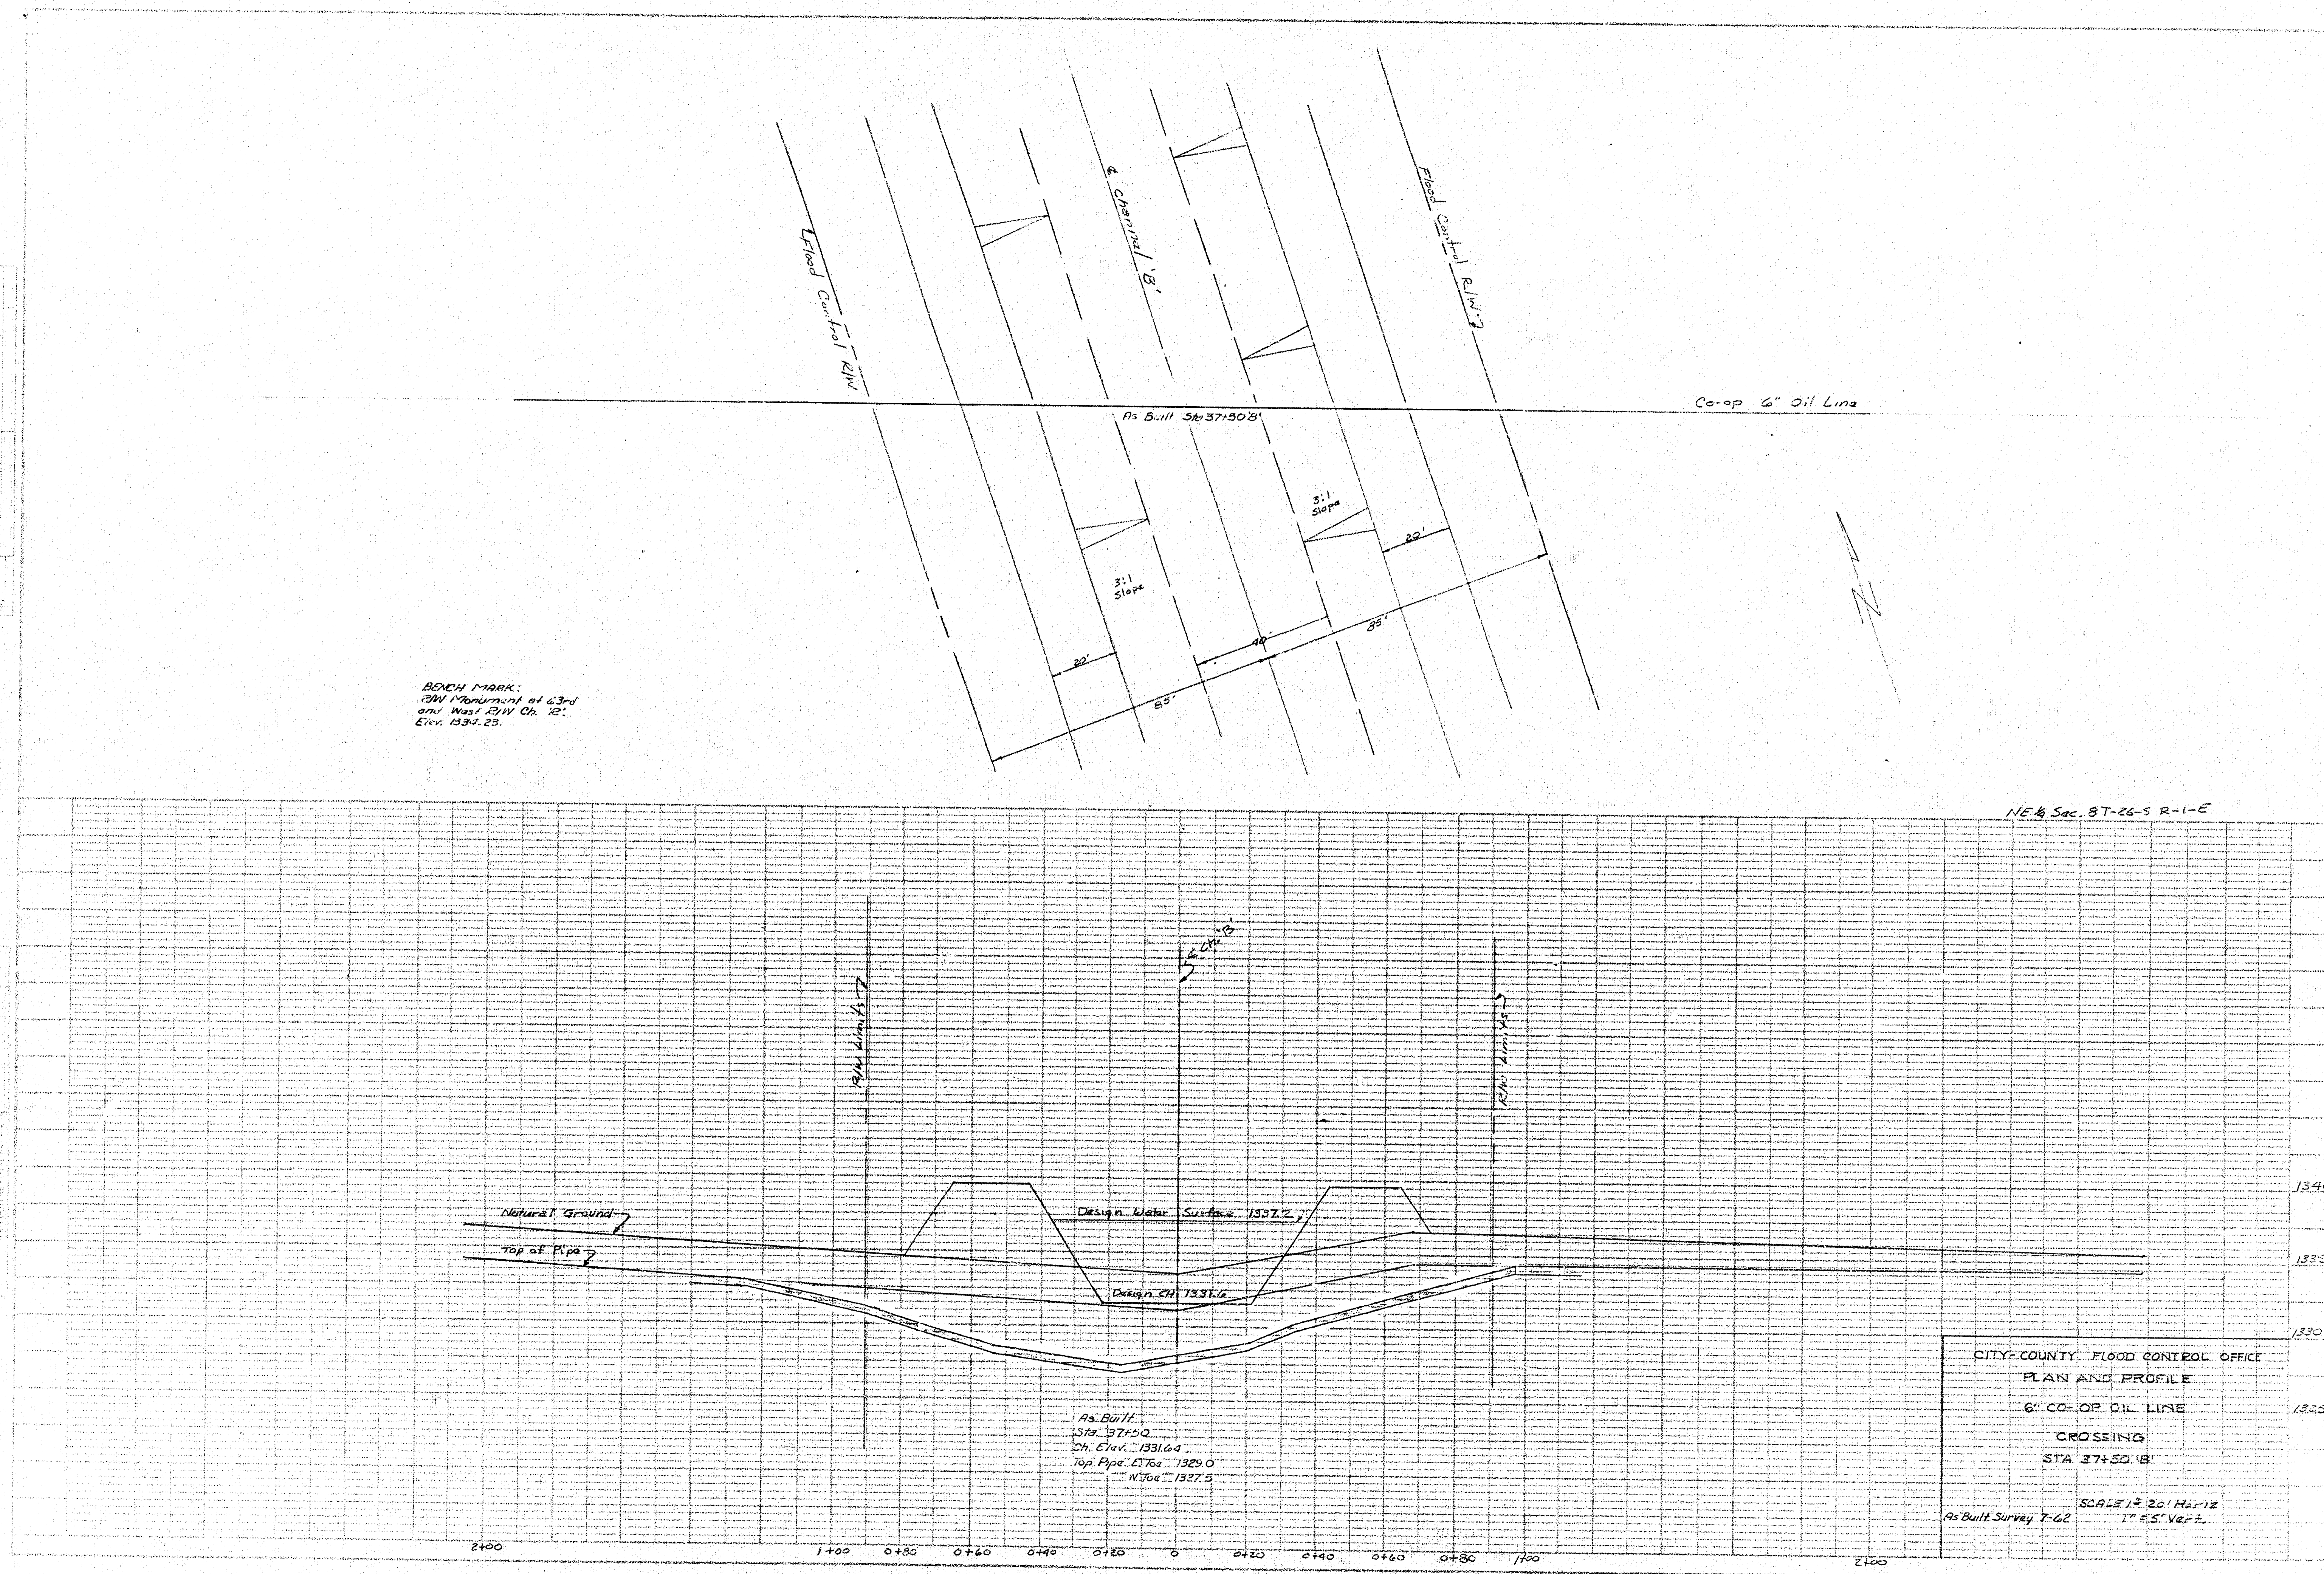

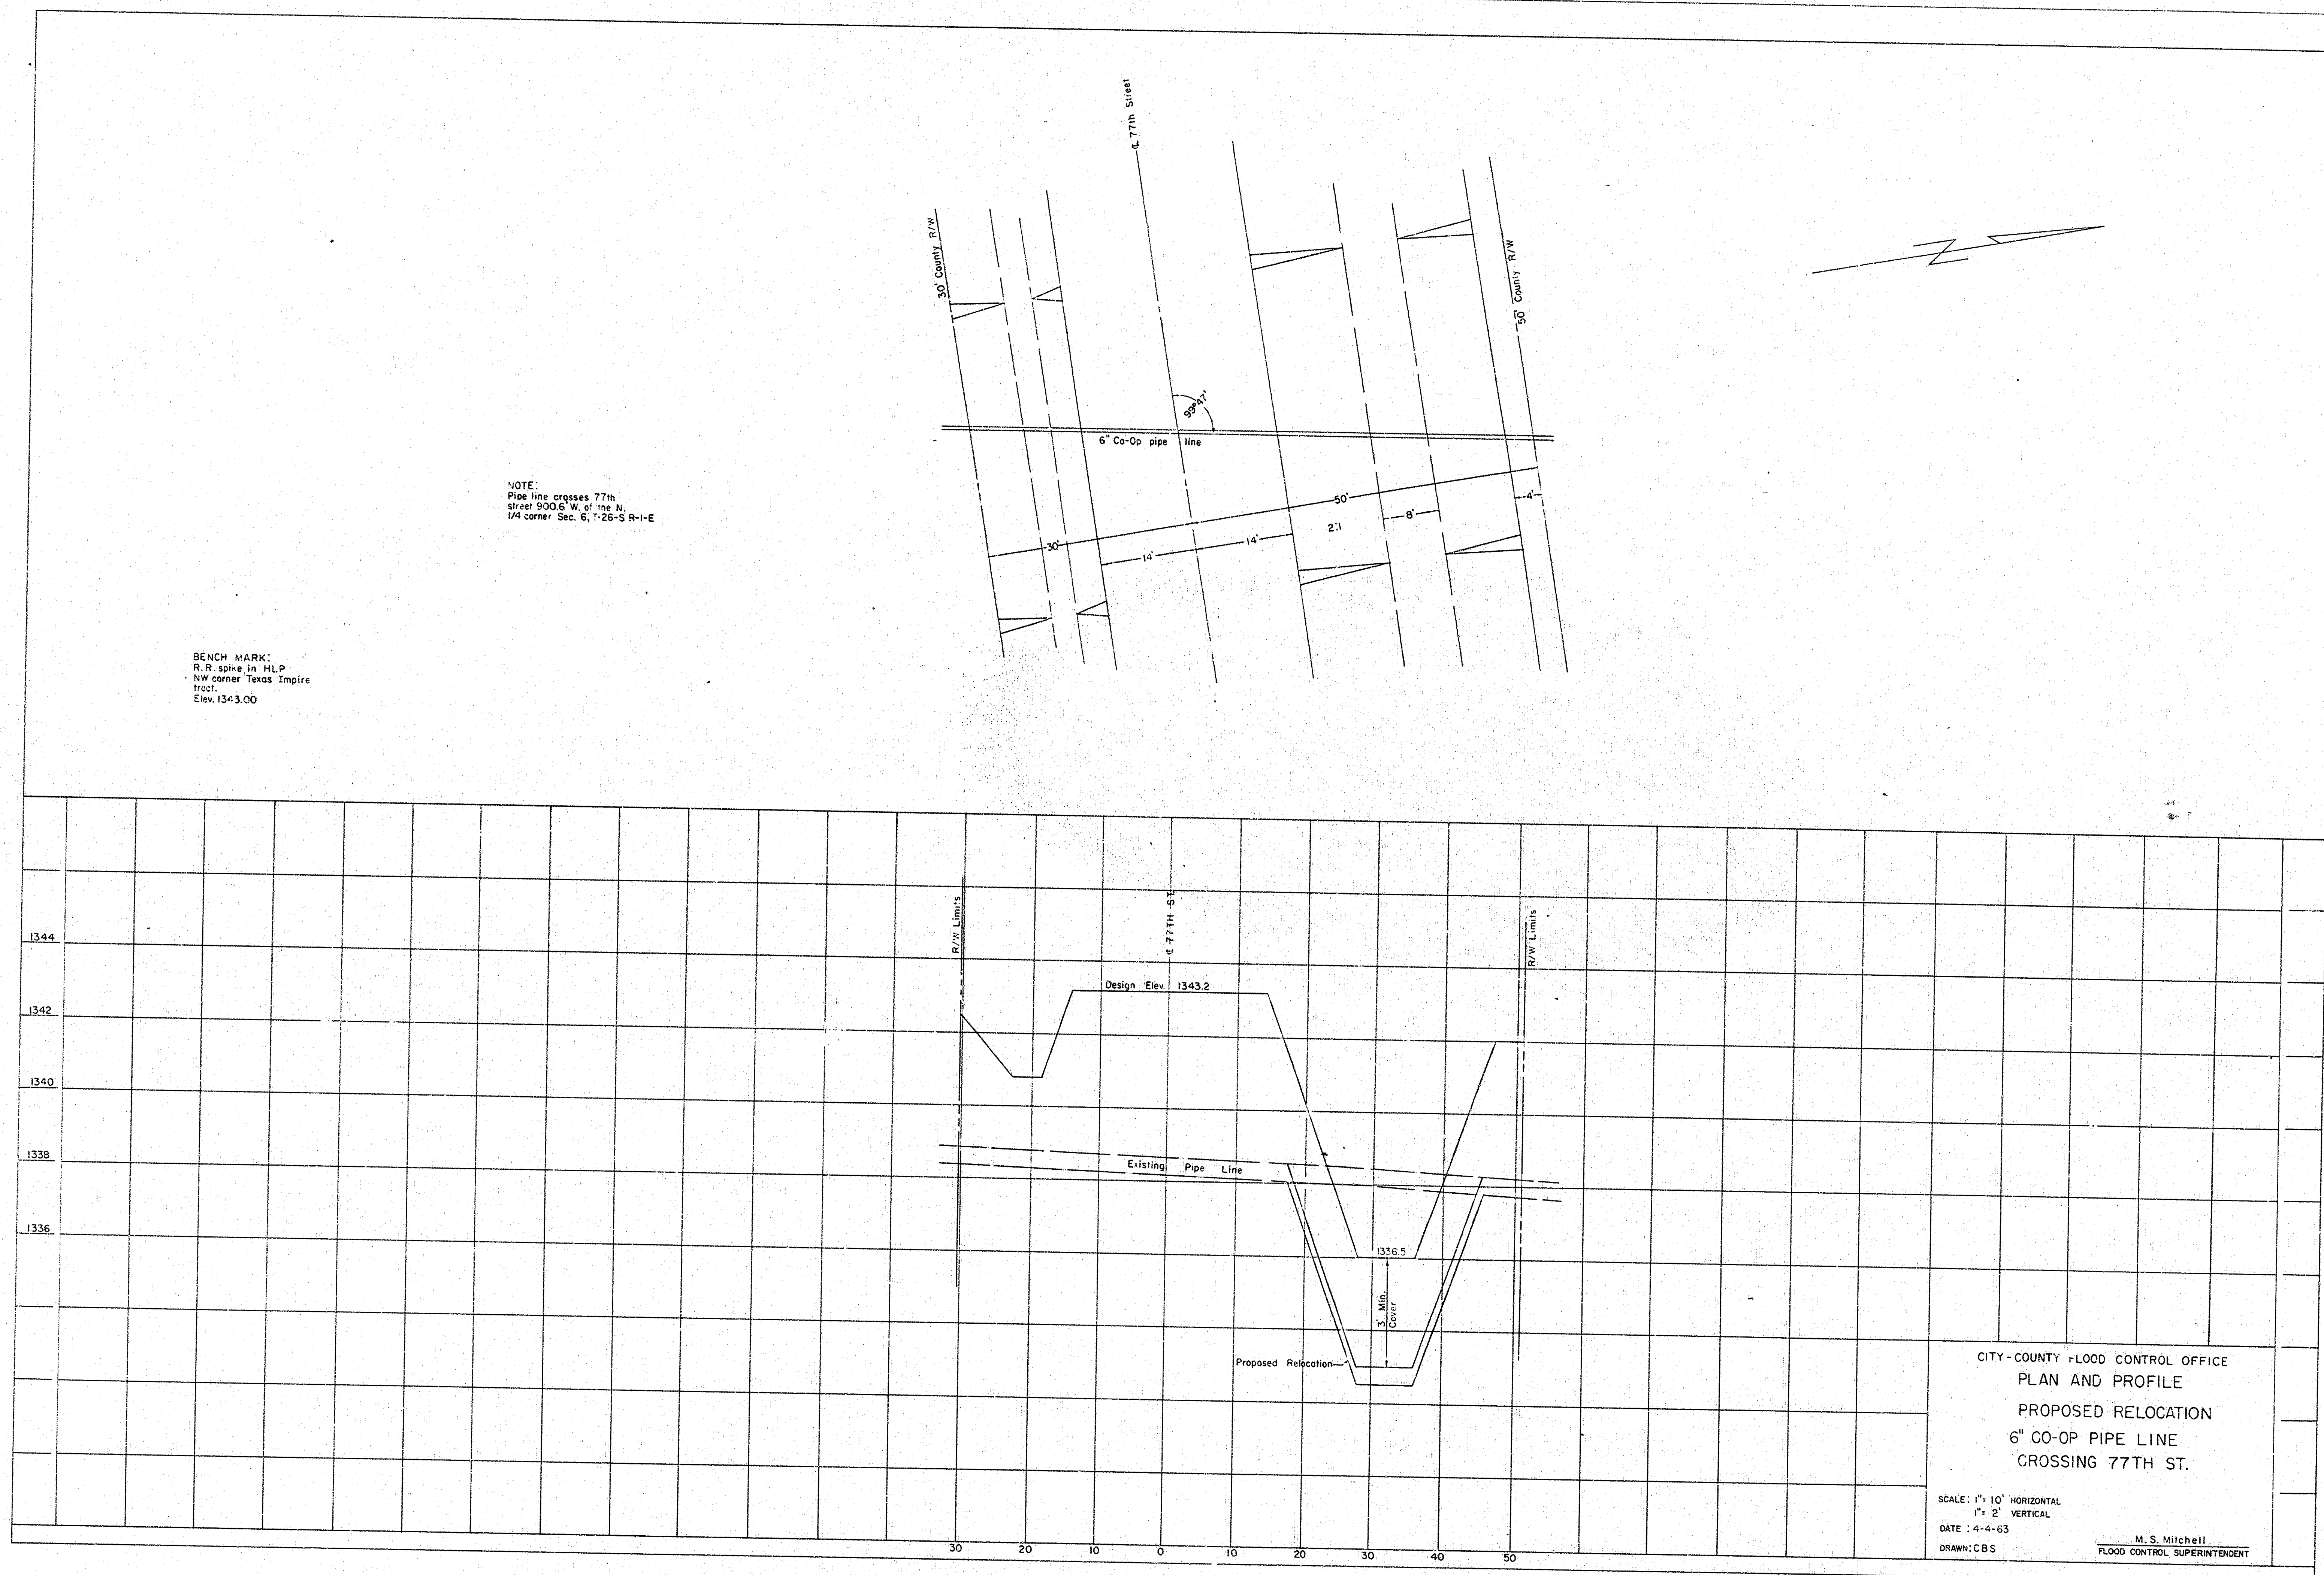

PLAN


