

STATE OF KANSAS STATE HIGHWAY COMMISSION SEDGWICK COUNTY

PLAN AND PROFILE

PROJECT F. C. 314 (B)


INDEX OF SHEETS

- 1 - Title Sheet
- 2 - Topography
- 3 & 4 - Plan & Profile
- 5 - Construction Layout (618-22-2775)
- 6 - Piling Location in Levees
- 7 - General Details
- 8 - Auxiliary
- 9 - Reinforcing
- 10 - Piling " " (618-22-1856)
- 11 - Construction Layout (618-22-1856)
- 12 - General Details
- 13 - Auxiliary
- 14 - Reinforcing

(COMBINED)	
Concrete Class A (4E)	794.1 CY
Reinforcing Steel	169,100 Lb
14"x14" Conc. Piling	4,070 LF
Bearing Devices	7,570 Lb
Metal Handrail	1,291.5 LF
Structural Steel	22,150 Lb

Sta 18+56 Const 30' 5" 30' 5" P.C.B.
Sta 18+56 Const 30' 5" 30' 5" P.C.B.

Begin Project
Sta 18+05.62

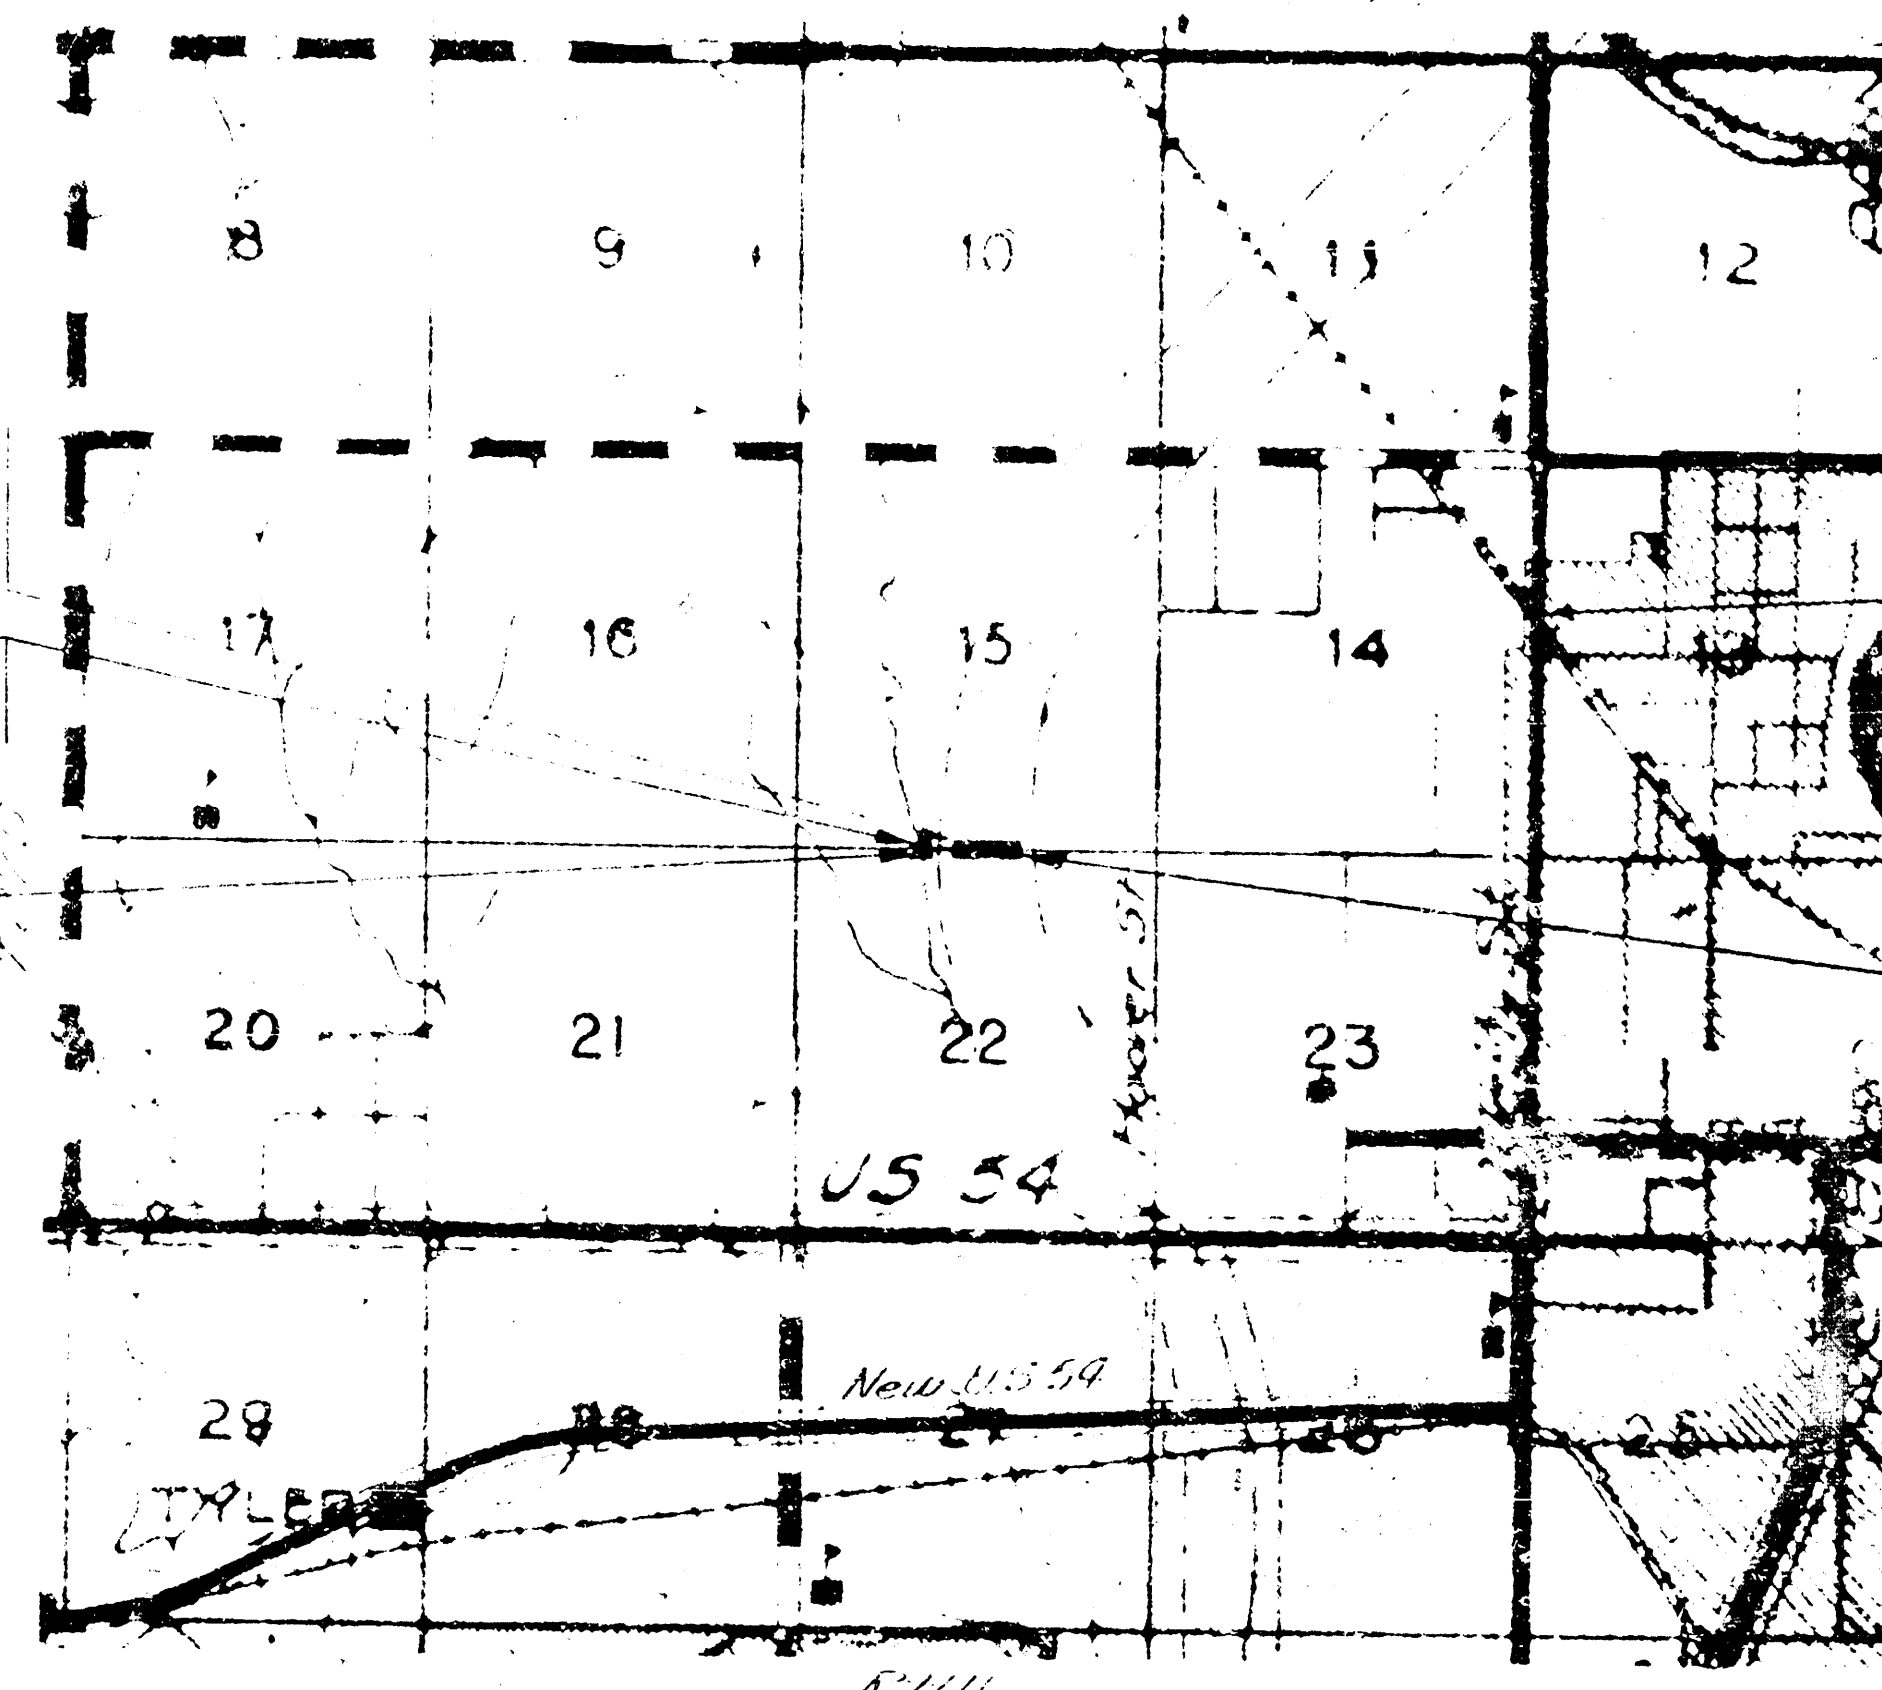

Wichita - 2 Miles
(Maine Siding)

End Project
Sta 30+41.38

Scale 2" = 1 mile

BRIDGES ONLY

CONVENTIONAL SIGNS

COUNTY LINE	---
SECTION LINE	---
WIRE FENCE	---
HEDGE ROW	---
RAILROAD	---
SURVEY LINE	---
RIGHT OF WAY	---
TELEPHONE	---
POWER POLE	---
TRAVELED WAY	---
CITY LIMITS	---
TOWNSHIP BOUNDARY	---

GROSS LENGTH OF PROJECT 123,576 FT. 0.234 MILES
EXCEPTIONS 602.26 FT. 0.114
ADDITIONS
NET LENGTH OF PROJECT 63,350 FT. 0.120 MILES
NET LENGTH OF BRIDGES 63,350 FT. 0.120 MILES
NET LENGTH OF ROAD FT. MILES

RECOMMENDED FOR APPROVAL DATE

ENGINEER OF SECONDARY ROADS
STATE HIGHWAY COMMISSION OF KANSAS

APPROVED DATE

STATE HIGHWAY ENGINEER
STATE HIGHWAY COMMISSION OF KANSAS


RECOMMENDED FOR FINAL DATE


DISTRICT ENGINEER
PUBLIC ROADS ADMINISTRATION
FEDERAL WORKS AGENCY


APPROVED DATE


DIVISION ENGINEER
PUBLIC ROADS ADMINISTRATION
FEDERAL WORKS AGENCY


618-22-1856 AND 618-22-2775

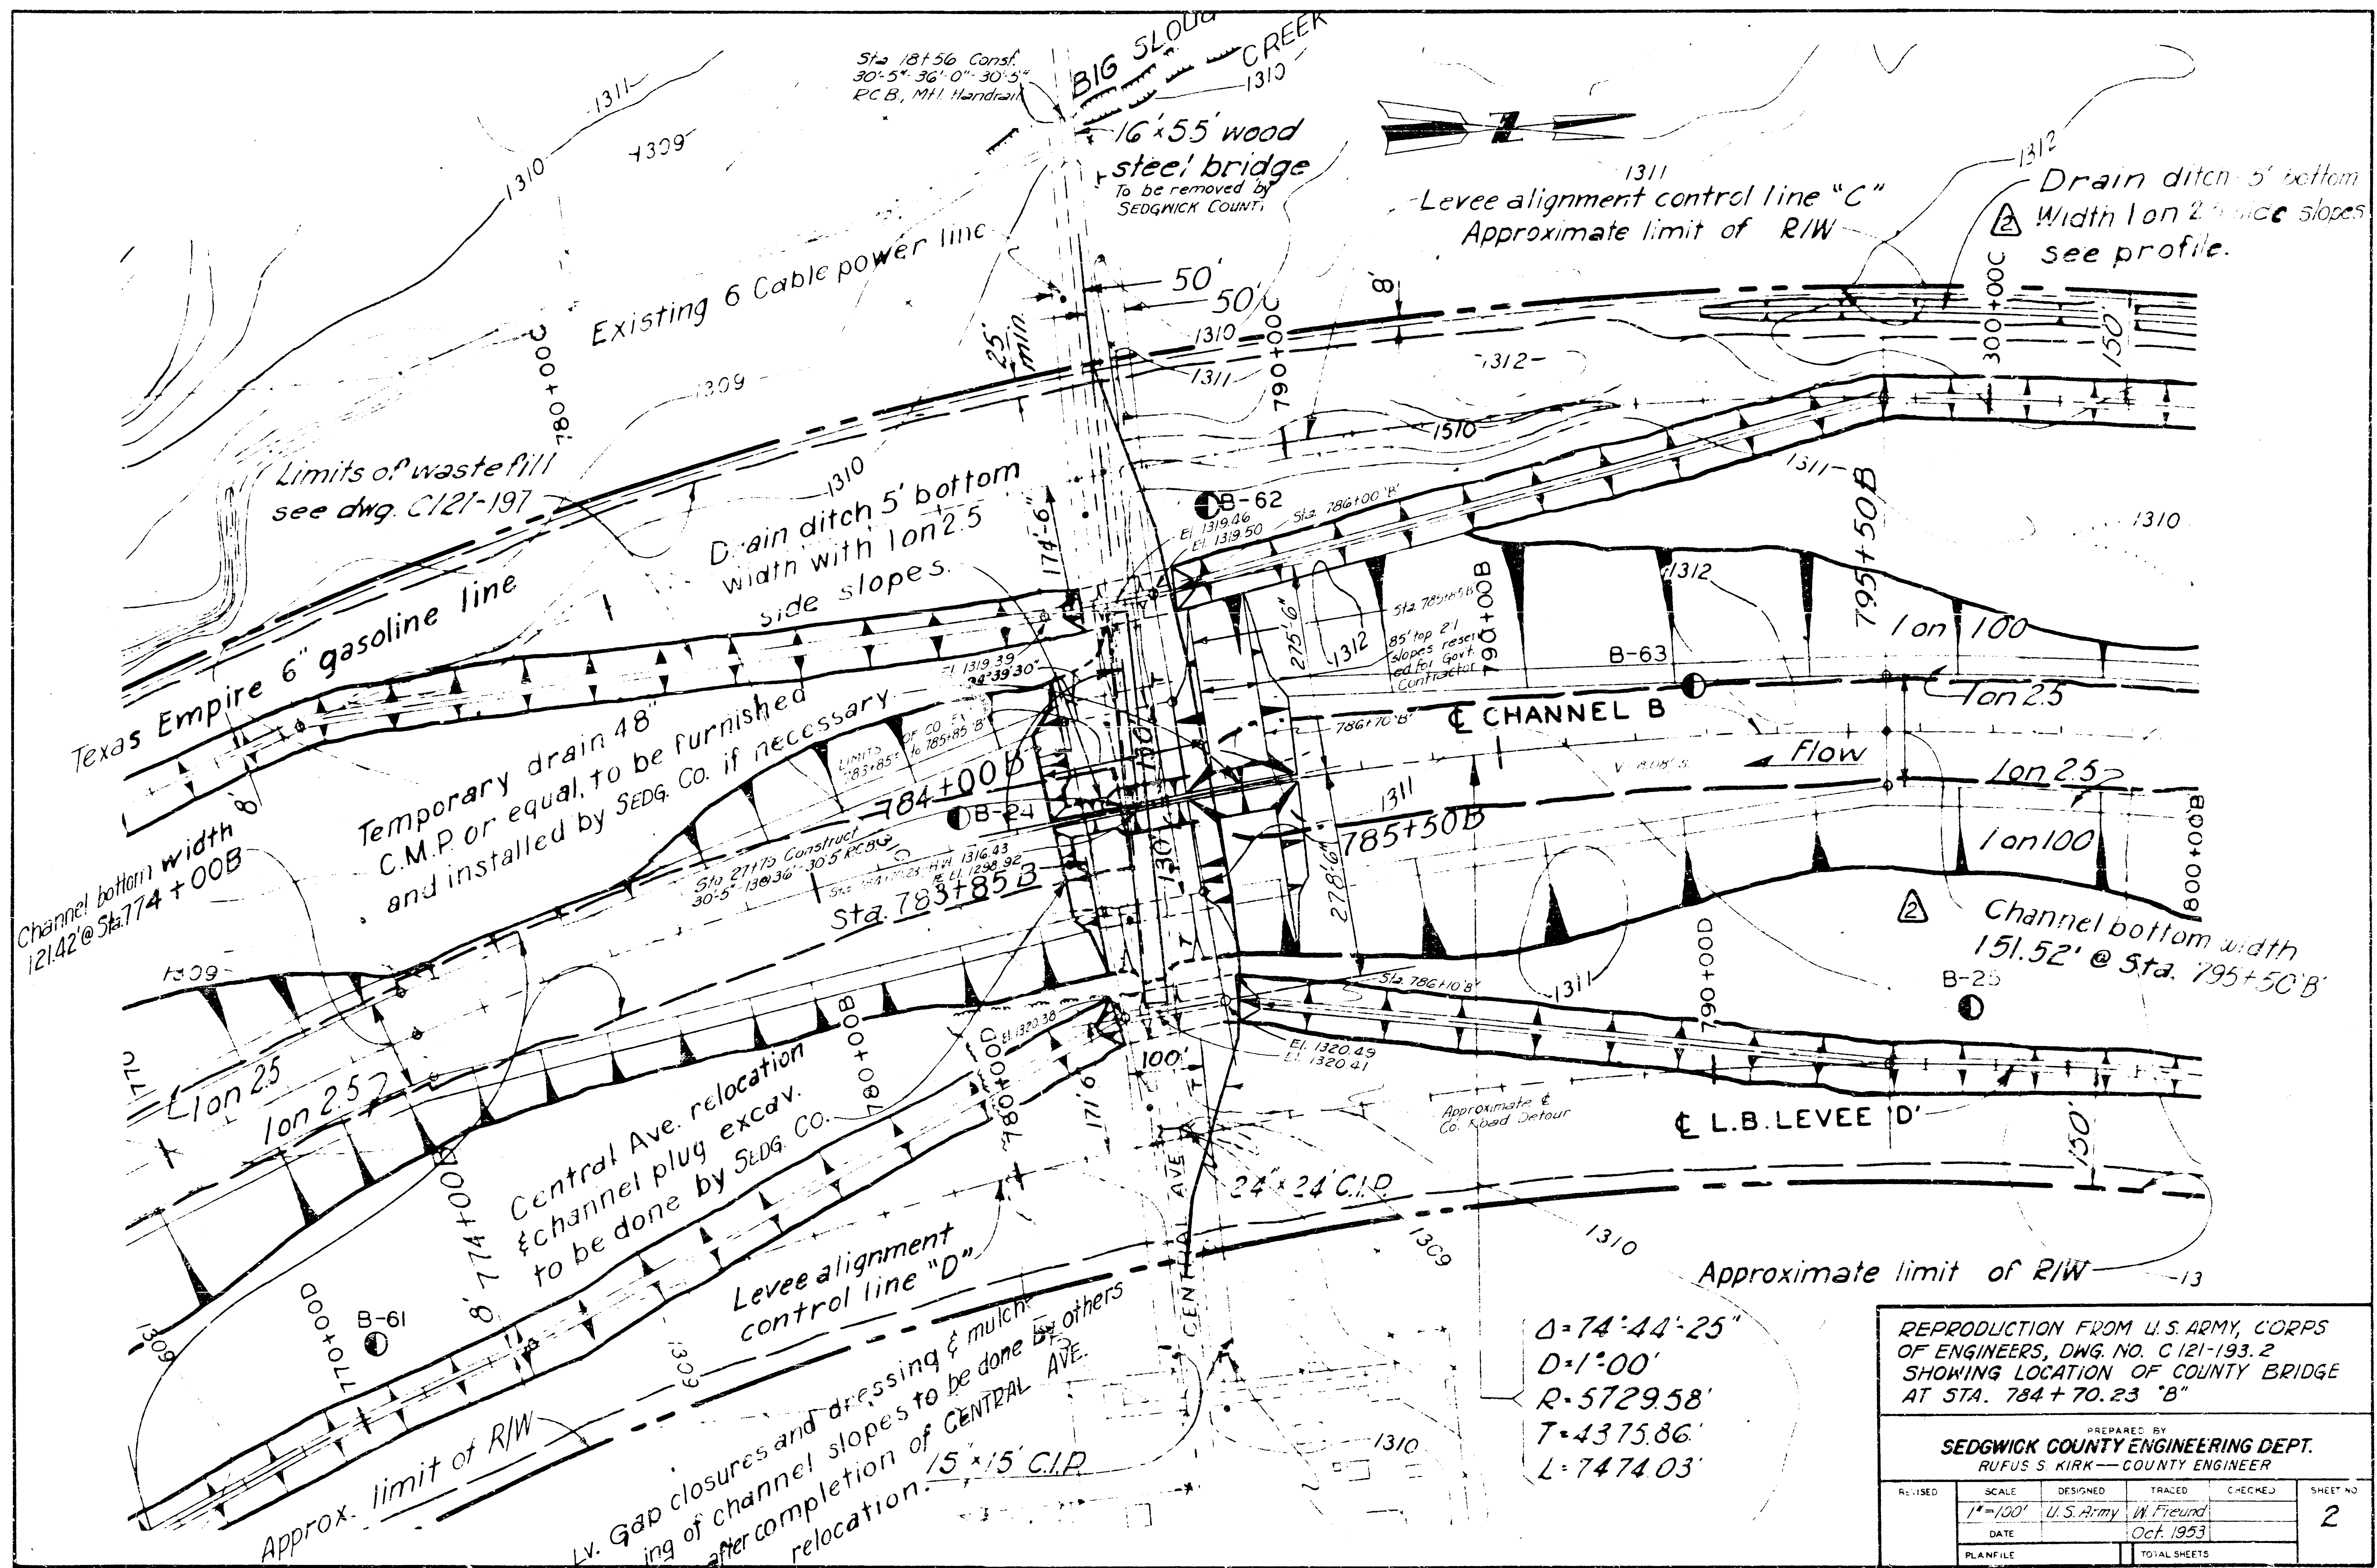

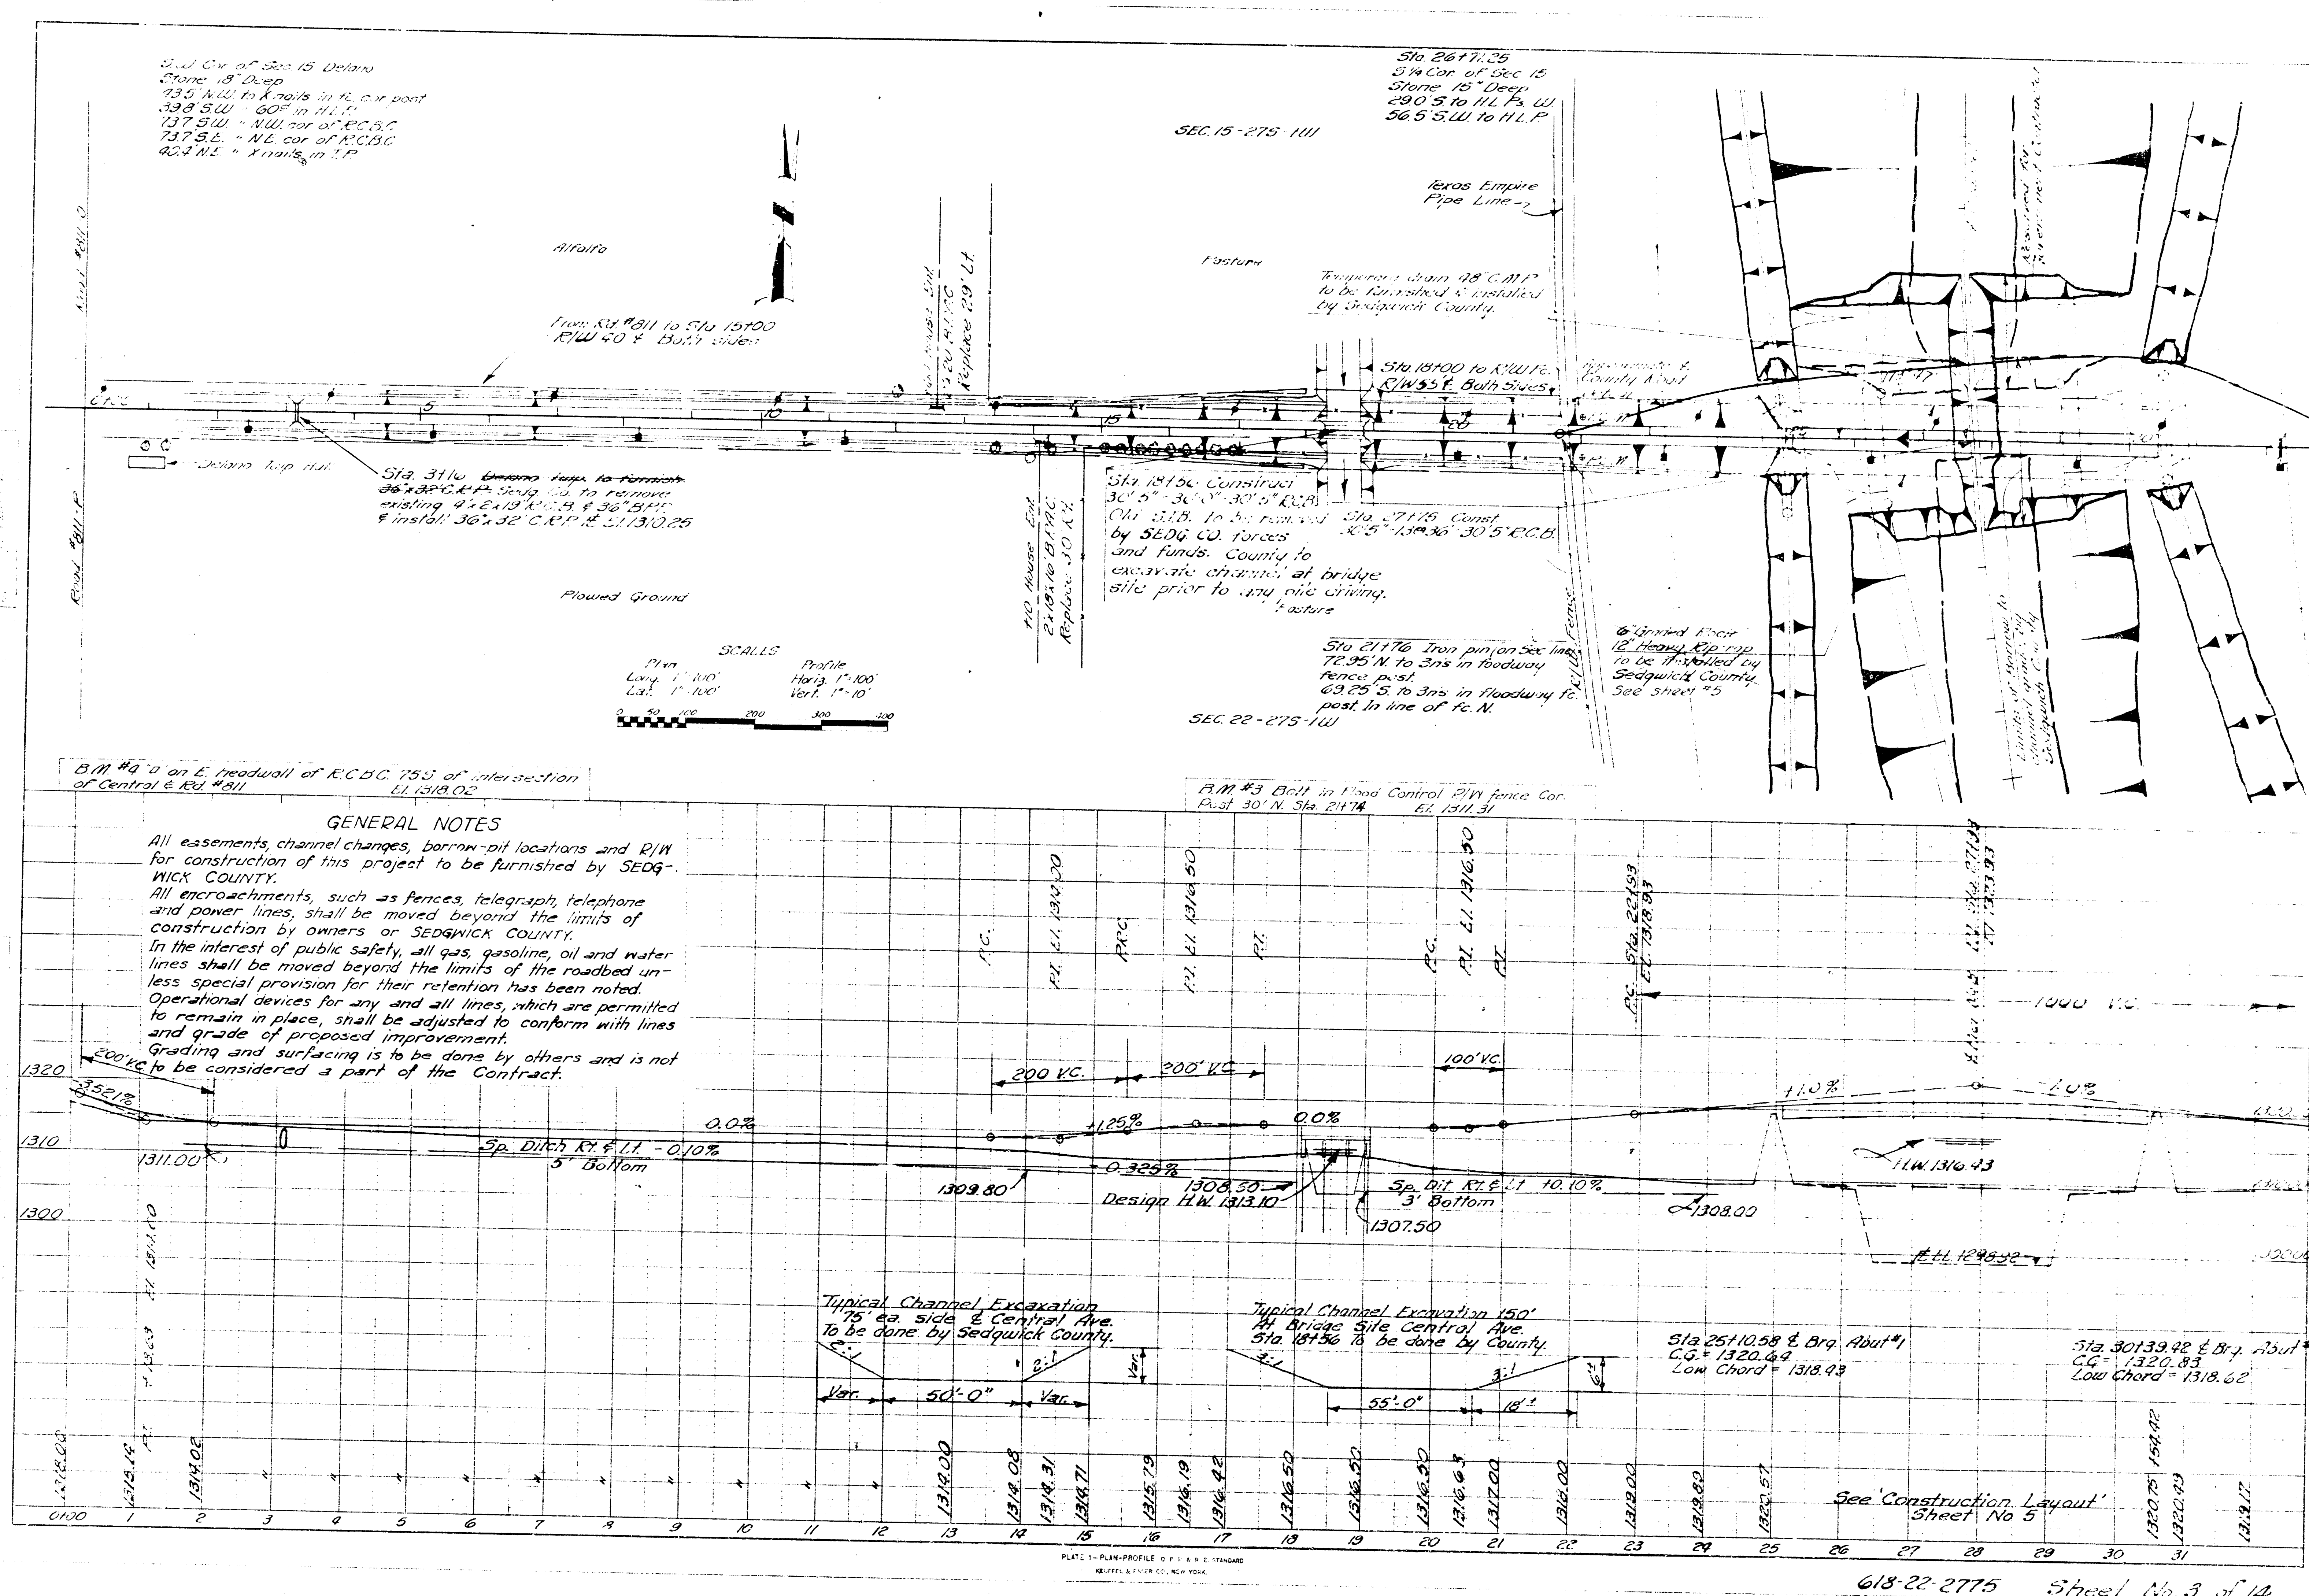

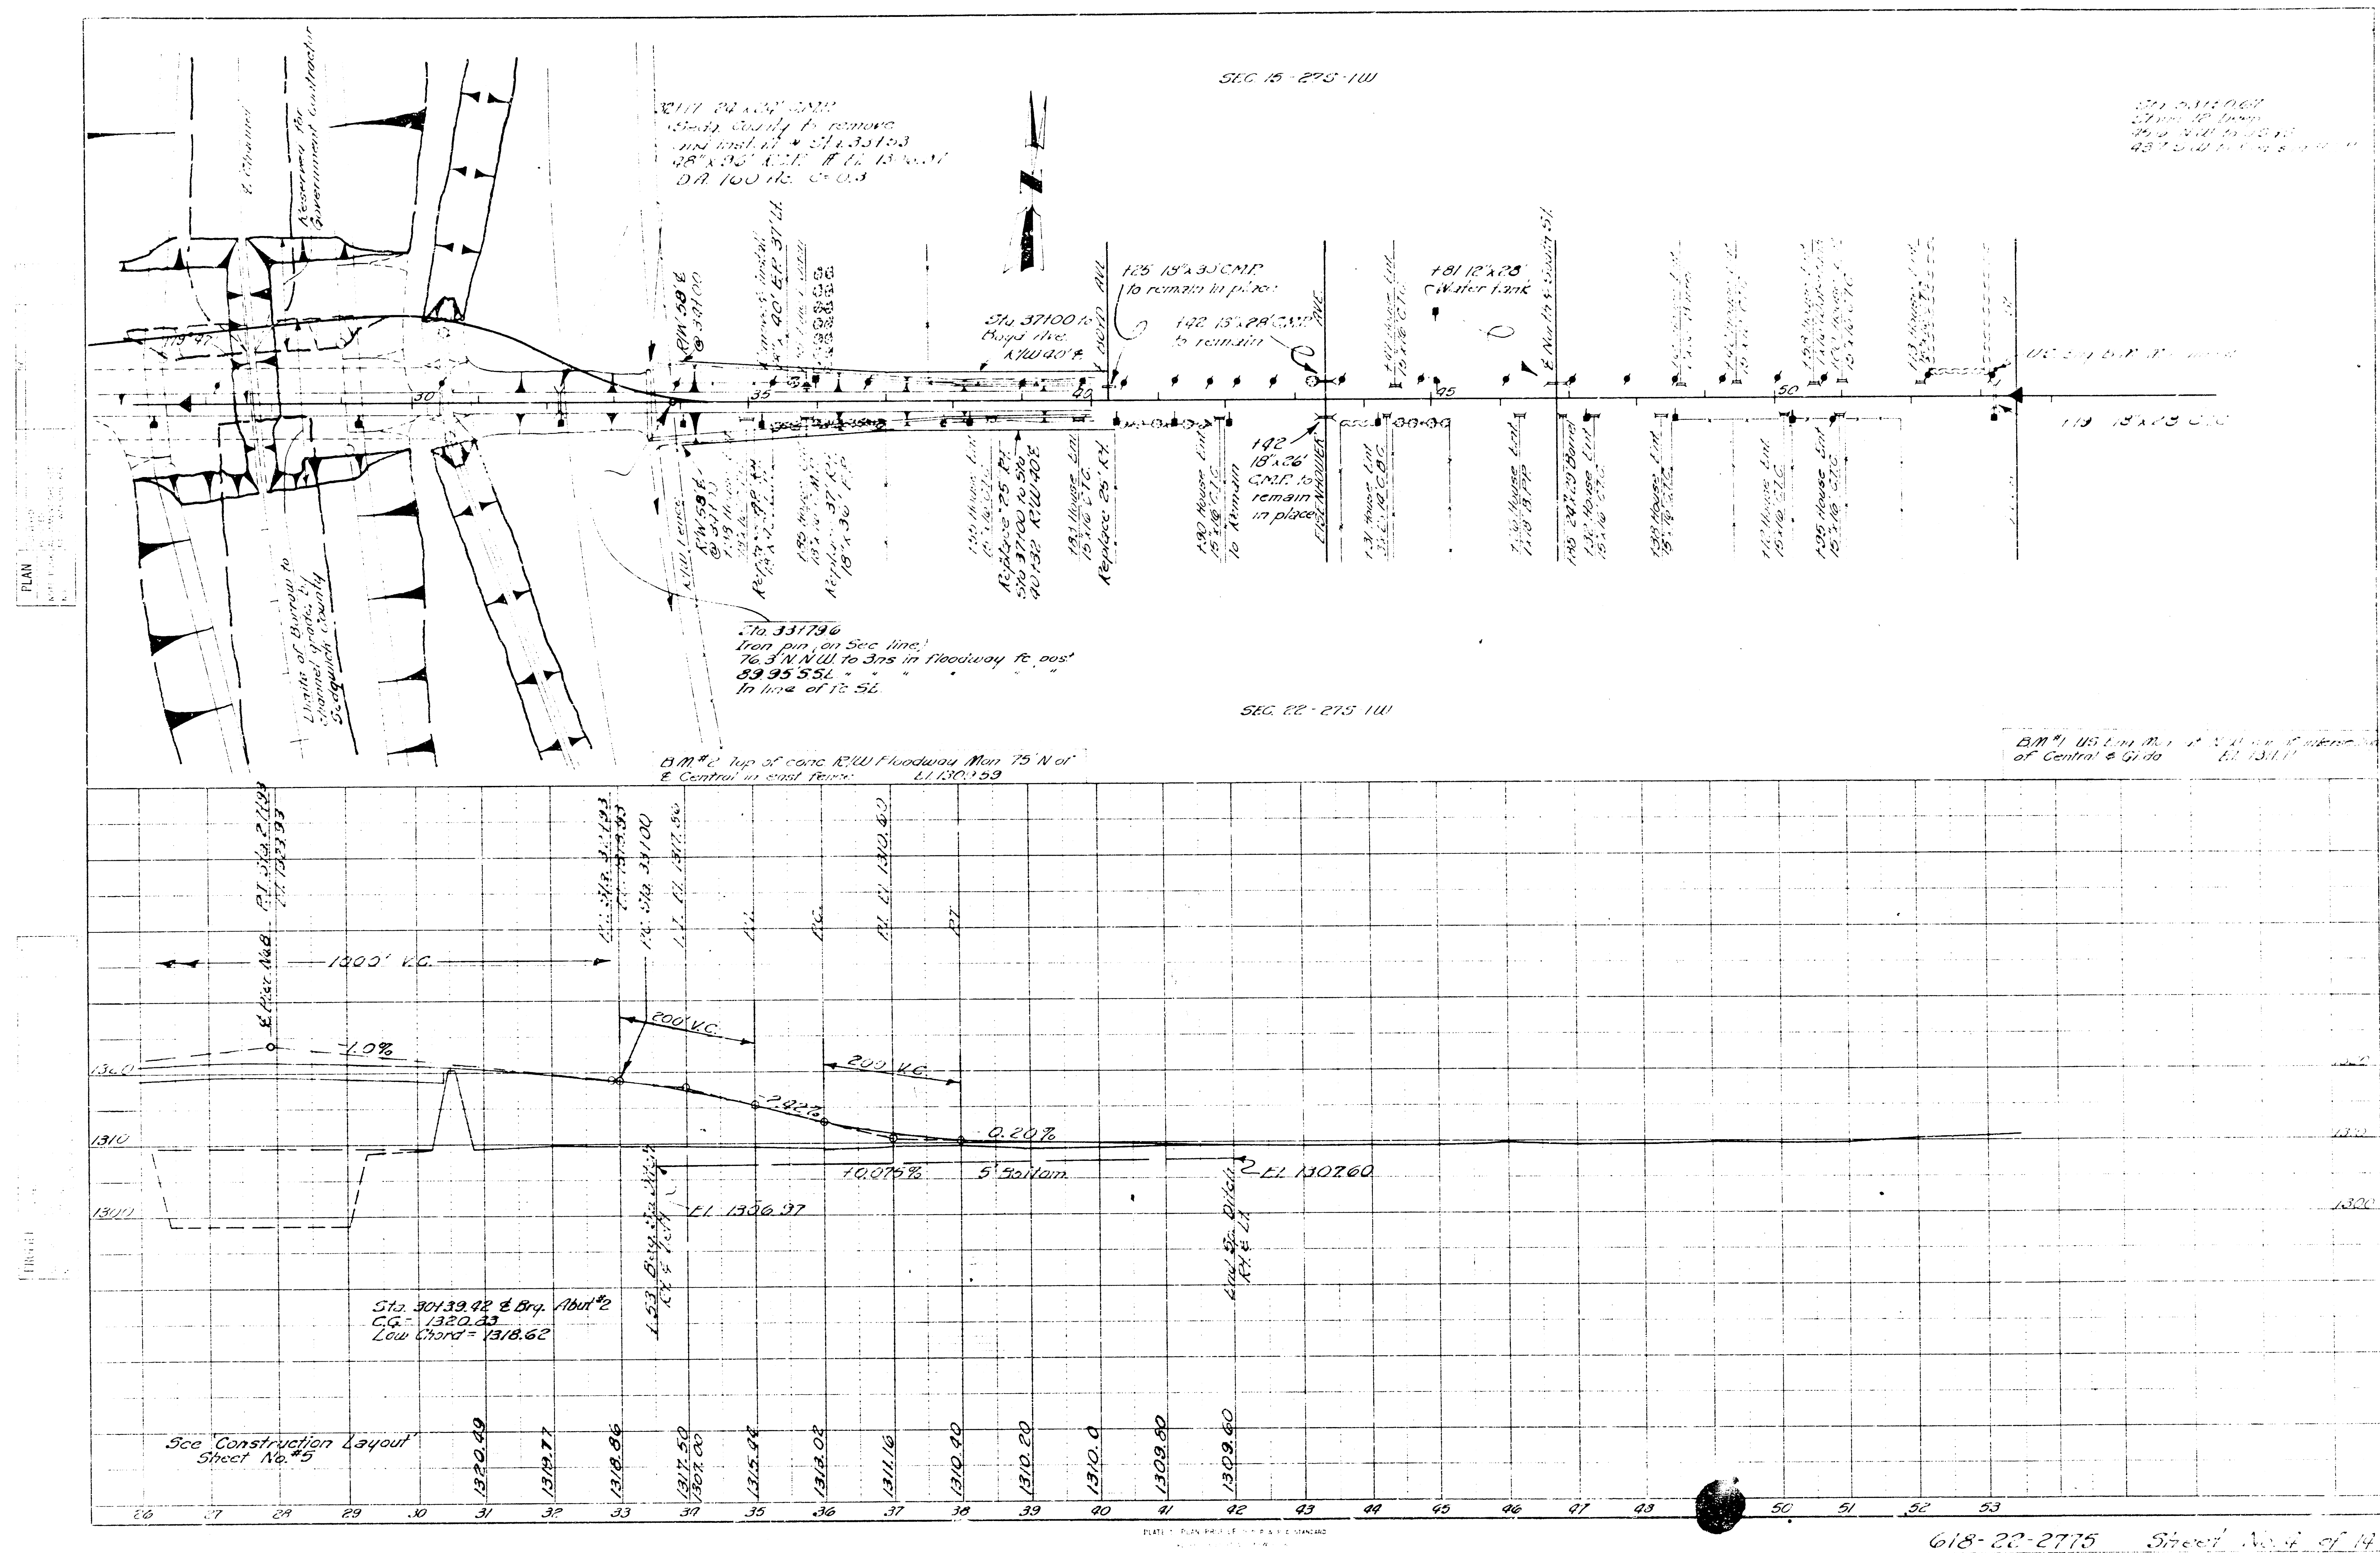

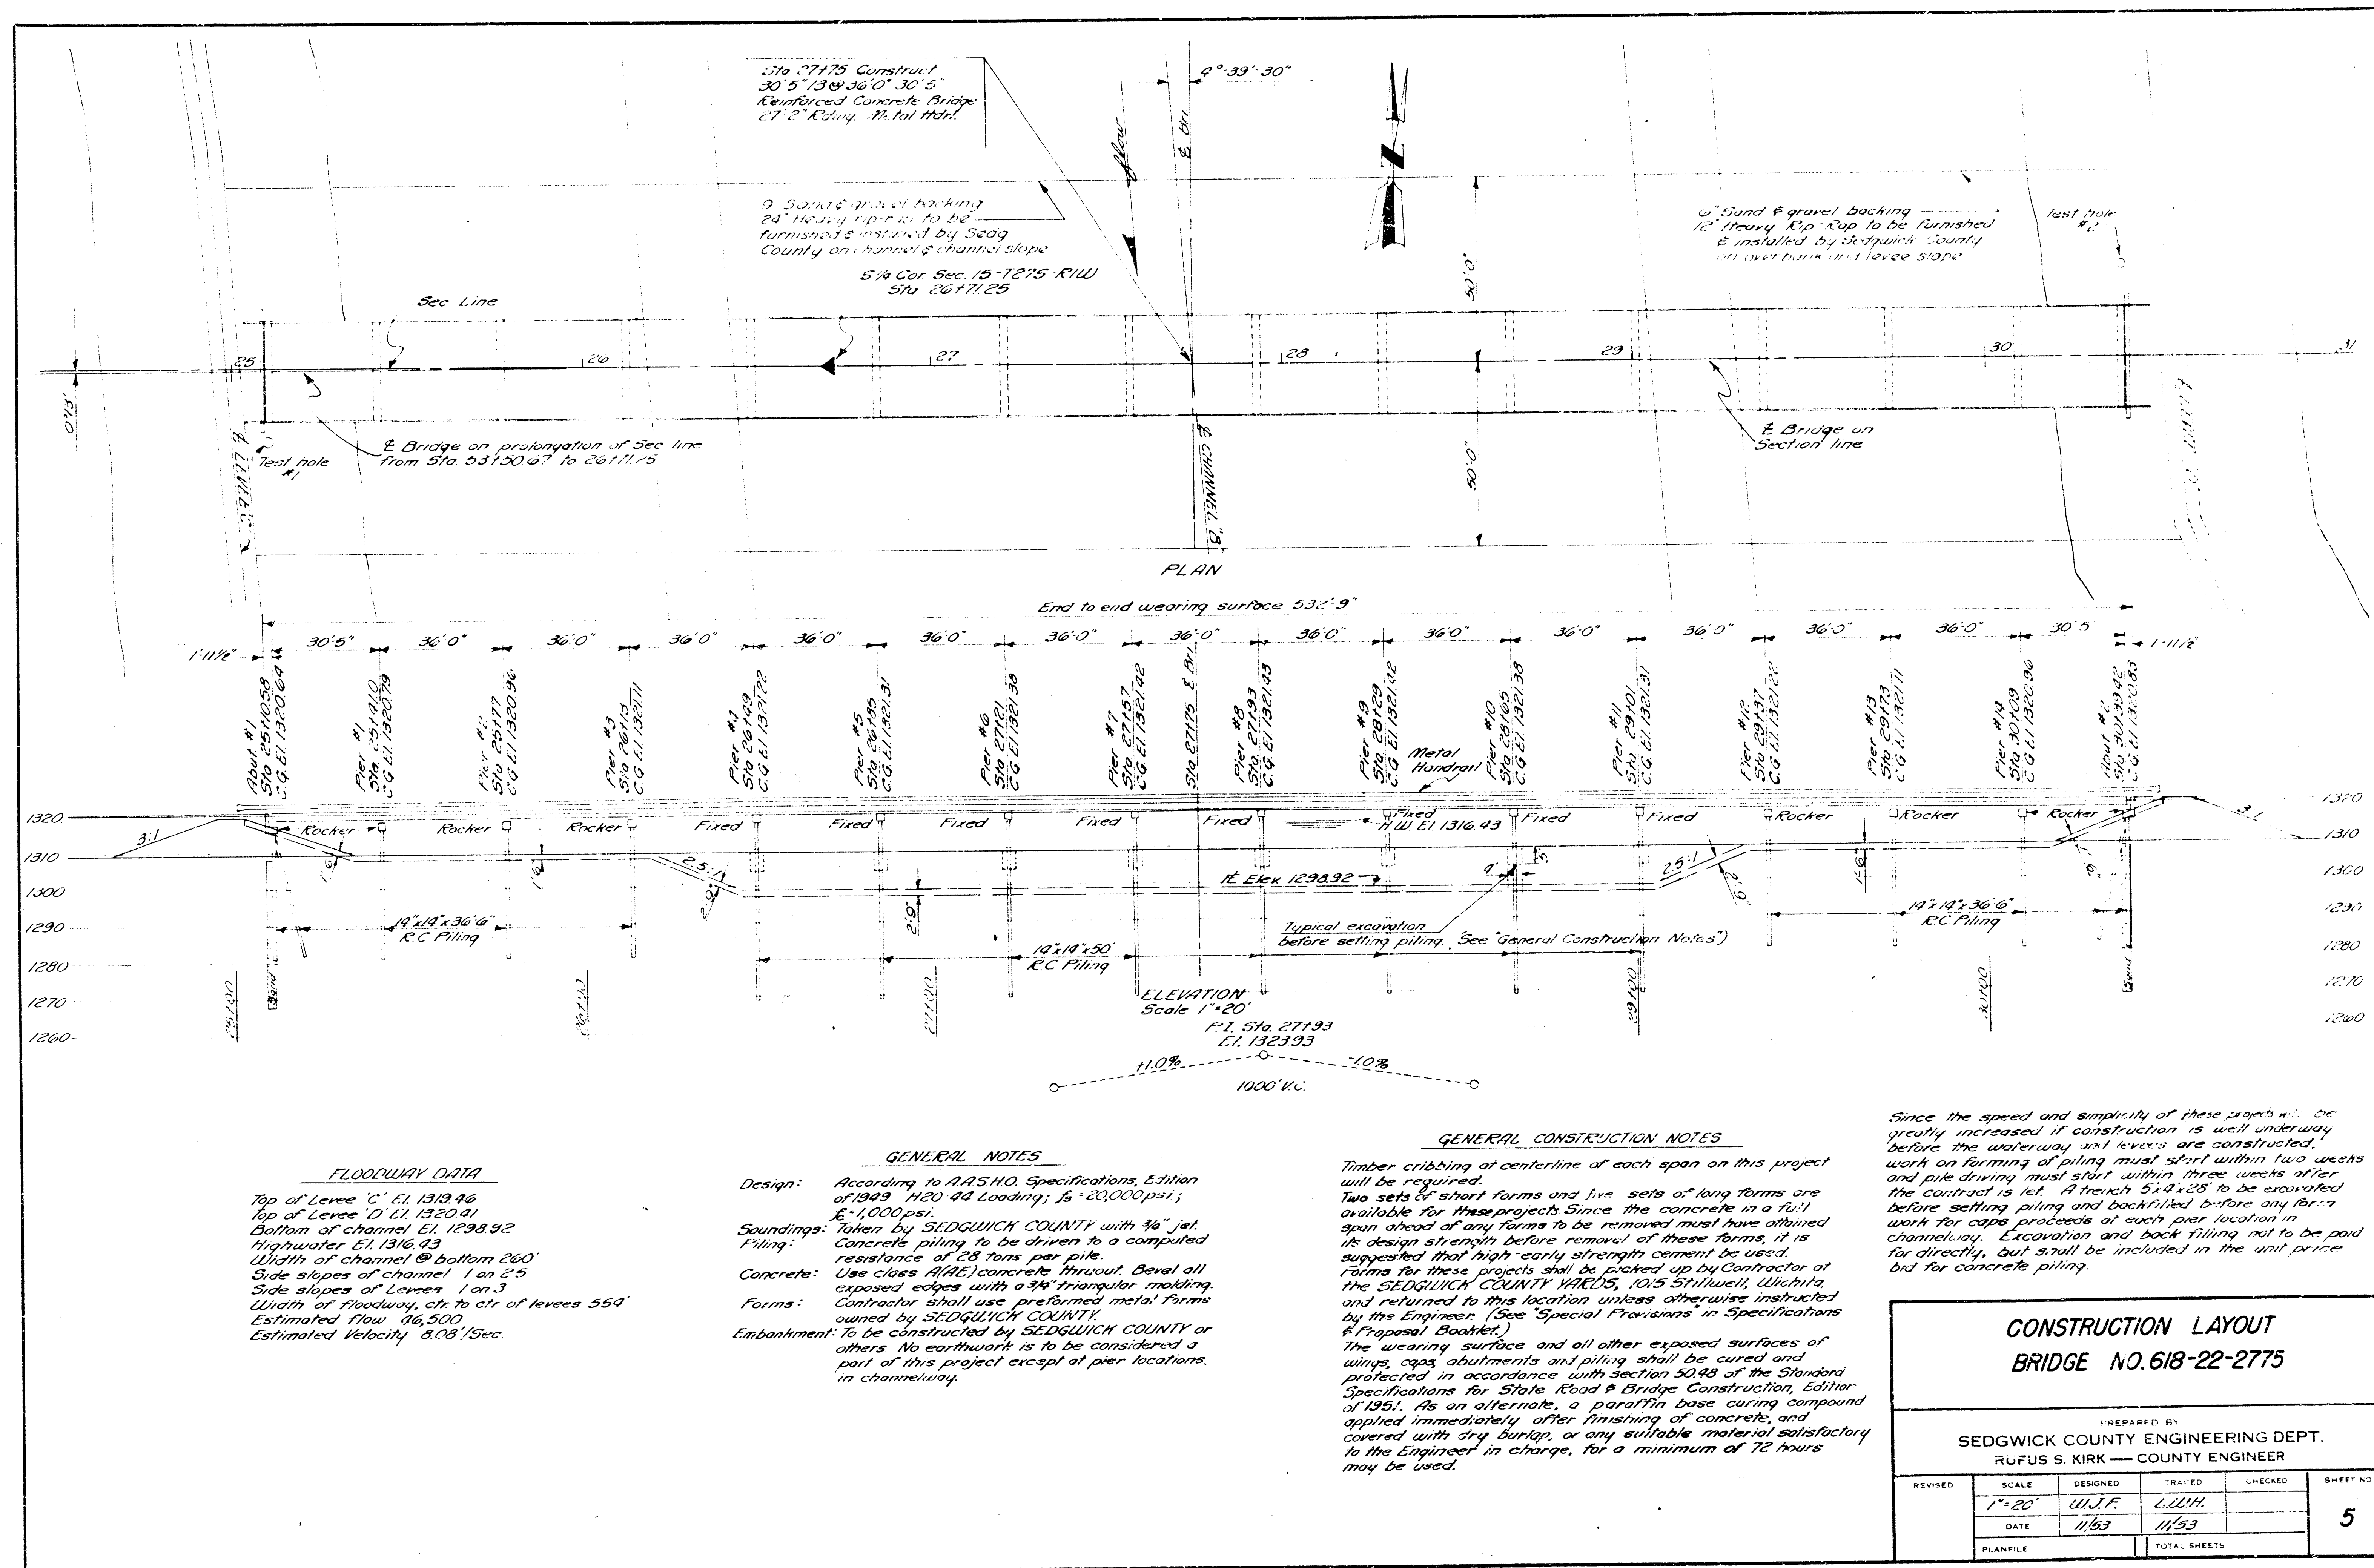




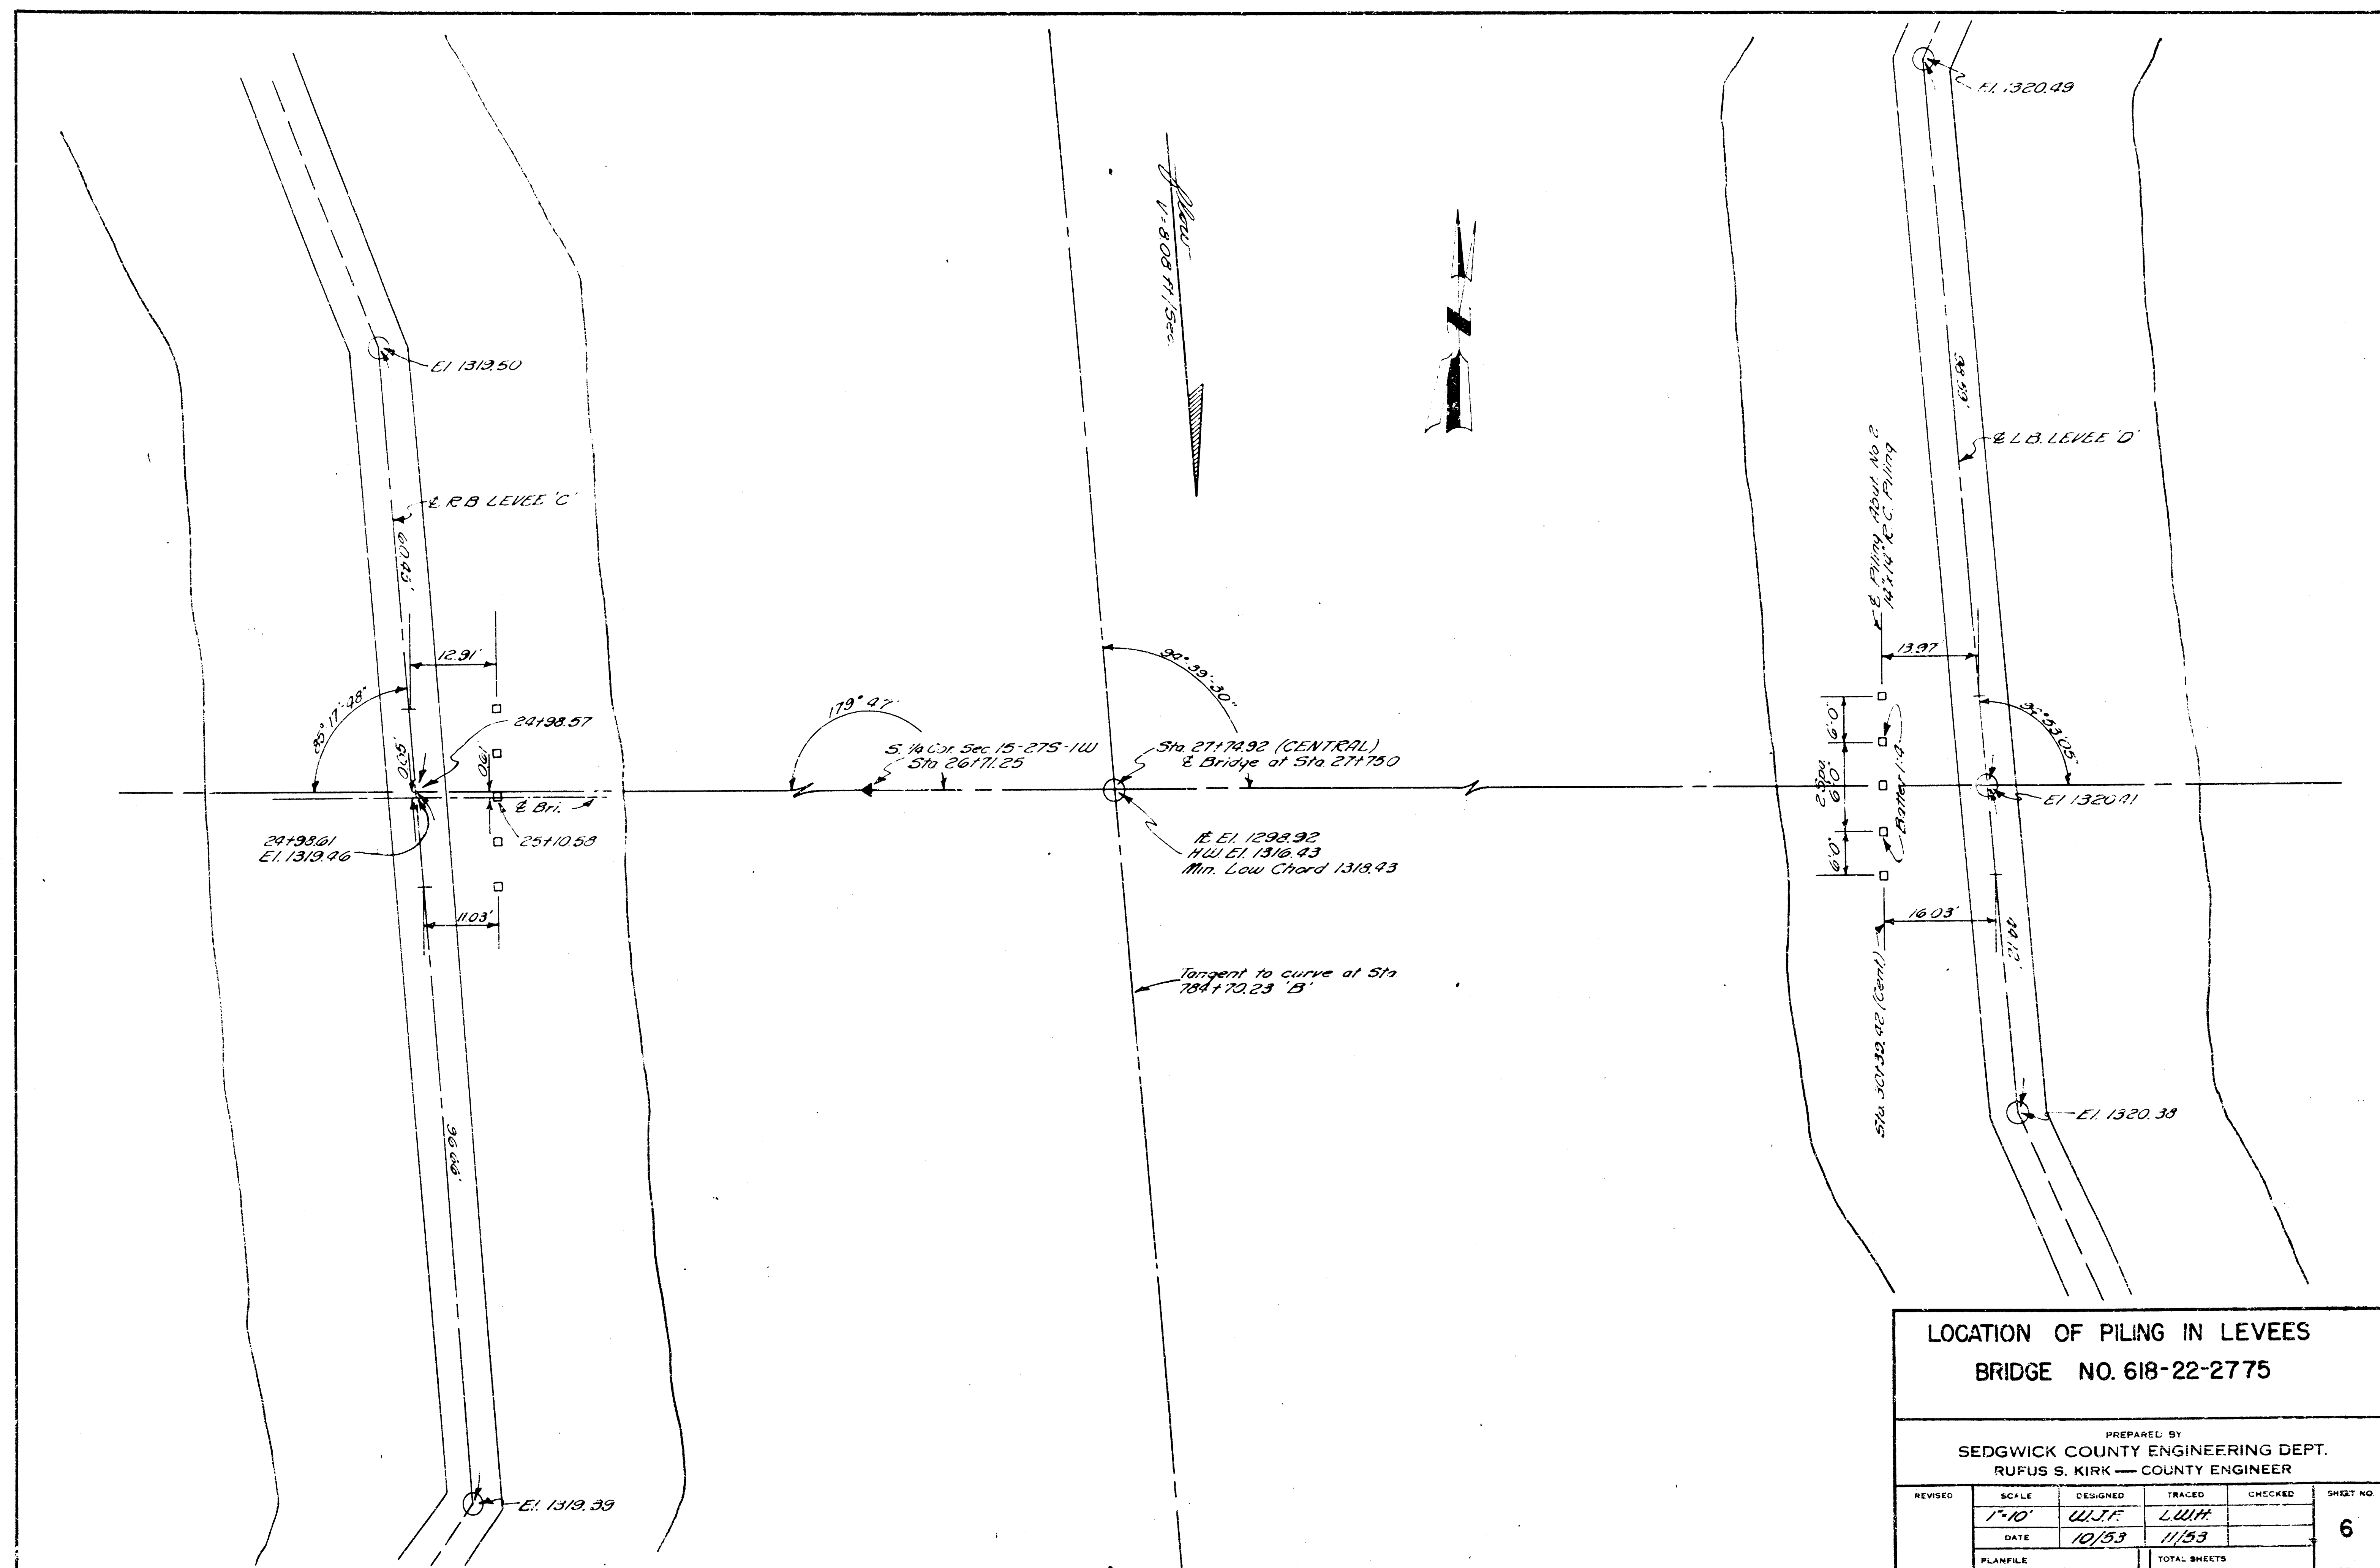


LOCATION OF PILING IN LEVEES				
BRIDGE NO. 618-22-2775				
PREPARED BY SEDGWICK COUNTY ENGINEERING DEPT. RUFUS S. KIRK — COUNTY ENGINEER				
REVISED	SCALE	DESIGNED	TRACED	CHECKED
	1"=10'	W.J.F.	L.W.H.	
	DATE	10/53	11/53	
PLANFILE				TOTAL SHEETS
				6

618-22-2775 6 of 14





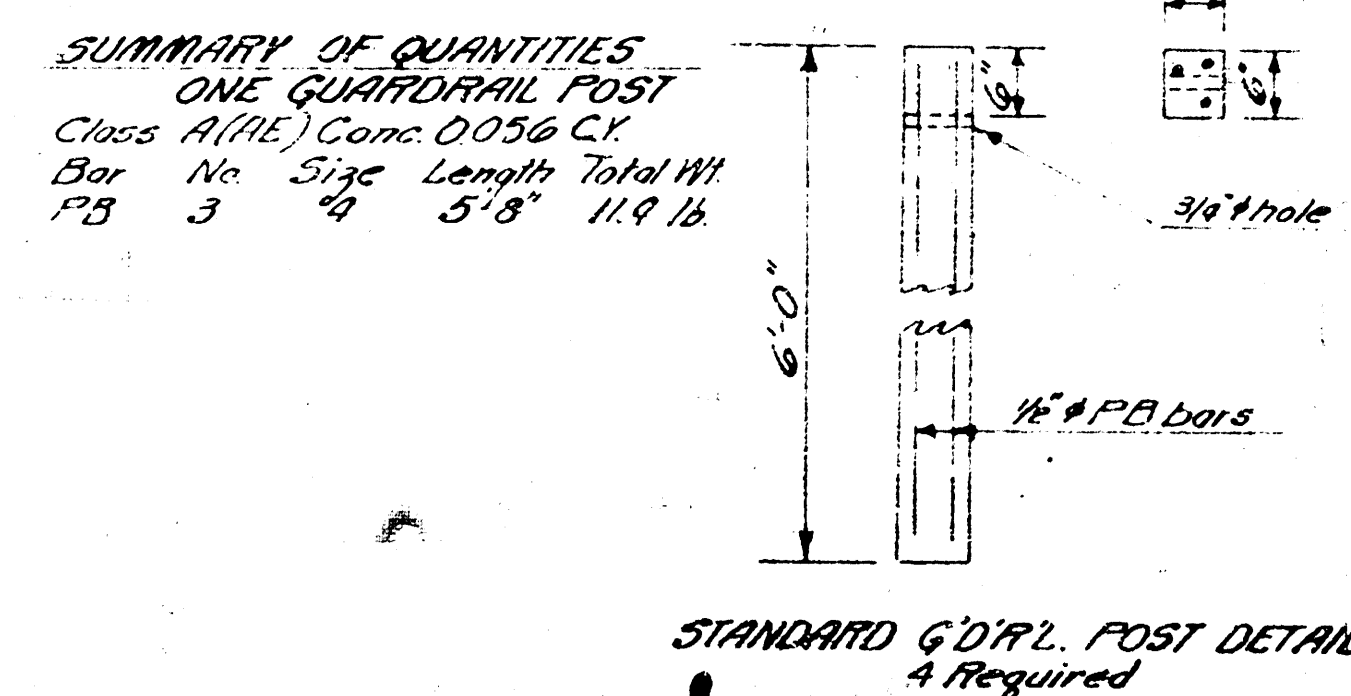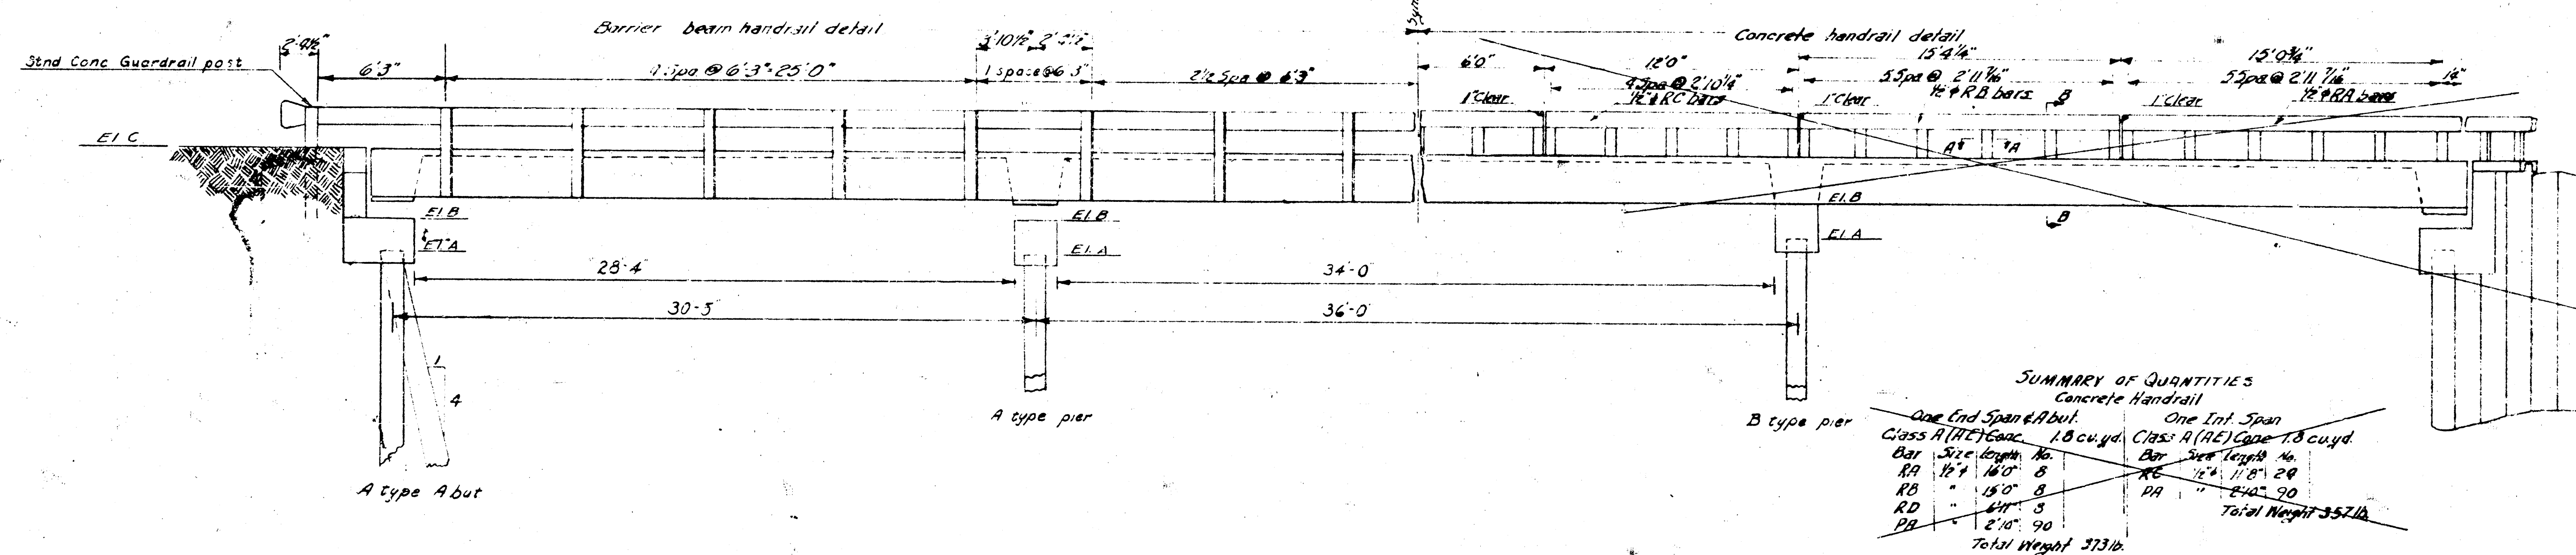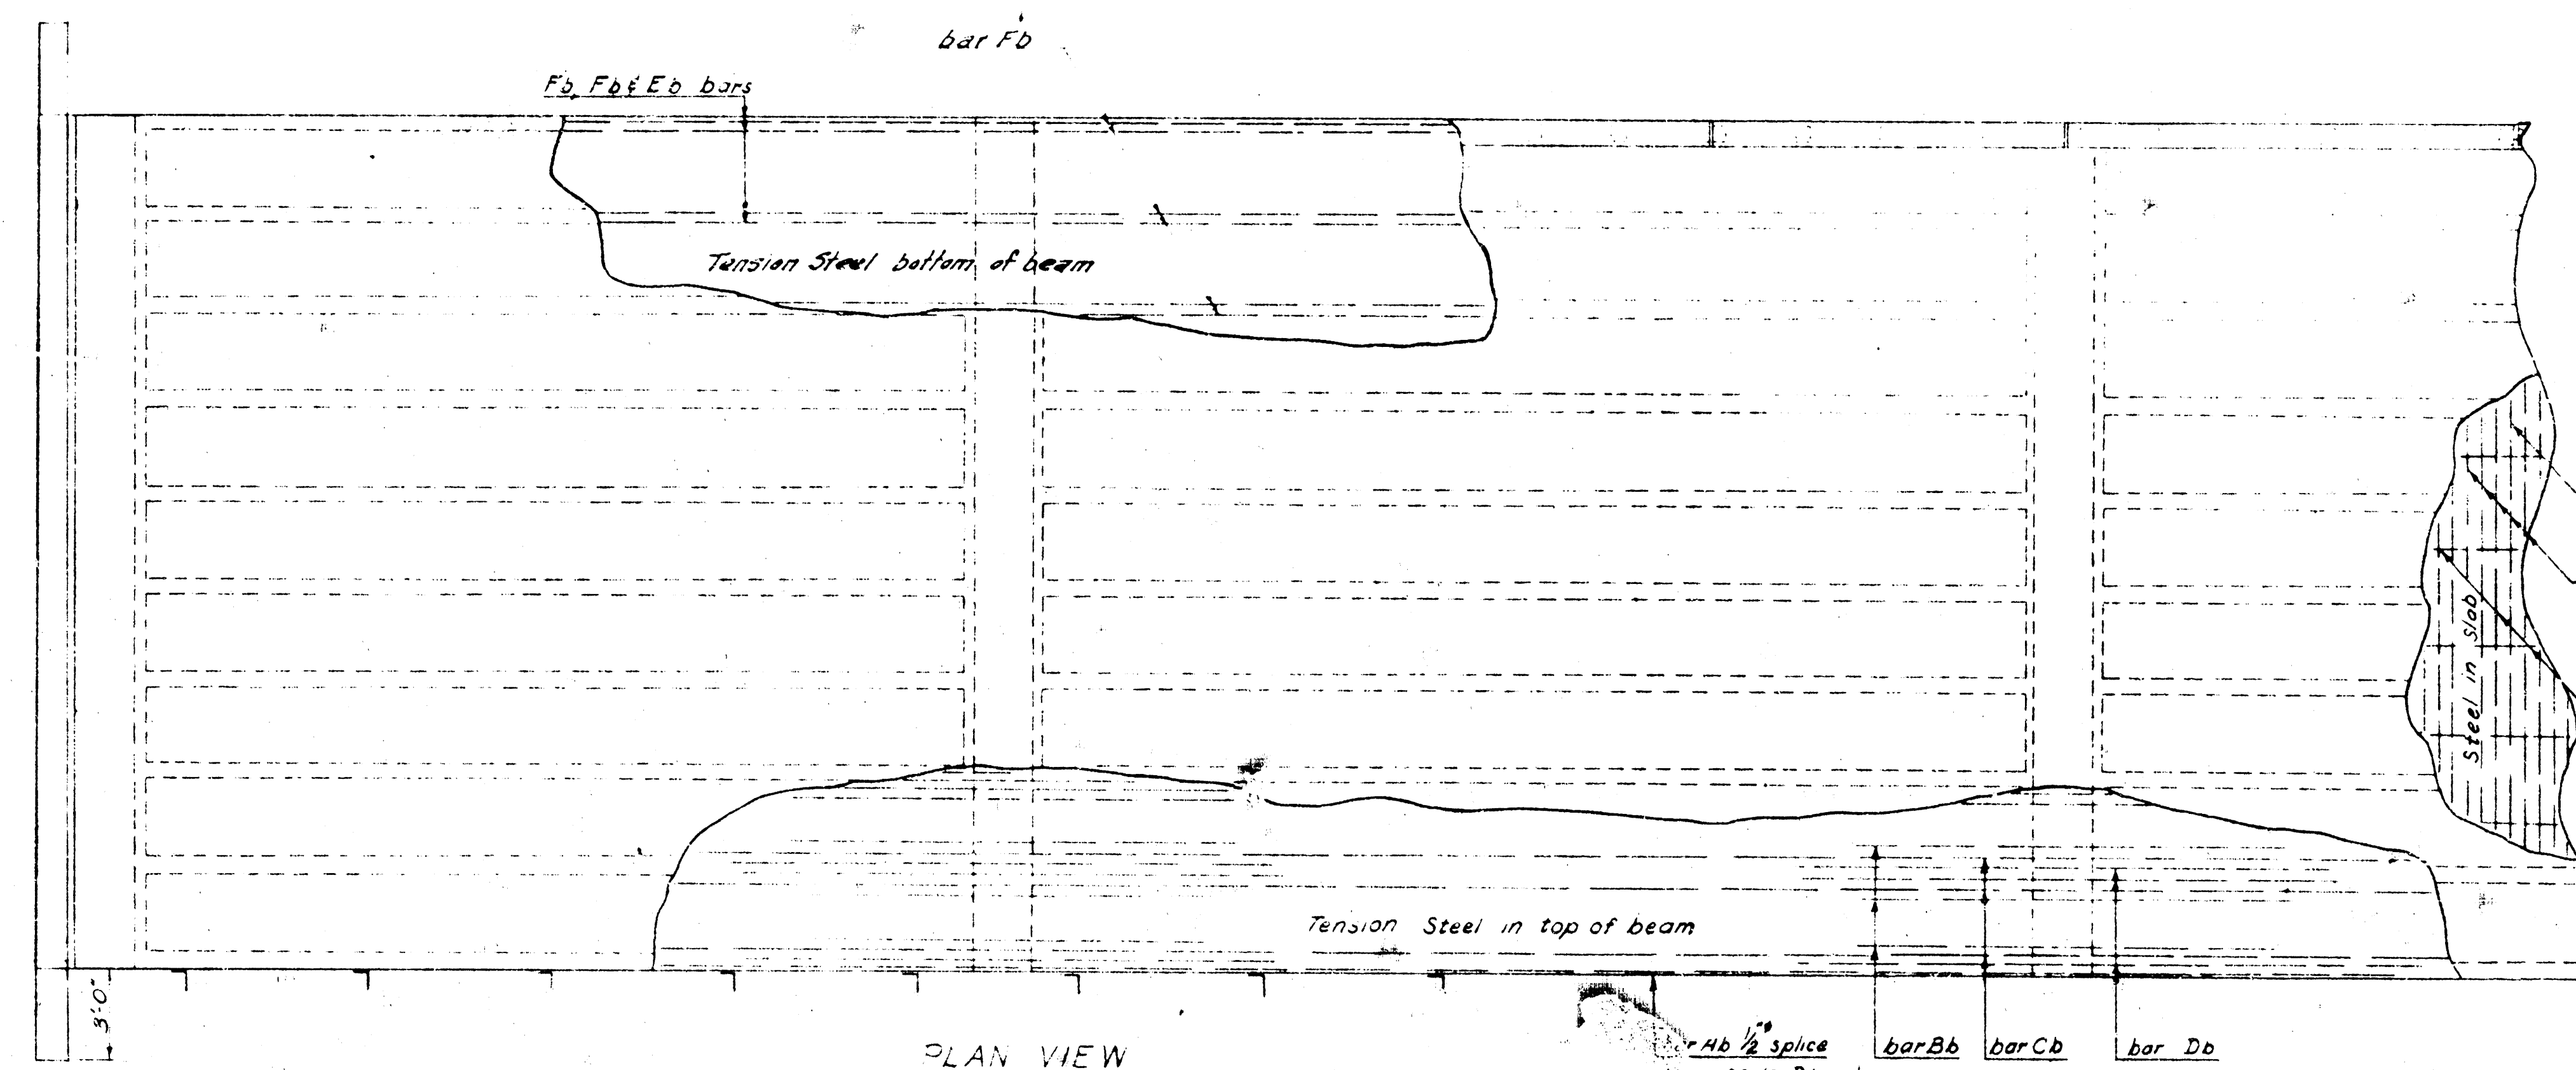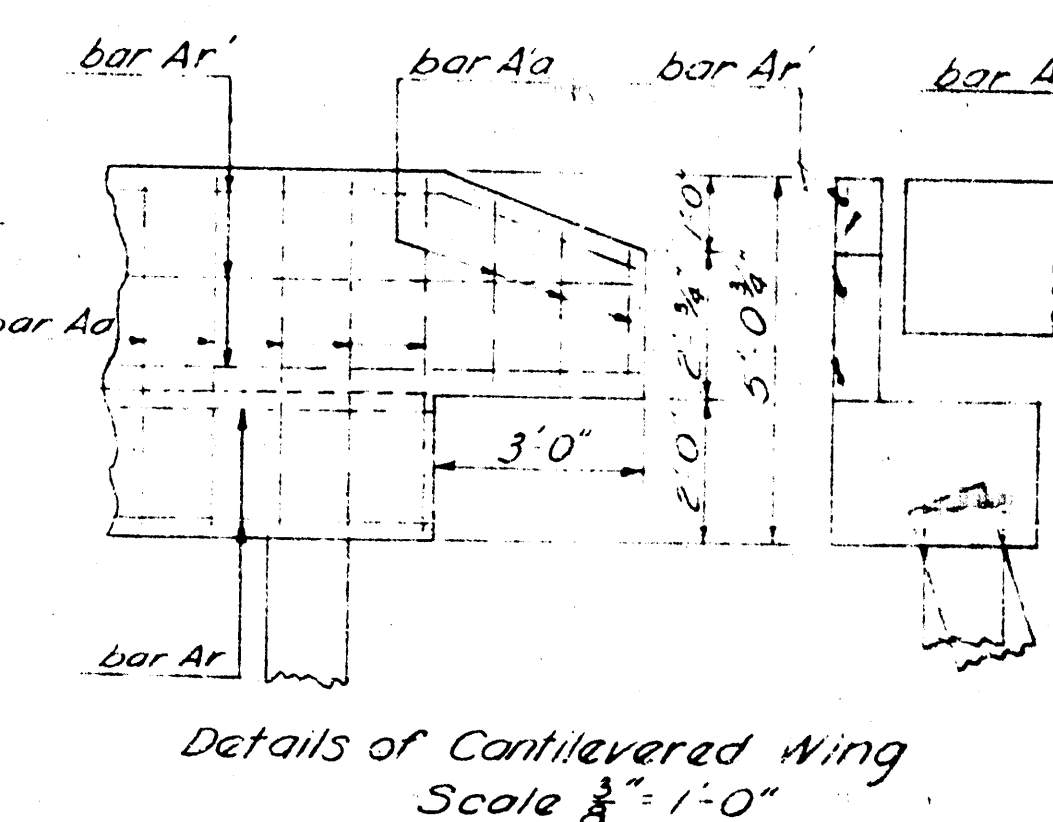

SUMMARY OF QUANTITIES
Concrete Handrail

One End Span & Abut.		One Int. Span	
Class A (RE) Conc.	1.8 cu yd	Class A (RE) Conc.	1.8 cu yd
Bar Size Length No.		Bar Size Length No.	
Total Weight 373 lb		Total Weight 357 lb	

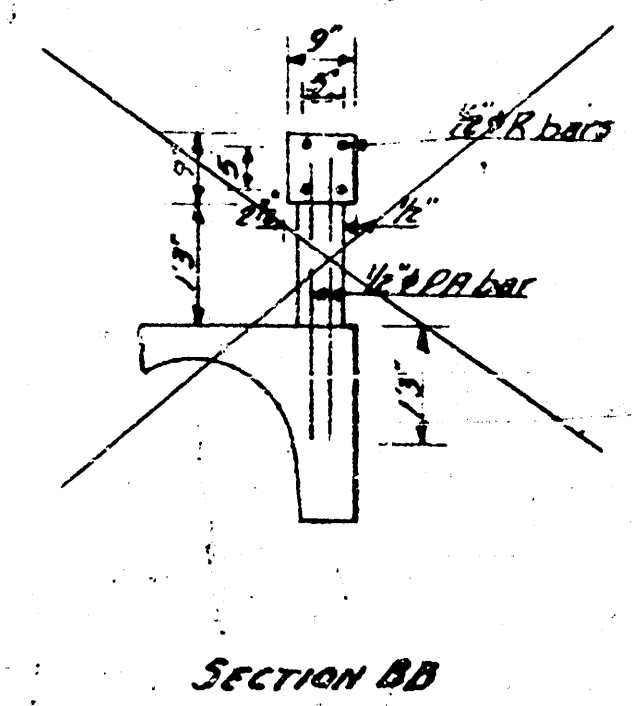
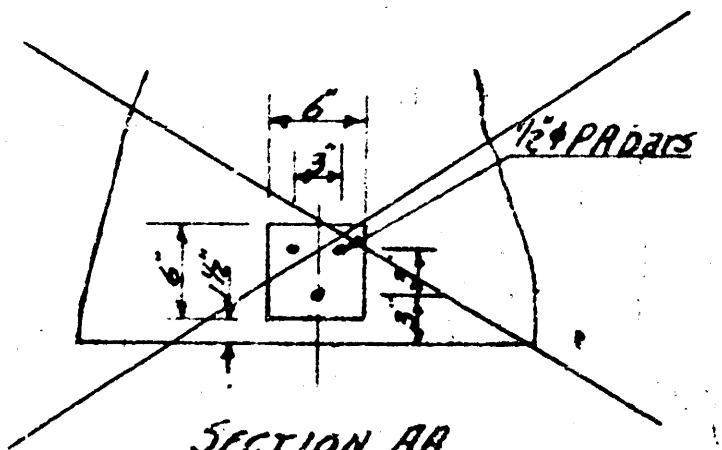


RE. CONC. MODIFIED T-BEAM BRIDGE BRIDGE NO. 618-22-2775

PREPARED BY
 SEDGWICK COUNTY ENGINEERING DEPT.
 RUFUS S. KIRK — COUNTY ENGINEER

REVISION	SCALE	DESIGNED	TRACED	CHECKED	SHEET NO.
1-25 11-53 C.L.P.	1/4" = 1'	R. R. J.	C. D. H.		7
DATE	9-50	9-150			
PLANFILE		TOTAL SHEETS			

618-22-2775

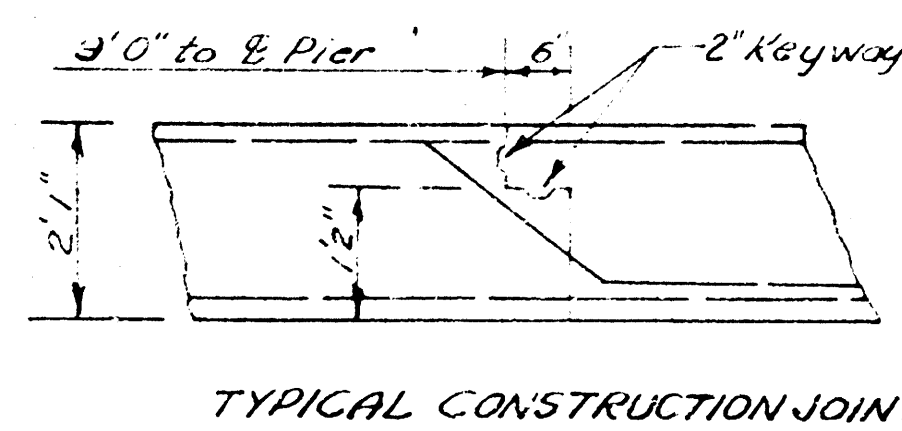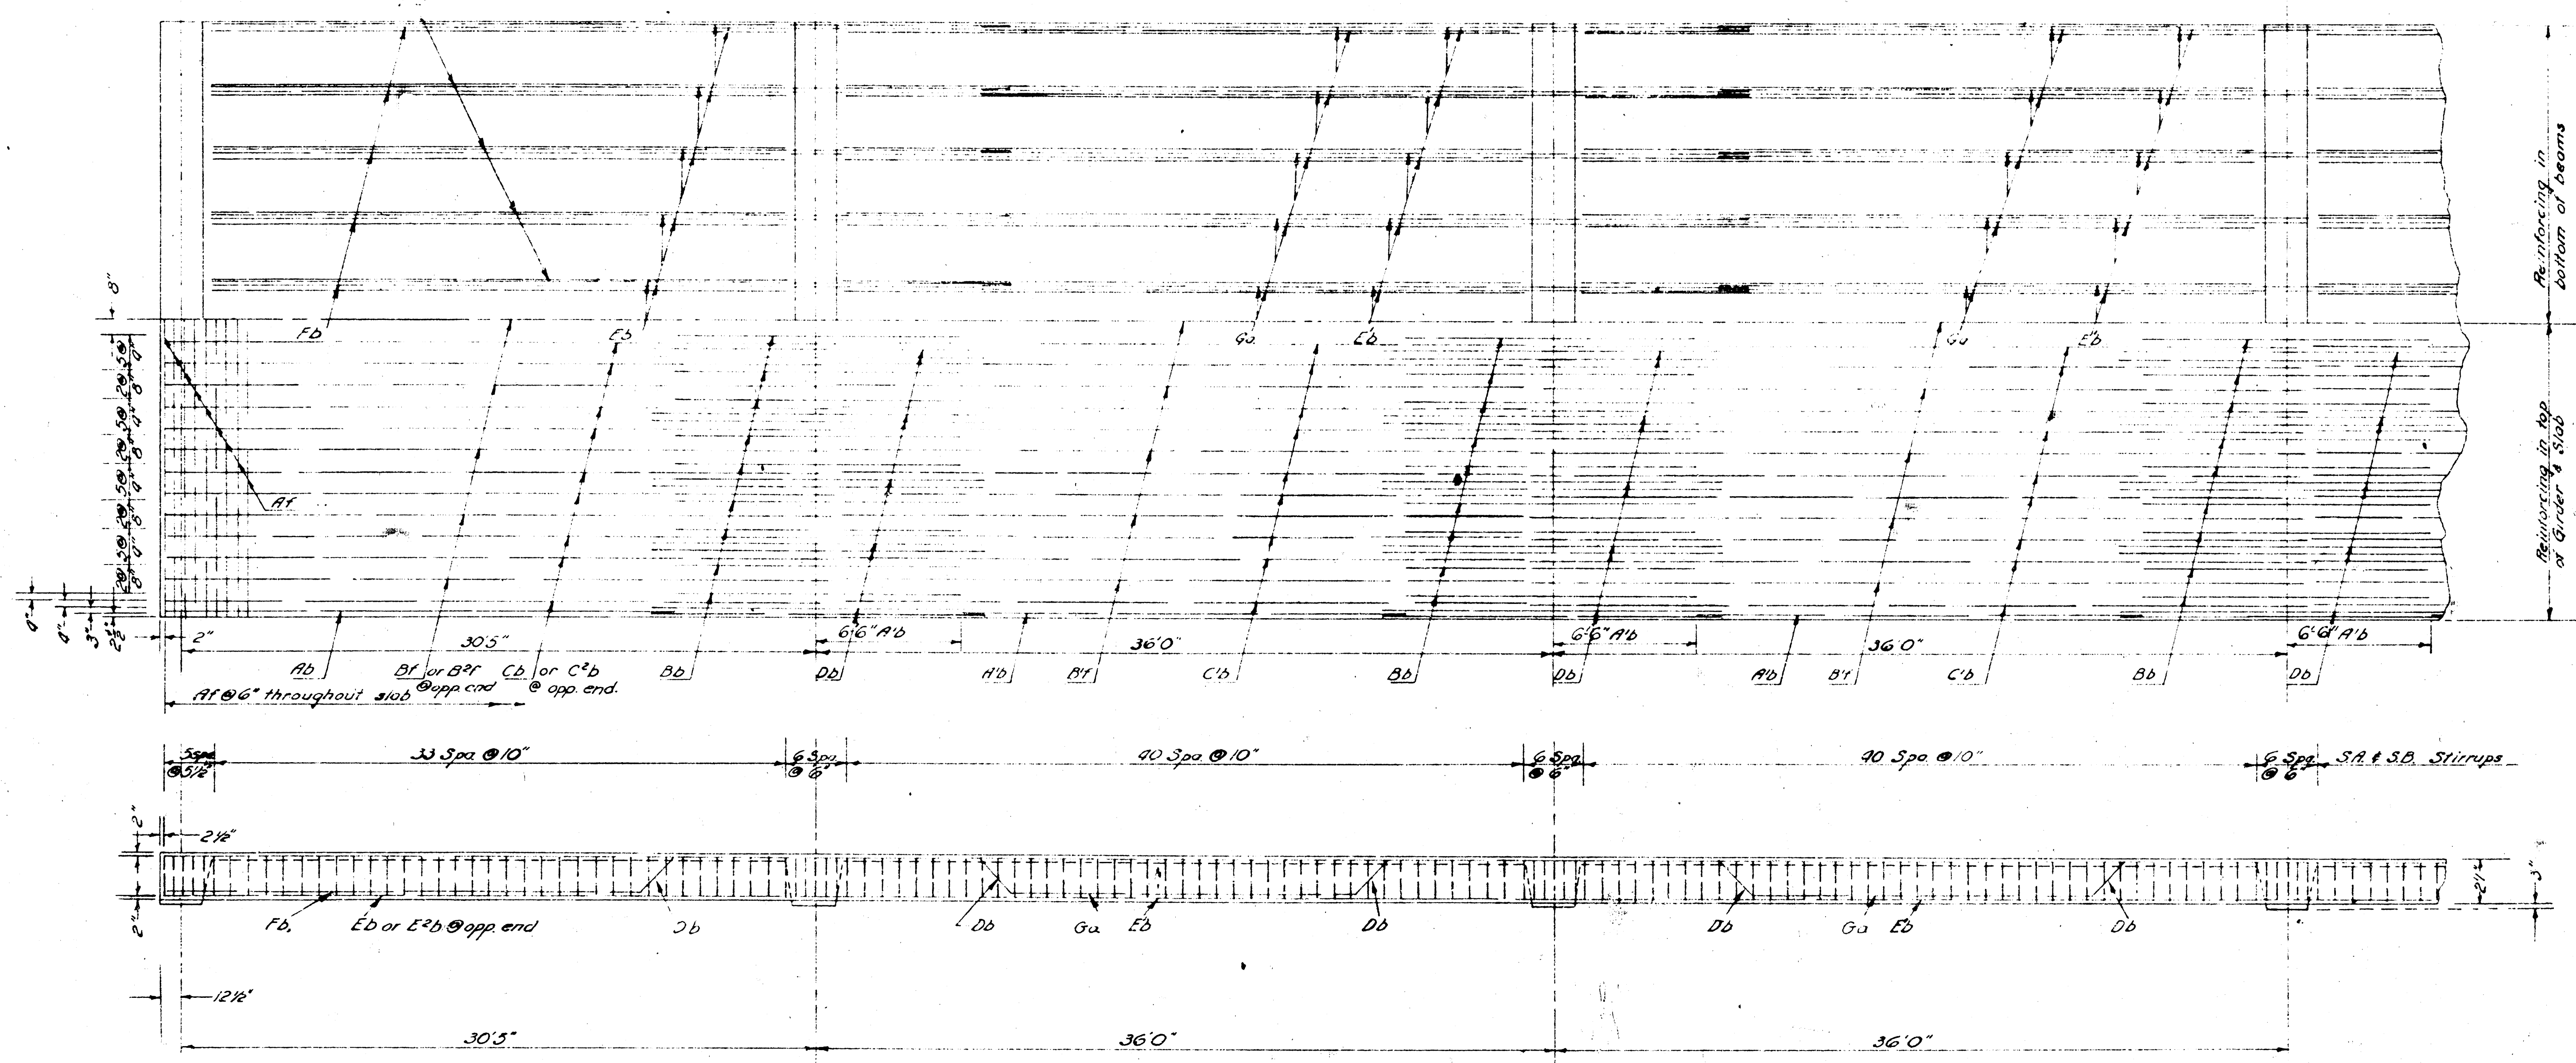

		30'-0" - 13' @ 36'-0" - 30'-0" Continuous Spans		27'-0" Roadway; Metal Handrail	
Bar	No.	A1	A2	B1	B2
Size	No.	10	12	10	12
Length	No.	274	210	274	210
Concrete Class		6515 Cu Wt		Metal Handrail	
Reinforcing Steel		14150 Lb		15690 Lb	
14" x 14" Conc. Piles		3460 Lin. Ft.		Lin. Ft.	
Bearing Devices		7200 Lb		Lin. Ft.	


*Cut 4 bars @ 1'-9"
4 " " 2'-1"
4 " " 2'-5"

REINFORCING DETAIL BRIDGE NO. 618-22-2775


PREPARED BY
SEDGWICK COUNTY ENGINEERING DEPT.
RUFUS S. KIRK — COUNTY ENGINEER

REVISED	SCALE	DESIGNED	TRACED	CHECKED	SHEET NO.
11/18/23	1/4" = 1'-0"	M.E.S.			9
	DATE				
	PLANFILE			TOTAL SHEETS	


618-22-2775 #9 of 12

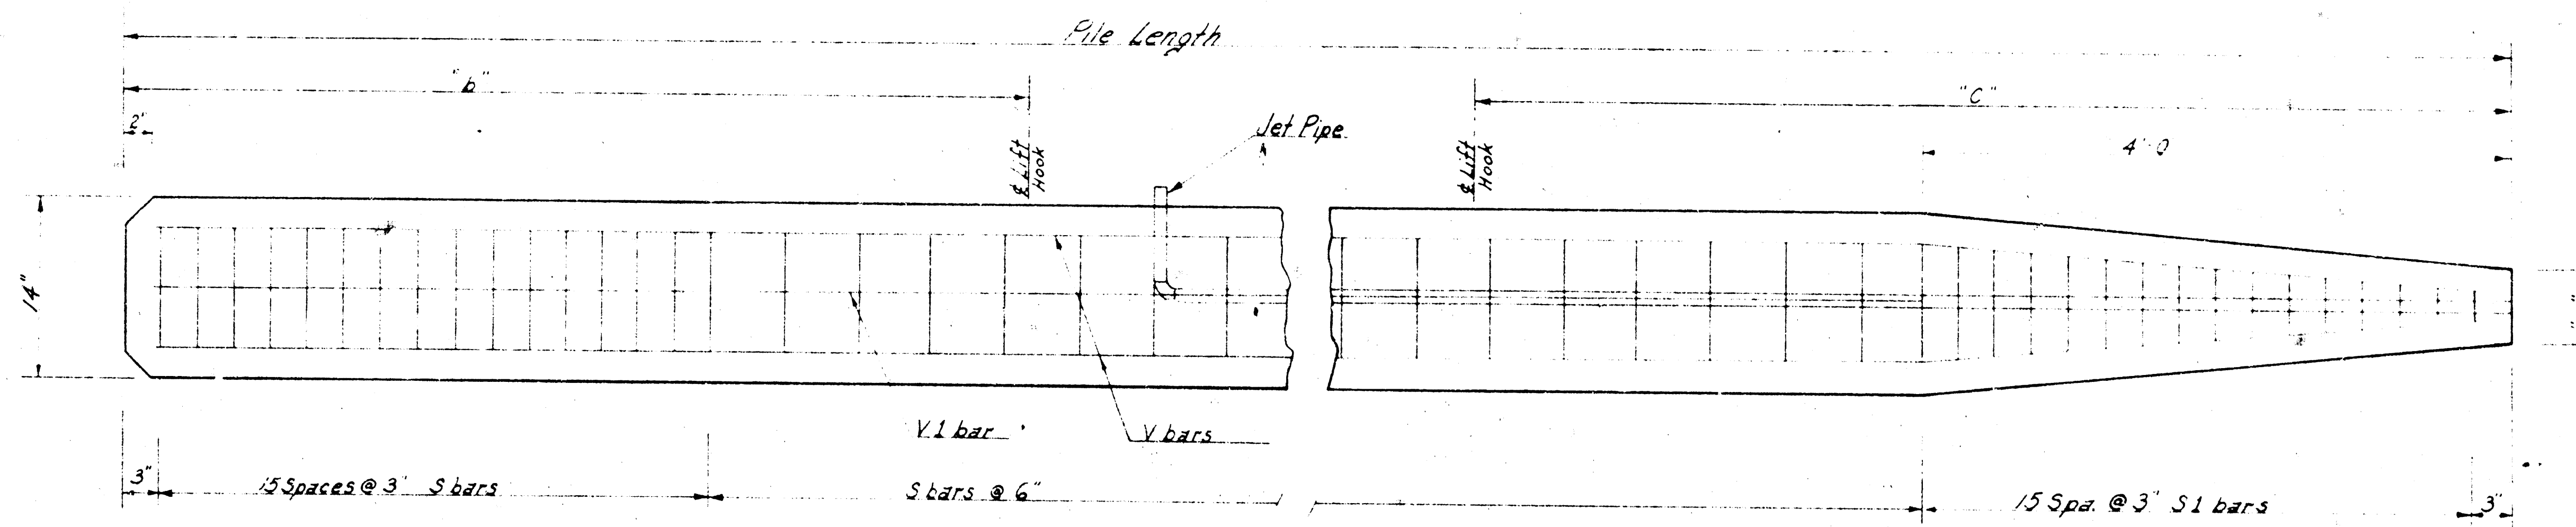


ELEVATION

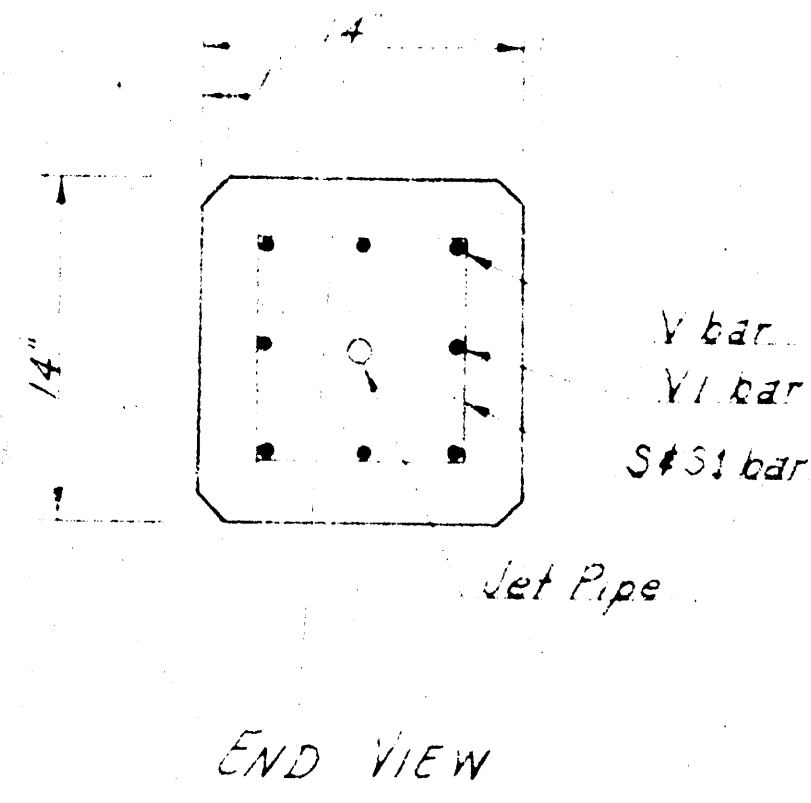


END VIEW

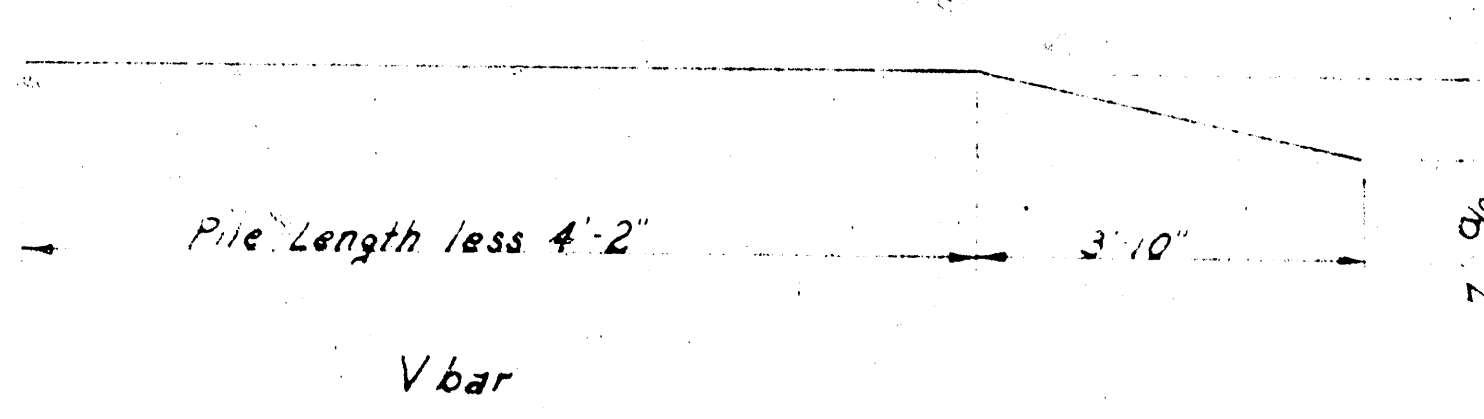

V bar

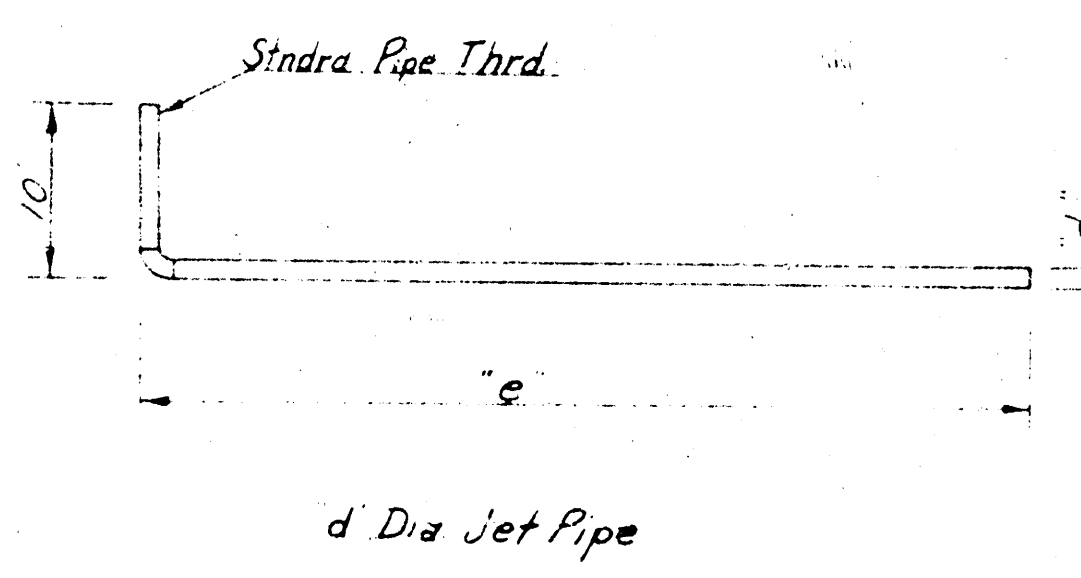


d Dia Jet Pipe

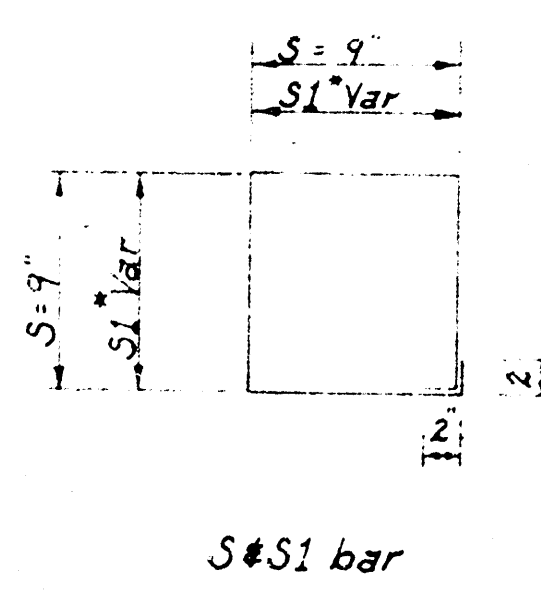

S#51 bar

*S1-15 bars, increase from "X" to "Y" by "Z" increments

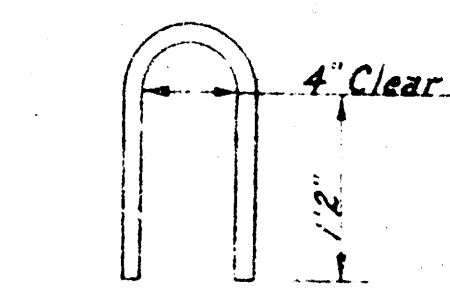

#8 Lift Hook

General Notes

Design: According to ARSNO Specifications, 1949 Edition for 12,000 psi, 10,000 psi Concrete. Use class A throughout if piling are to be encased, or otherwise protected. Use class A(AE) if piling are to form open bent, unless otherwise noted. Reinforcing: All dimensions are to center of bars, unless otherwise noted. Jet Pipe: Standard pipe of Dimensions shown unless otherwise approved by Engineer. Curing: Piling shall be left in forms or otherwise properly cured for at least 7 days. Piling shall not be moved until concrete has attained its design strength or a minimum of 4 weeks after casting. Payment: The cost of material and labor used for casting and driving of piles shall be included in the unit bid for concrete piles. Handling: Piling shall only be lifted by handling hooks or by rigging within 16" of hook location.

Note: Concrete at end of piles shall be removed to expose reinforcing as shown elsewhere on plans. The length for payment of piles shall be as stated in Sect 59.40 of the Standard Specifications of Kansas, 1951 Edition.

	10 req'd			10 req'd			10 req'd		
Pile Length	20'-6"	24'-6"	28'-6"	32'-6"	36'-6"	40'-6"			
Bar	Size Length No.	Size Length No.	Size Length No.	Size Length No.	Size Length No.	Size Length No.			
Y	#7 20'-6" 4	#7 24'-6" 4	#7 28'-6" 4	#7 32'-6" 4	#7 36'-6" 4	#7 40'-6" 4			
Y1	#2 3'-4" 41	#2 3'-4" 49	#2 3'-4" 57	#2 3'-4" 65	#2 3'-4" 73	#2 3'-4" 81			
S	#2 Var 15	#2 Var 15	#2 Var 15	#2 Var 15	#2 Var 15	#2 Var 15			
S1	#2 Var 15	#2 Var 15	#2 Var 15	#2 Var 15	#2 Var 15	#2 Var 15			
Lift Hook	#8 3'-0" 2	#8 3'-0" 2	#8 3'-0" 2	#8 3'-0" 2	#8 3'-0" 2	#8 3'-0" 2			
Jet Pipe									
a	6	6	6	6	6	6			
b	6'-0"	7'-2"	8'-4"	9'-6"	10'-8"	12'-0"			
c	8'-0"	9'-2"	10'-4"	11'-6"	12'-8"	14'-0"			
d									
e									
X, Y, Z	3'-4" to 3'-6" by 3'-4" to 3'-6" by 3'-4" to 3'-6" by 3'-4" to 3'-6" by 3'-4" to 3'-6"								
Concrete	.94 Cu Yds.	1.14 Cu Yds.	1.34 Cu Yds.	1.55 Cu Yds.	1.75 Cu Yds.	1.95 Cu Yds.			
Rebar	207 Lbs.	247 Lbs.	287 Lbs.	327 Lbs.	367 Lbs.	407 Lbs.			


40' 10" 9d		50' 0" 8d					
Pile Length	370"	Size Length No	Size Length No	Size Length No	Size Length No	Size Length No	Size Length No
Bar							
Y	#6 36' 8"	4	#7 48' 8"	4			
Y1	#6 33' 0"	4	#8 45' 0"	4			
S	#2 3' 4"	74	#2 3' 4"	100			
S1	#2 Var 15		#2 Var 15				
Lift Hook	#8 3' 0"	2	#8 3' 0"	2			
Jet Pipe		1		1			
a	10"		6"				
b	10' 10"		1' 10"				
c	11' 11"		15' 10"				
d			1 1/2"				
e			41' 0"				
X, Y, Z	3' 4" to 3' 6" by 4'	3' 10" 8d by 8"					
Concrete	1.82 Cu Yds.	2.43 Cu Yds.					
Rebar	182 Lbs	256 Lbs	95%	10d			

14"x14"x Re. Conc. Piling
BRIDGE NO. 618-22-2775
& 618-22-1856

PREPARED BY
SEDGWICK COUNTY ENGINEERING DEPT.
RUFUS S. KIRK — COUNTY ENGINEER

REVISION	SCALE	DESIGNED	TRACED	CHECKED	SHEET NO.
		Schwab	Hausman		10
		12-51	1-52		
TOTAL SHEETS					

618-22-2775 #10 of 10

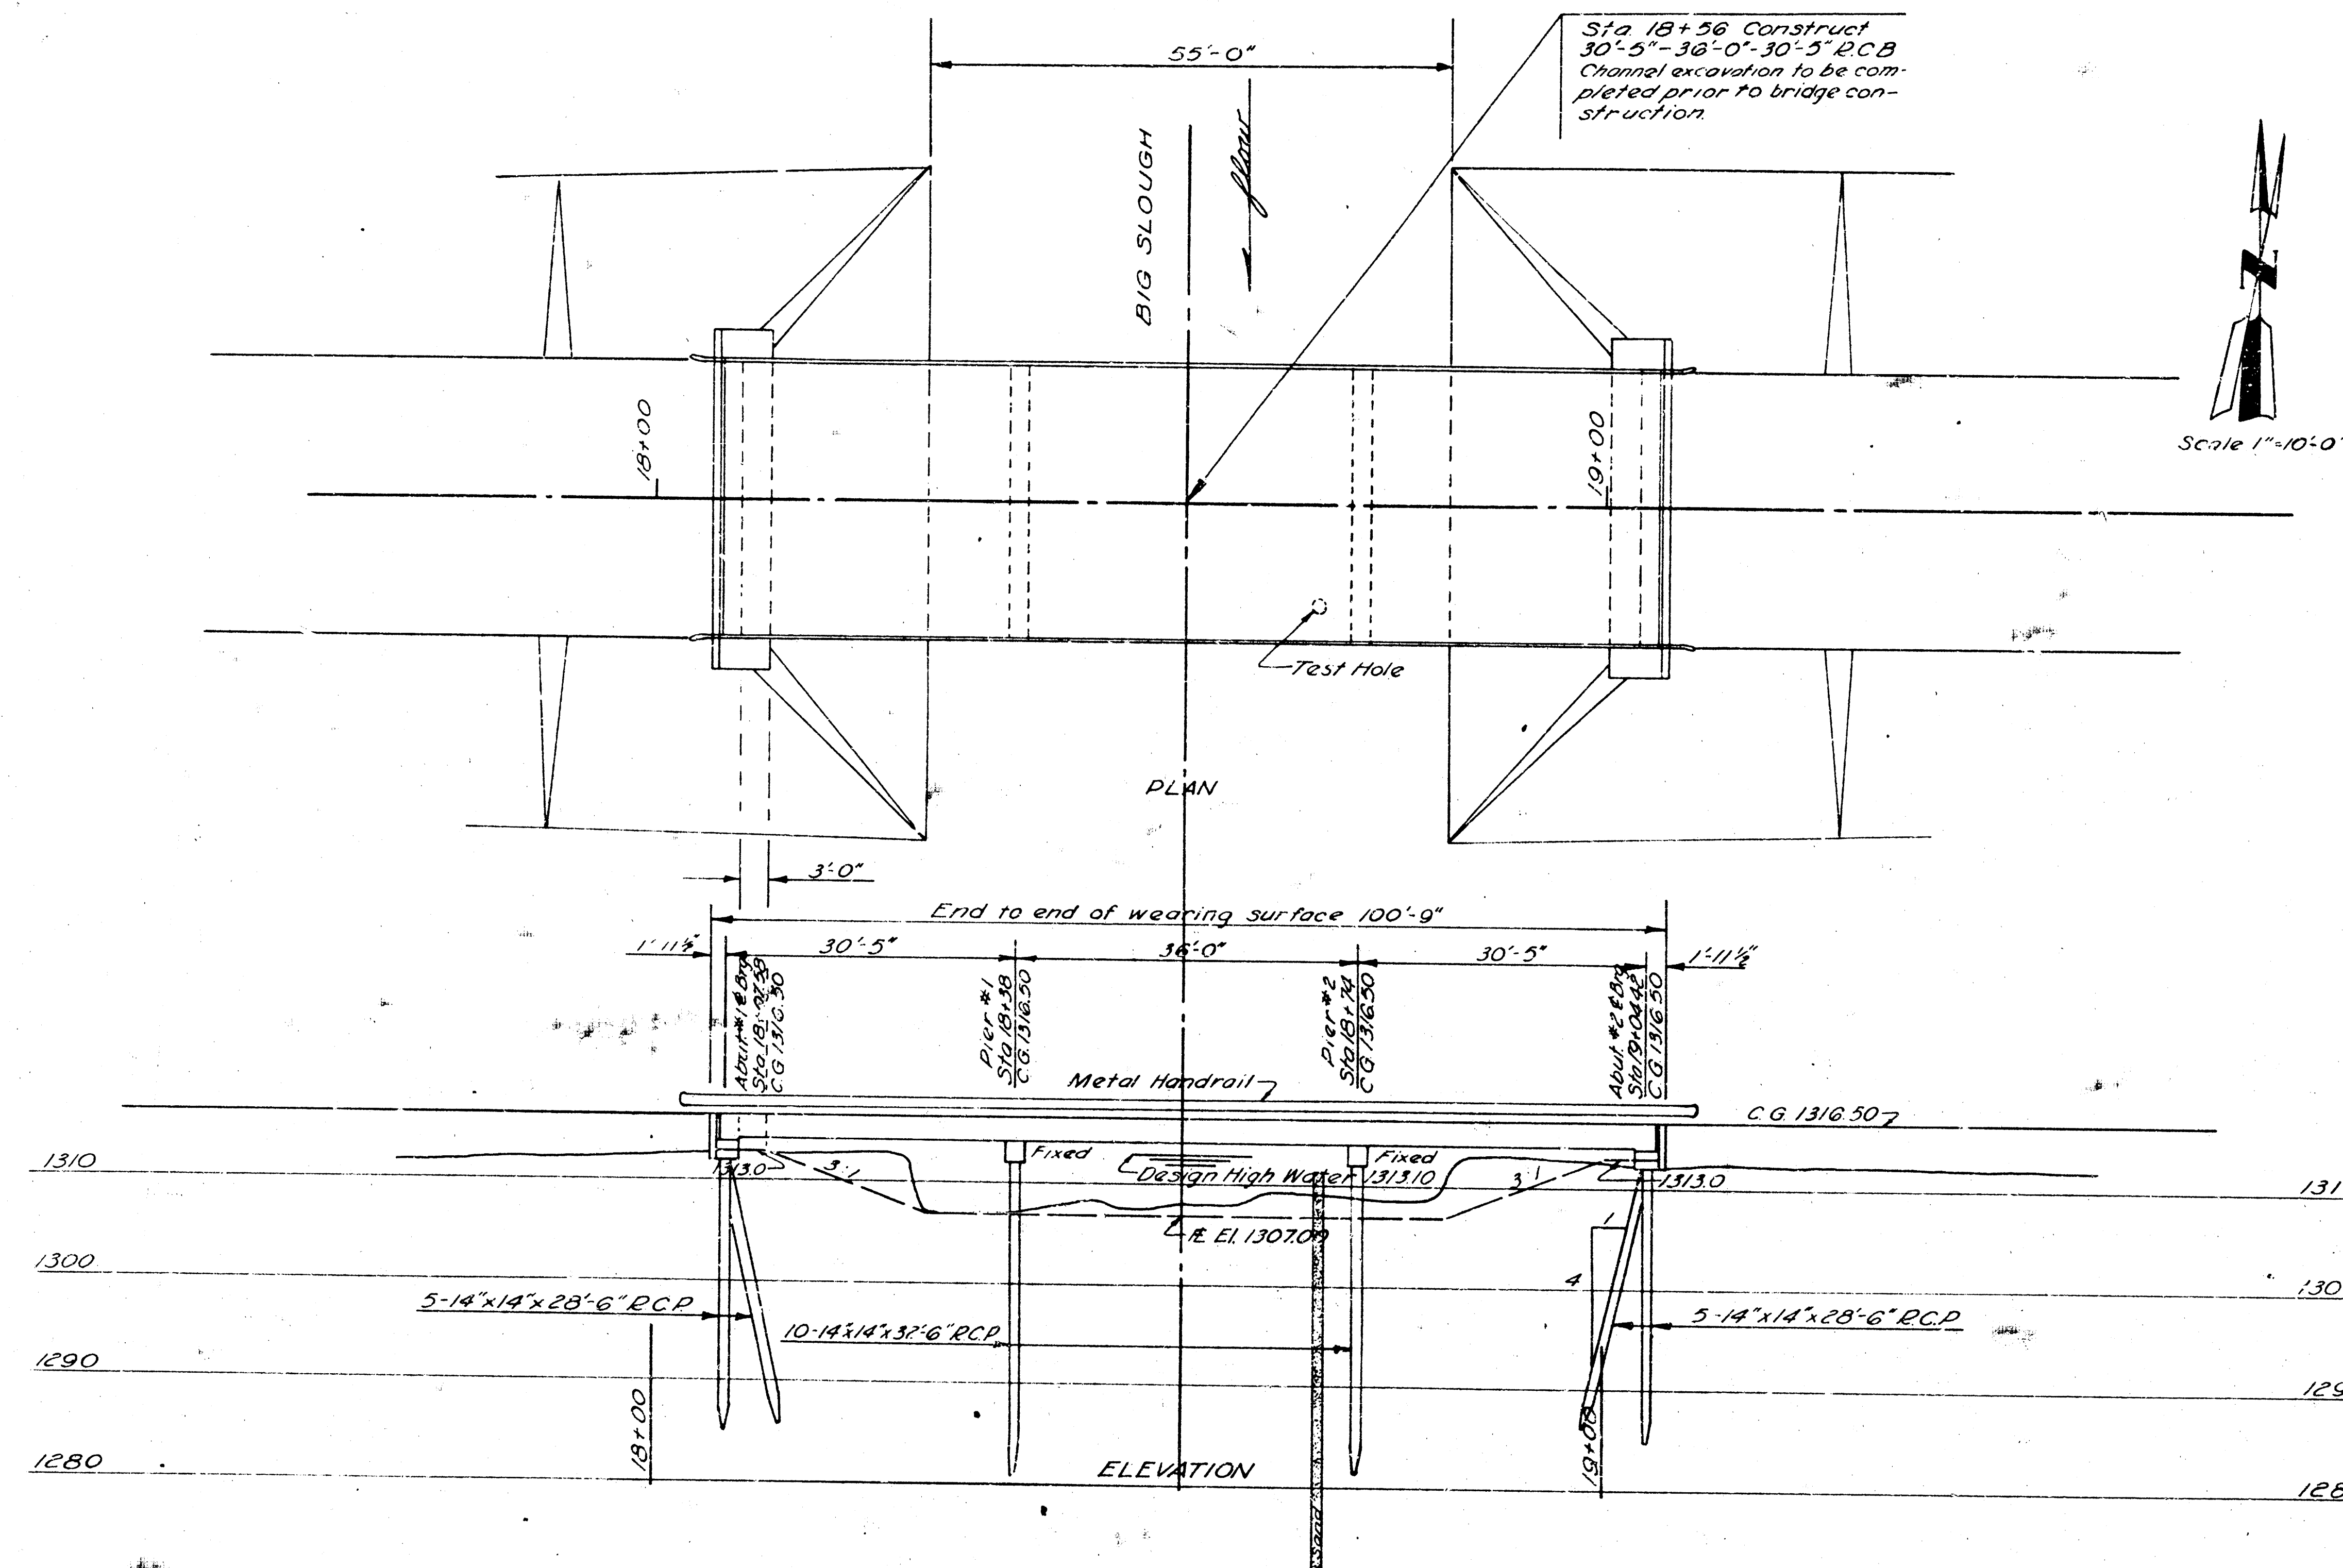

GENERAL NOTES

Design: According to A.A.S.H.O. Specifications, Edition of 1949, 1120-44. Loading: 15,000 psi, 10,000 psi.

Soundings Taken by Sedgwick County with 1/4" jet.

Piling: Concrete Piling to be driven to a computed resistance of 25 tons per pile.

Concrete: Use Class A(AE) concrete, thruout. Bevel all exposed edges with a 1/4" triangular moulding.

Forms: Contractor shall use preformed metal forms owned by SEDGWICK COUNTY.

Embankment: To be constructed by SEDGWICK COUNTY or others. No earthwork is to be considered a part of this project except at pier and abutment locations-the cost of which is to be included in the unit price bid for piling.

GENERAL CONSTRUCTION NOTES

Timber cribbing at the centerline of each span on this project will be required.

Two sets of short forms and five sets of long forms are available for these projects. Since the concrete must full span ahead of any forms to be removed must have attained its design strength before removal of these forms it is suggested that high early strength concrete be used.

Forms for these projects shall be picked up by the contractor at the Sedgwick County Yards, 1021 Stillwell, Wichita, and returned to this location unless otherwise instructed by the Engineer. (See "Special Provisions" in Specifications and Proposals Book, etc.)

The wearing surface and all other exposed surfaces of wings, caps, abutments, and piling shall be cured and protected in accordance with Sec. 5048 of the Standard Specifications for State Road Bridge Construction, Edition of 1951. As an alternate, a paraffin base curing compound applied immediately after finishing of concrete, and covered with dry burlap, or any suitable material satisfactory to the Engineer in charge, for a minimum of 72 hours may be used.

D.A. 30 Square Miles C.O. 25
Waterway provided 414 sq ft

CONSTRUCTION LAYOUT **BRIDGE NO. 618-22-1856**

PREPARED BY
SEDGWICK COUNTY ENGINEERING DEPT.
RUFUS S. KIRK — COUNTY ENGINEER

REVISED	SCALE	DESIGNED	TRACED	CHECKED	SHEET NO.
	1"=10'	W.J.F.	C.J.F.		11
	DATE	11-53	11-53		
	PLANFILE		TOTAL SHEETS		

618-22-1856 Sh. # 11 of 14

