


PLAN	DATE
PROJECT NO.	
DATE	
BY	
CHECKED	
APPROVED	

PROFILE	DATE
PROJECT NO.	
DATE	
BY	
CHECKED	
APPROVED	

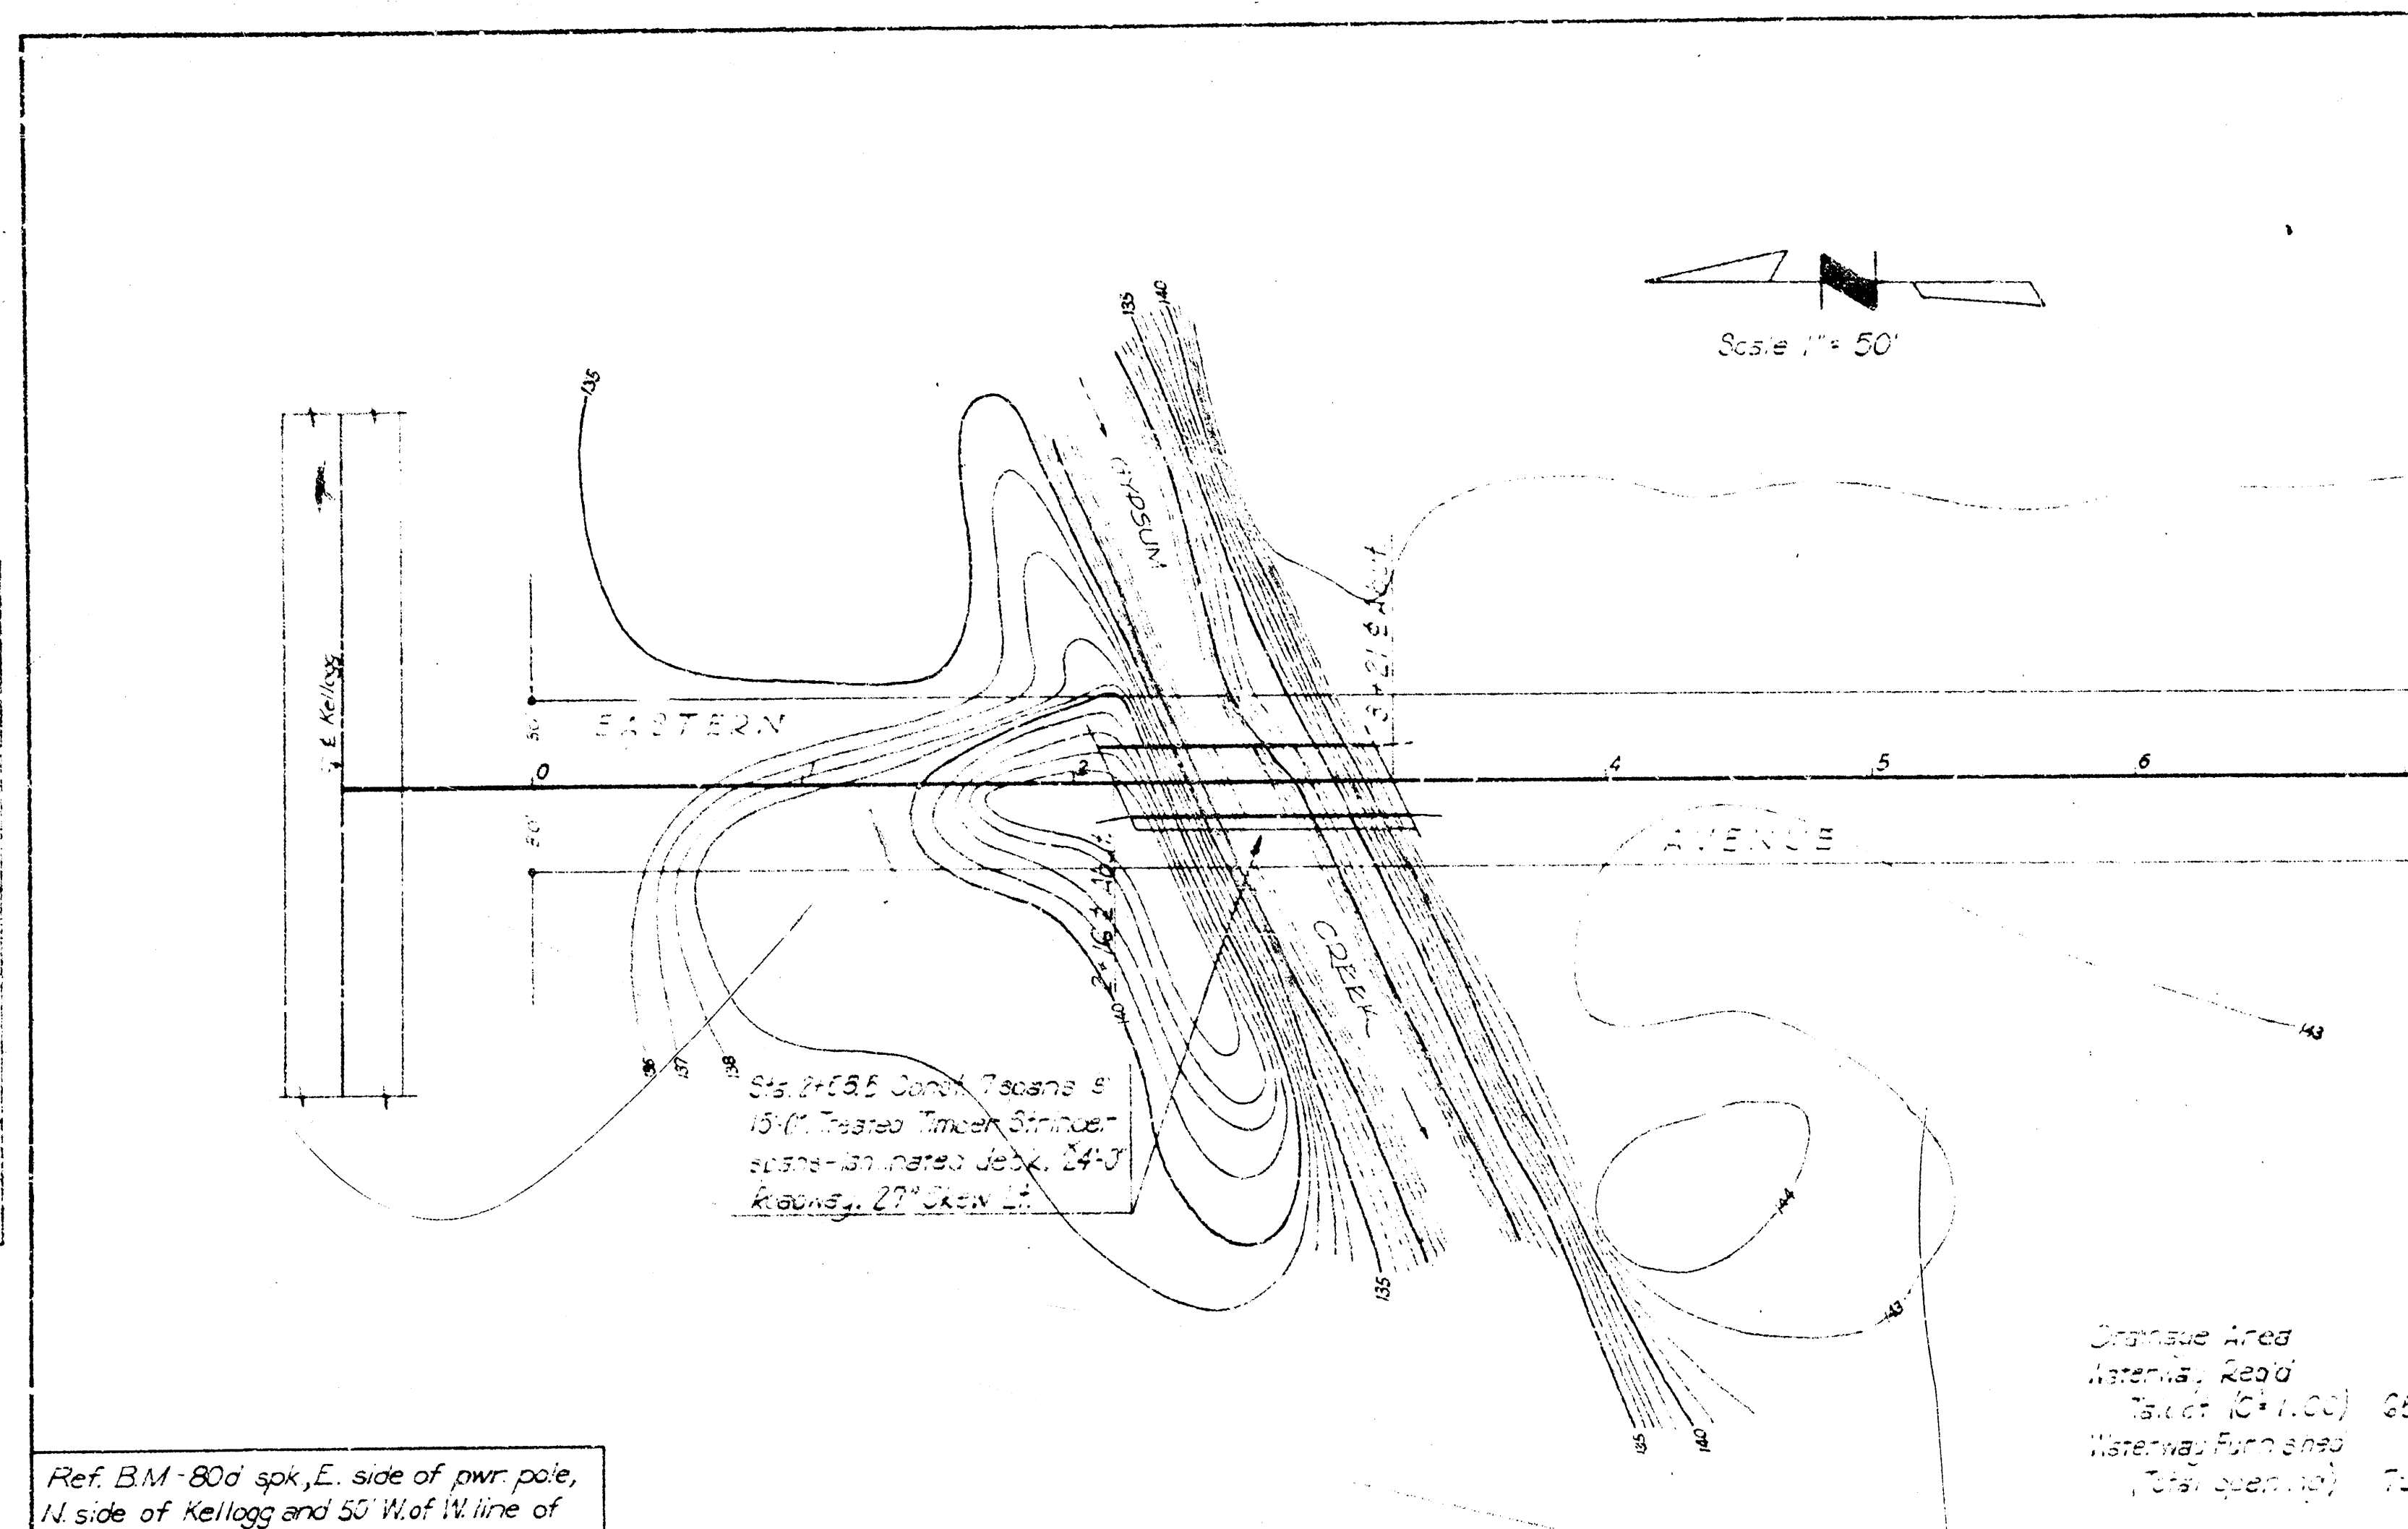

Station	Pier #1	Pier #2	Pier #3	Pier #4	Pier #5	Pier #6	Station
1+55.00	1+58.00	1+61.00	1+64.00	1+67.00	1+70.00	1+73.00	1+76.00

PILE LENGTHS AS DRIVEN

BRIDGE FOR WM. LEVITT
WICHITA, KANSAS
CONTOUR MAP & PROFILE

D. B. DELAMATER
CONSULTING ENGINEER
WICHITA, KANSAS
(CONSTRUCTED - DECEMBER, 1954)




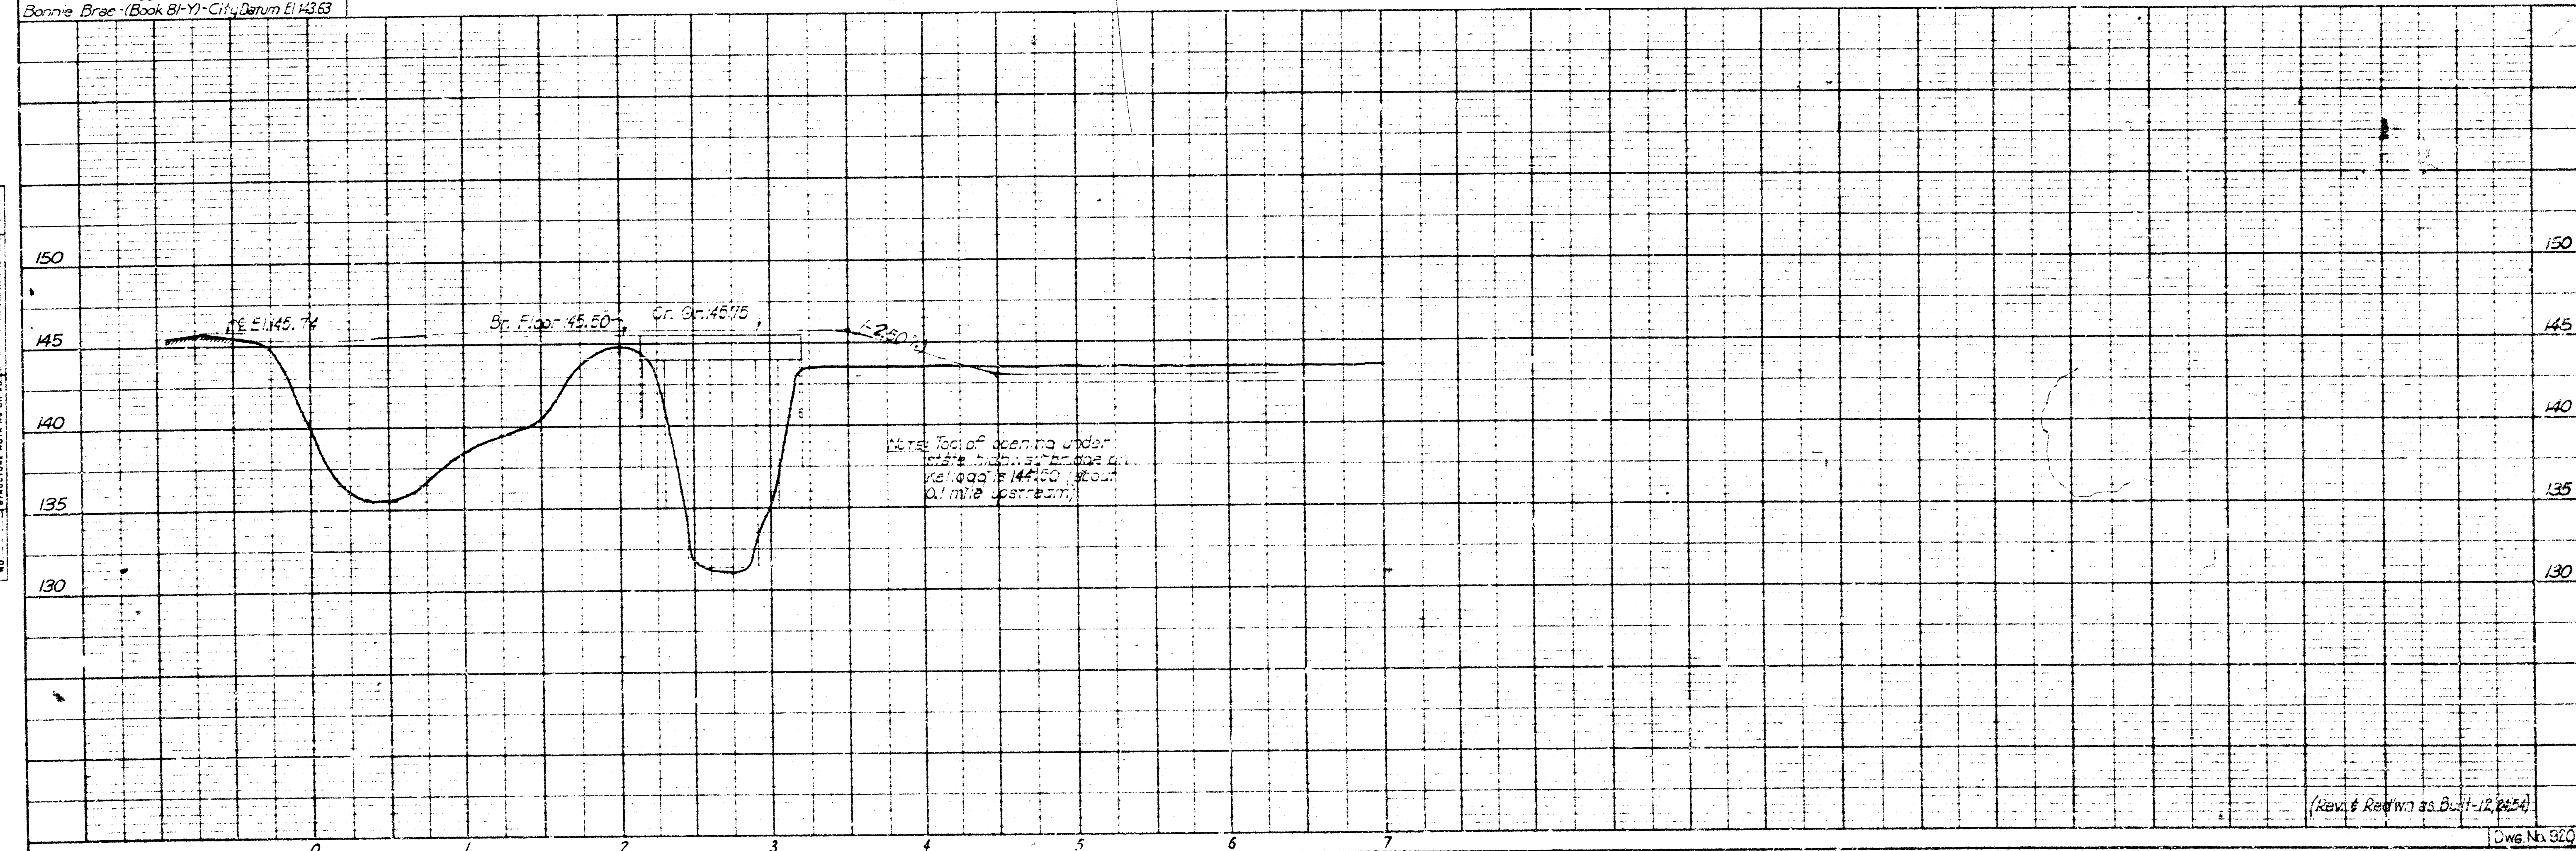


PLATE 1. PLAN & PROFILE & PILE DRIVEN




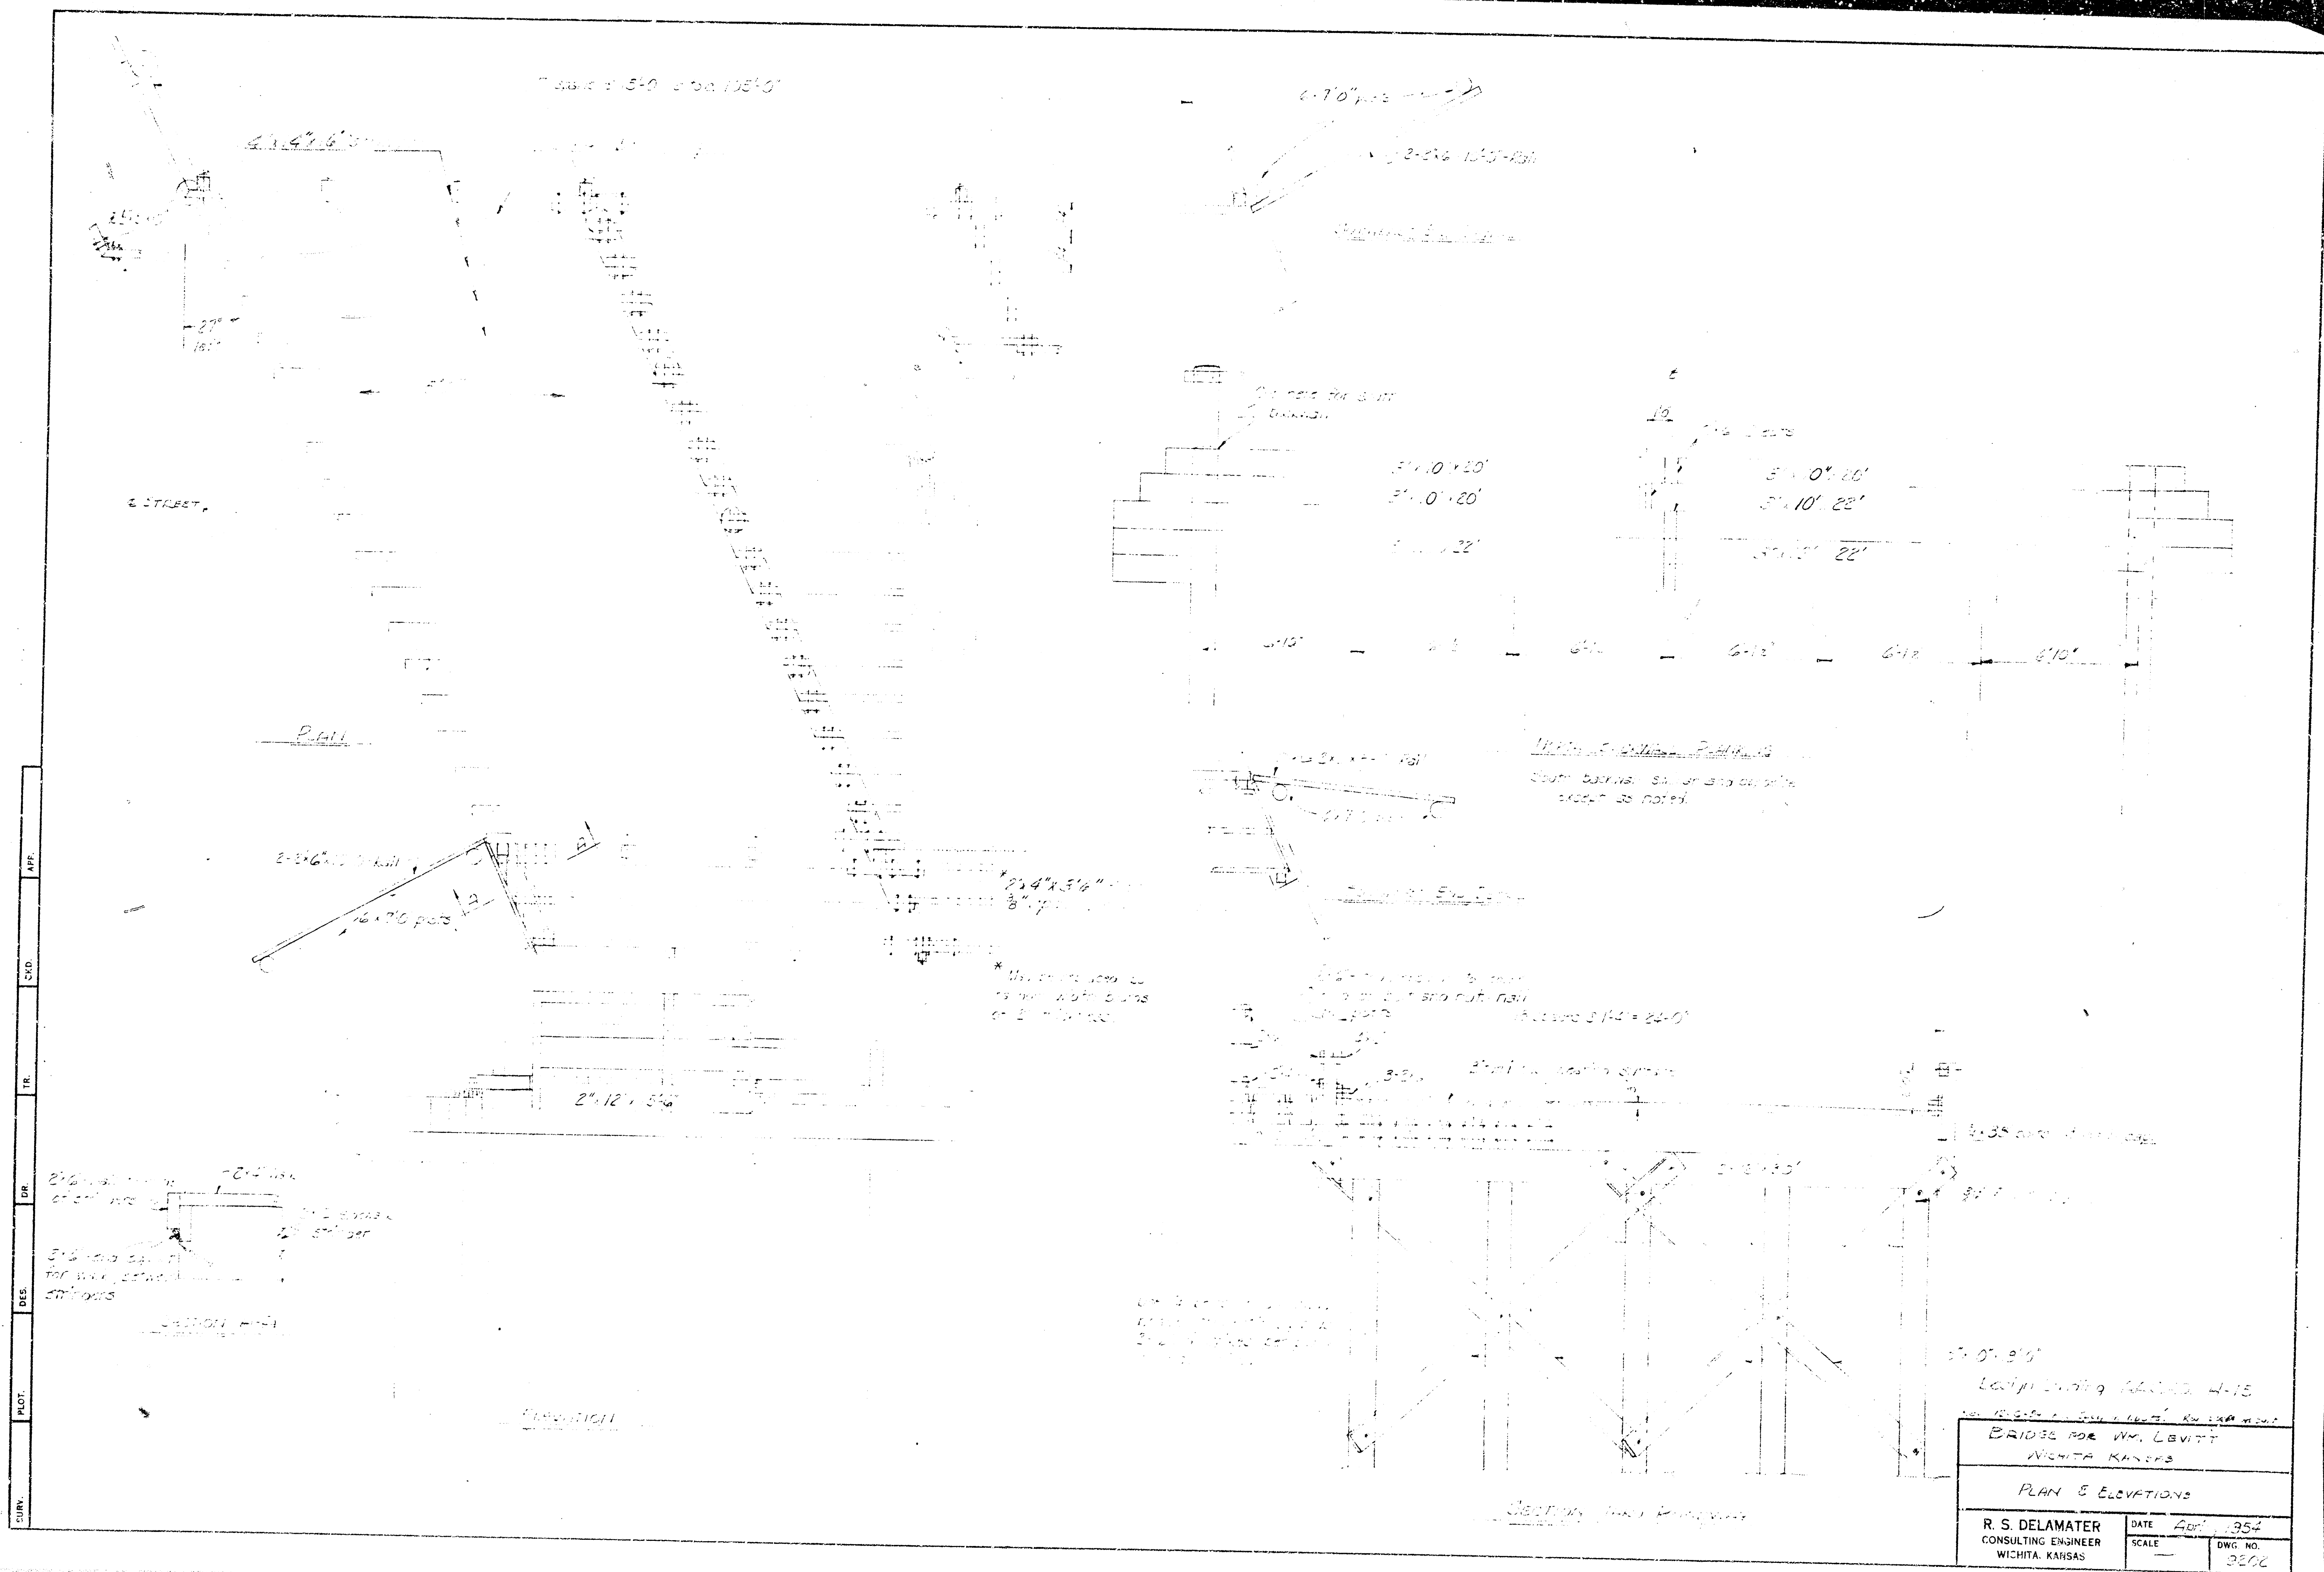

 


BRIDGING DETAIL

NUMBER OF SPICES
PRODUCED IN THE COUNTRY

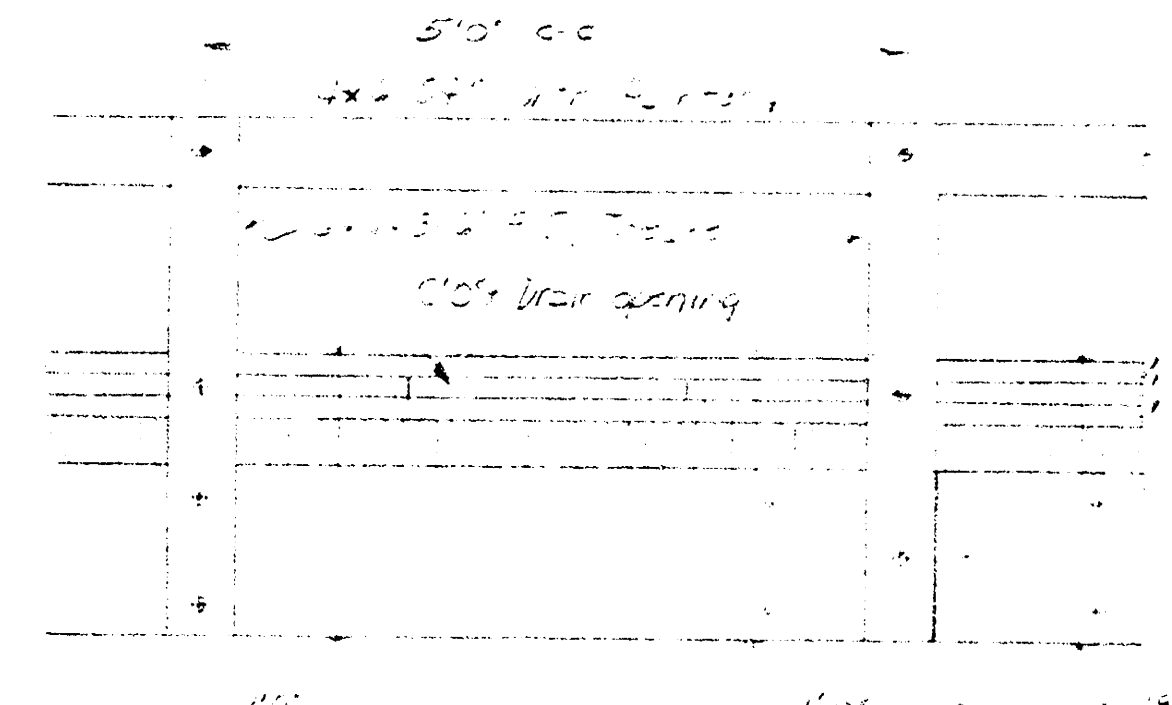

CURB & GUARDRAIL DETAILS

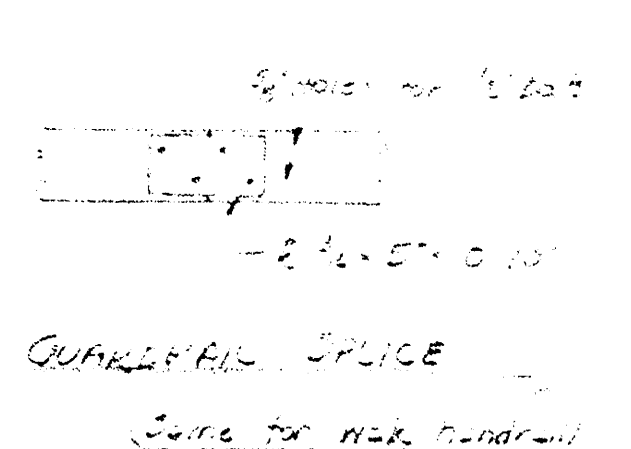


1st floor ceiling too high with 20d
nails to attempt to strengthen, staggered
from bottom to bottom, nail boards to
center to center. 18" x 6 staggered
boards to bottom.


PLATE SECTION 3: PLACET SET


Pipe Corrosion

There are no more
creosote in the
wood of the

Wings fixed to the

[Handwritten note:]

Not more than




[illegible]

BRIDGE FOR AM. LIGHT		
WICHITA, KANSAS		
MISCELLANEOUS DETAILS		
R. S. DELAMATER CONSULTING ENGINEER WICHITA, KANSAS	DATE	April, 1954
	SCALE	DWC NO.
	3/4" = 1'	9203