
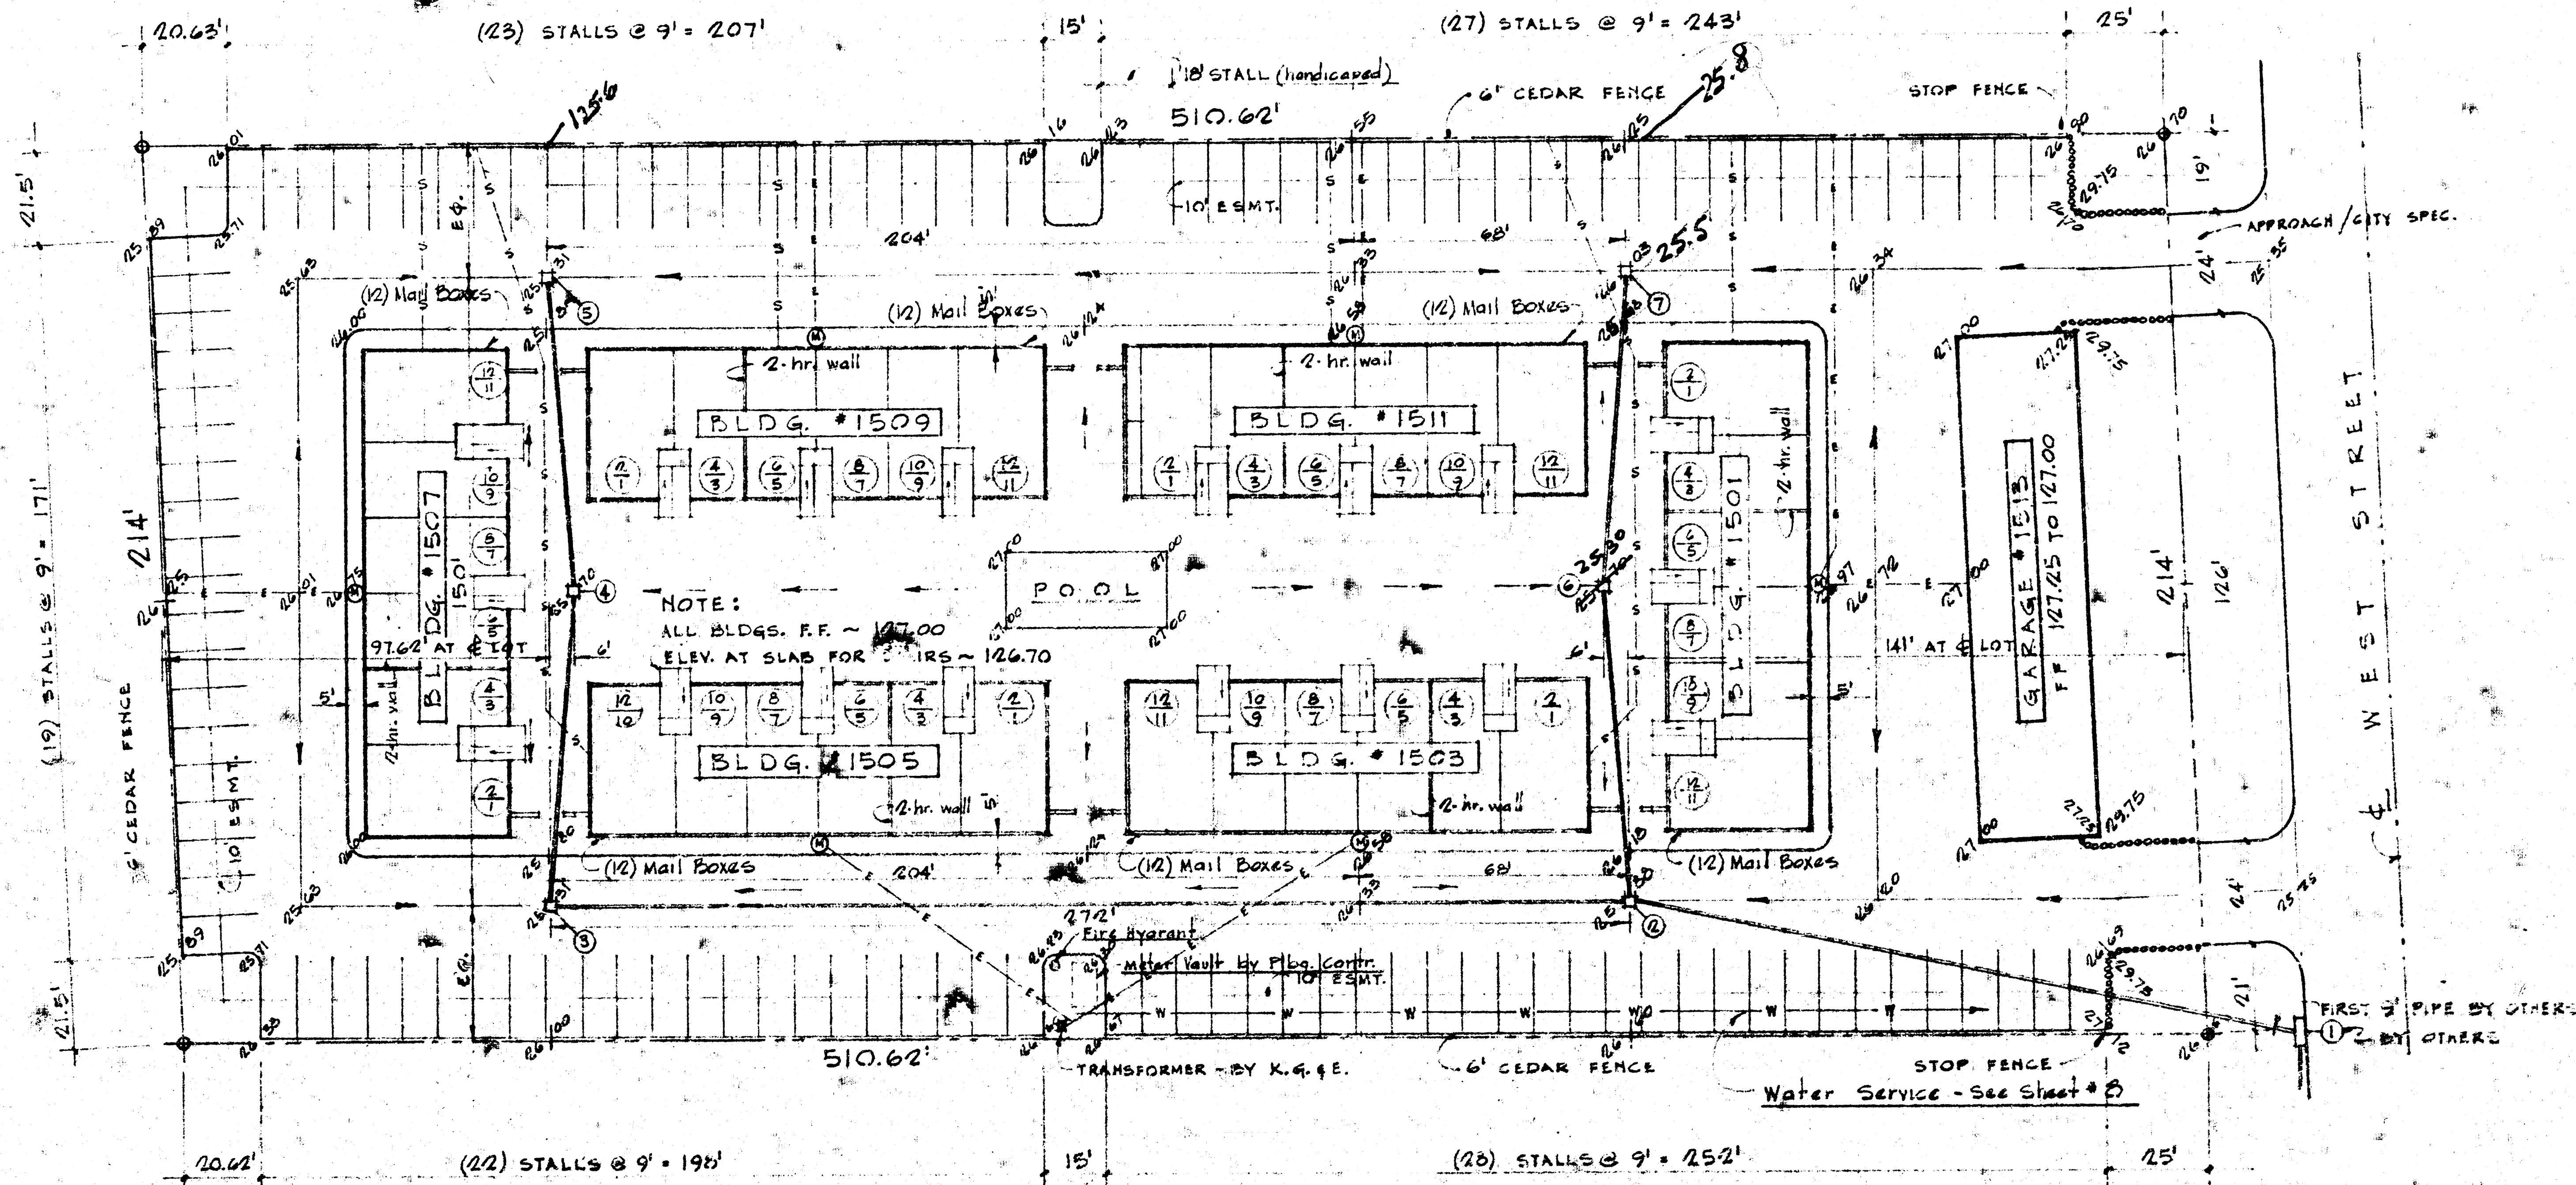


STORM SEWER SCHEDULE						
Struct.	Type	Top El.	Bottom El.	Size	Length	Grade
1	By others	120.21	120.21	27"	552'	0.23%
2	Drop Inl.	125.88	120.95	18"	170'	0.44%
3	Drop Inl.	125.31	122.28	15"	272'	0.49%
4	Drop Inl.	125.70	122.54	12"	75'	0.35%
5	Drop Inl.	125.80	122.80	12"	75'	0.35%
6	Drop Inl.	125.70	122.50	12"	75'	2.07%
7	Drop Inl.	126.03	123.50	12"	75'	1.33%

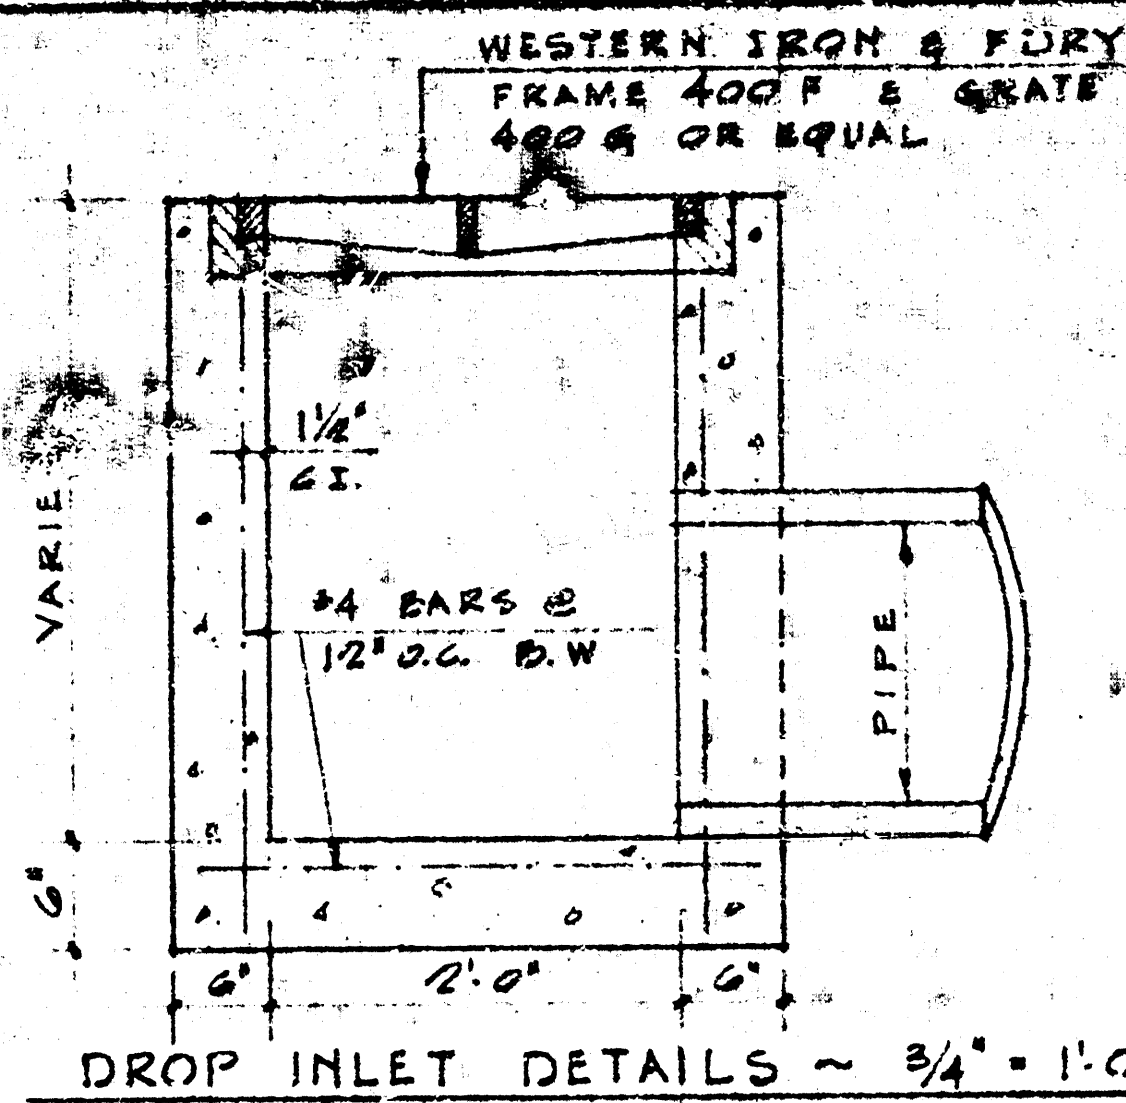

P L O T P L A N

SCALE 1" = 30'


NOTE: SEE SHEET #2 FOR BUILDING LAYOUT

LOT 1 ~ AGILE SECOND ADDITION

City of Wichita Private Storm Sewer No. 468 76 245 80527 000 000 008



B.M.: City Disc. 44'E & 44'N
2 13th & West El. 126.443

D. L. VAN BUSKIRK, ARCH.
360 N. ROCK ROAD
WICHITA, KANSAS 67207

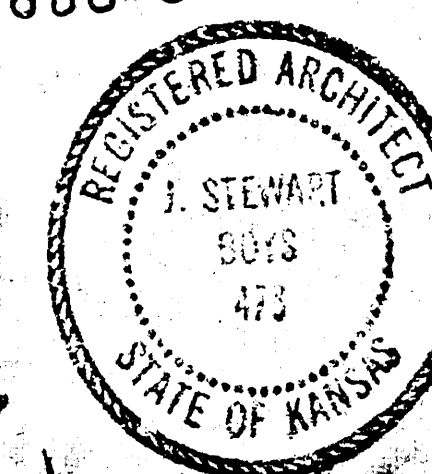

V I L L A O E S T E PLAN NO. 7801
1501, 1503, 1505, 1507, 1509, 1511, 1513
N. WEST STREET

STORM SEWER SCHEDULE						
Struct.	Type	Top El.	Fin. El.	Size	Length	Grade
1	By others	120.21	120.21	27"	552'	0.23%
2	Drop Inl.	125.88	120.95	18"	170'	0.44%
3	Drop Inl.	125.31	122.48	15"	272'	0.49%
4	Drop Inl.	125.70	122.54	12"	75'	0.35%
5	Drop Inl.	125.80	122.50	12"	75'	0.35%
6	Drop Inl.	125.70	122.50	12"	75'	2.07%
7	Drop Inl.	126.03	123.50	12"	75'	1.33%

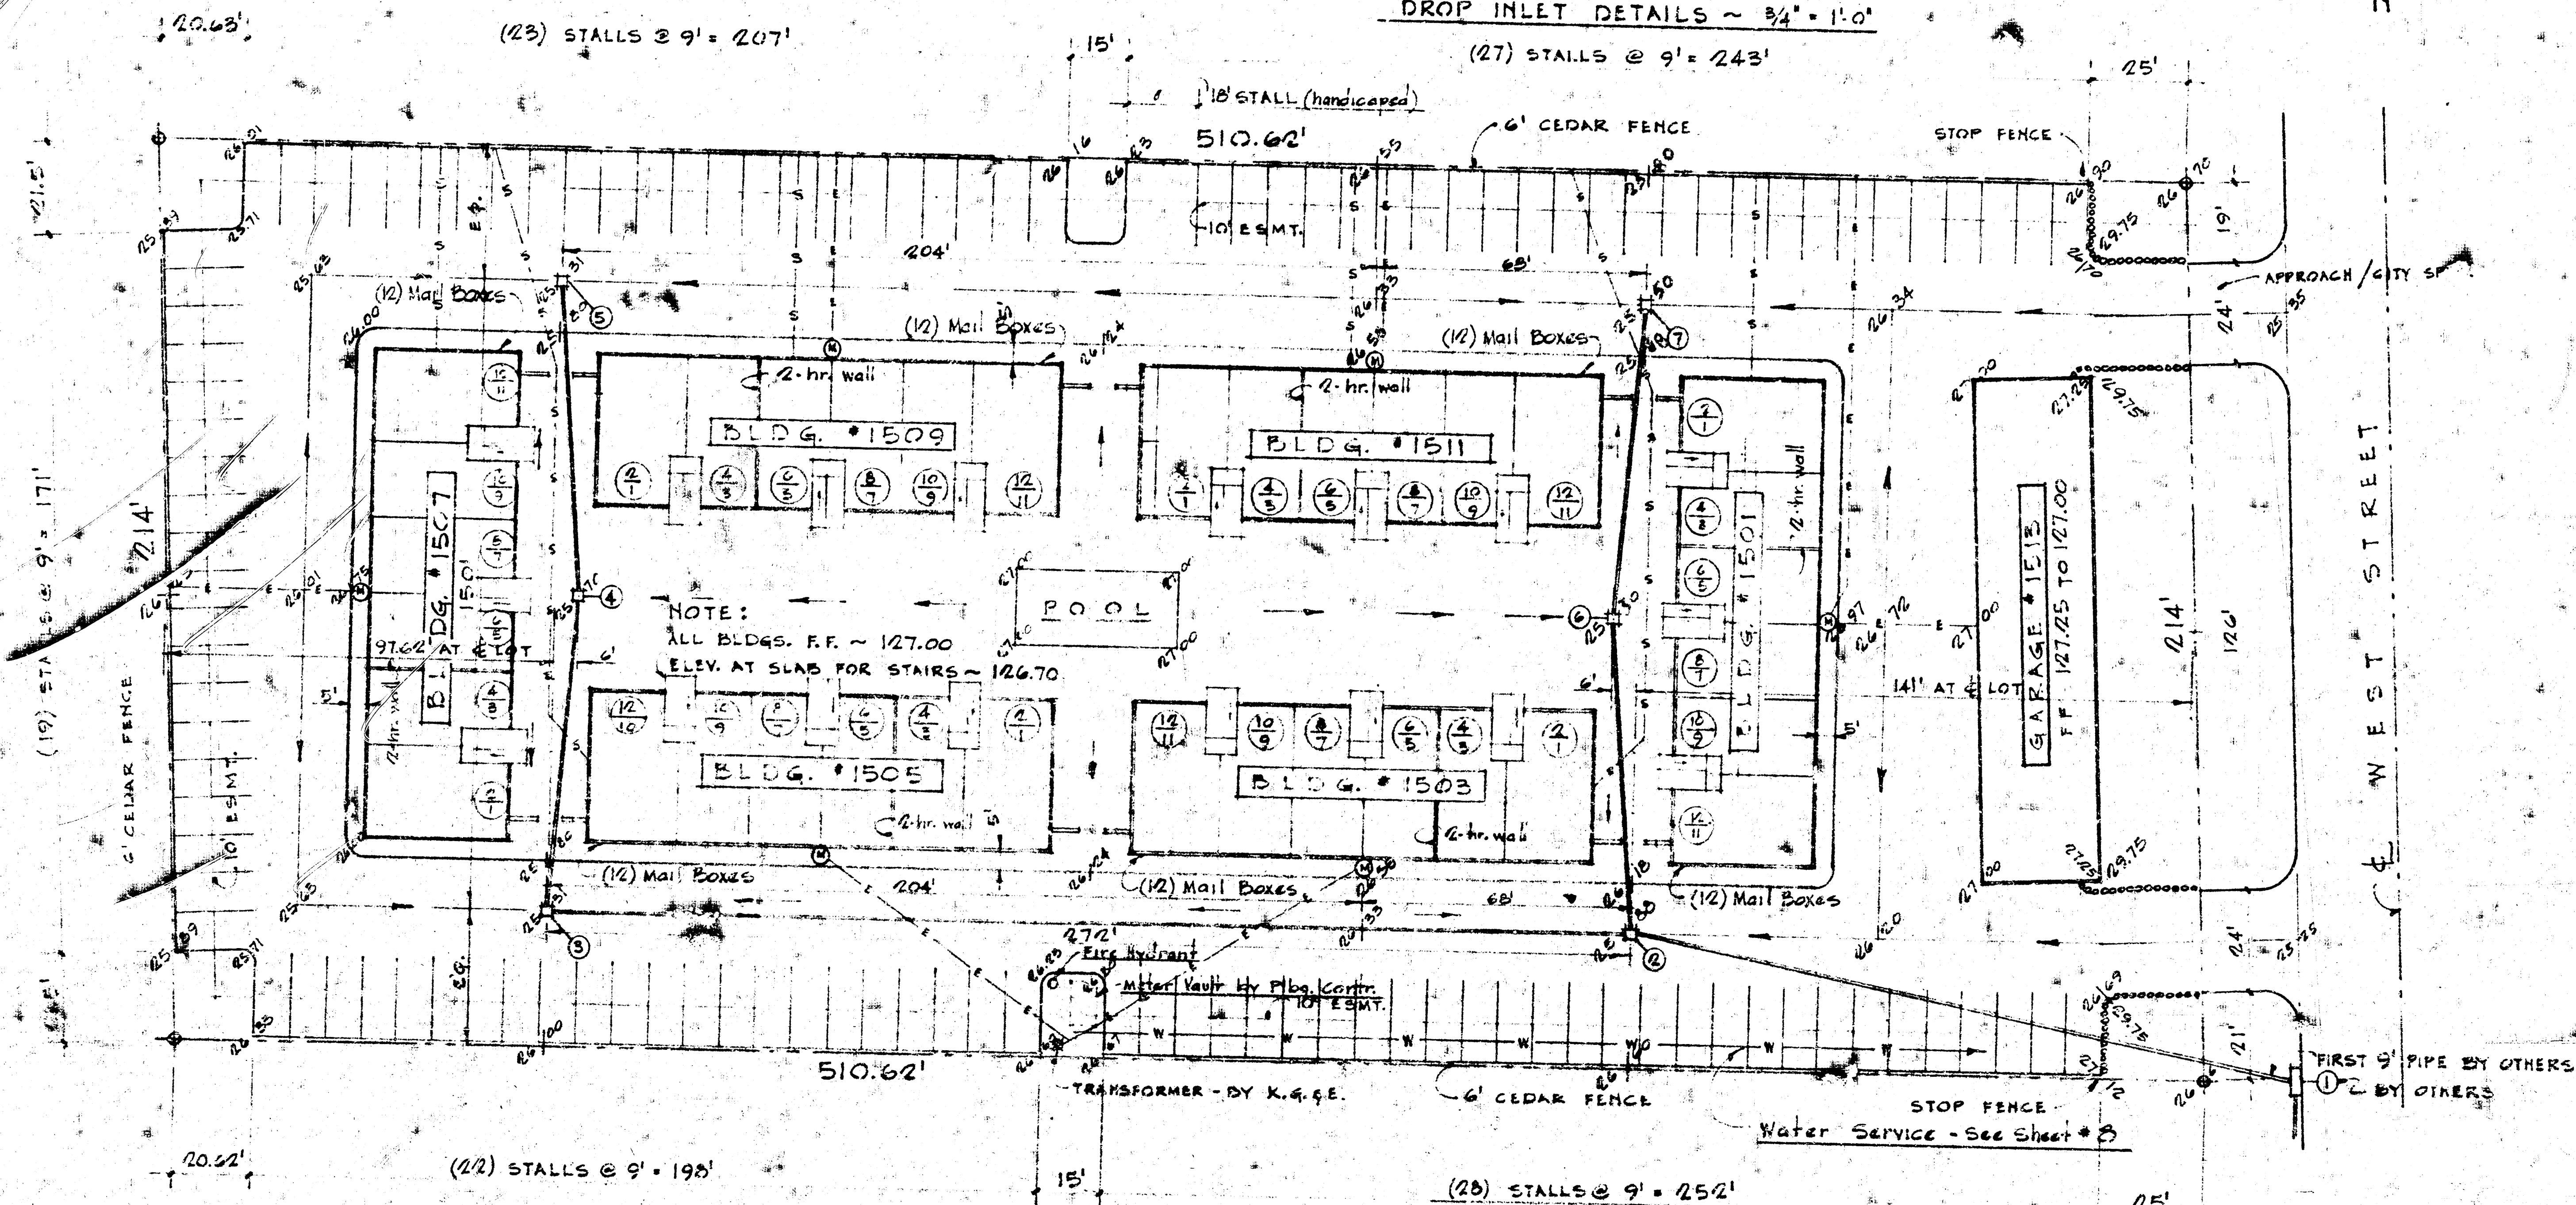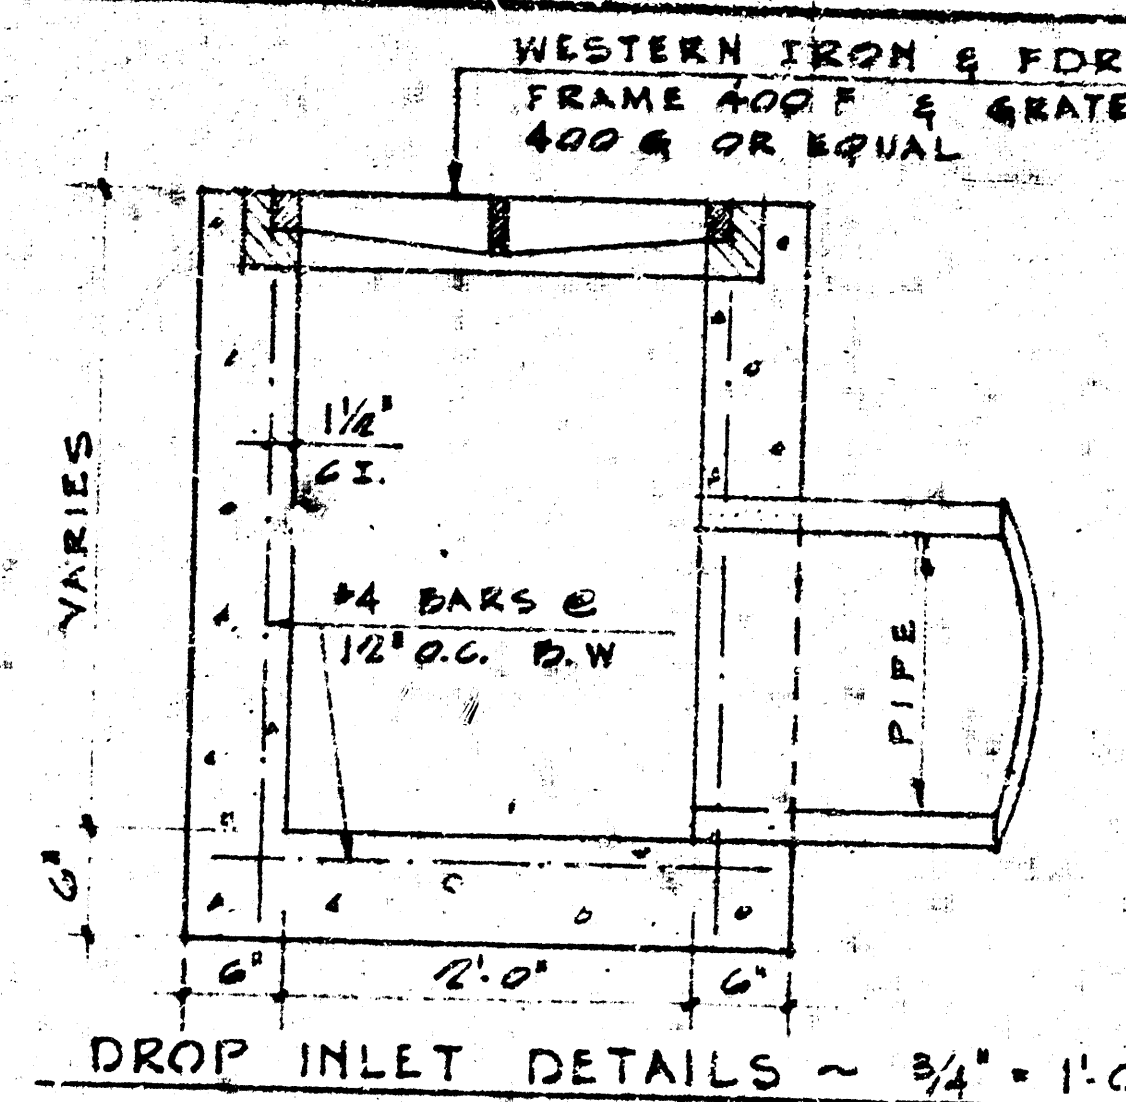

P L O T P L A N

SCALE 1" = 30'


NOTE: SEE SHEET #2 FOR BUILDING LAYOUT

LOT 1 ~ AGILE SECOND ADDITION

CITY OF WICHITA PRIVATE STORM SEWER NO. 466 76 2-5 80527 OUR DES.

B.M.: City Disc 44.6 & 44.7
E 13th & West El. 126.443

D. L. VAN BUSKIRK, INC.
360 N. ROCK ROAD
WICHITA, KANSAS 67205

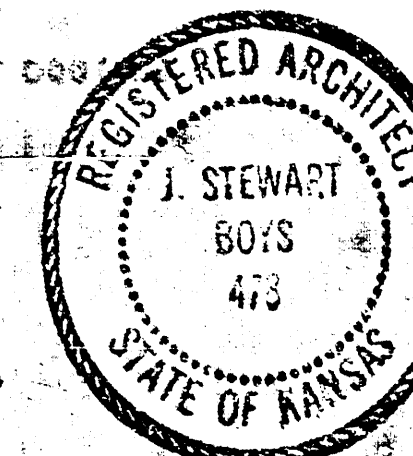

1501, 1503, 1505, 1507, 1509, 1511, 1513
N. WEST STREET
V I L L A O E S T E
PLAN NO. 7801

