


 

NOTES: REVISIONS BY E.D. DATE 7/14

1. IN NORTH CORNER OF SITE, ABOVE DRIVE CHAIN ON PLAN LABEL #10 IS TO BE DELETED AND REPLACED WITH VAULTED DRIVE AS SHOWN FOR THE REVISED PLAN DATE 7/14.



2. PARKING SPACES CHANGED TO BE OF BLUE PRINT TYPE A, 15' OF BLDG. C & NORTH OF BLDG. D. PREVIOUS PLAN SHOWN 14' H. 15' TOTAL MINIMUM 14'50" TOTAL PARKING AREA. THIS REVISION PLAN & 45' AN INCREASE OF 1' STALL.

LEGEND

ROADWAY AND PARKING AREAS SHALL BE ASPHALT W/ CONC. CURB AND GUTTER OR EQUAL

PLANTERS IN PARKING AREAS SHALL HAVE CONC. CURB AND GUTTER OR EQUAL

ALL RADII SHALL BE 5' UNLESS NOTED

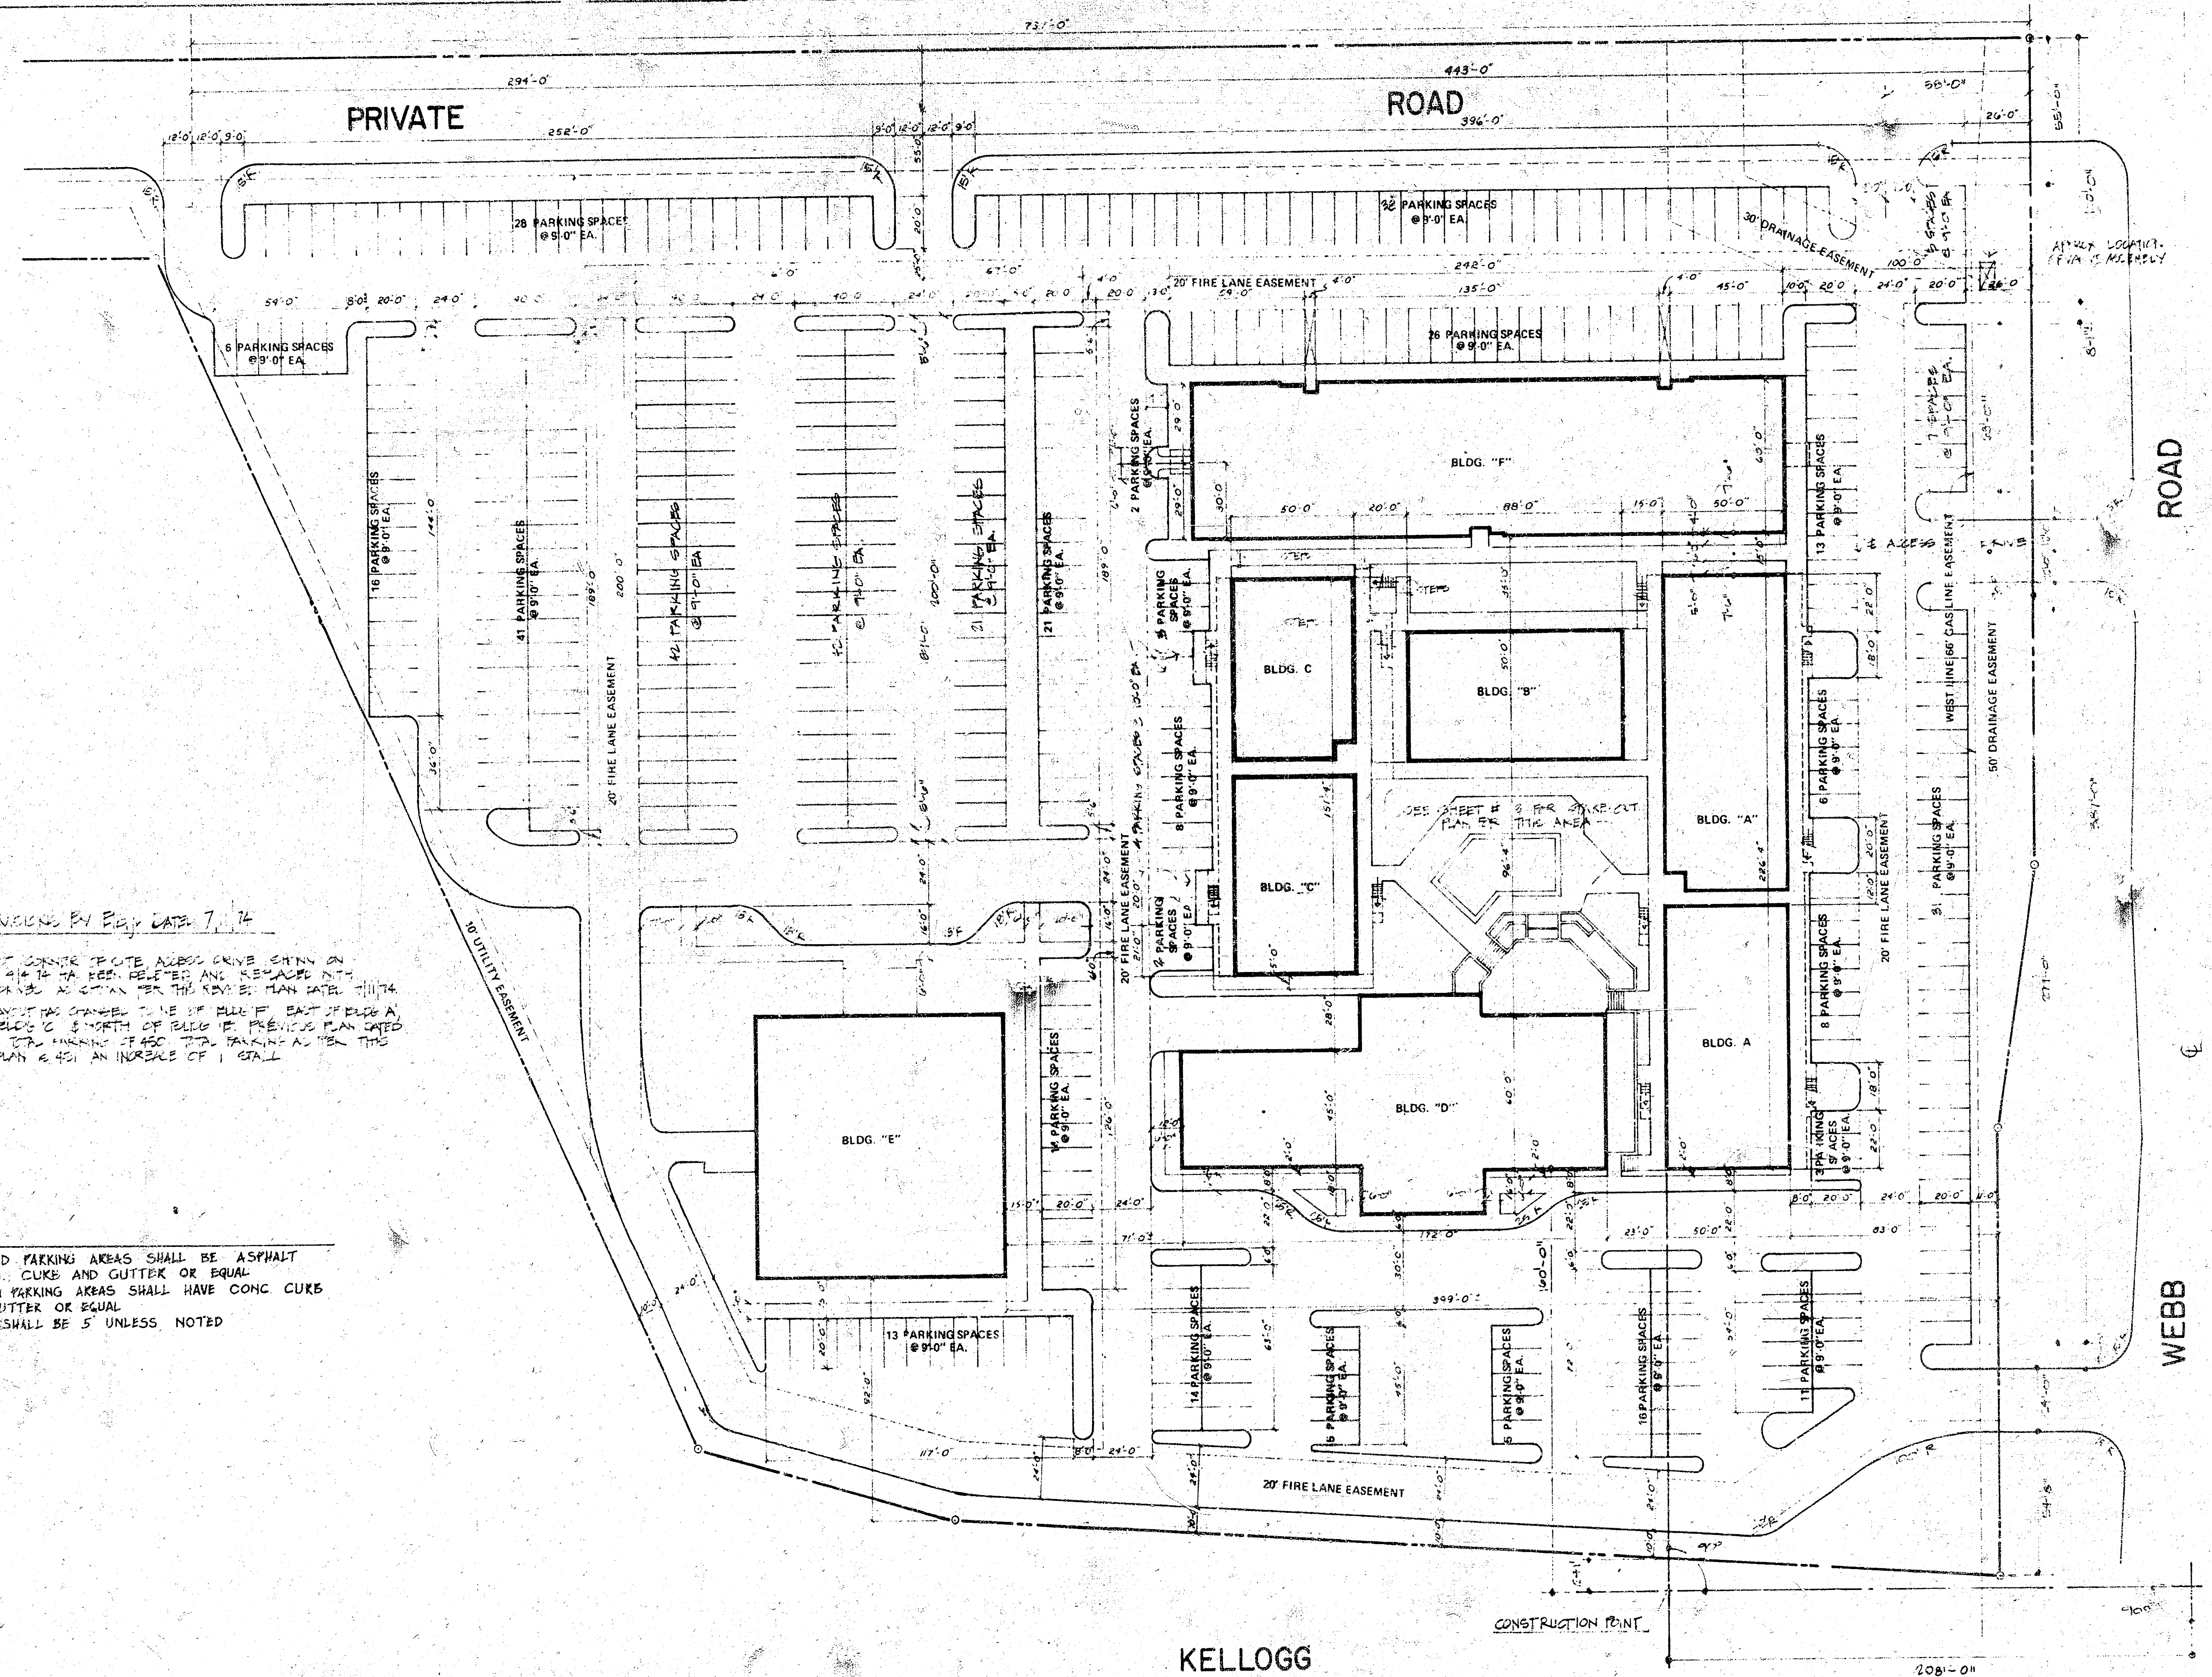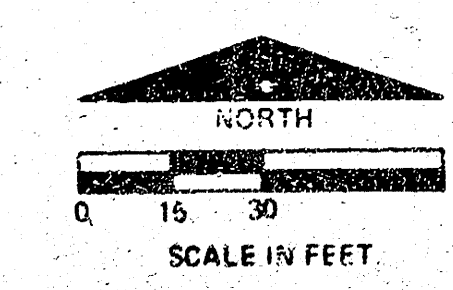

KELLOGG

SITE LAYOUT PLAN

 ottinger-smith corporation Consultants in Planning 625 First National Bank Building Wichita, Kansas 67202	PROJECT F.N.C. DEVELOPMENT		SHEET TITLE LAYOUT PLAN	DESIGNER NED BLAKE	REVISIONS BY DATE C.B.V. (SEE NOTE) 7/14
	SHEET NUMBER 2	OF 11	DATE MARCH 22, 1974	ENGINEERING TECHNICIAN P.D. PRICE	