

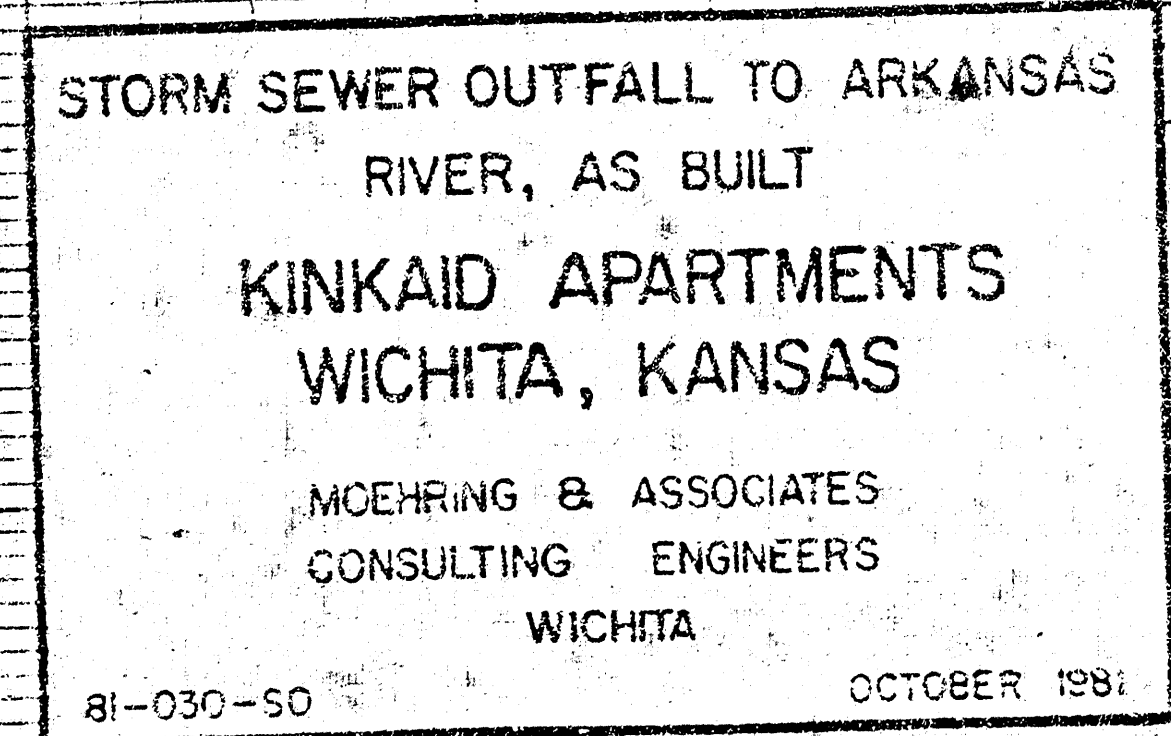


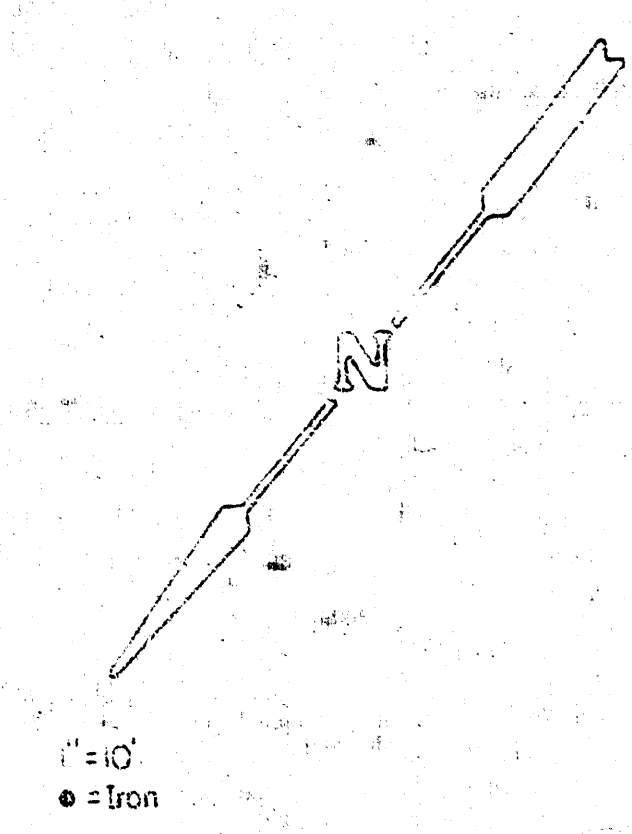

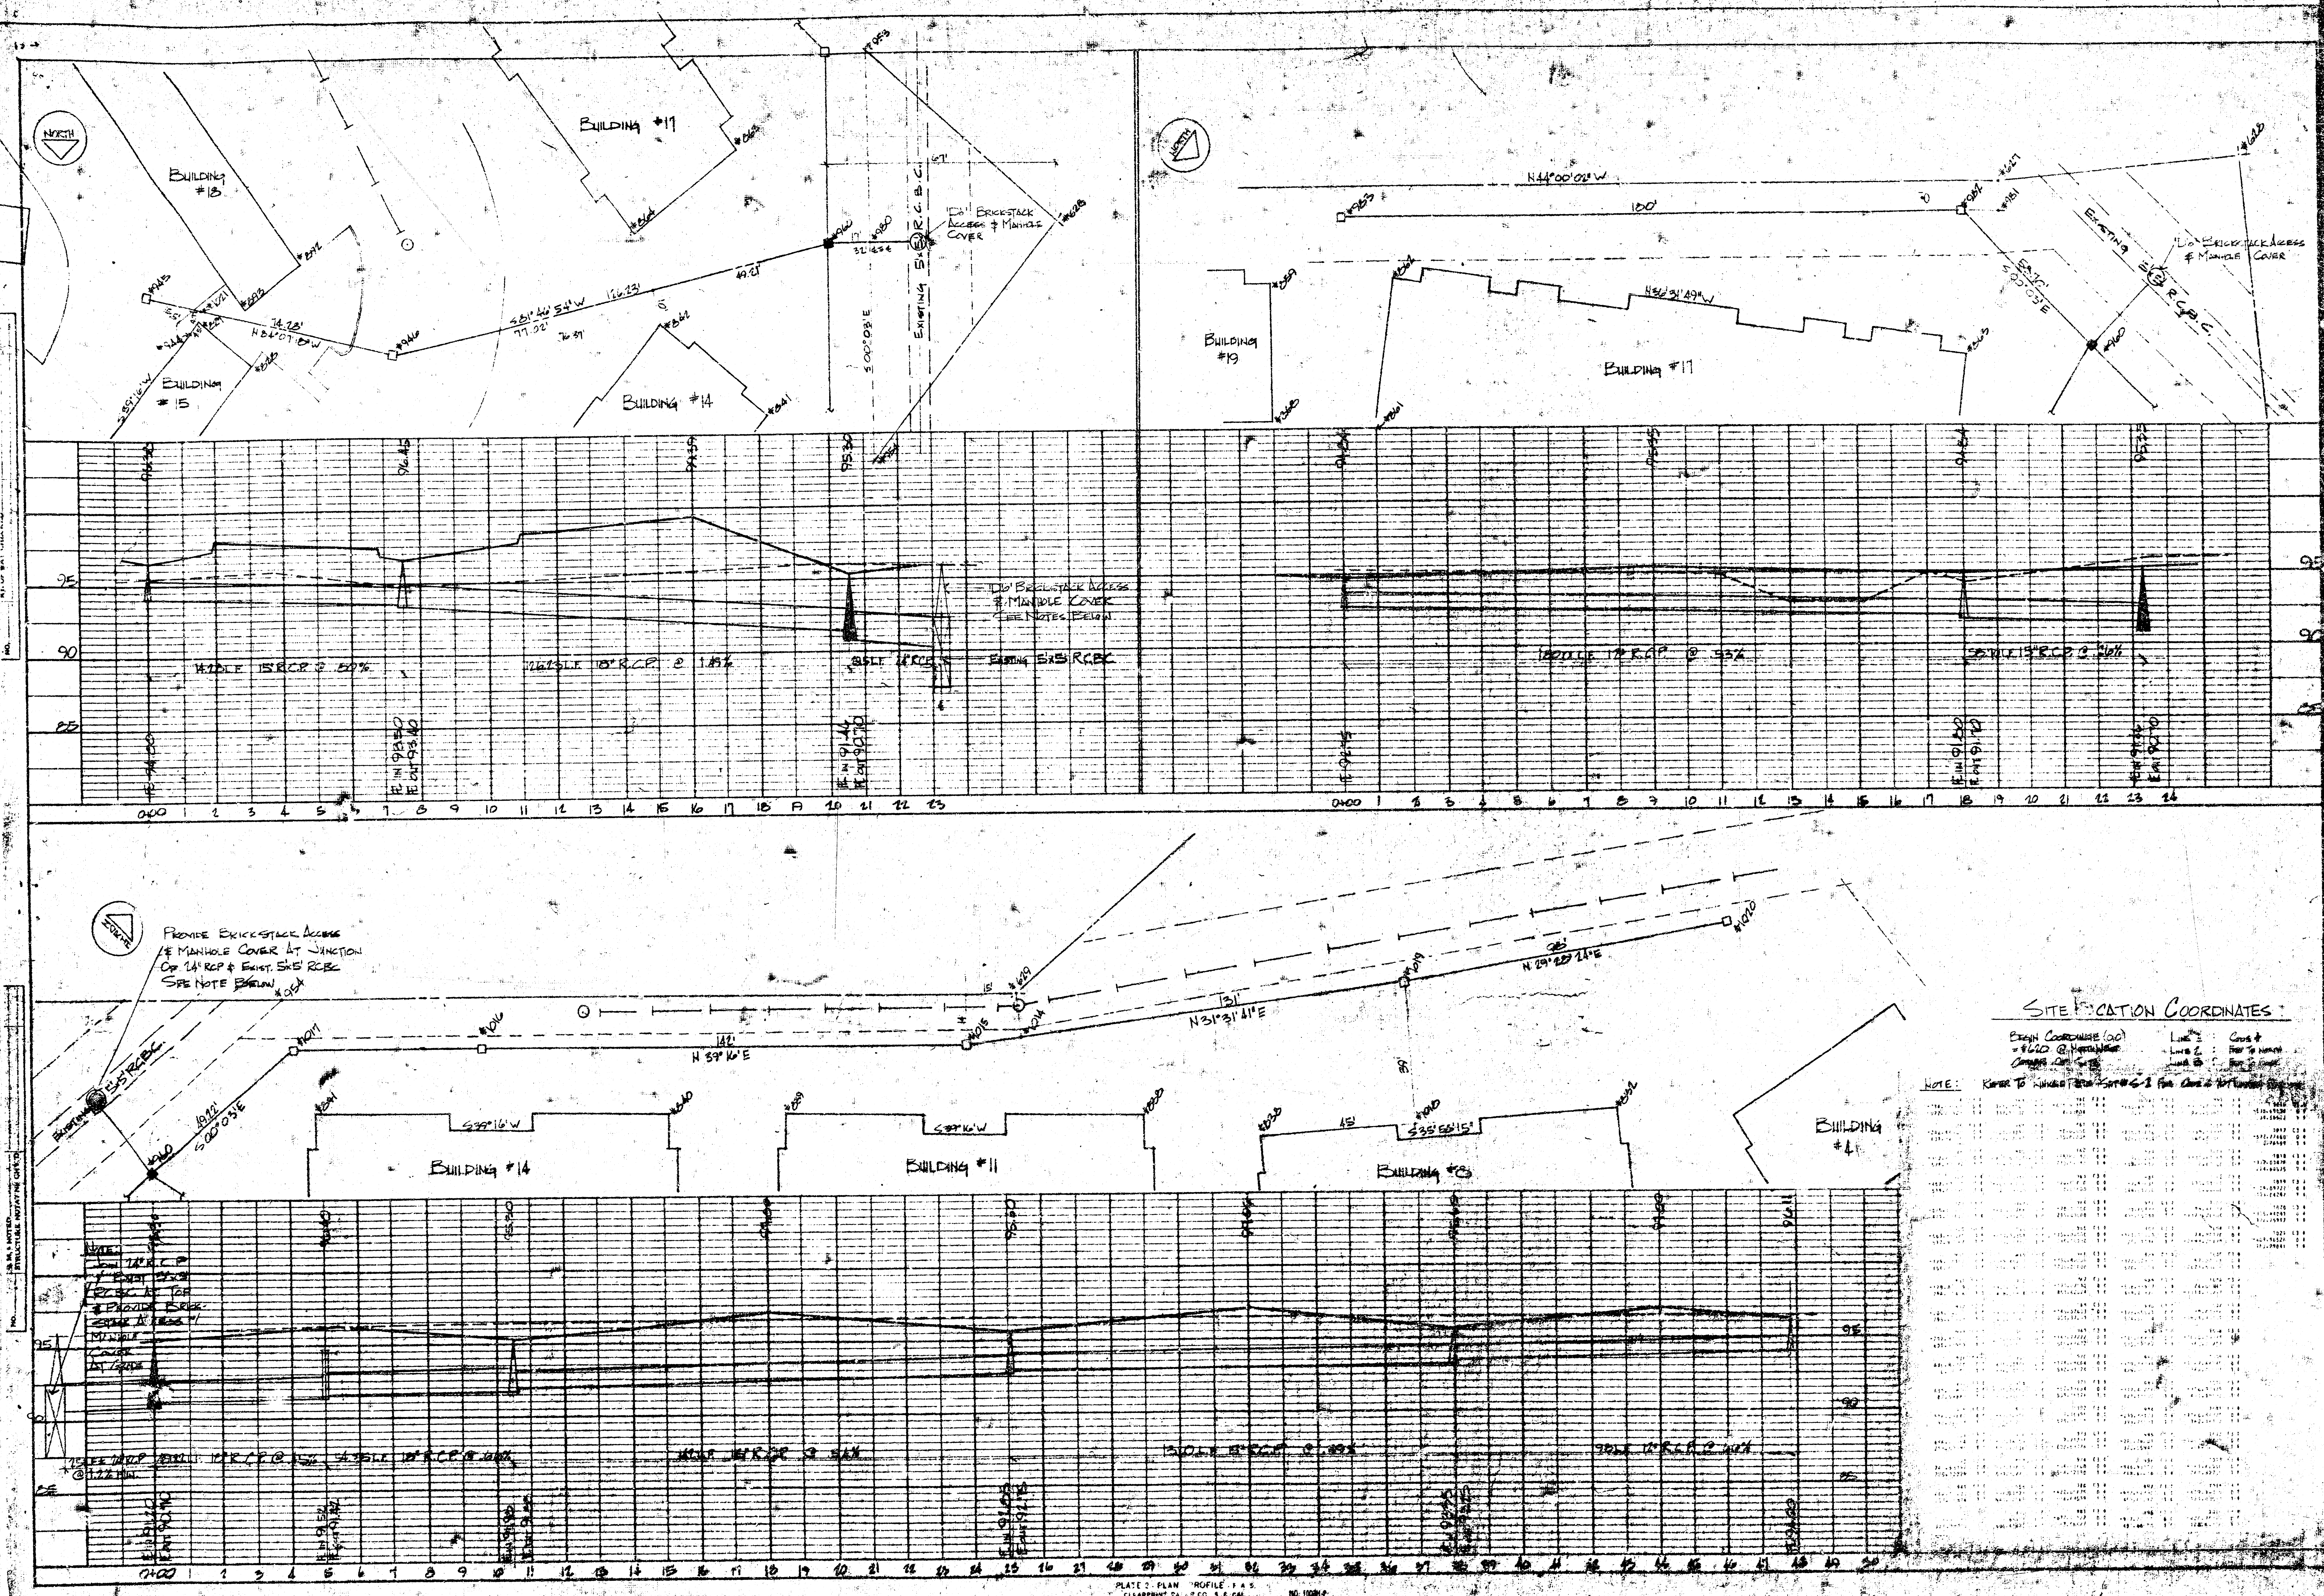

LAWRENCE E. WELLS
A R C H I T E C T

254 LAURA, SUITE 205
WICHITA, KANSAS 67211

KINKAID PARK APTS.
FOR KINKAID, INC., WICHITA, KANSAS

SECTION AND SOUTH TOPEKA
PLAN NO. C-352 PROJECT 545

SHEET 7 OF 2
3/3