
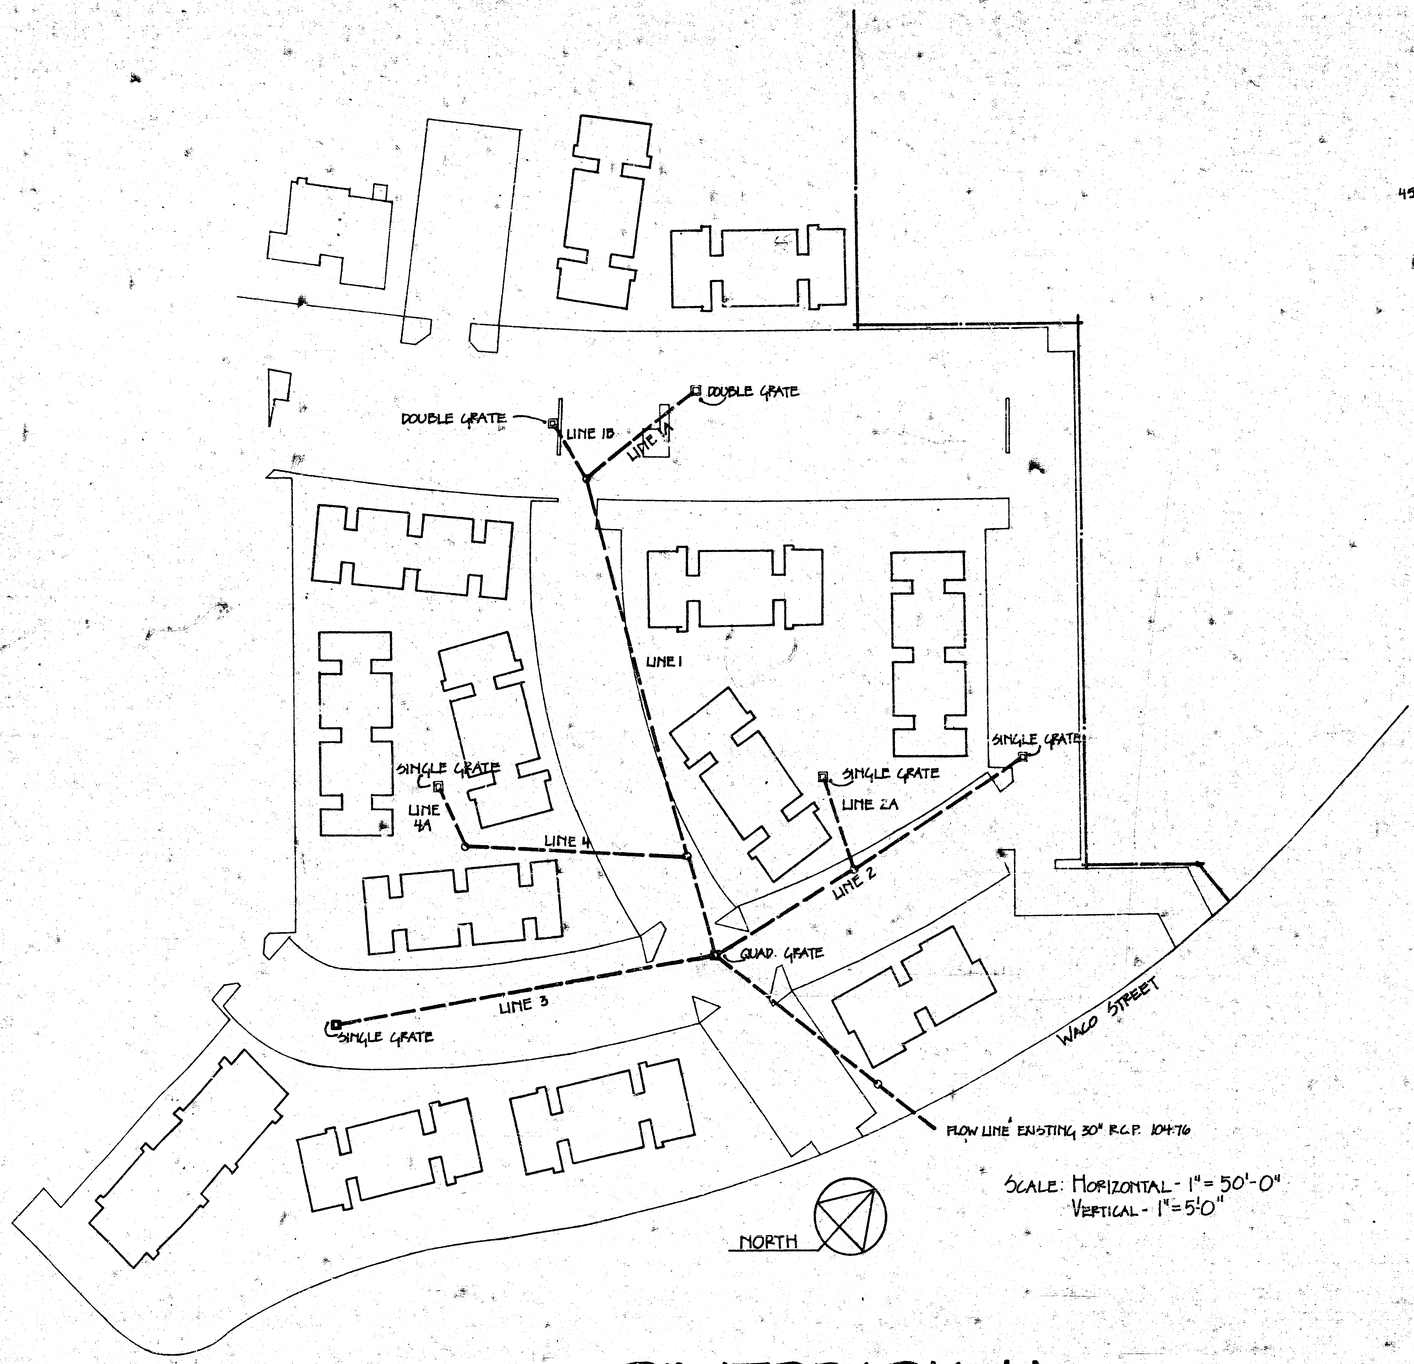



SCALE: HORIZONTAL - 1" = 50'-0"
VERTICAL - 1" = 5'-0"

RIVERPARK II


STORM SEWER PLAN & PROFILES
GENERAL CONTRACTOR - UTILITY CONTRACTORS INC.
1977 U-1065

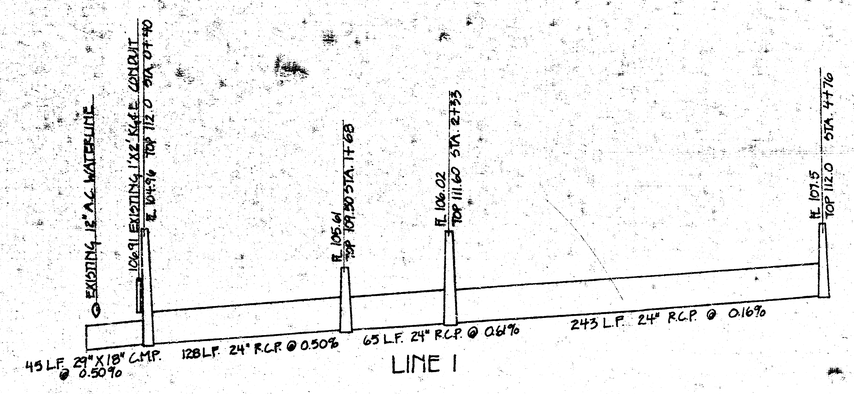


LINE 1

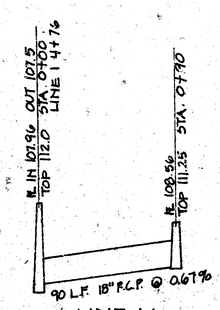


LINE 1A

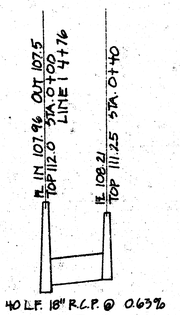


LINE 1B

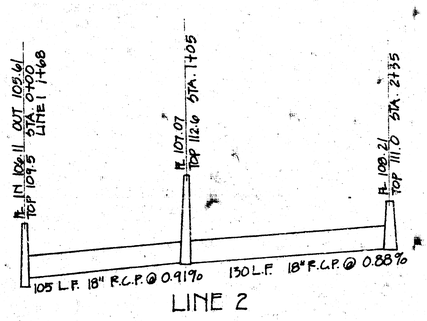


LINE 2

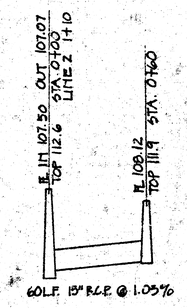


LINE 2A

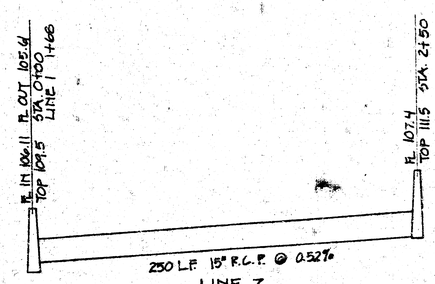


LINE 3

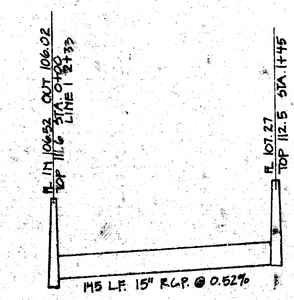

LINE 4

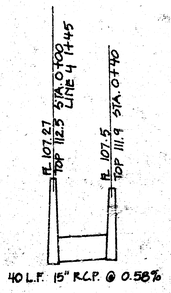


LINE 4A

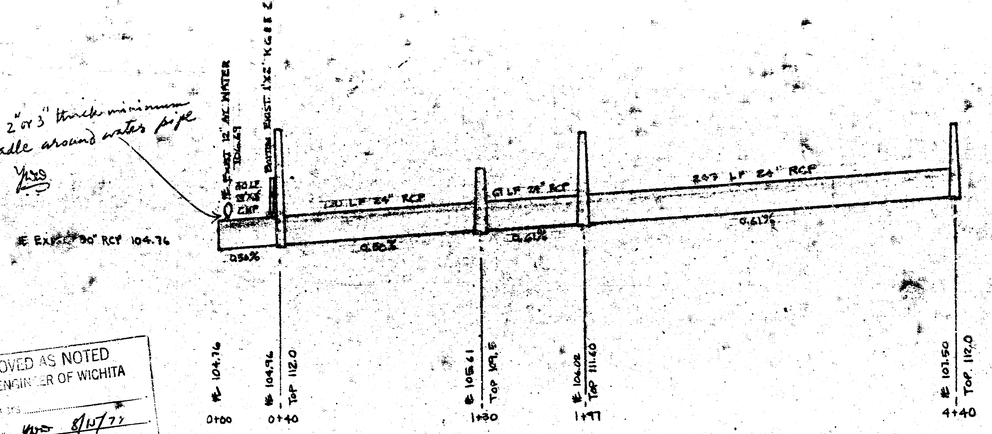


APPROVED AS NOTED
By CITY ENGINEER OF WICHITA
Sanitary Sewers _____
Storm Sewers Yes 8/10/77
Driveway Approaches _____

ty of Wichita Private Storm Sewer NO. PBKW 707043


LINE 1

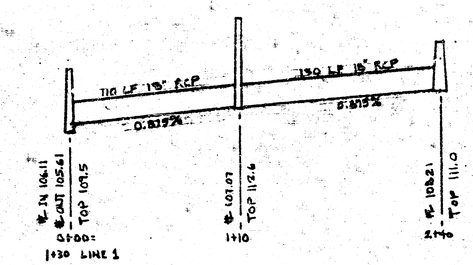


LINE 2

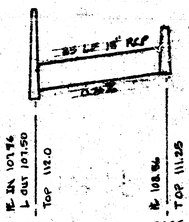


LINE 1A

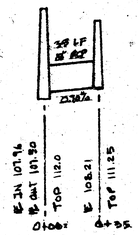


LINE 1B

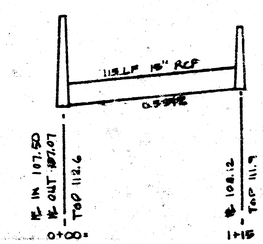


LINE 2

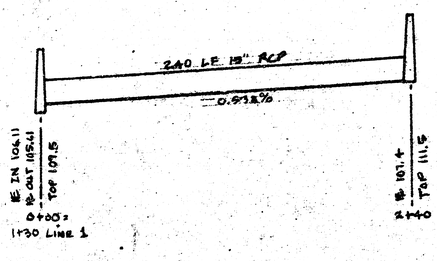

LINE 3

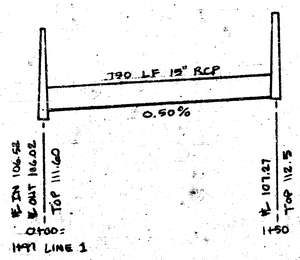

LINE 4

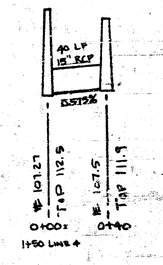

LINE 4A

Scales Horz. 1" = 50'
Vert. 1" = 5'