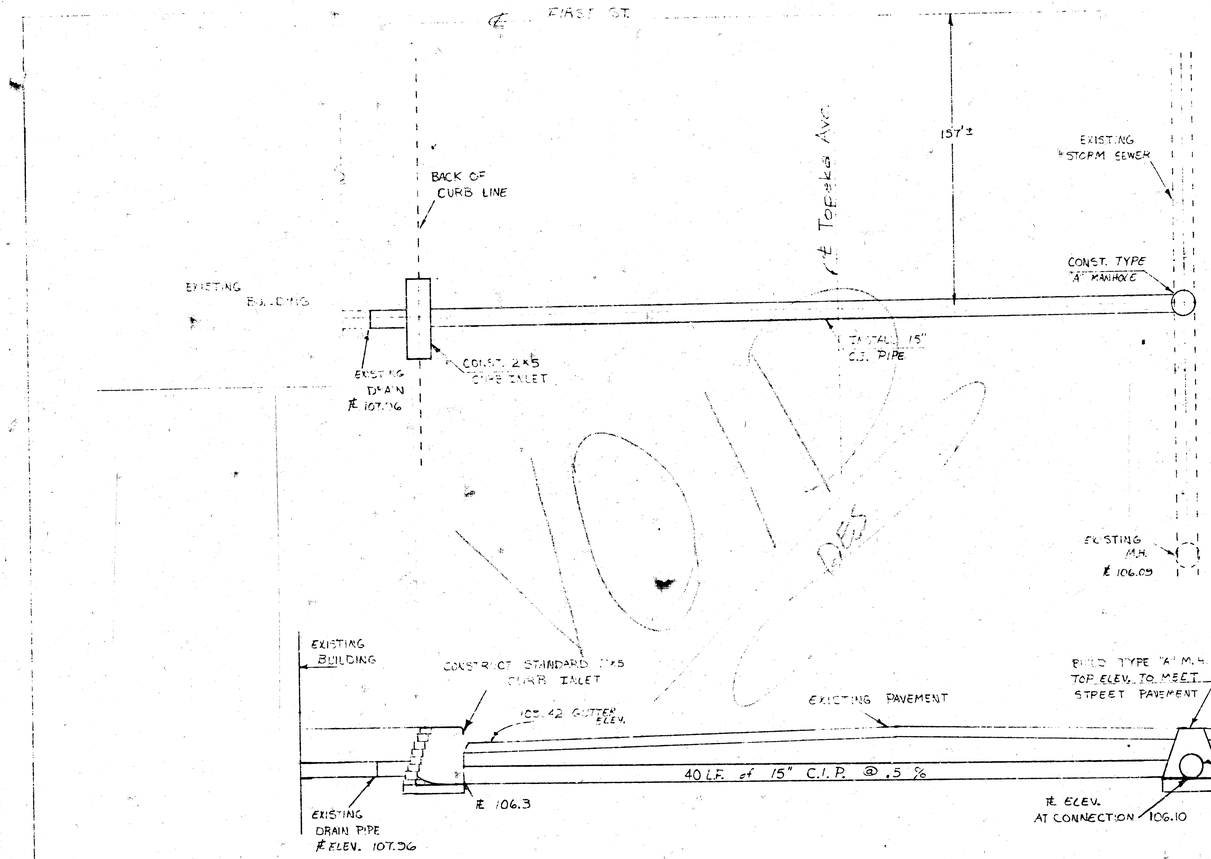


NOTE: TOP OF PIPE TO BE 1'-10" BELOW TOP OF PAVEMENT.

SCALE 1"=5'

APPROVED AS NOTED
By CITY ENGINEER OF WICHITA
Sanitary Sewers _____
Storm Sewers M.F.
Driveway Approaches _____

NOTE TO CONTRACTOR:
This project will be constructed under the supervision of the CITY ENGINEER and conforming to the SPECIFICATIONS of the CITY OF WICHITA. The CONTRACTOR will arrange with the City of Wichita for all construction staking, plans, and inspection.


City Proj. No. DBKW706039

ROOF DRAIN SYS. BELL TELE.

1ST & TOPEKA

6-25-76

UTILITY CONTRACTOR'S RICH...

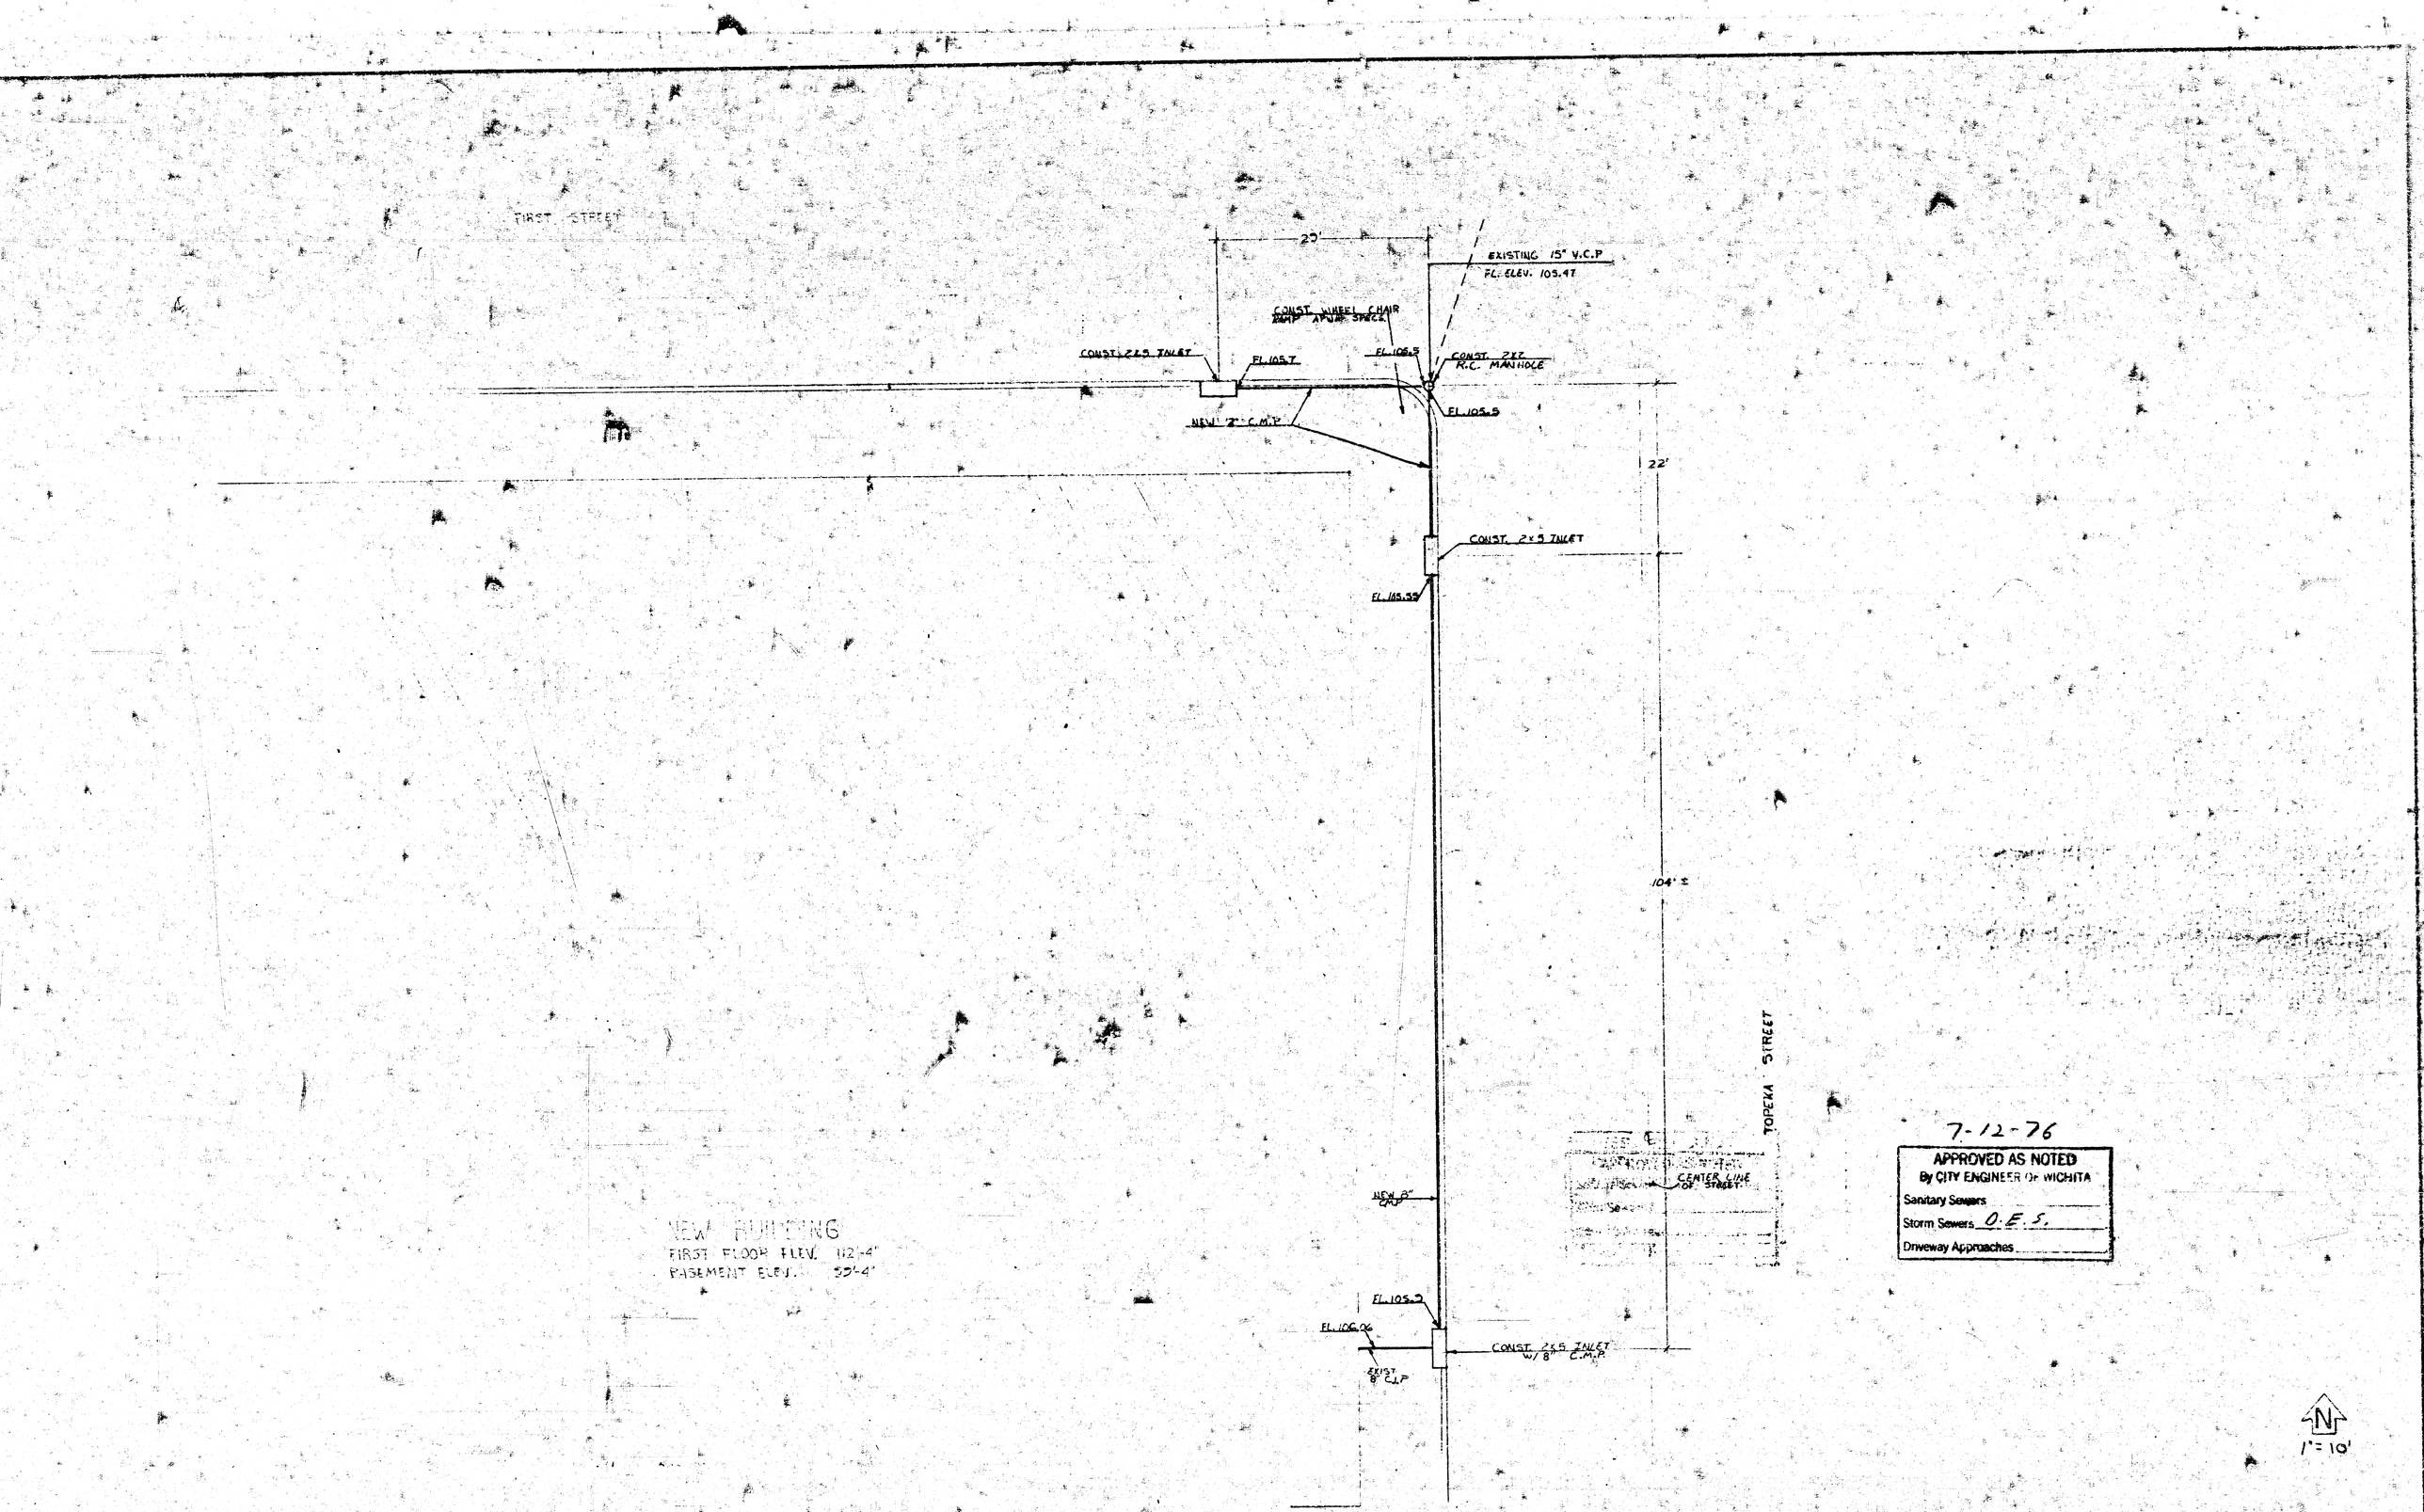
FIRST STREET
25'
EXISTING 15" V.C.P
FL. ELEV. 103.47
CONST. WHEEL CHAIR RAMP AT N.W. CORN.
CONST. 2'x2' R.C. MANHOLE
FL. 105.5
CONST. 2'x5' INLET
FL. 105.7
NEW 2" C.M.P.
FL. 105.5
22'
CONST. 2'x5' INLET
FL. 105.39
104' ±
TOPEKA STREET
CENTER LINE OF STREET
NEW 8" C.M.P.
FL. 105.3
FL. 106.06
EXIST. 8" C.I.P.
CONST. 2'x5' INLET W/ 8" C.M.P.
NEW BUILDING
FIRST FLOOR ELEV. 112'-4"
BASEMENT ELEV. 99'-4"
7-12-76
APPROVED AS NOTED
By CITY ENGINEER OF WICHITA
Sanitary Sewers
Storm Sewers O.E.S.
Driveway Approaches
N
1" = 10'
DBKW 706039
STORM SEWER RECONSTRUCTION
SOUTHWEST CORNER FIRST & TOPEKA
1" = 10'
RLF