

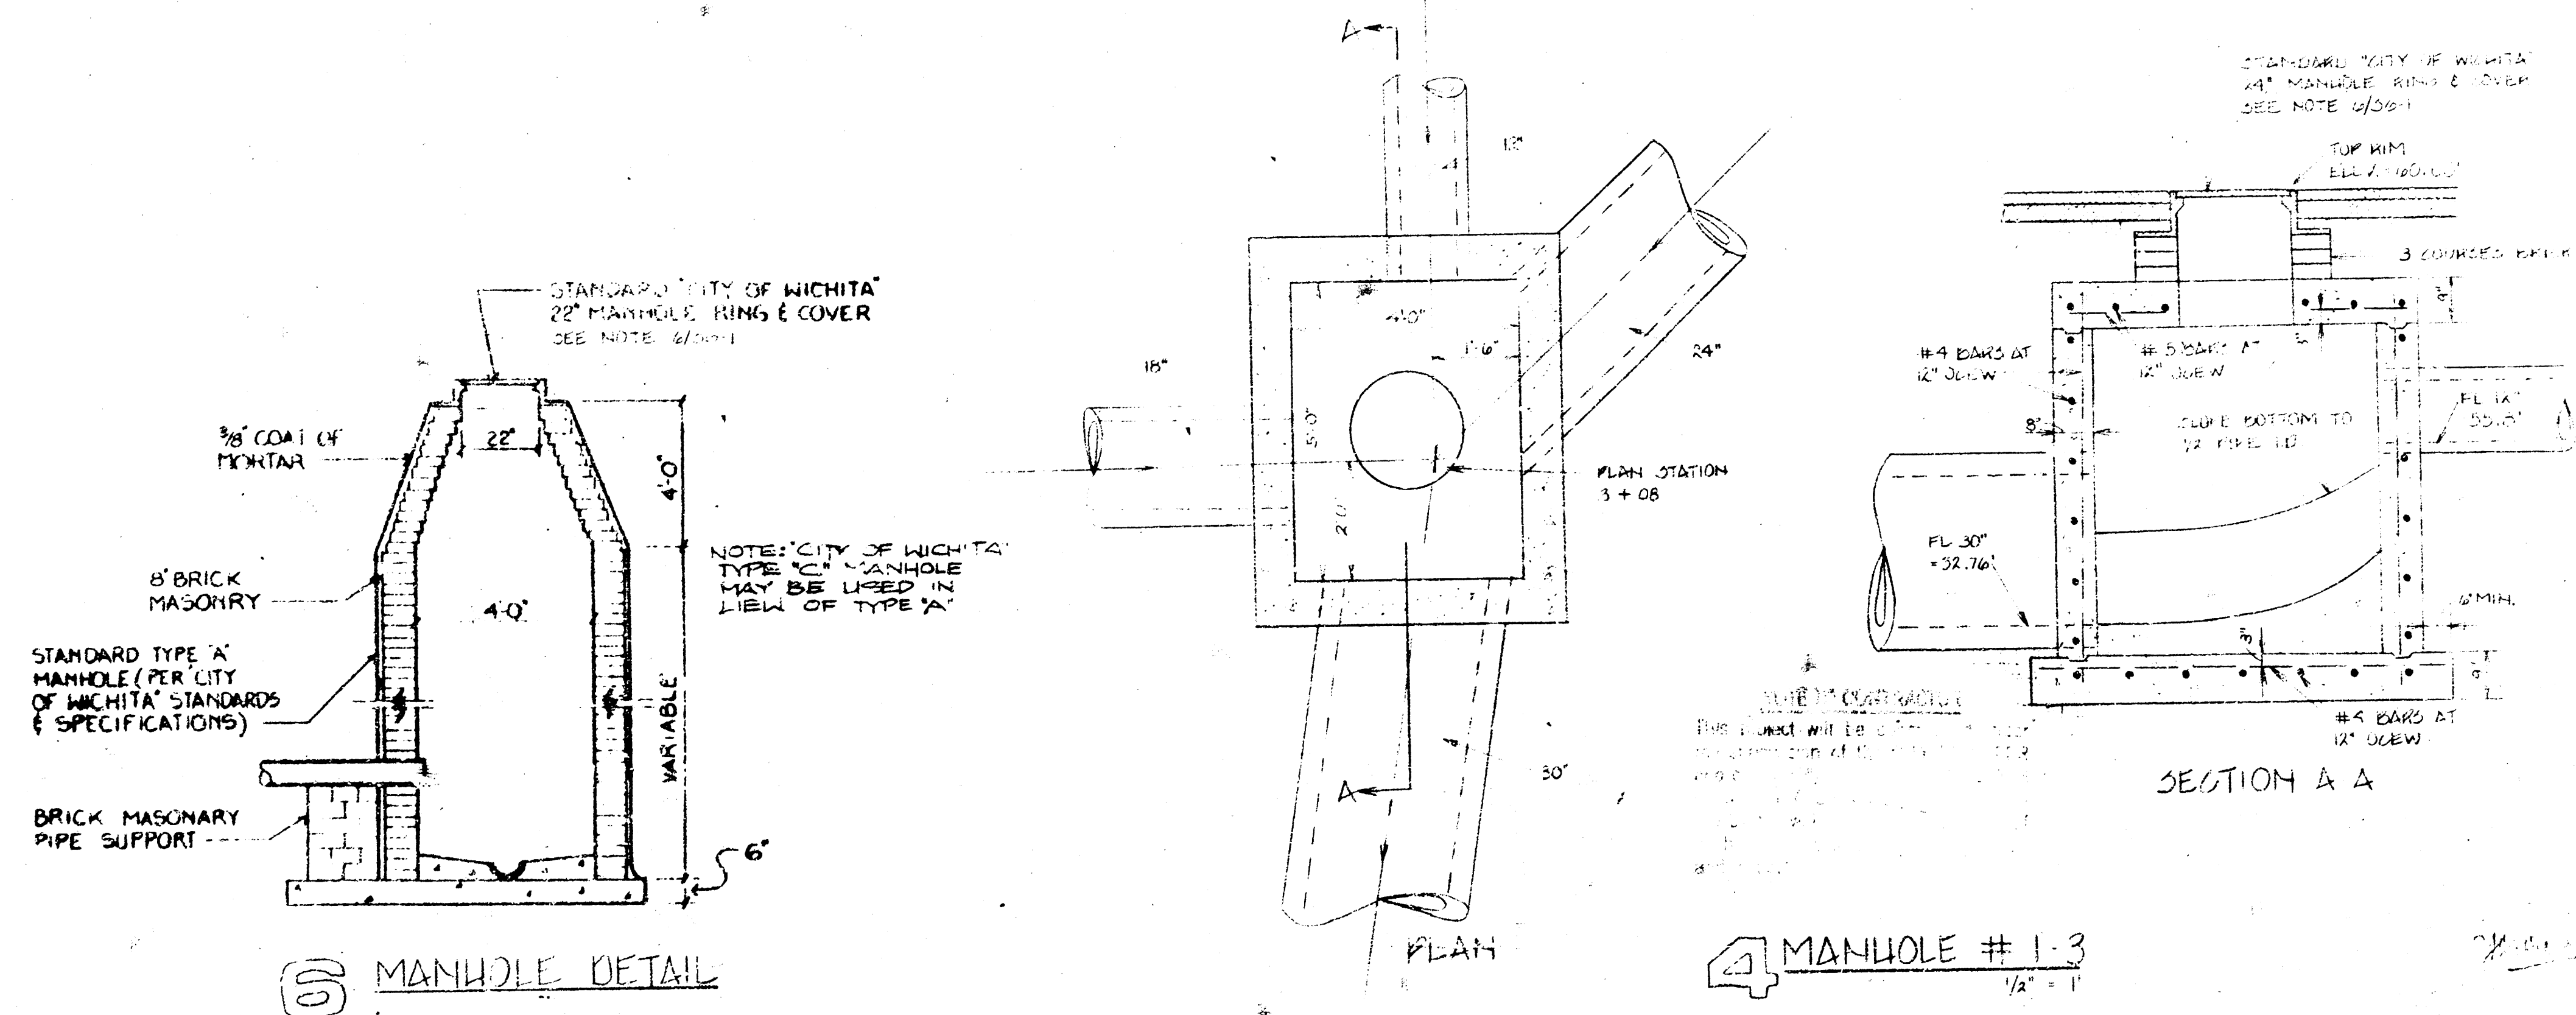
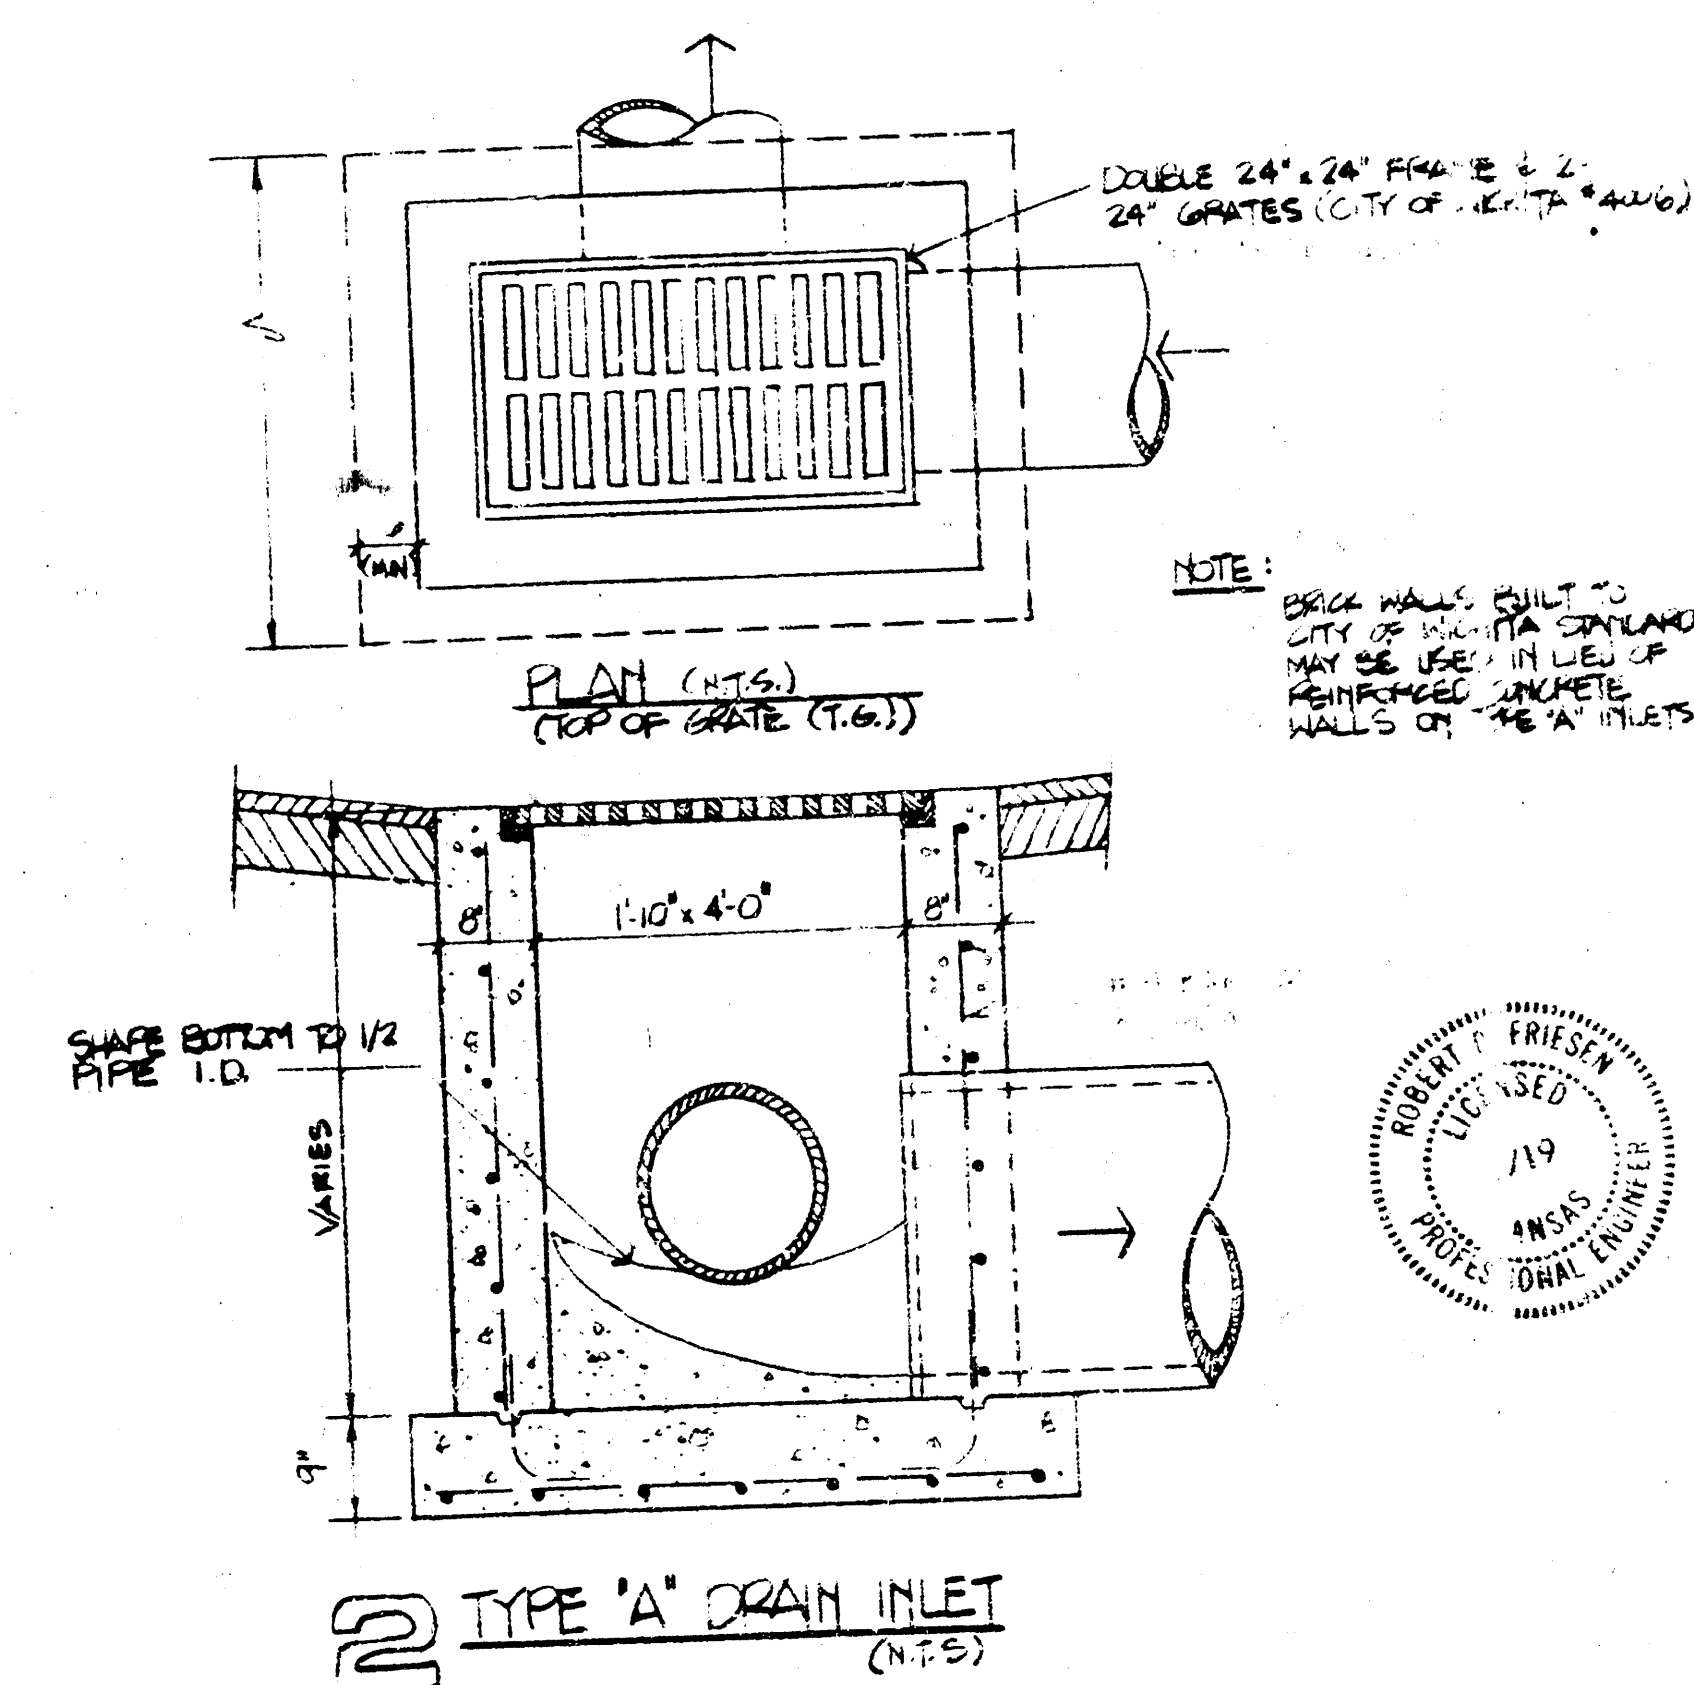
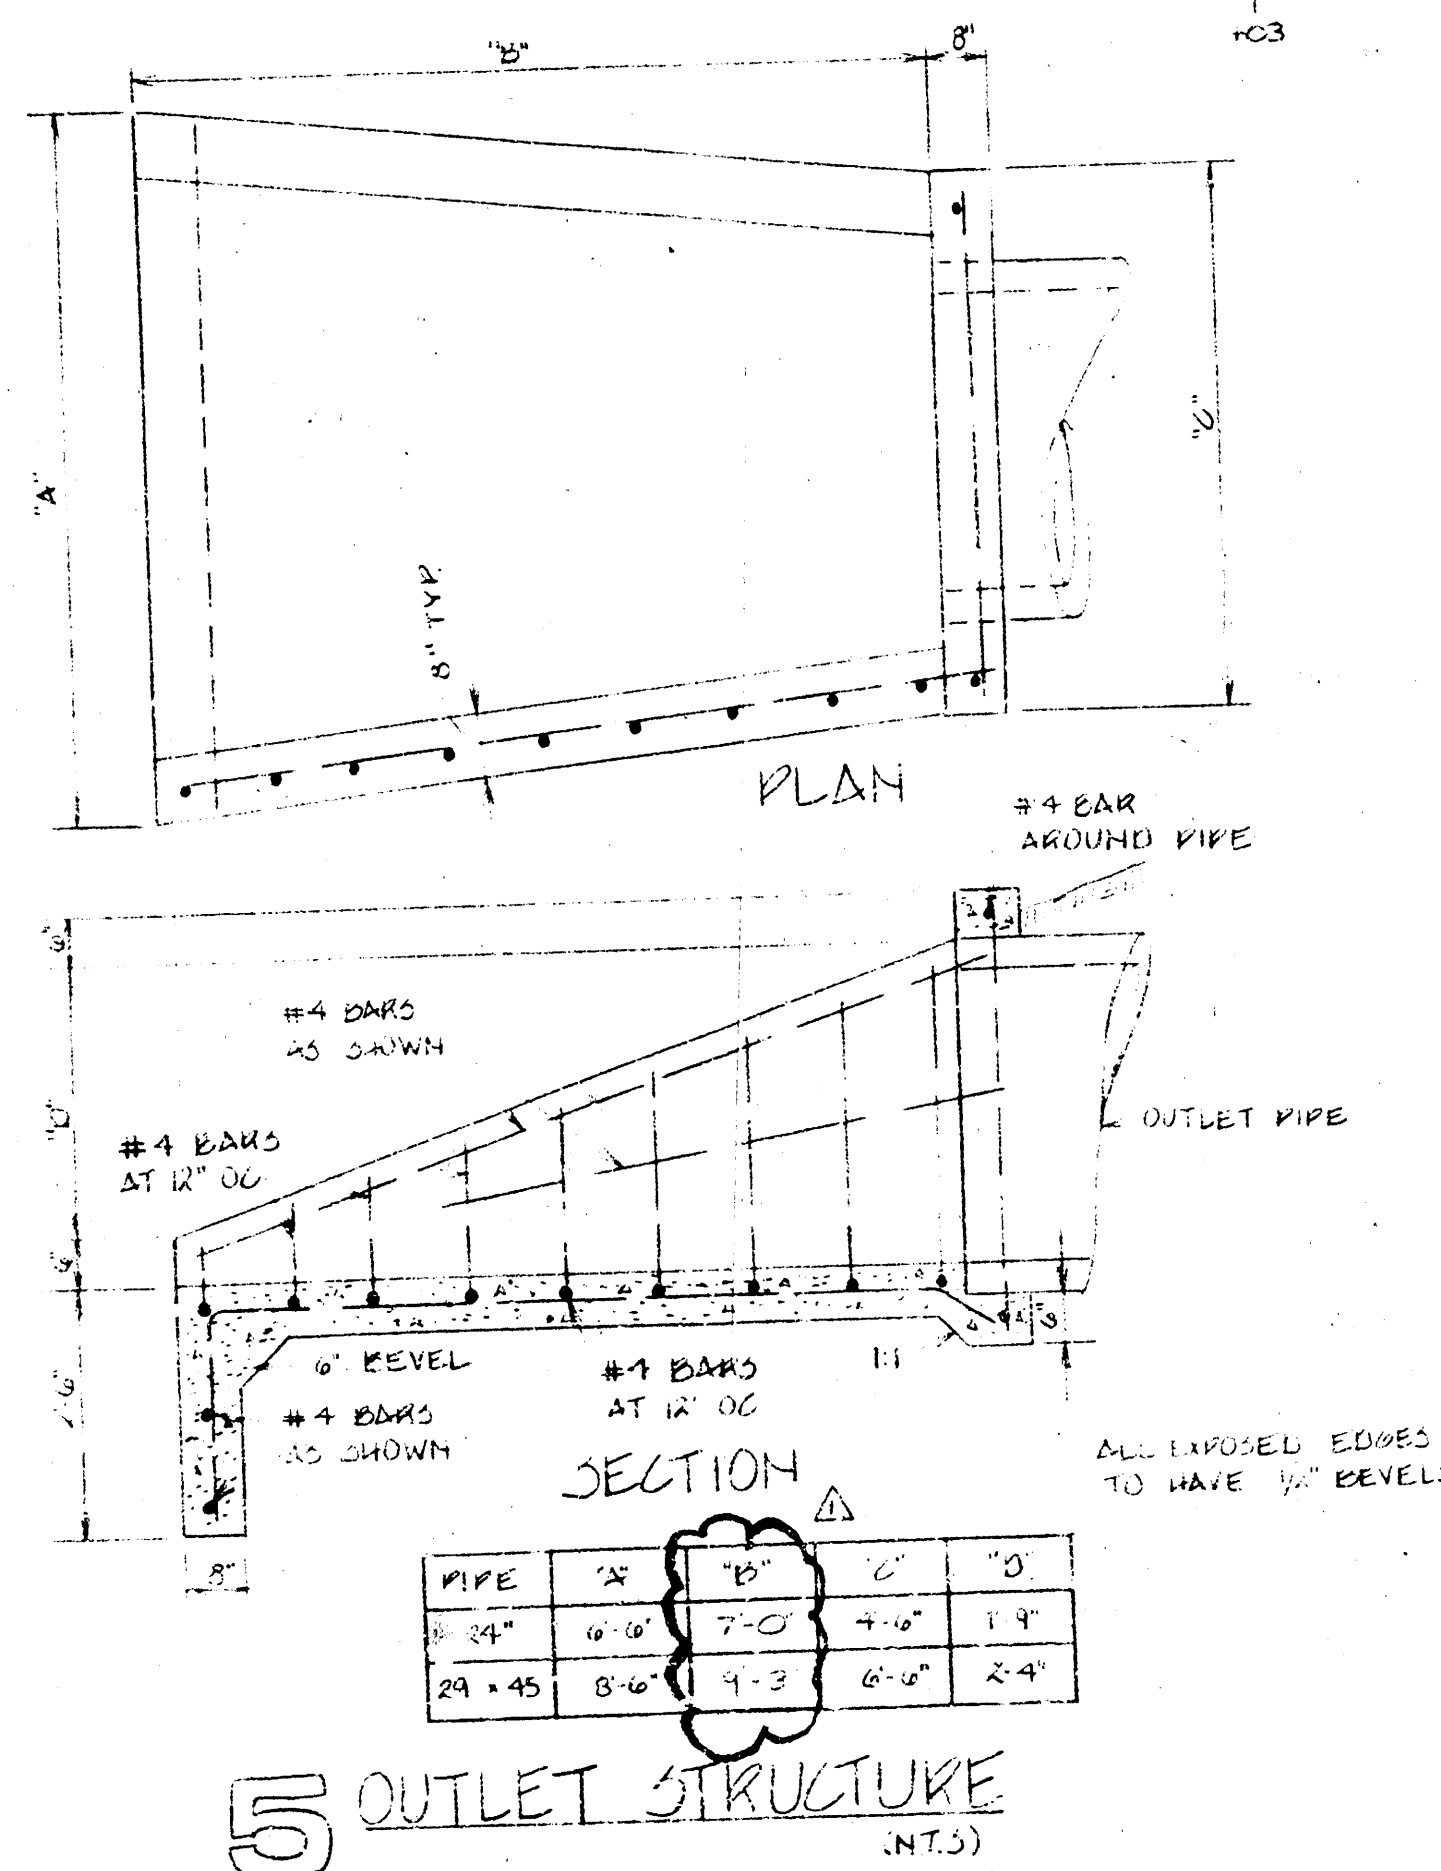
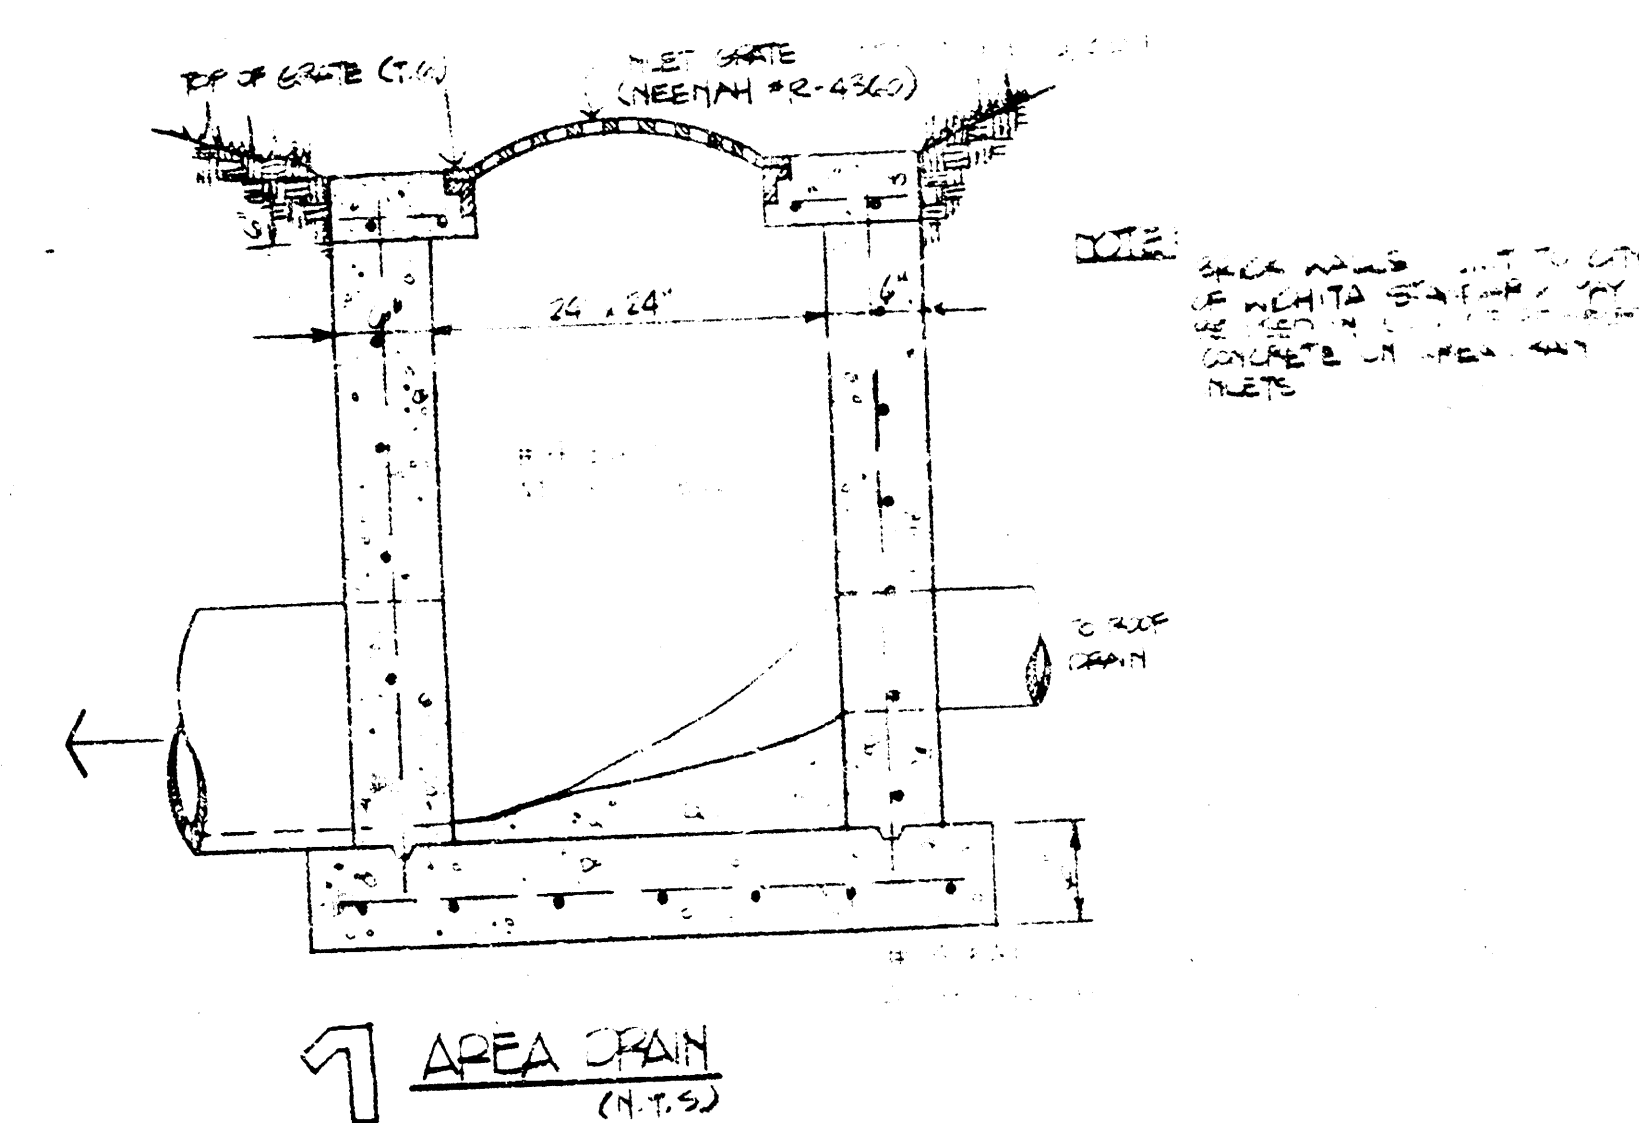


[illegible]

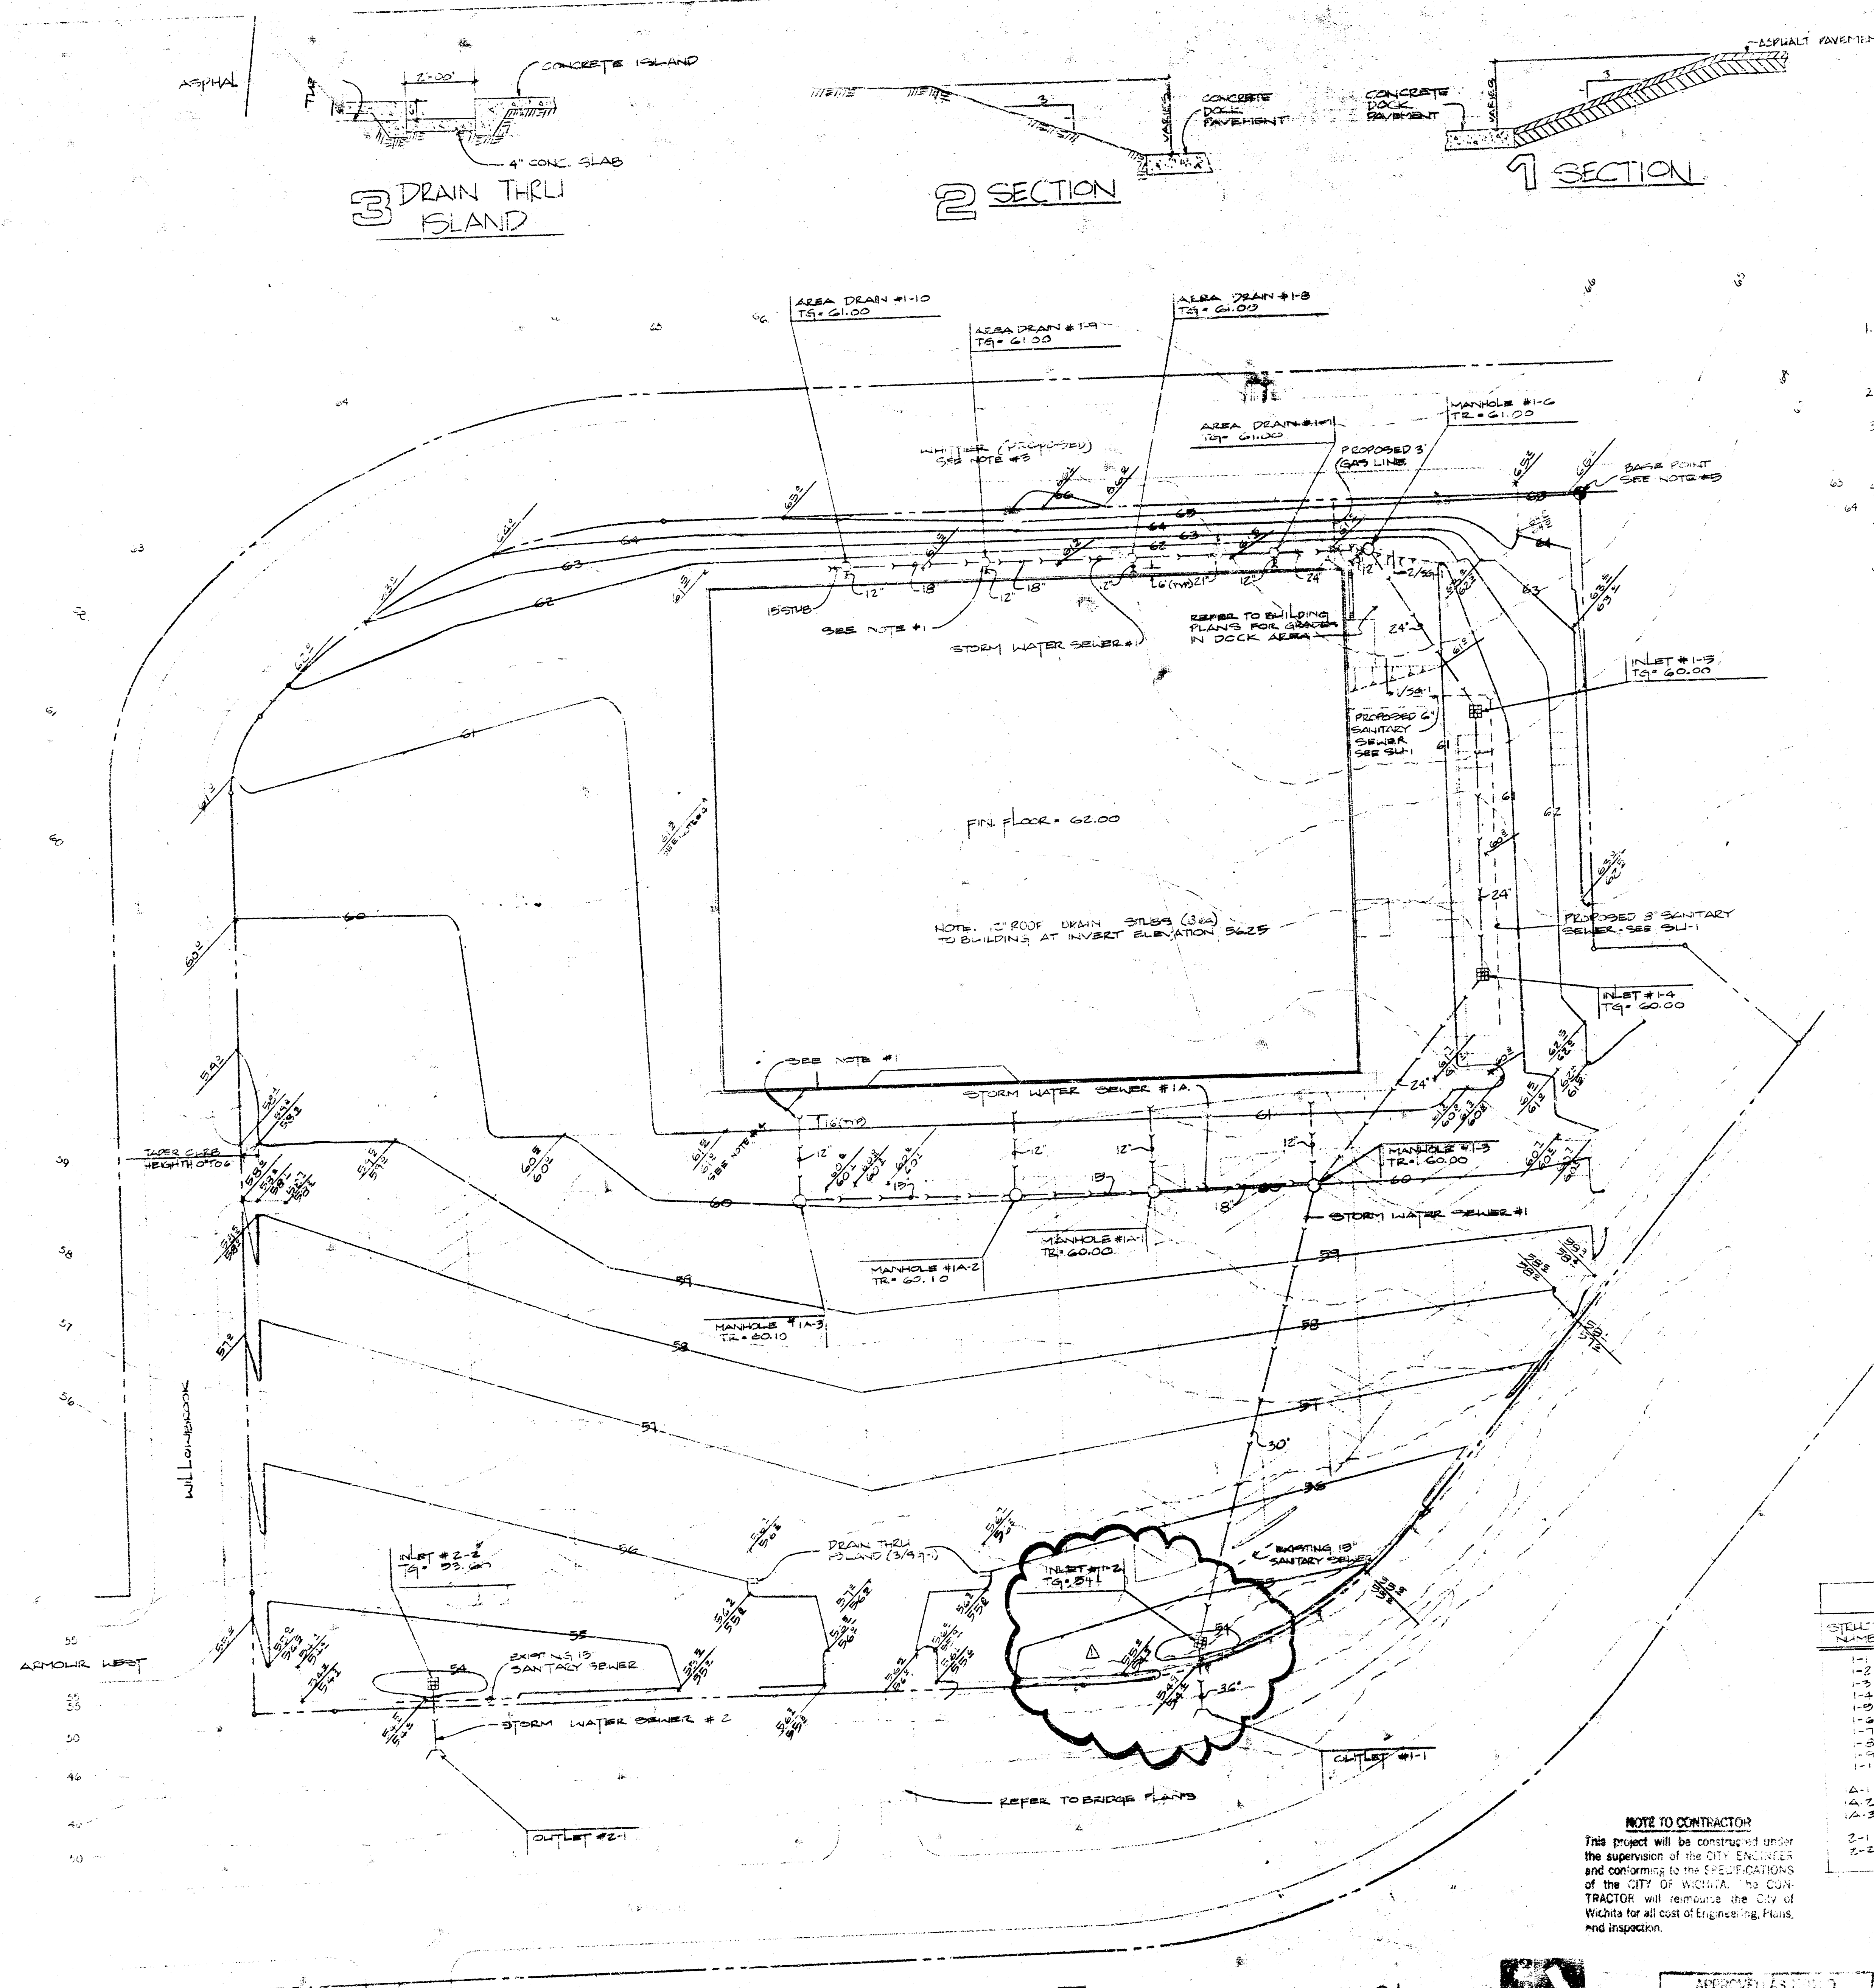

- NOTES**
1. CONTRACTOR TO VERIFY (COORDINATE) EXACT LOCATION OF ROOF DRAIN & DRAIN LINES WITH PLUMBING DRAWINGS & MAKE ADJUSTMENTS AS REQUIRED.
 2. FINISH GRADES SHOWN ARE TO THE TOP OF FINISHED OR GRADED AREA.


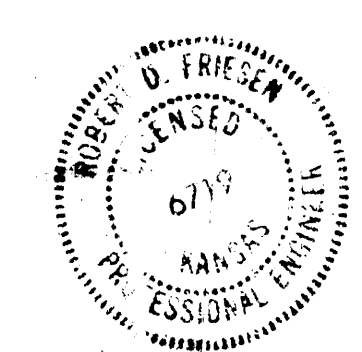

LAW/KINGDON, P.A.
 312 E. MARKET STREET, SUITE 200
 WICHITA, KANSAS 67202




- LEGEND**
- 60 - EXISTING CONTOUR
 - 62 - NEW CONTOUR
 - 62.00 - NEW SPOT ELEVATION
 - 12" - DRAIN INLET
 - 12" - AREA DRAIN
 - 12" - MANHOLE
 - 12" - STORM WATER SEWER

STRUCTURE NUMBER	TYPE OF DETAIL	SIZE	LOCATION	ELEVATION

NOTE TO CONTRACTOR
 This project will be constructed under the supervision of the CITY ENGINEER and conforming to the SPECIFICATIONS of the CITY OF WICHITA. The CONTRACTOR will reimburse the City of Wichita for all cost of Engineering, Plans, and Inspection.

A SITE GRADING AND STORM WATER SEWER PLAN

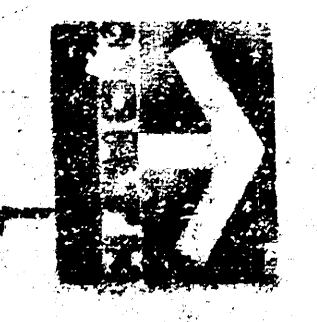

APPROVED AS SHOWN
 By CITY ENGINEER

TARGET EAST
 Wichita, Kansas
 PROJECT NUMBER 7881

SITE GRADING PLAN
 SHEET NO. 1
SG-1