

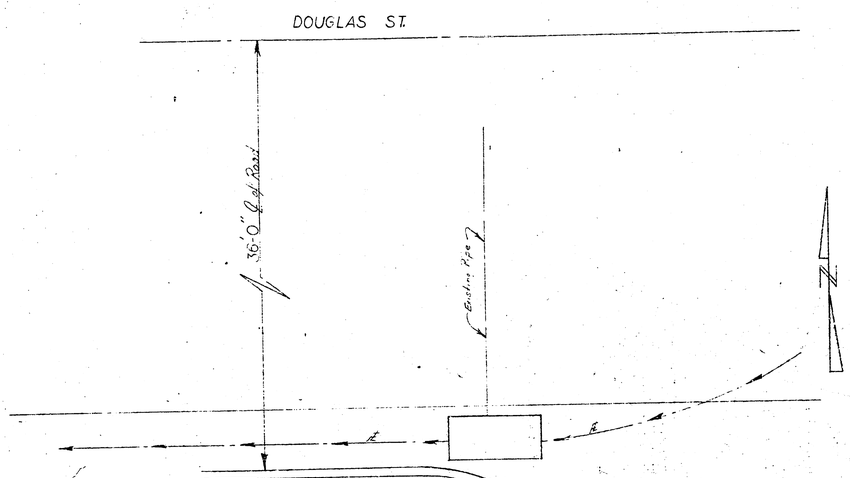


WEST ENTRANCE PIZZA HUT CORPORATE OFF.
9111 EAST DOUGLAS
WICHITA, KANSAS

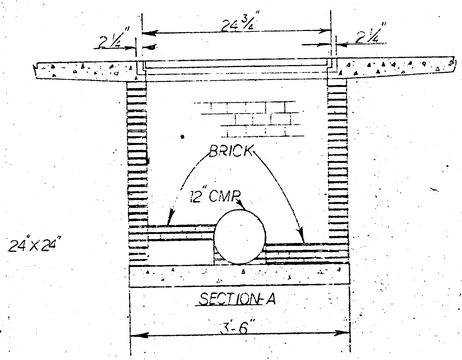

GRATES ARE 24"X24"

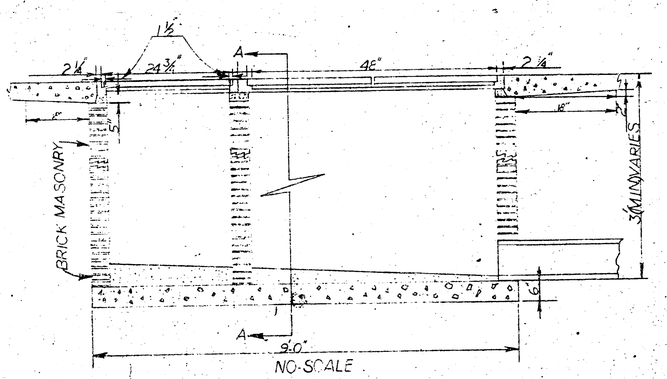

DROP
NOTE - TRIPLE 2X2 INLET PER CITY OF WICHITA SPECS.

APPROVED AS NOTED
By CITY OF WICHITA
Sanitary Sewers
Storm Sewers Yerkes 11/9/78
Property Acquisition

NOTE TO CONTRACTOR
This project will be ... the supervision of the CITY ENGINEER ... and conformance to the SPECIFICATIONS ... of the CITY OF WICHITA ... Work ... and by ...

CITY OF WICHITA PROJECT NO.
468 72 80657 000 000 006

UTILITY CONTRACTORS, INC.
939 NORTH MARKET - P.O. BOX 3099
WICHITA, KANSAS 67201

PIZZA HUT CORP.
STORM SEWER CONST.

JOB #
BY: J.A. BONFANTE
DATE: NOV. 78
SCALE: AS SHOWN

10 2 44