


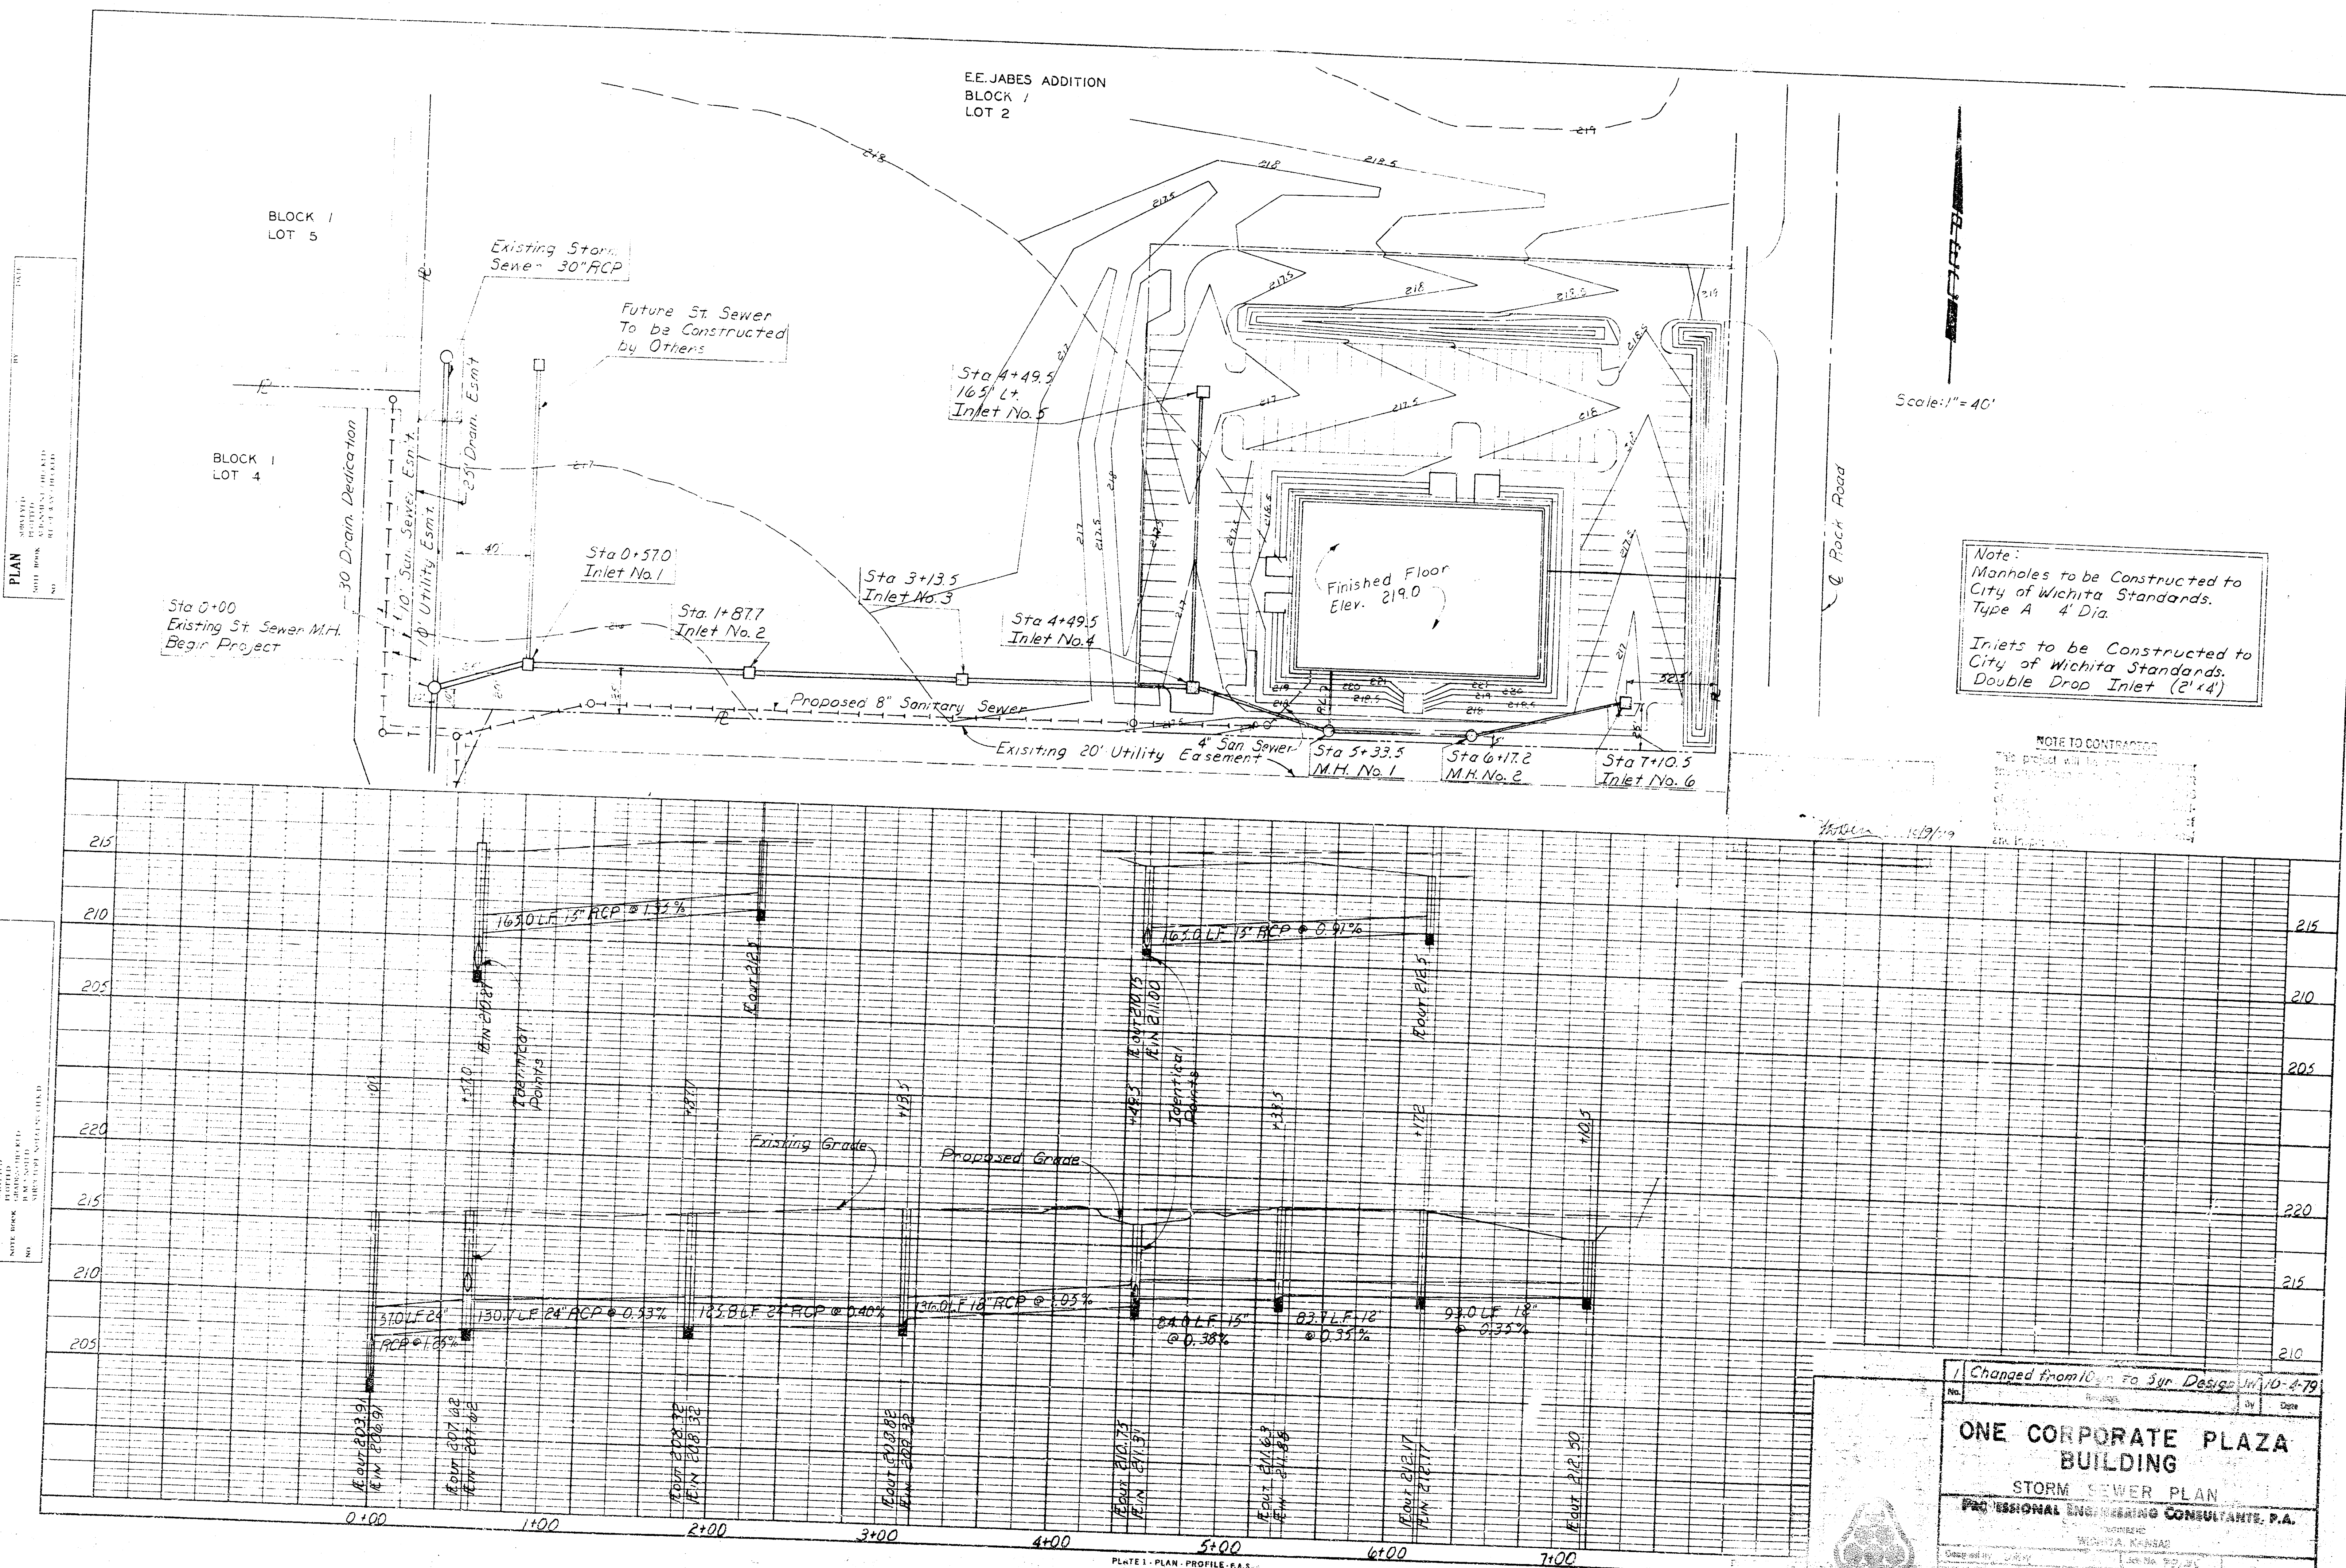

Note:
Manholes to be Constructed to
City of Wichita Standards.
Type A 4' Dia.
Inlets to be Constructed to
City of Wichita Standards.
Double Drop Inlet (2'x4')

Changed from 10" to 8" Syn. Design 10-4-79


ONE CORPORATE PLAZA BUILDING

STORM SEWER PLAN

PROFESSIONAL ENGINEERING CONSULTANTS, P.A.

WICHITA, KANSAS

Scale: 1" = 40'

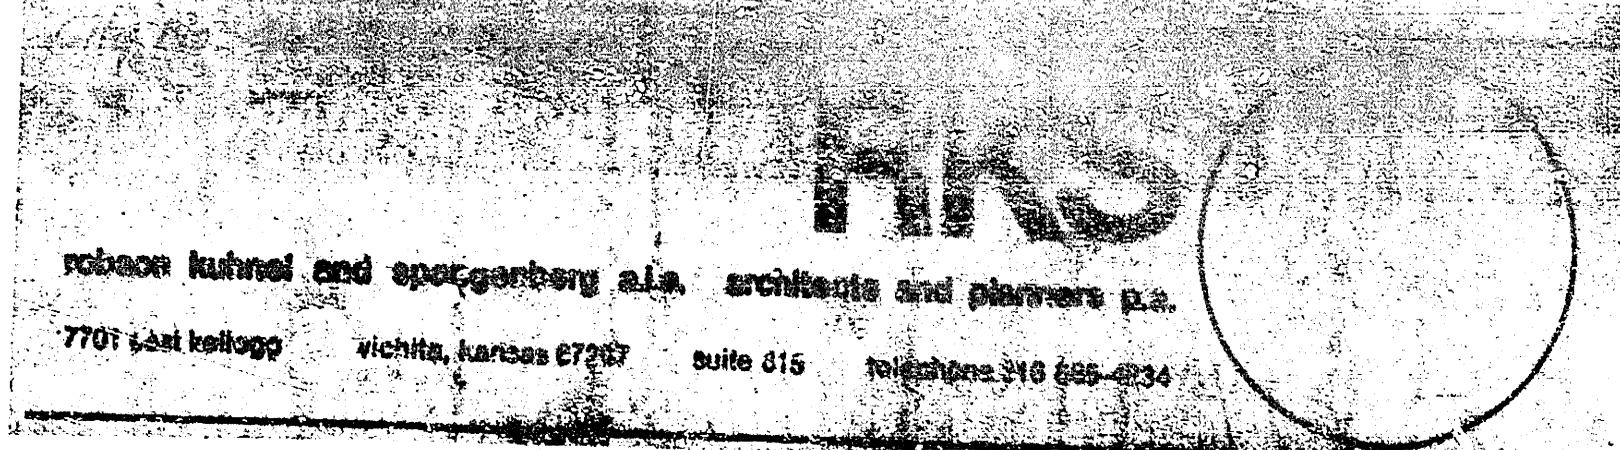

AVAILABLE COPY... FILMED FROM THE BEST