



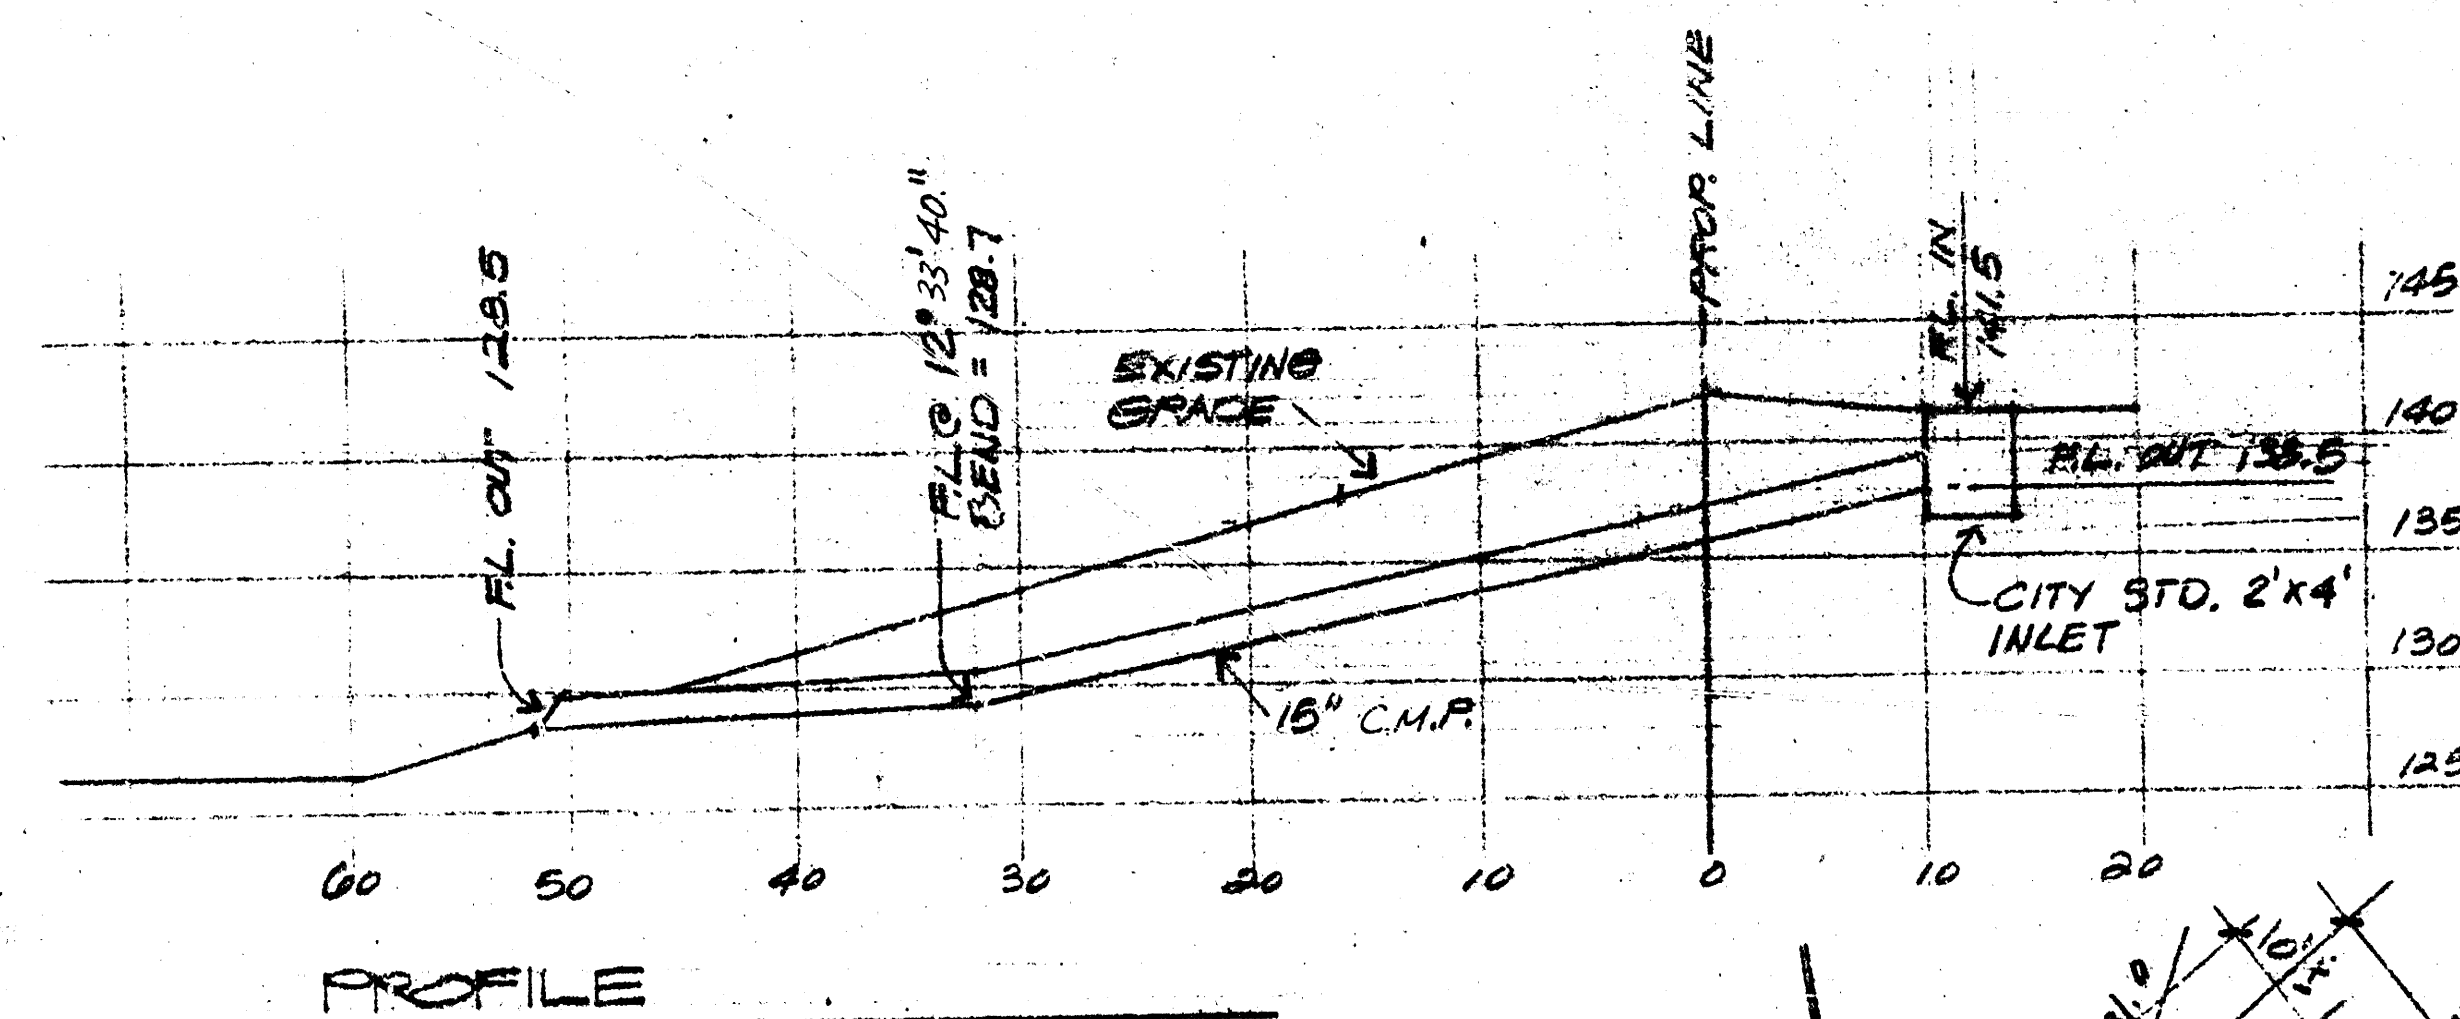

APPROVED AS NOTED
By CITY ENGINEER OF WICHITA
Sanitary Sewers
Storm Sewers
Driveway Approaches

NOTE TO CONTRACTOR
This project will be under the supervision of the City Engineer of Wichita and conforming to the City of Wichita standards and specifications.

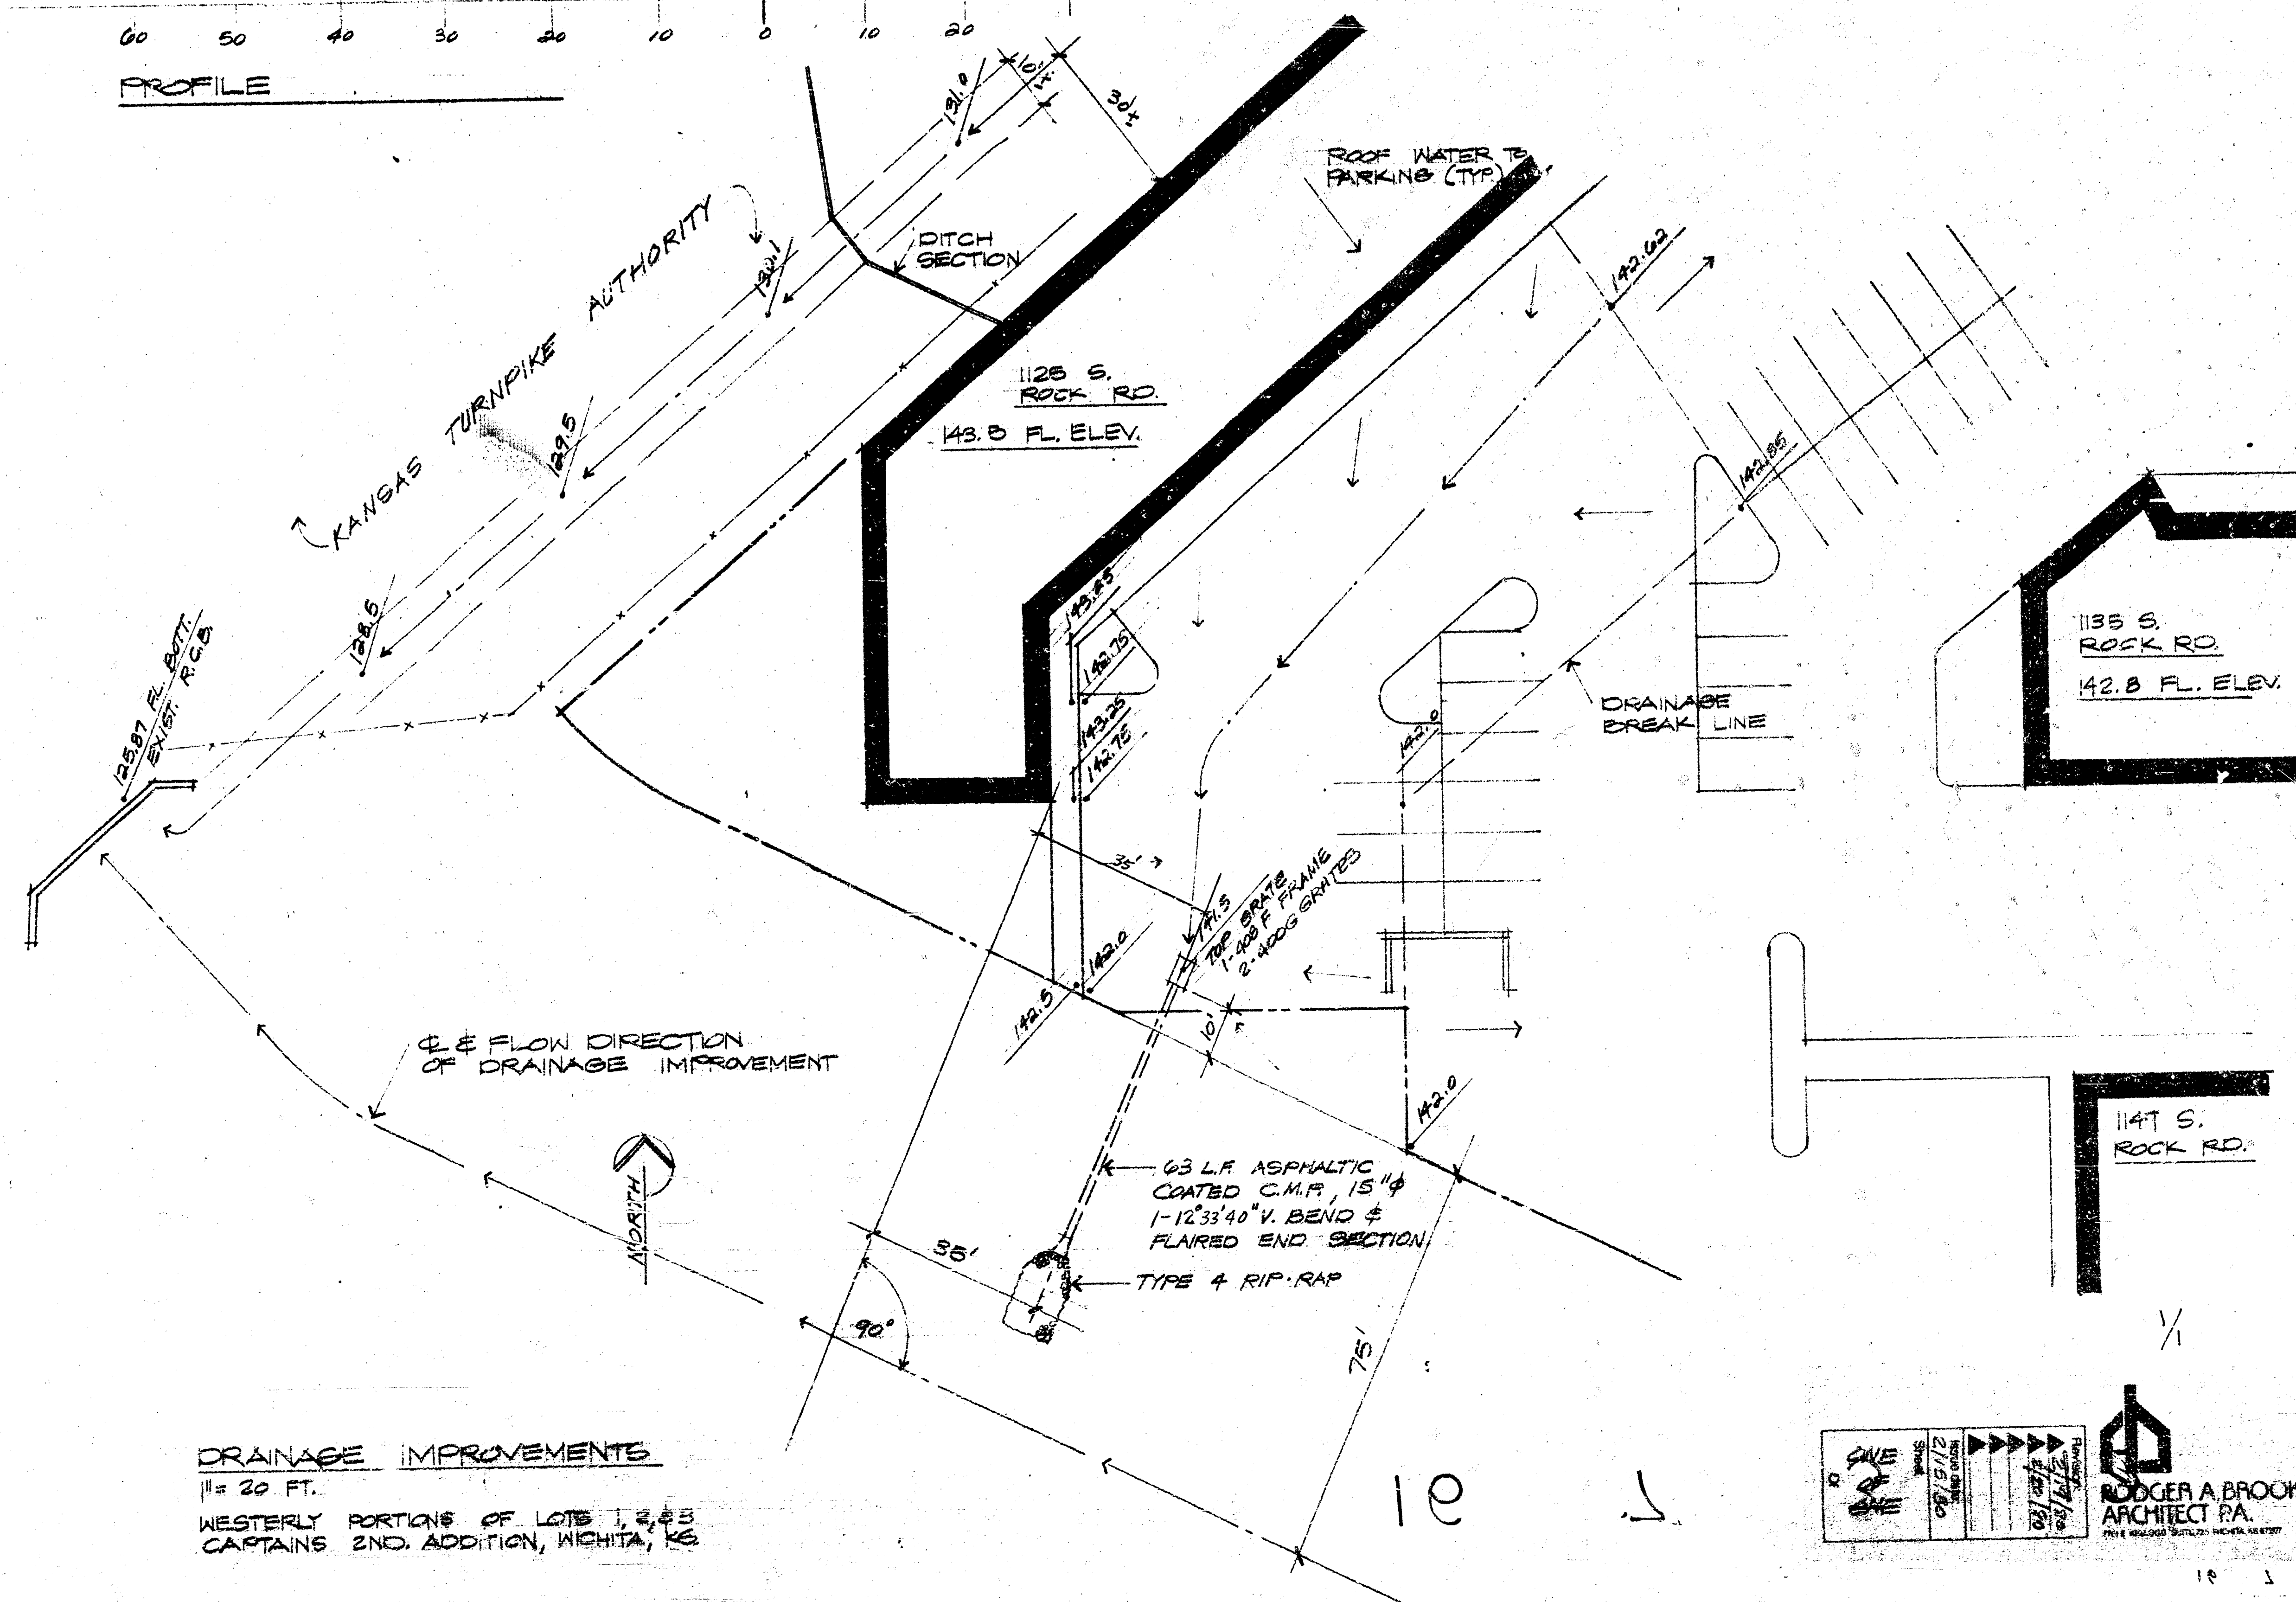

DRAINAGE IMPROVEMENTS
1" = 20 FT.
WESTERLY PORTIONS OF LOTS 1, 2, & 3
CAPTAINS 2ND ADDITION, WICHITA, KS

RODGER A. BROOKS
ARCHITECT P.A.
