



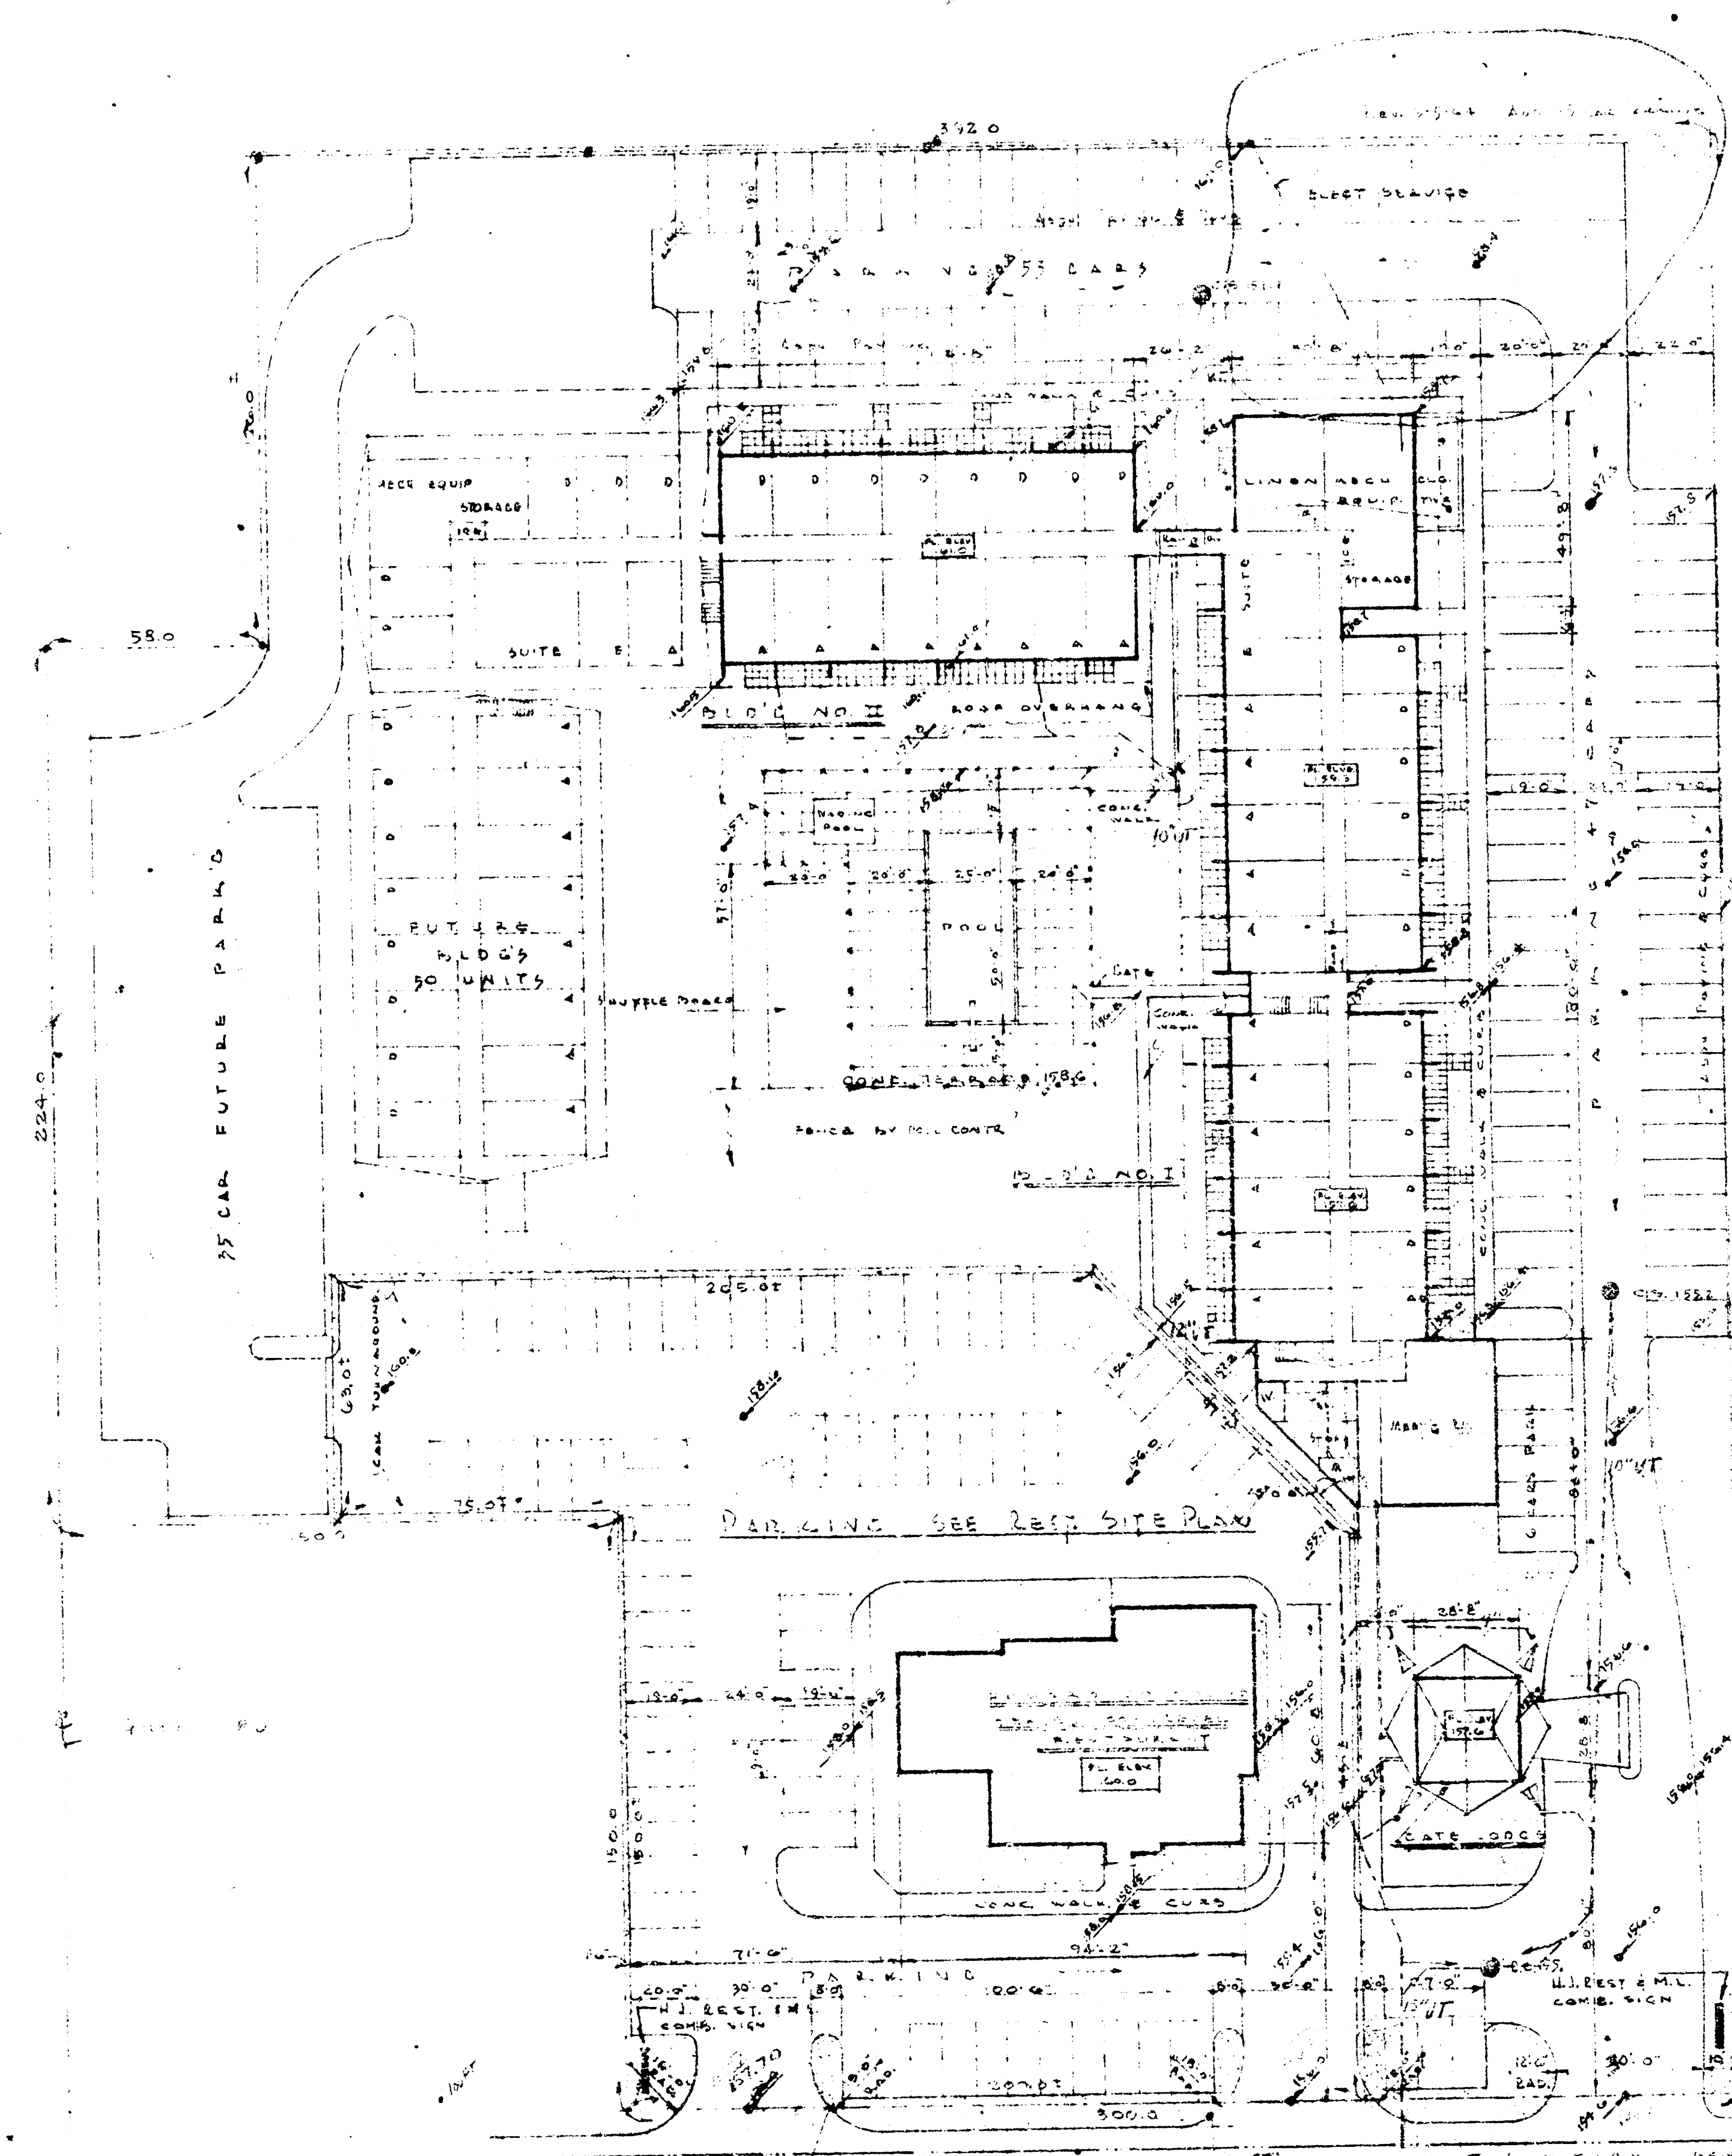

- NOTES:**
1. SET ALL BUILDINGS PARALLEL ON AT RIGHT ANGLES TO DUTY PROPERTY LINE AT EAST & SOUTHEAST CORNER OF LOT 1.
 2. CONTRACTORS SHALL GET APPROVAL FROM LOCAL AND STATE HIGHWAY AUTHORITIES FOR ANY LANDSCAPE WORK OR GRADING BETWEEN PROPERTY LINE & HIGHWAY.
 3. VERIFY SIGN, DRIVEWAY PAVING & GRADING WITH RESTAURANT DRAWINGS.
 4. FORD ELEVATIONS ON CURBS IN ACCORDANCE TO TYPICAL DRAWINGS.
 5. THERE ARE IRON TIES & ALL LOCATIONS OF PROPERTY.

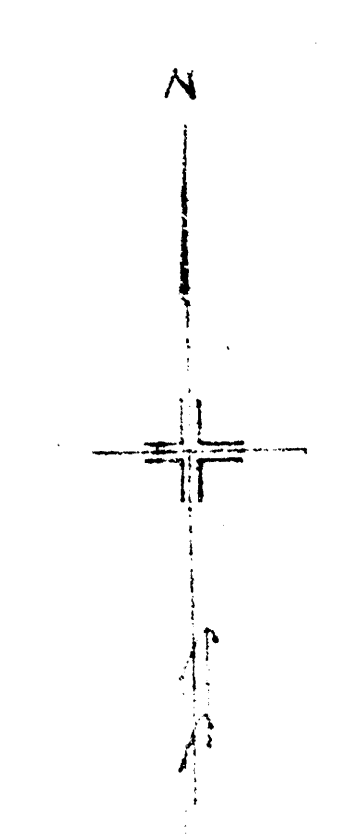

STATE HIGHWAY 2877
TAKEN FROM SOUTH SIDE
AT N.W. CORNER OF LOT 1
AT CORNER 1241.15

PLOT PLAN	
SCALE 1"=50'	
SUBMITTAL NO. 2	
REVISIONS	
NO.	DATE
1	5-9-54
RICHARD A. KELLER, ARCHT. & ENGR. 1224 SUPERIOR BUILDING CLEVELAND 15, OHIO	

F.L. OF 15" TILE AT DITCH
1541.79
FILLING BE PROVIDED
42" STORM DRAIN 1540.65