


1. Underground utility service lines and overhead utility pole lines are to be adjusted as necessary by others prior to construction unless the plans specifically call for their adjustment by the Contractor or unless the plans specifically identify a utility to be adjusted by its owner during construction. Existing utilities and their location, as shown on the plans, represent the best information obtainable for design. Location information has been obtained from the various utility companies and is either from company records, drawings or company field locations. The Contractor will be required to work around existing utilities within the right-of-way which do not conflict with proposed construction.
2. The Contractor shall be responsible for preserving properly irons. The Contractor will be required to re-establish any properly irons which are damaged or destroyed by him during construction operations. Such irons shall be re-established by a licensed land surveyor in accordance with state law.

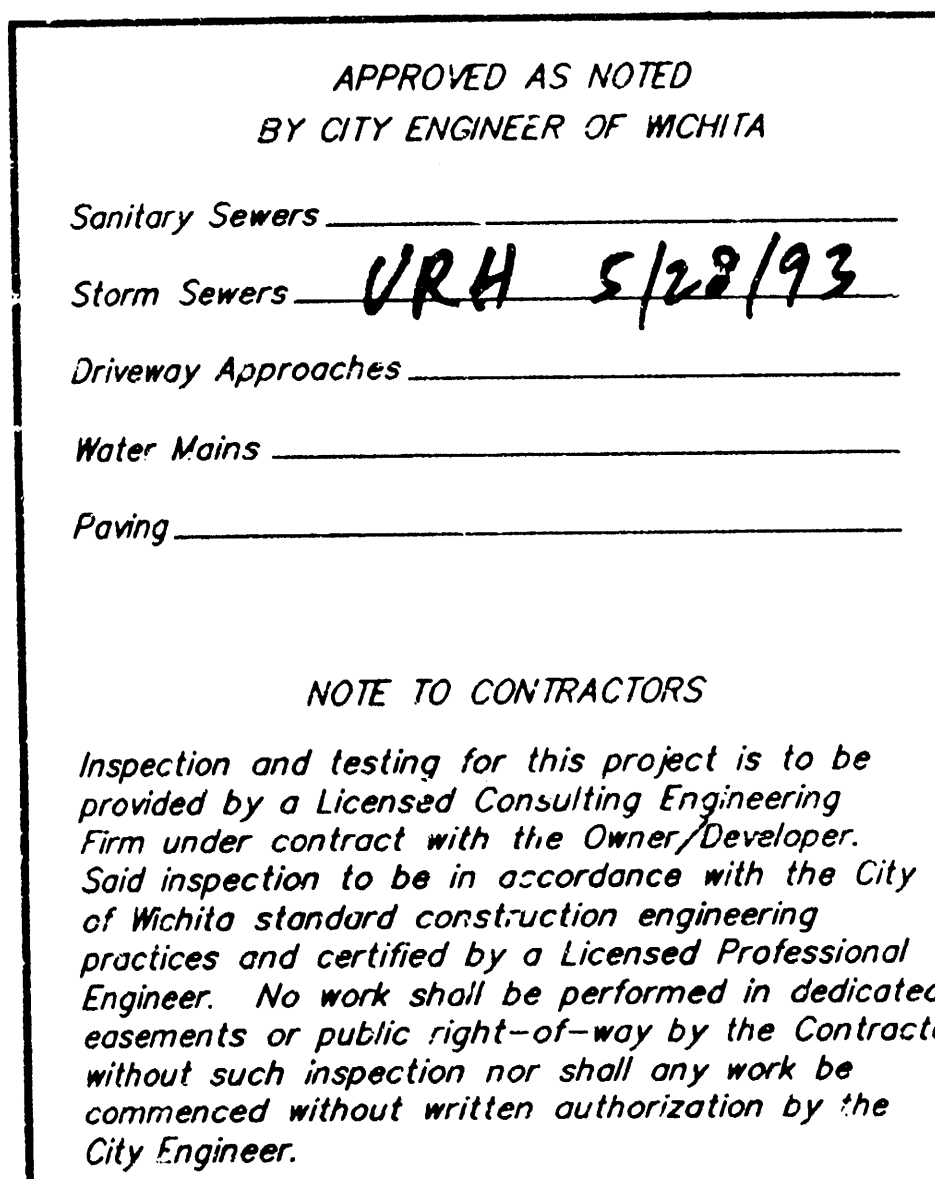

" + " ON TOP OF CURB AT PARKING LOT,
APPROX. 55' N & 35' E OF THE
CENTERLINE INTERSECTION @ WICHITA
AND THIRD STREET.
ELEV. = 111.87 CITY DATUM

