



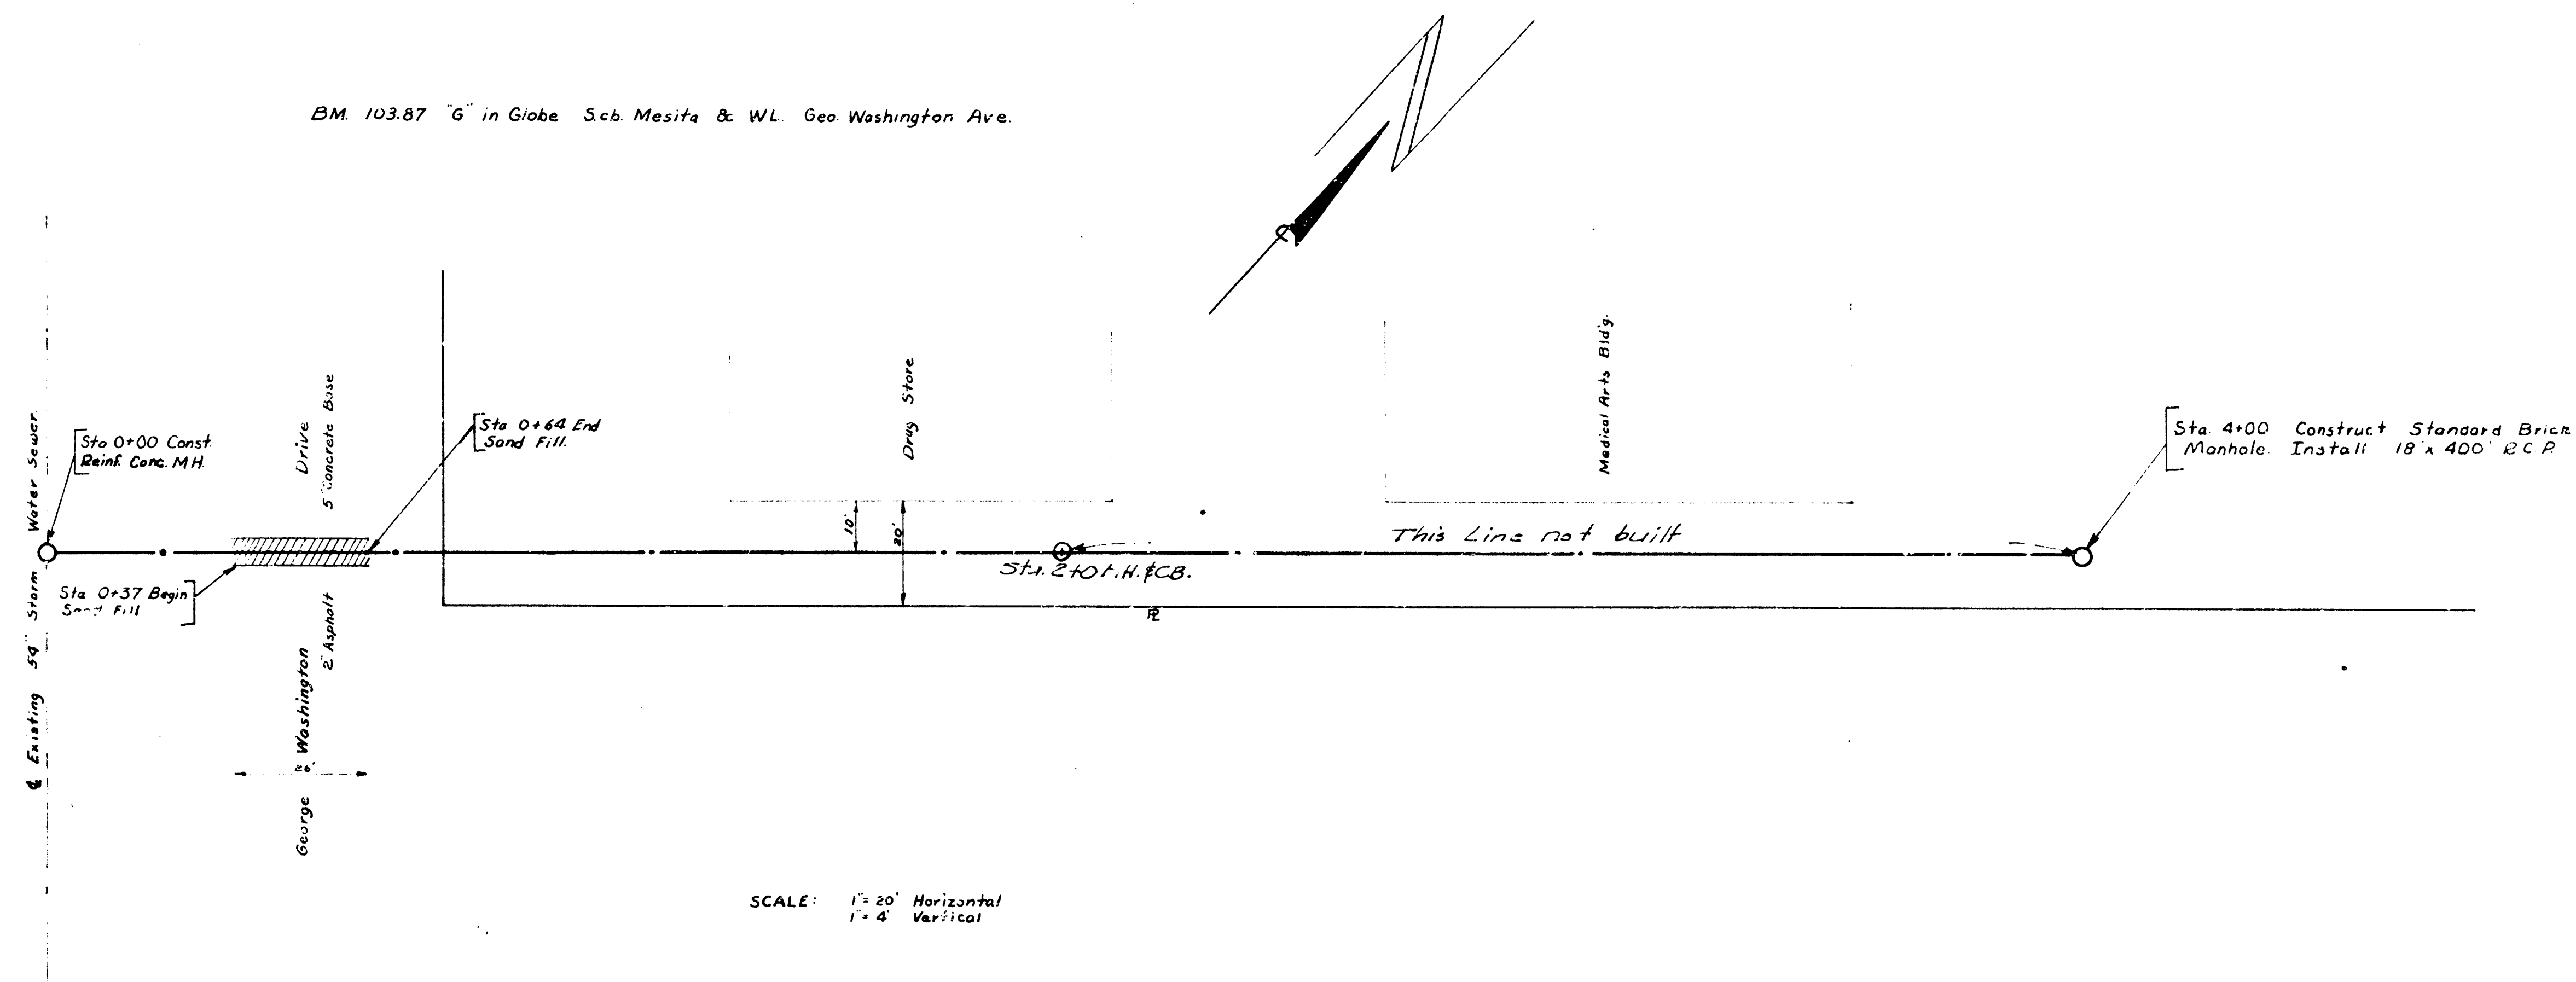

NOTE: Horizontal Scale = 1" = 20'

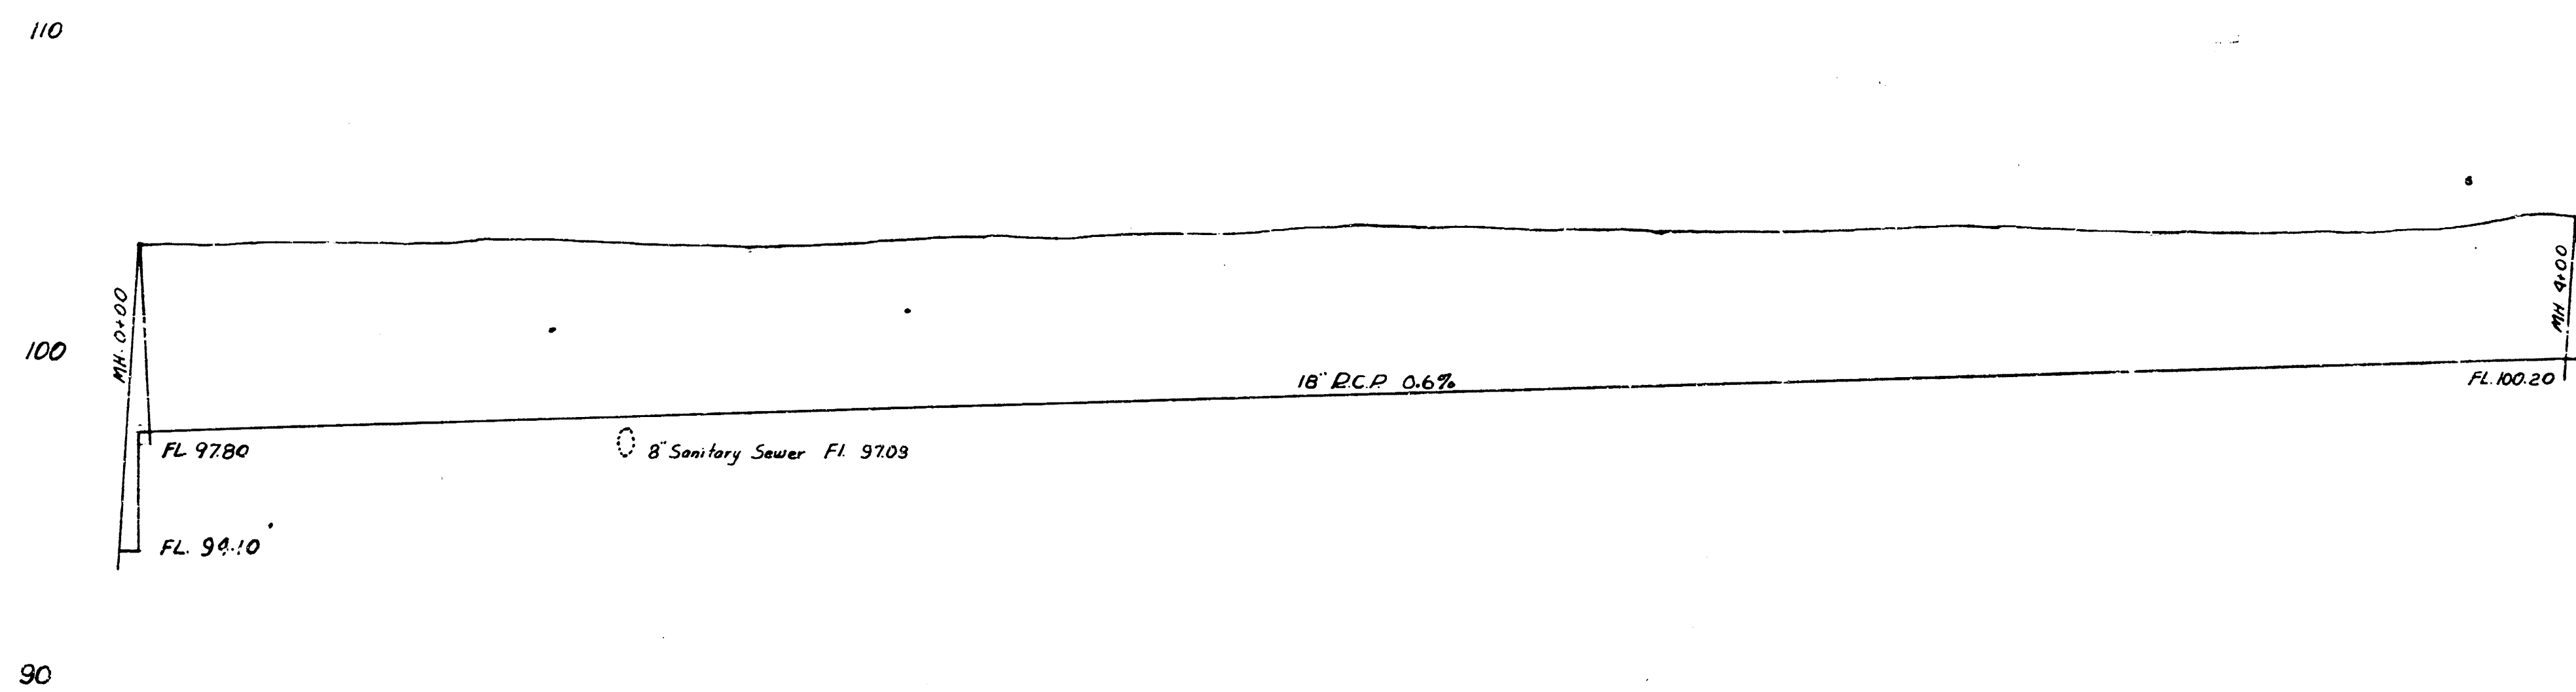

South of Mesita.
Wormer Storm Sewer
City of Wichita, Kansas
L.K. White, City Engineer
1950