


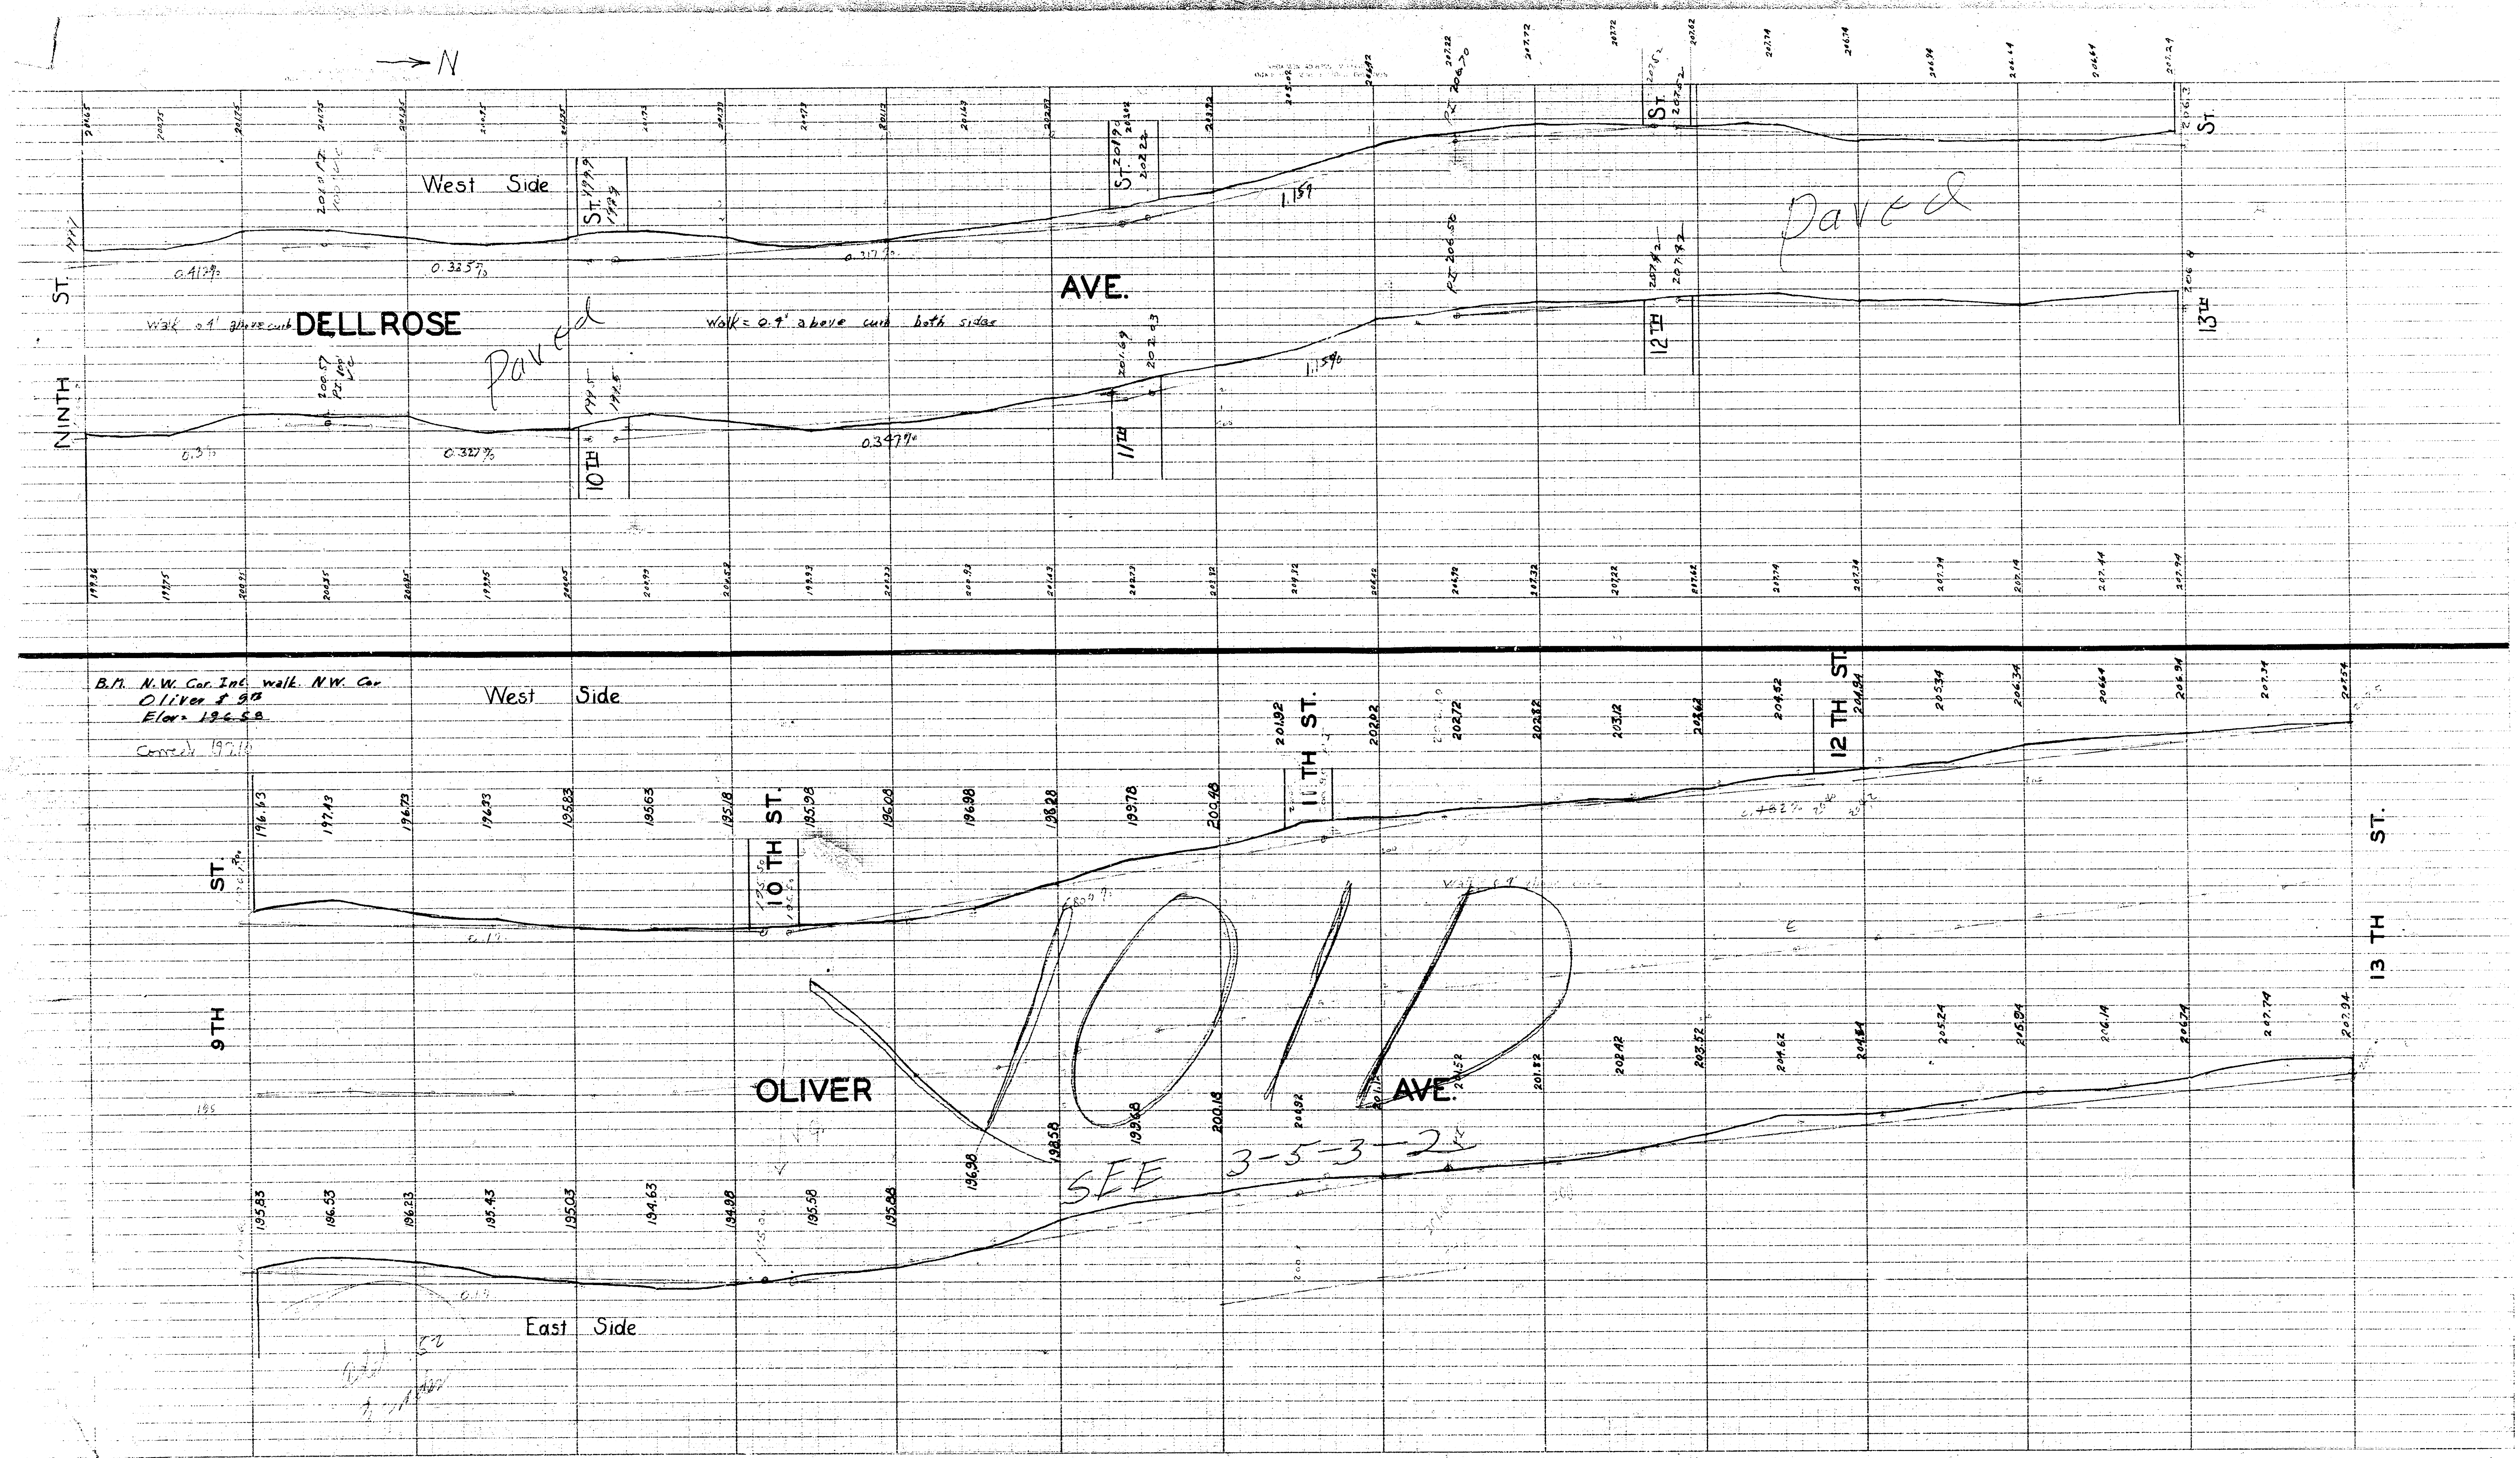

24-L