


13-S

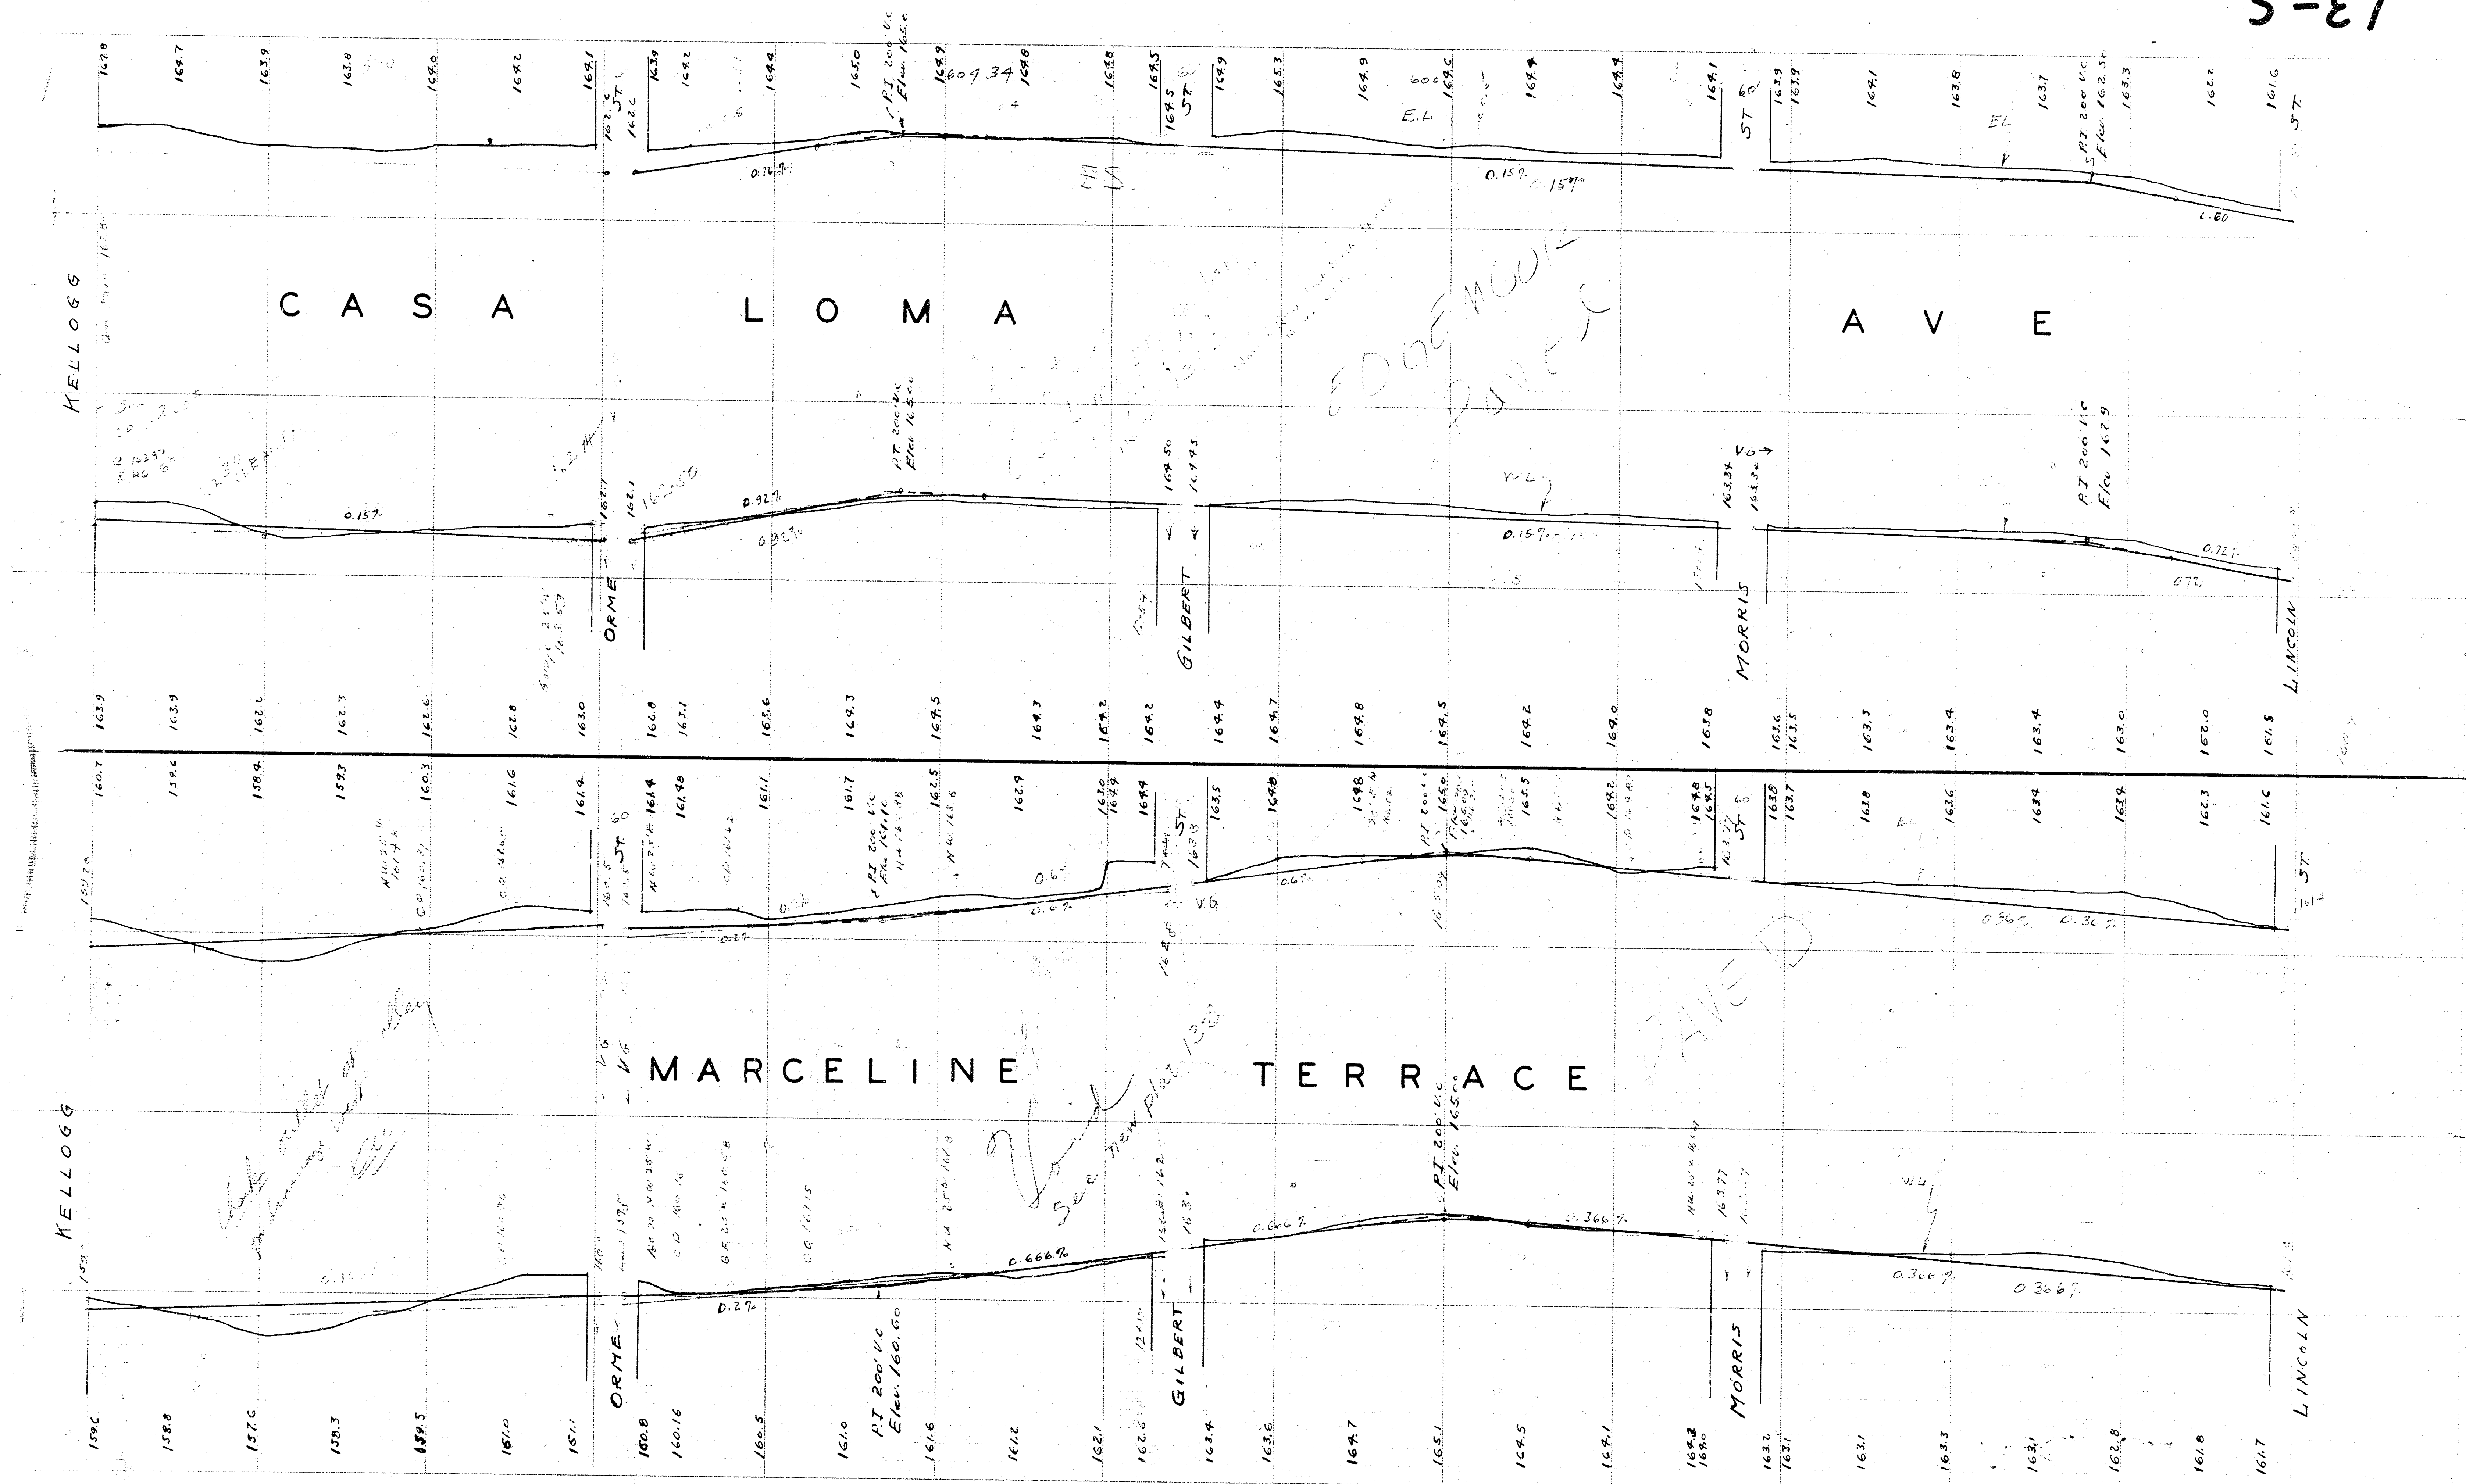

13-S