


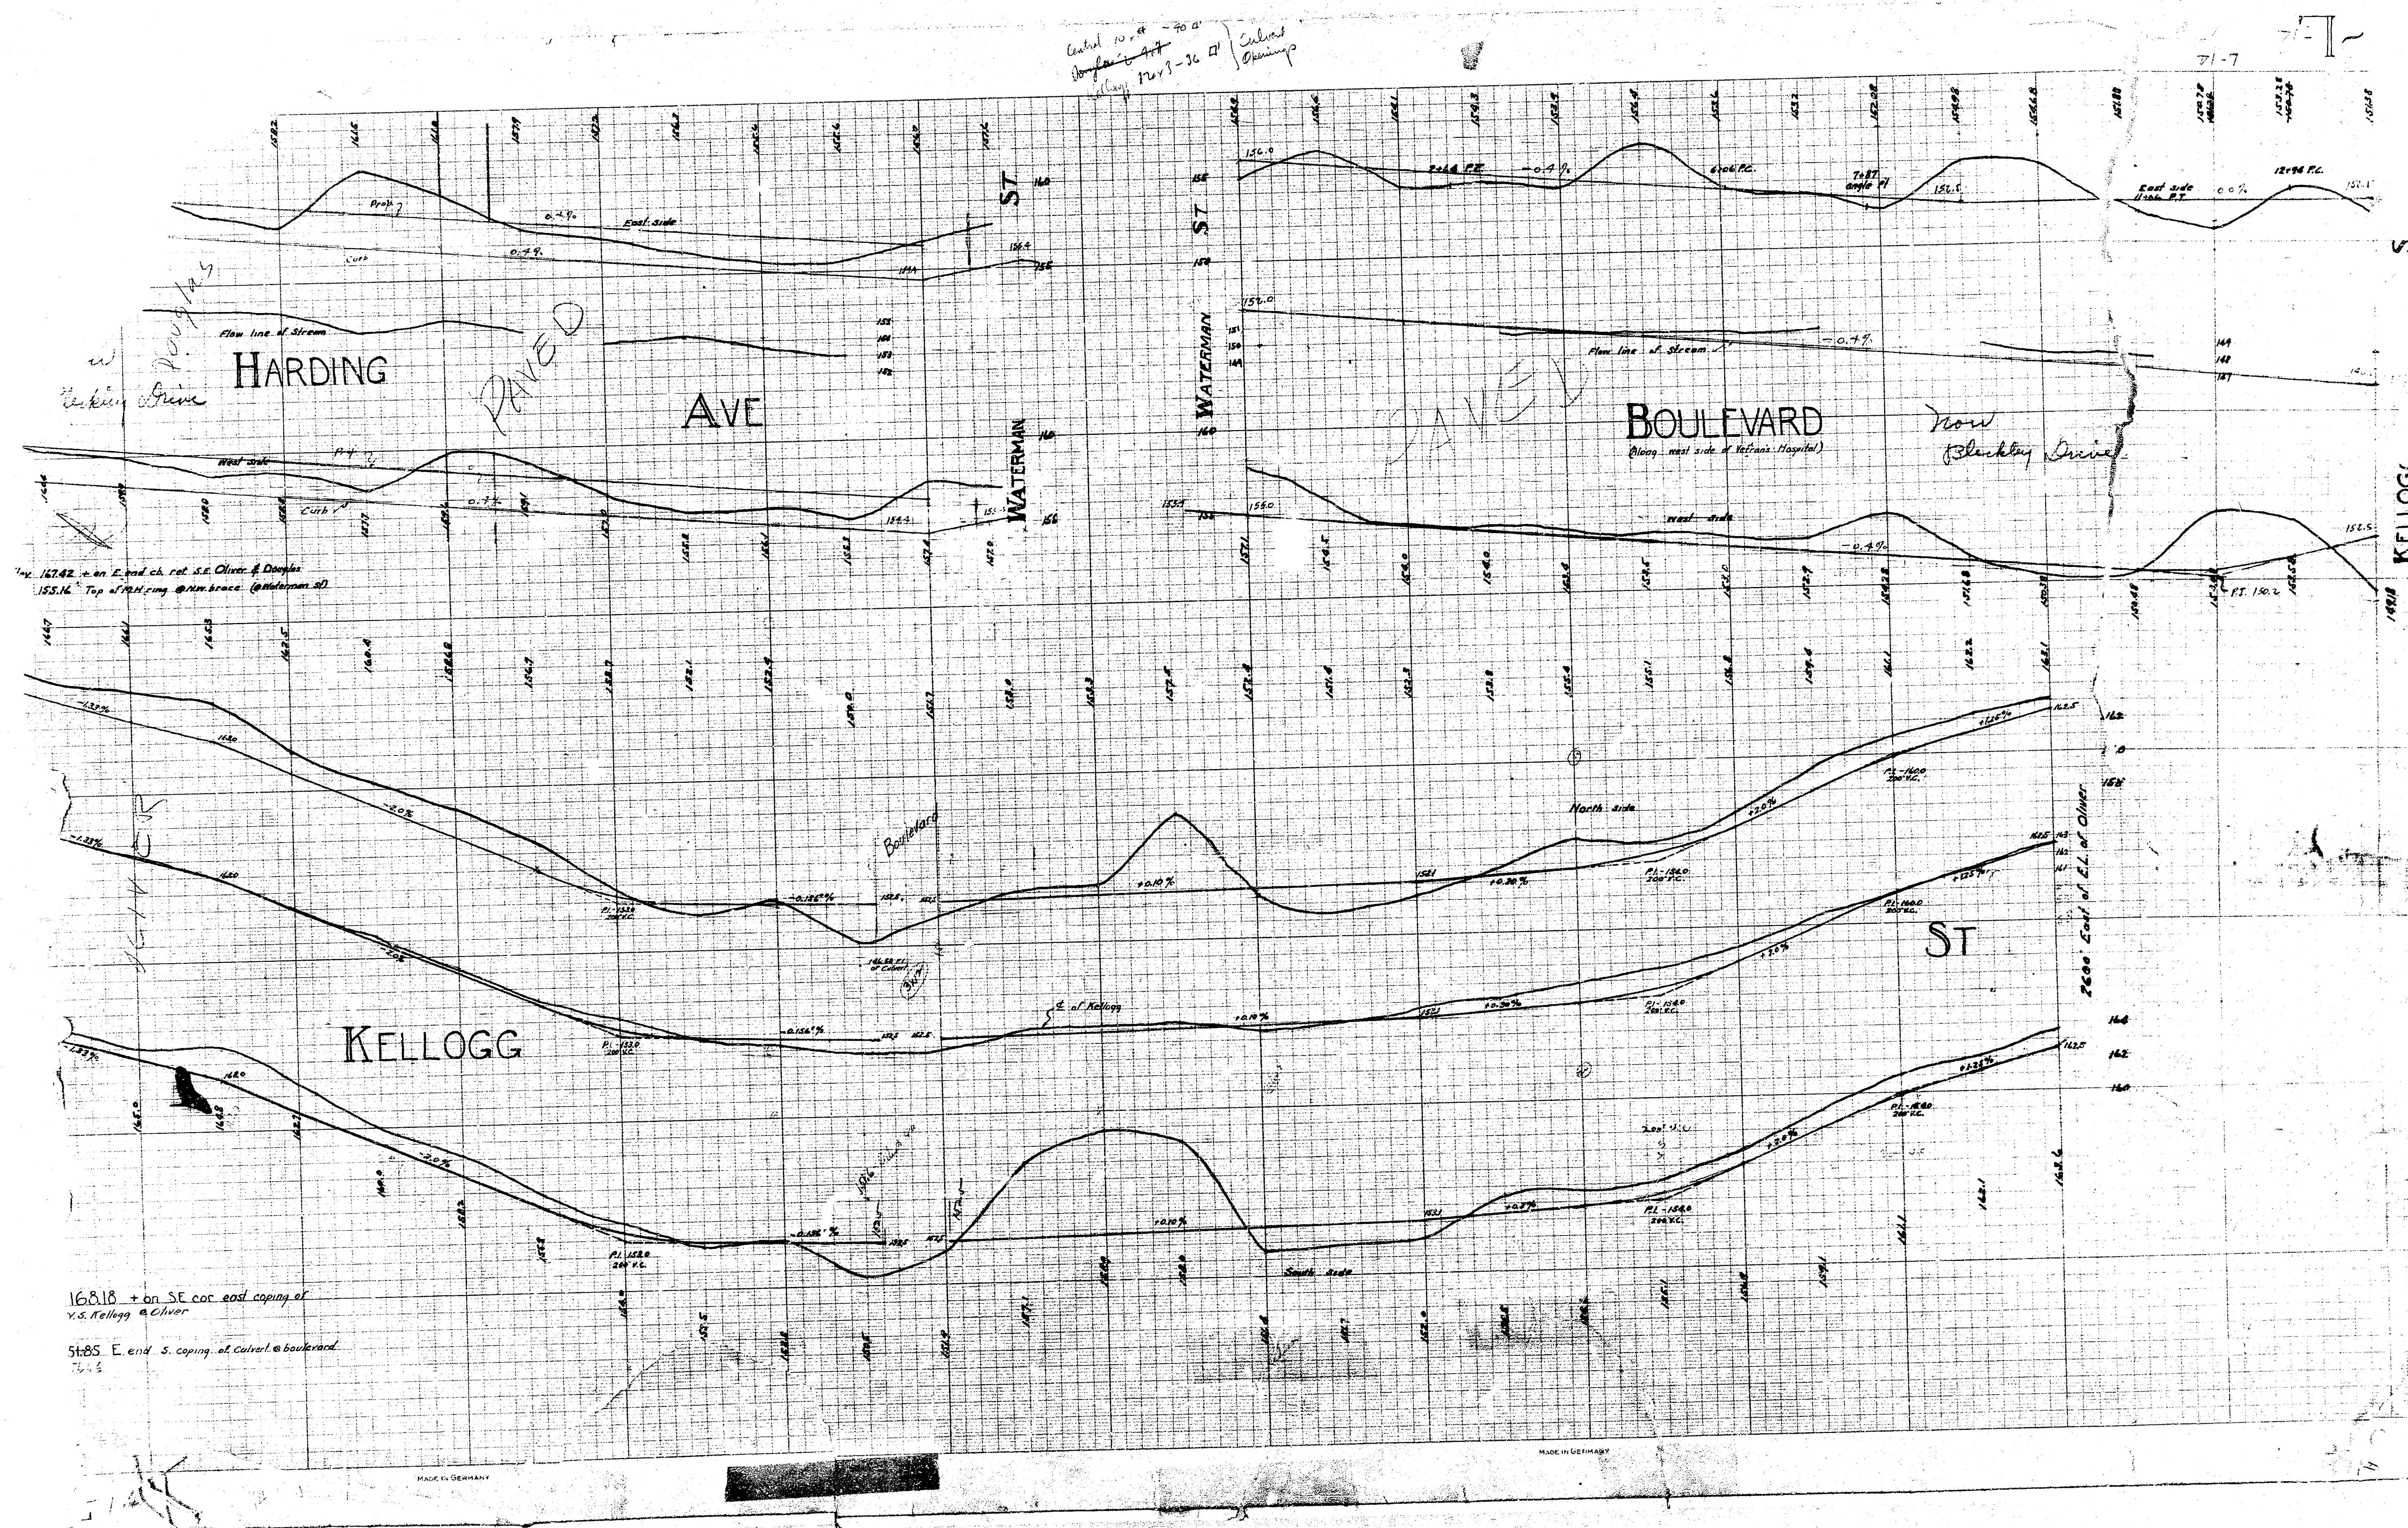

COPIES
5-12-10