



 


12

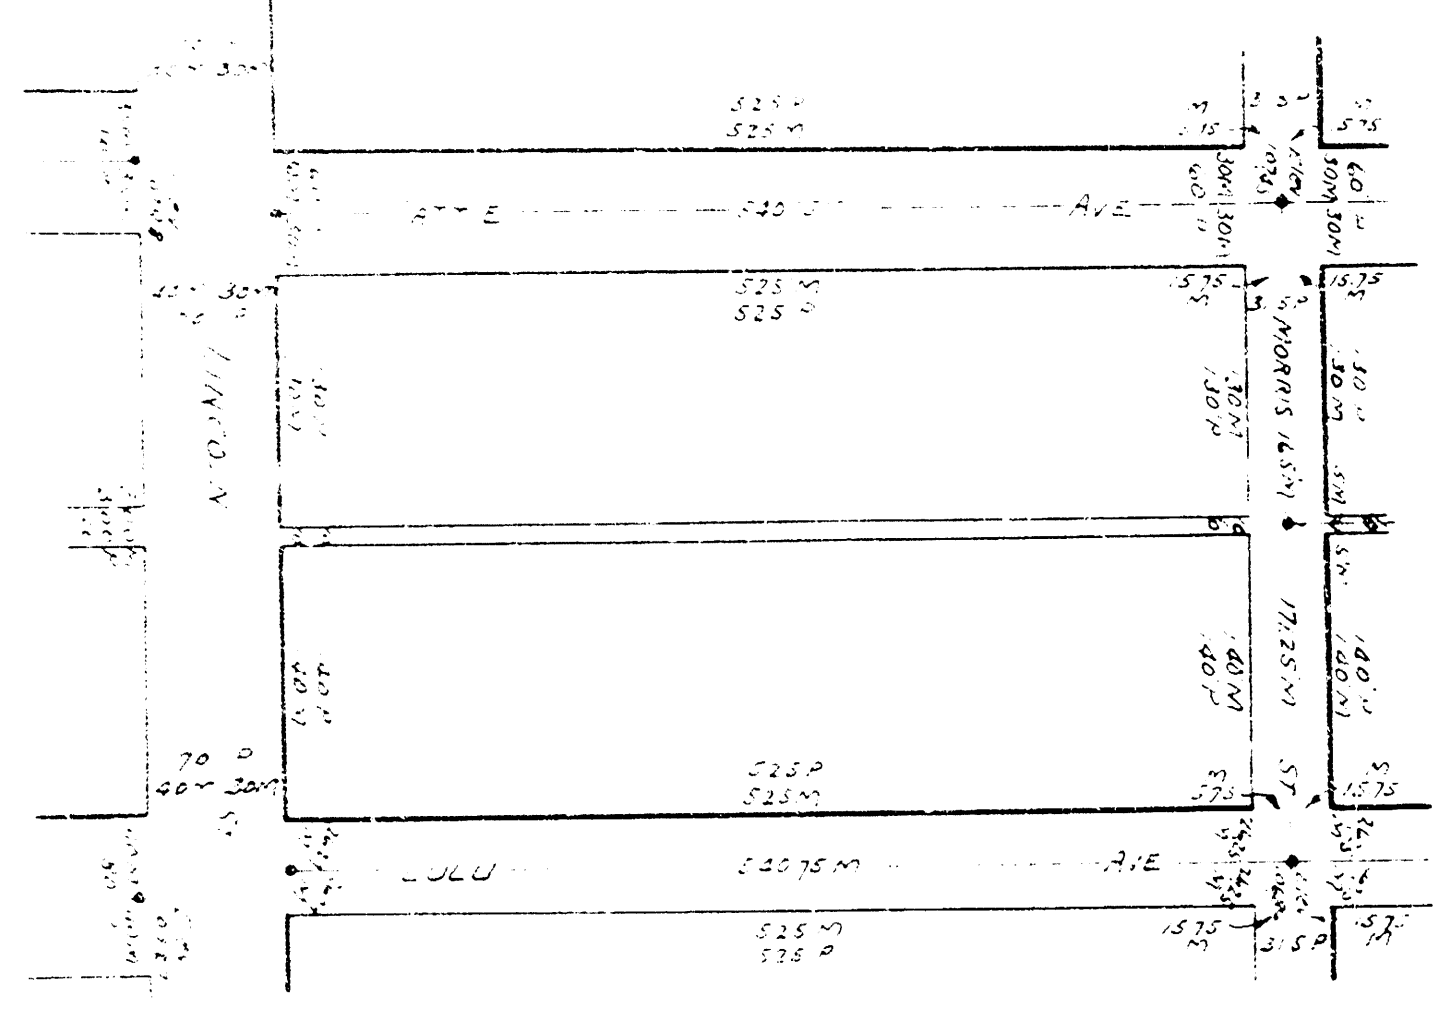


13



14

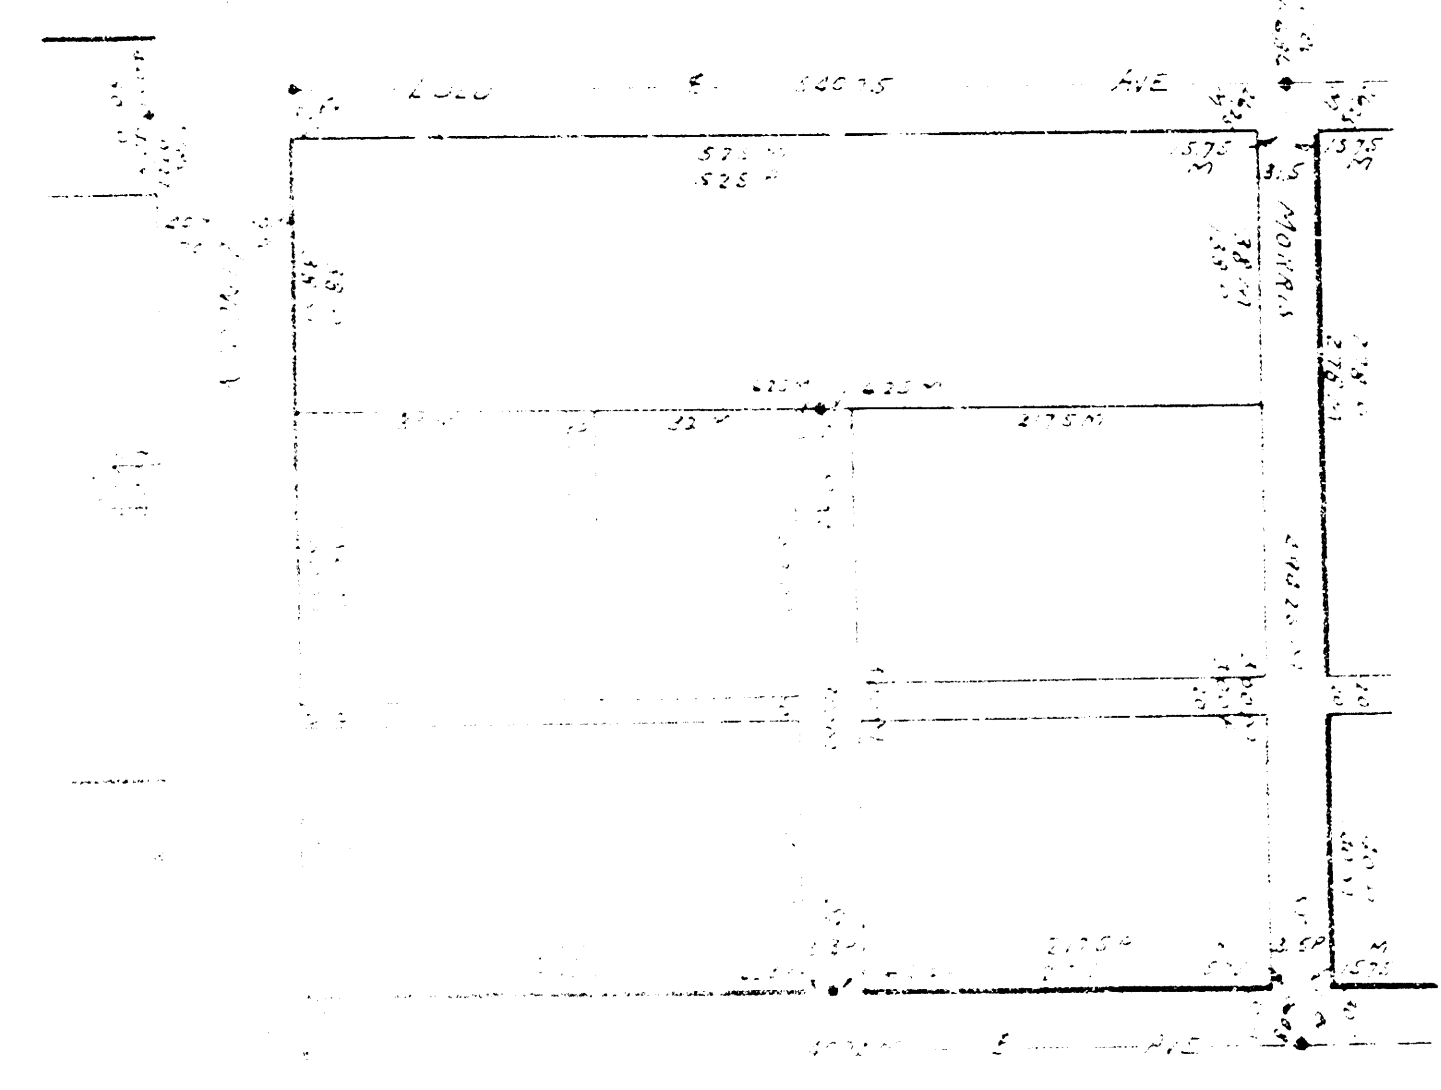


15

 


16




17

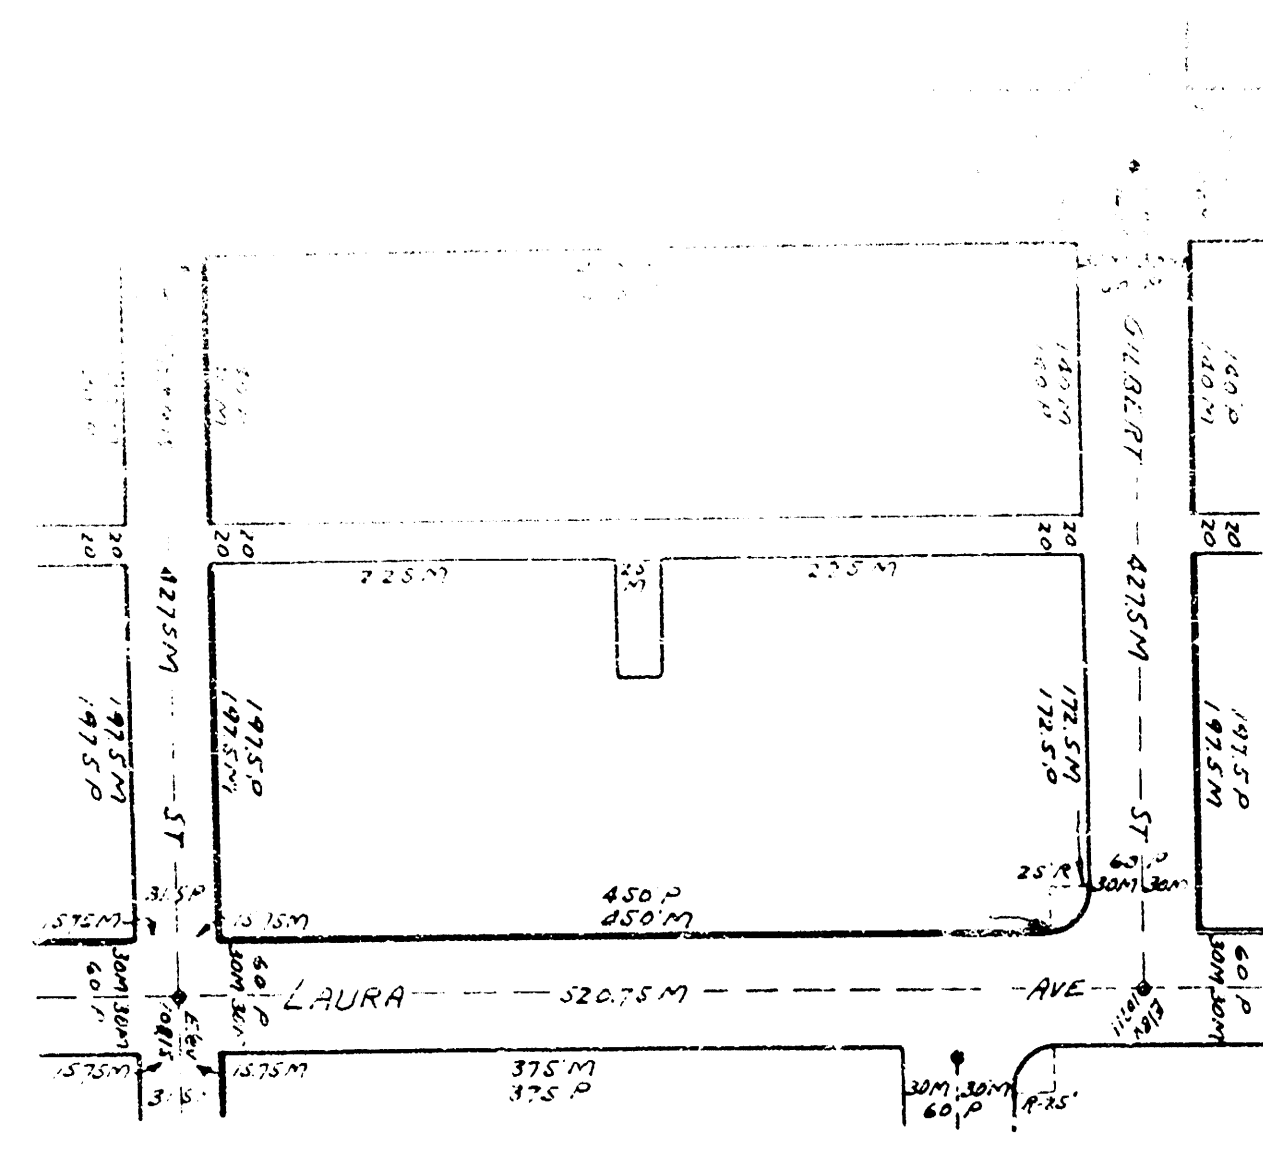


18

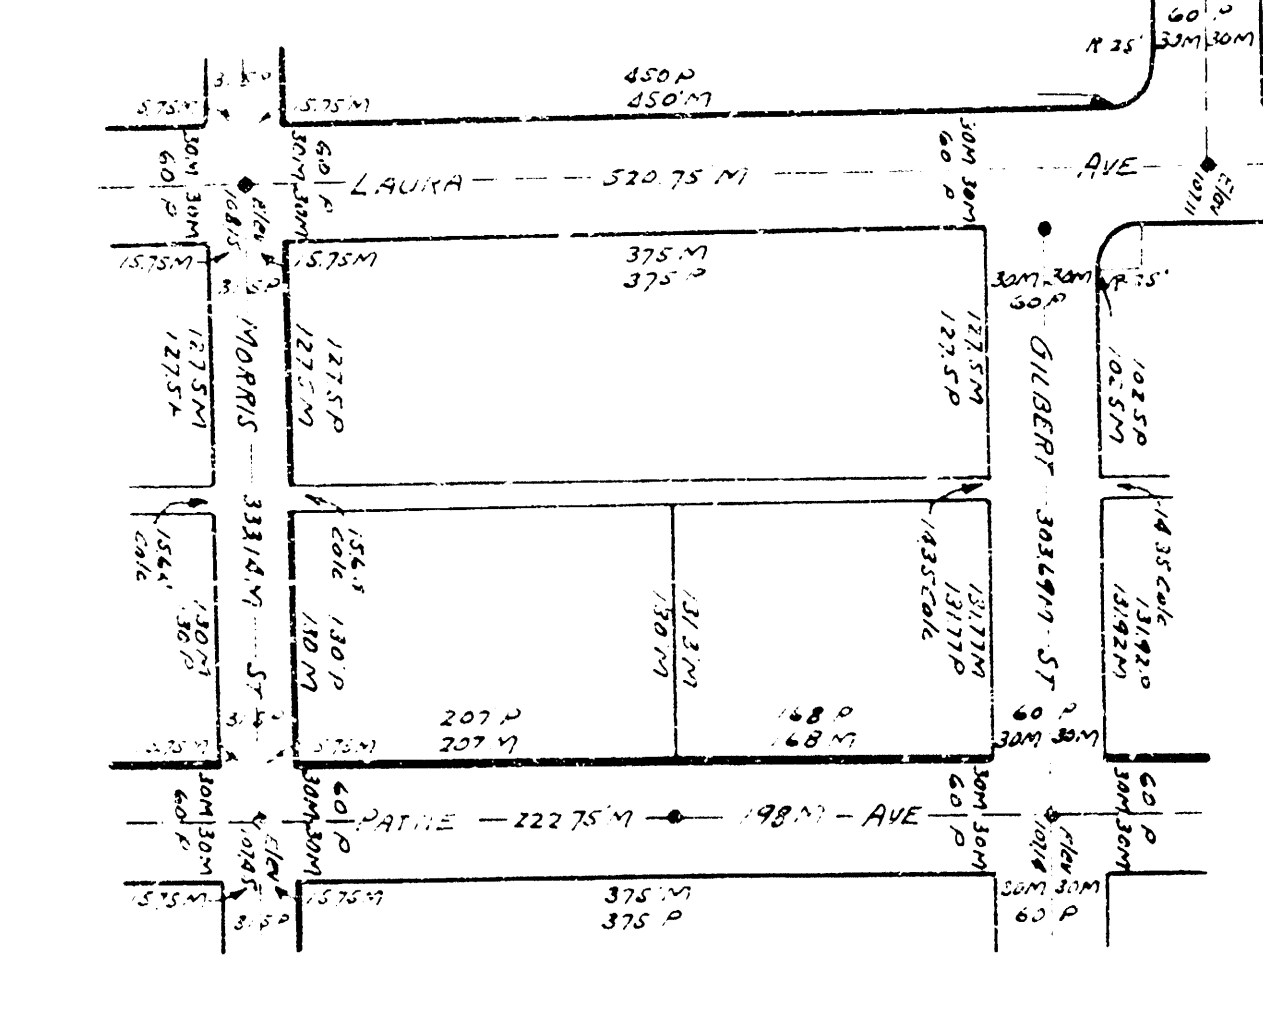


19

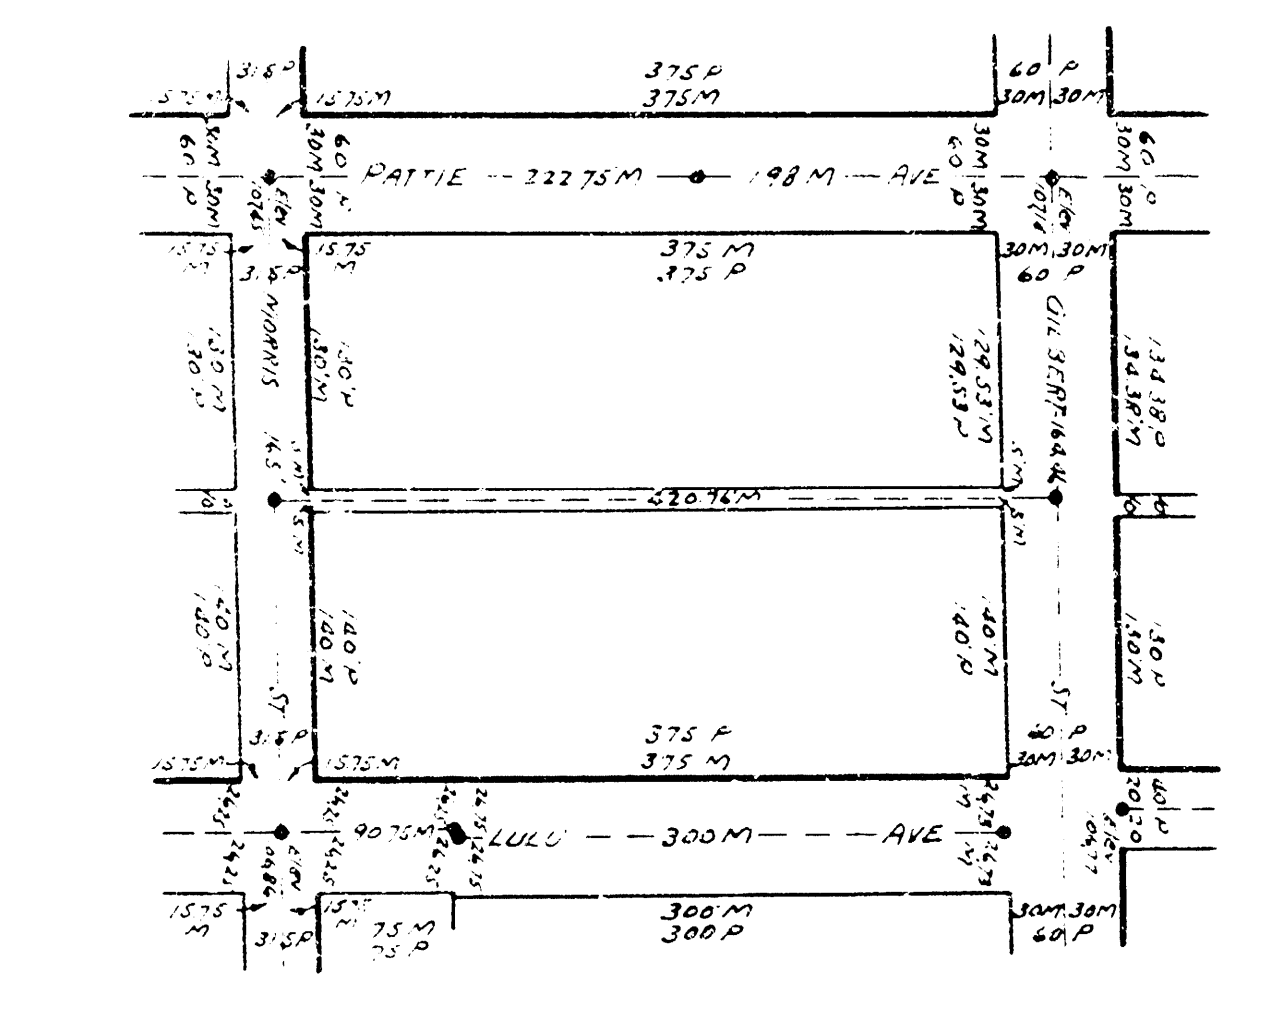


20

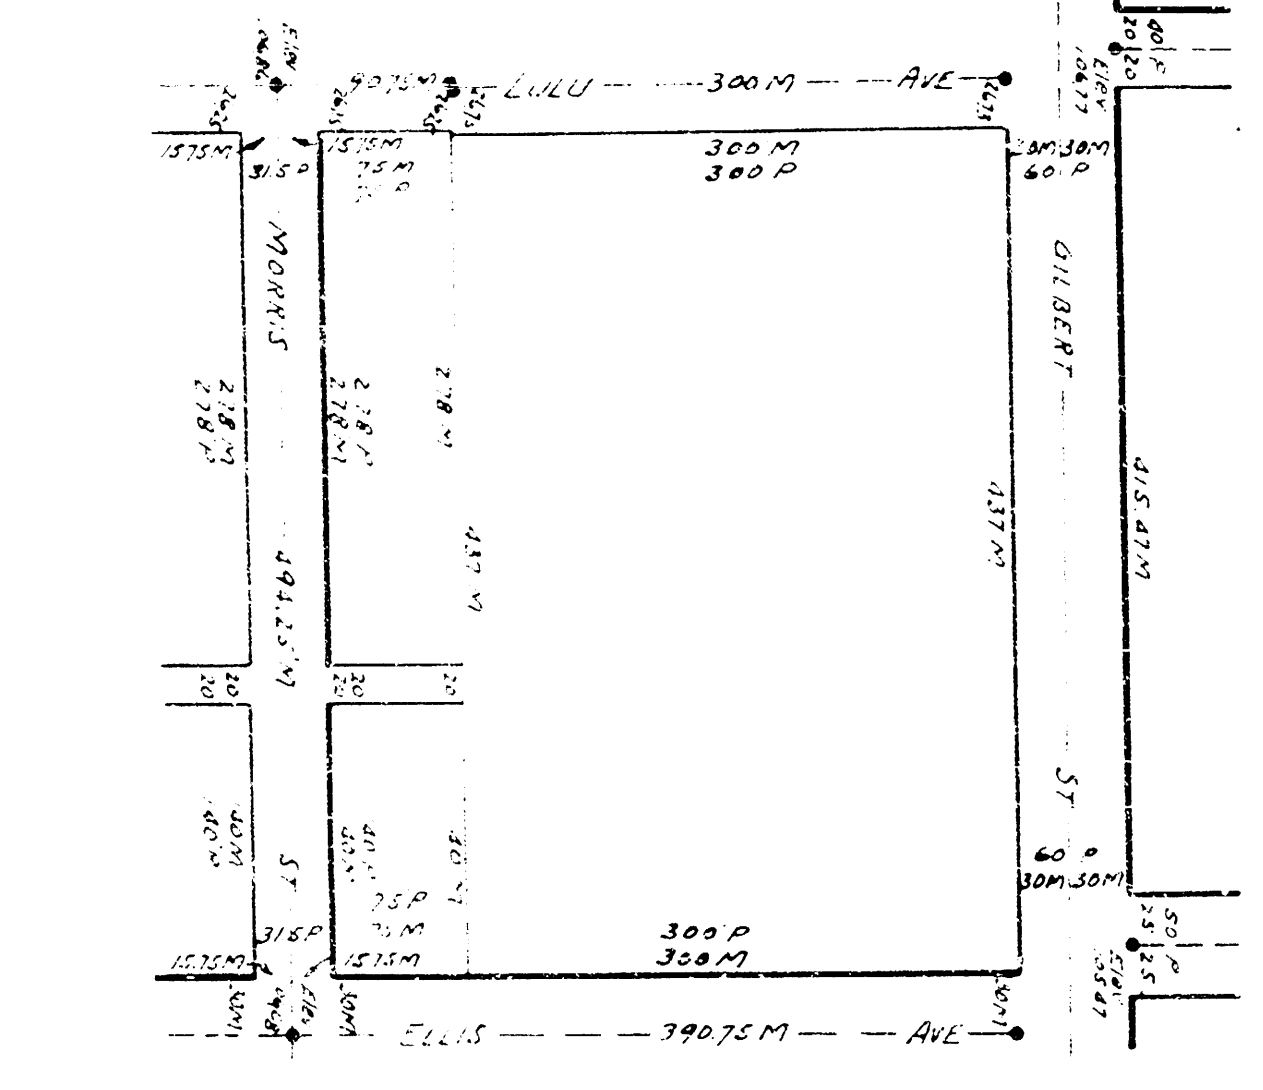


21

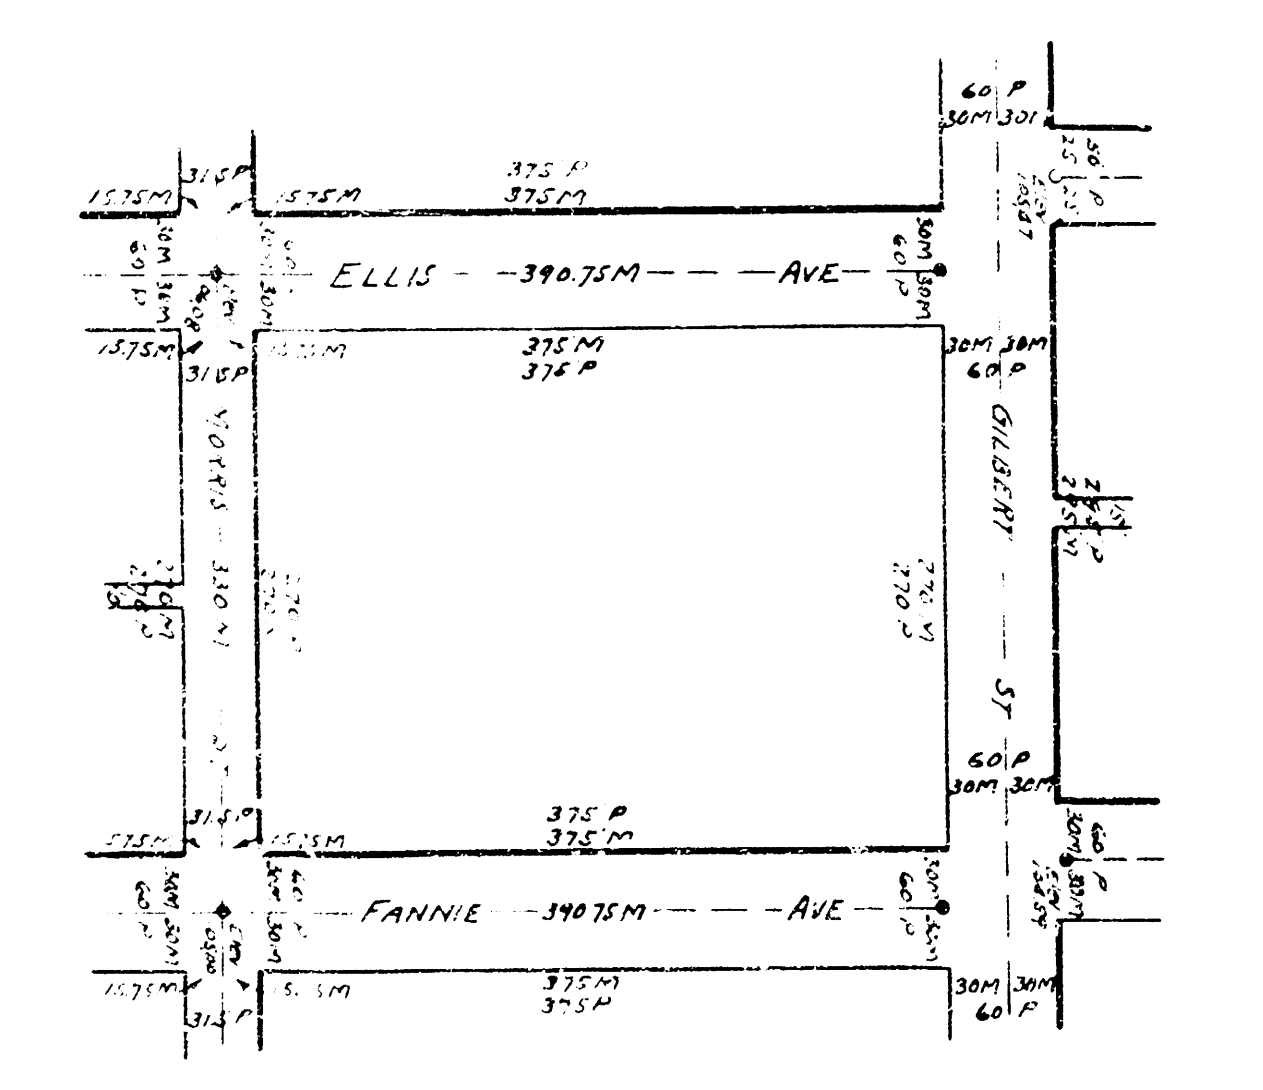


22

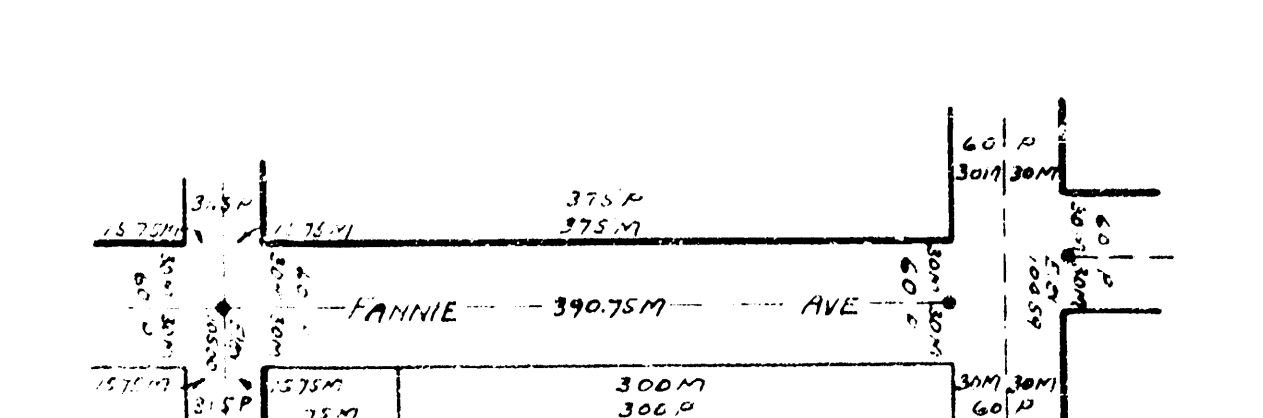


23

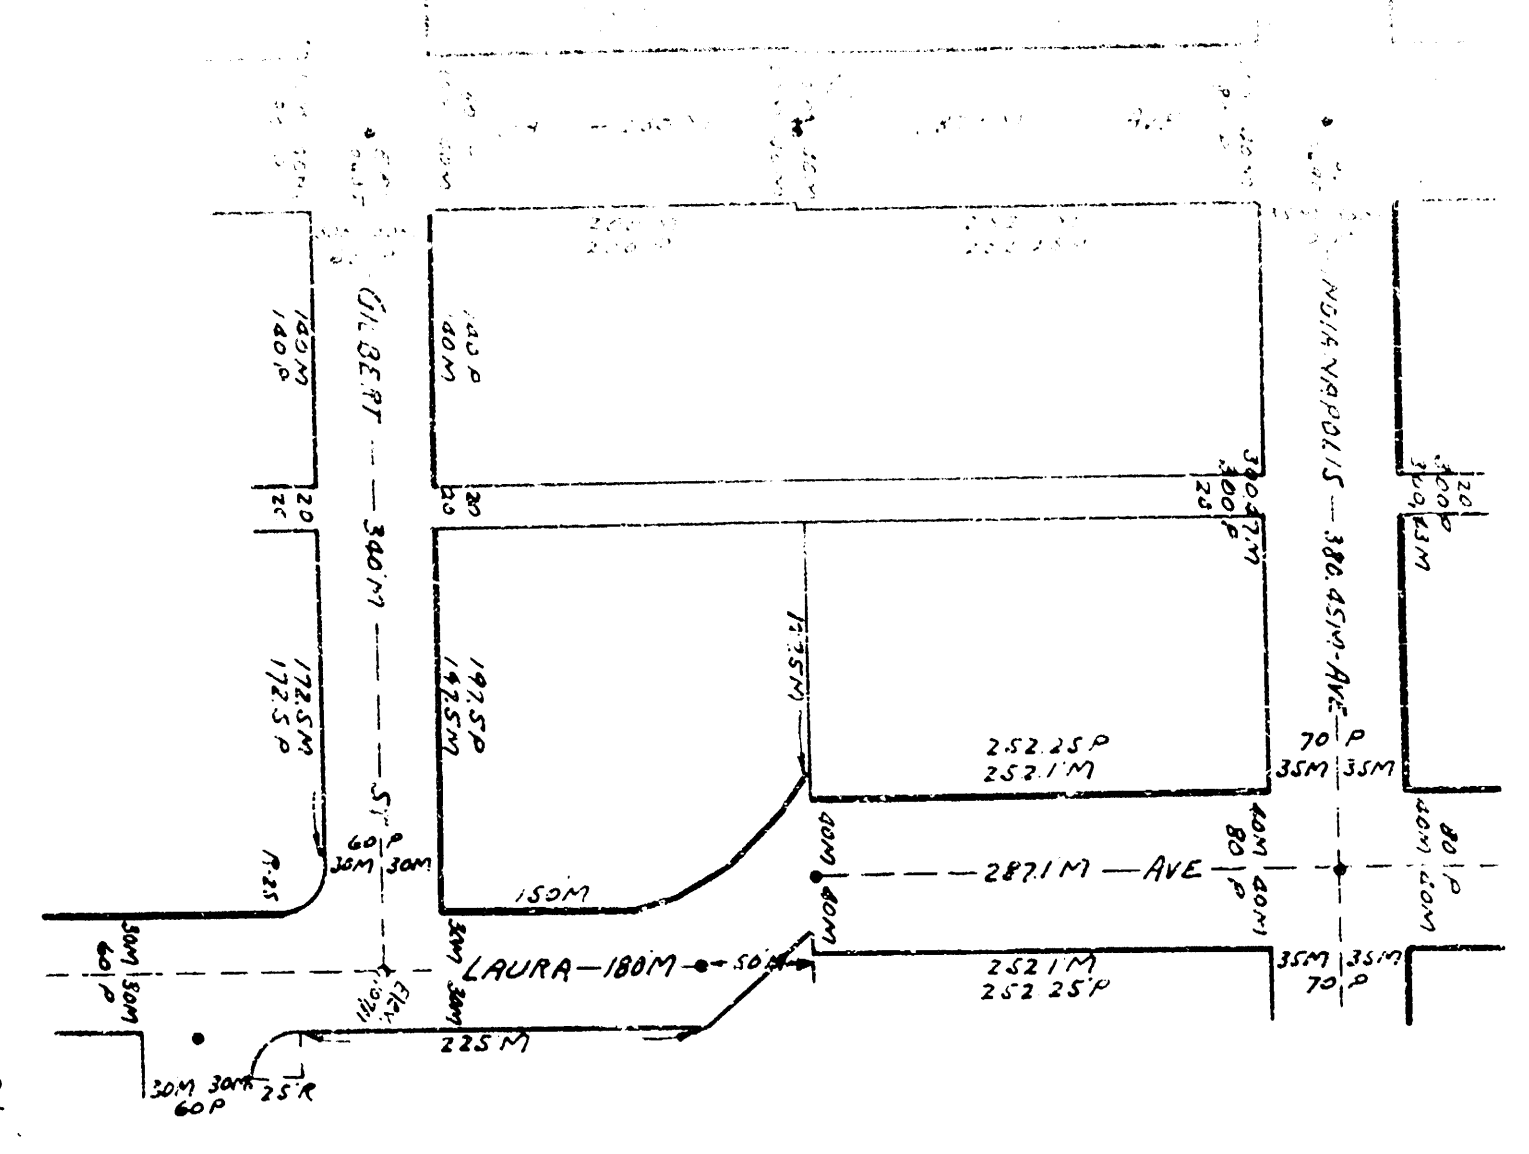


24

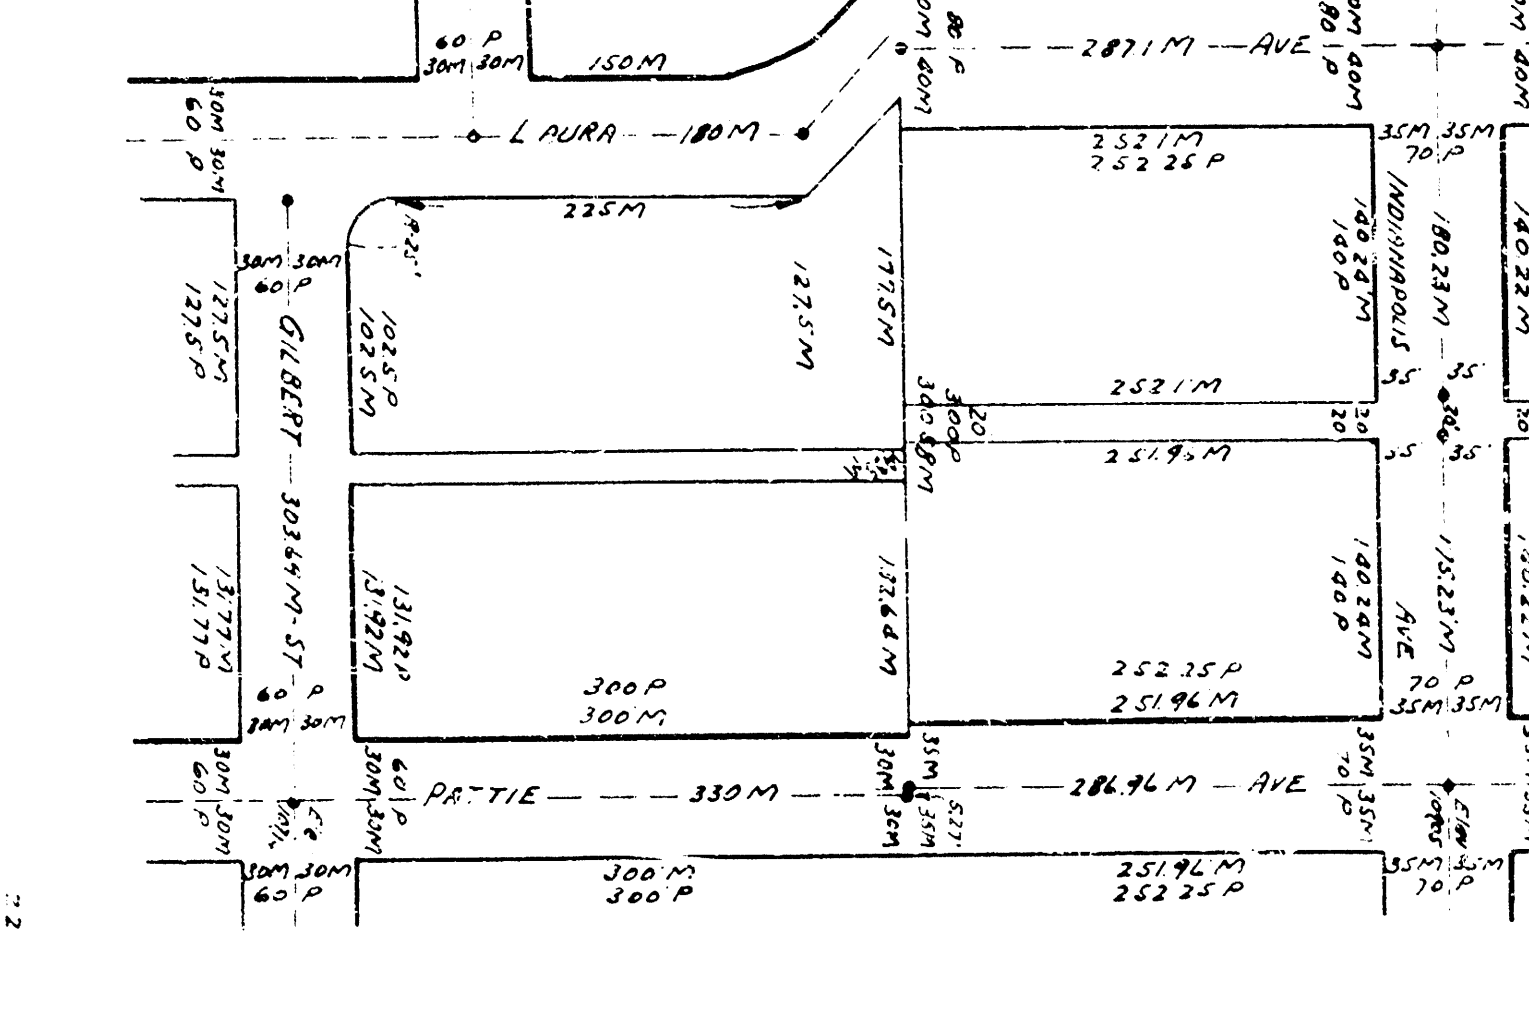


25

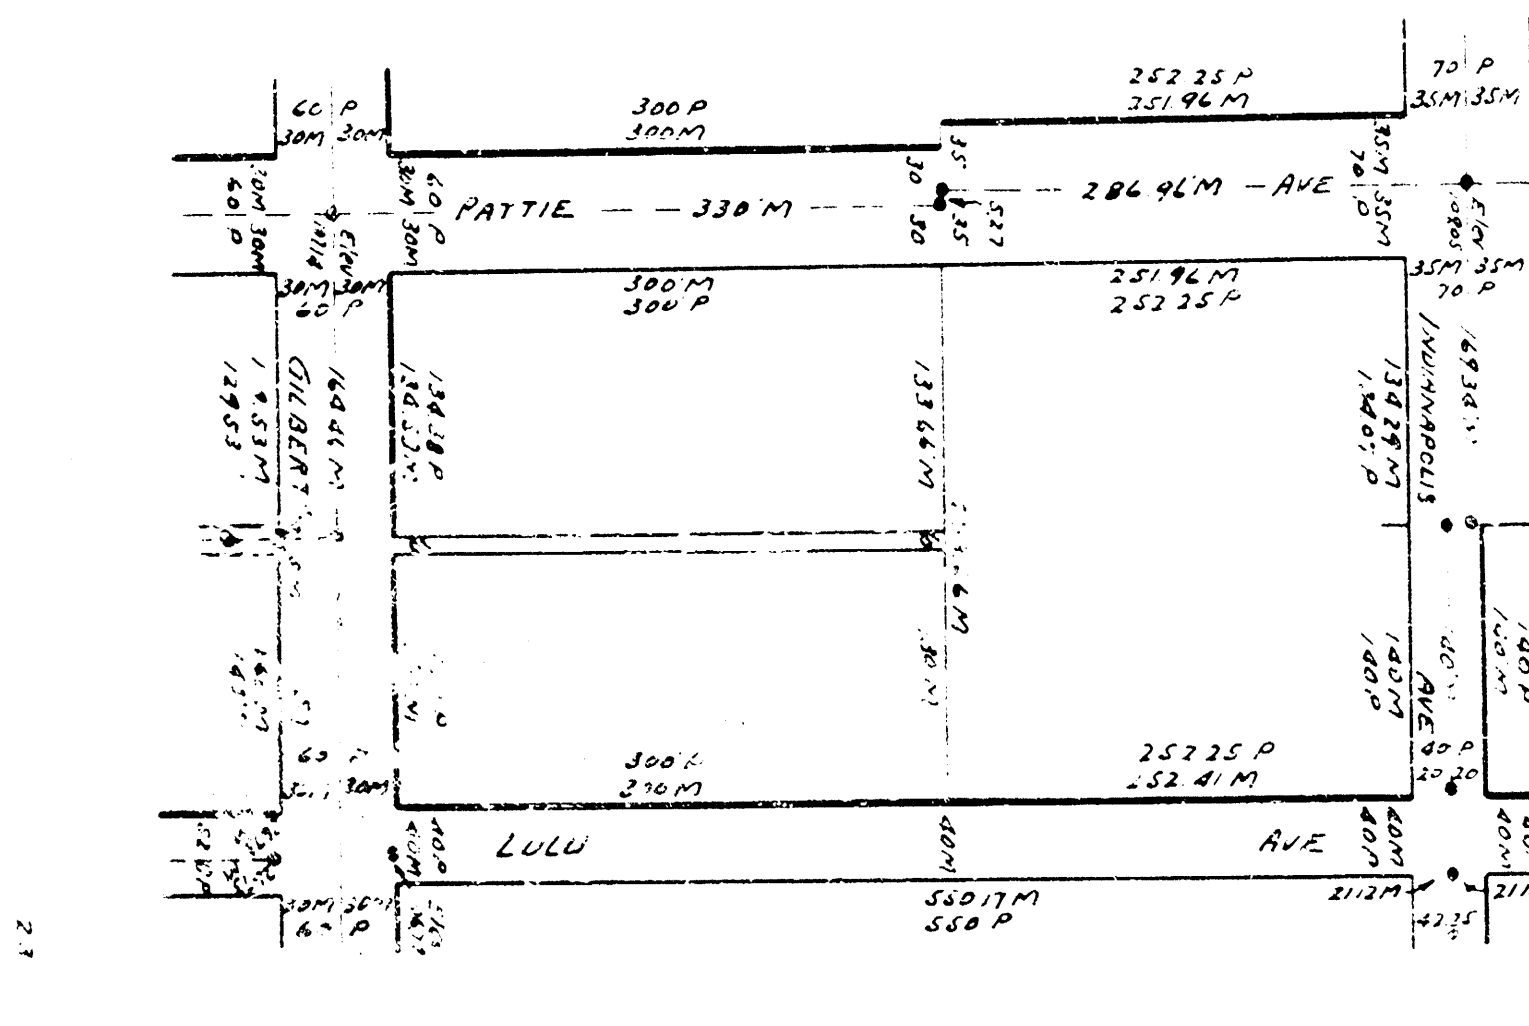


26

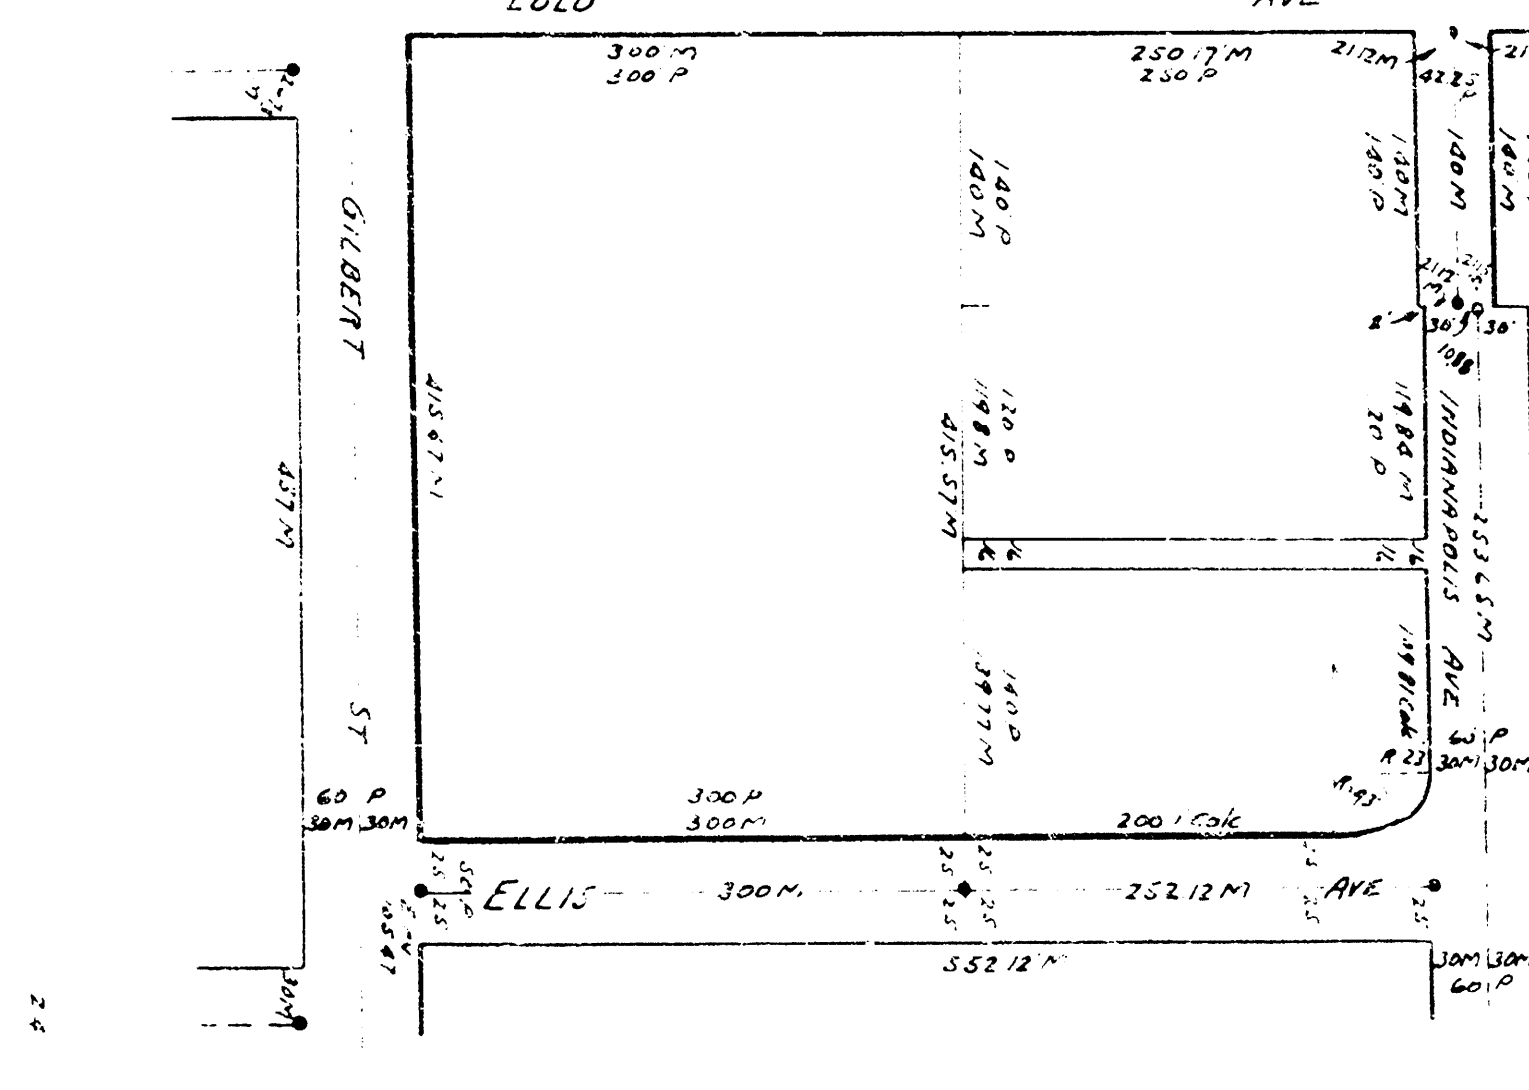


27

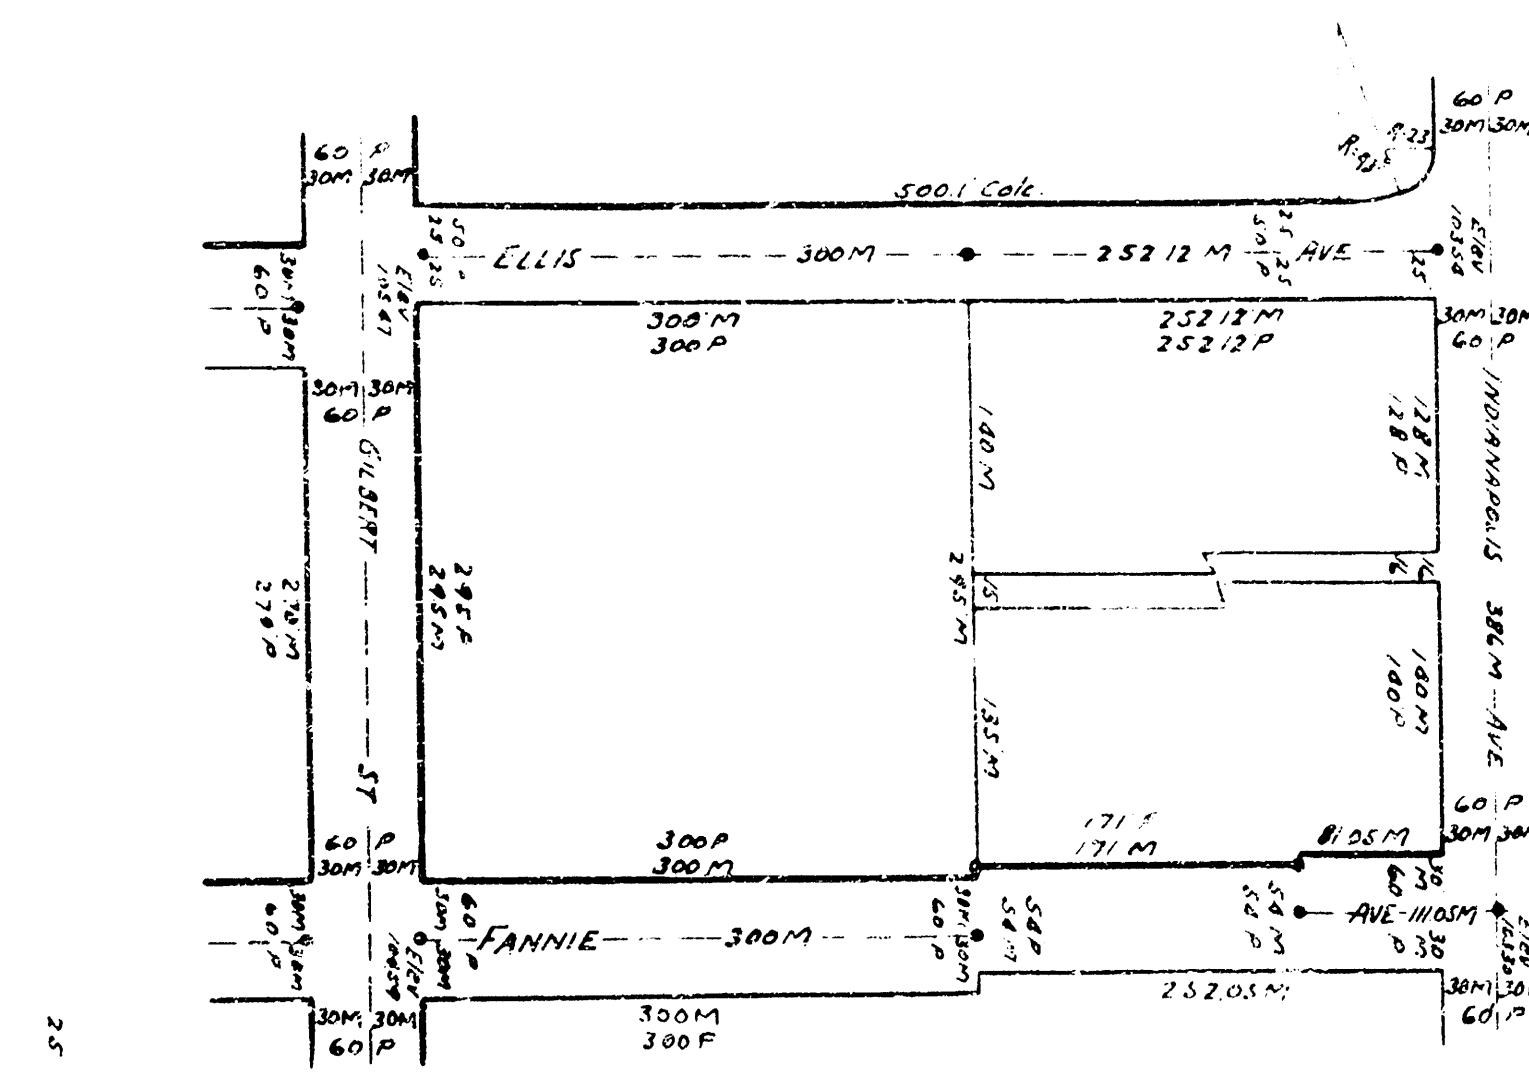


28

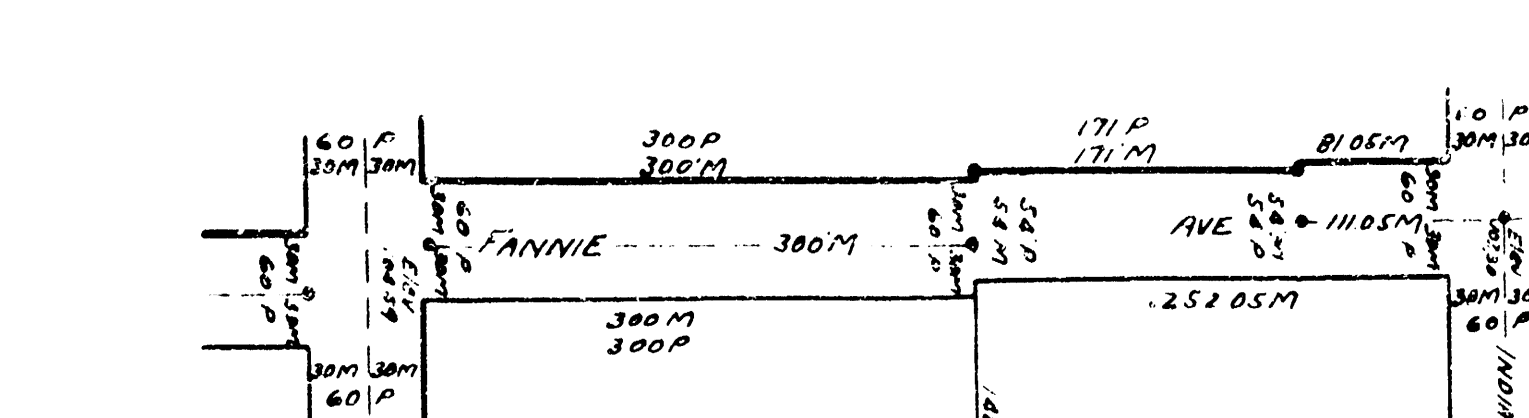


29

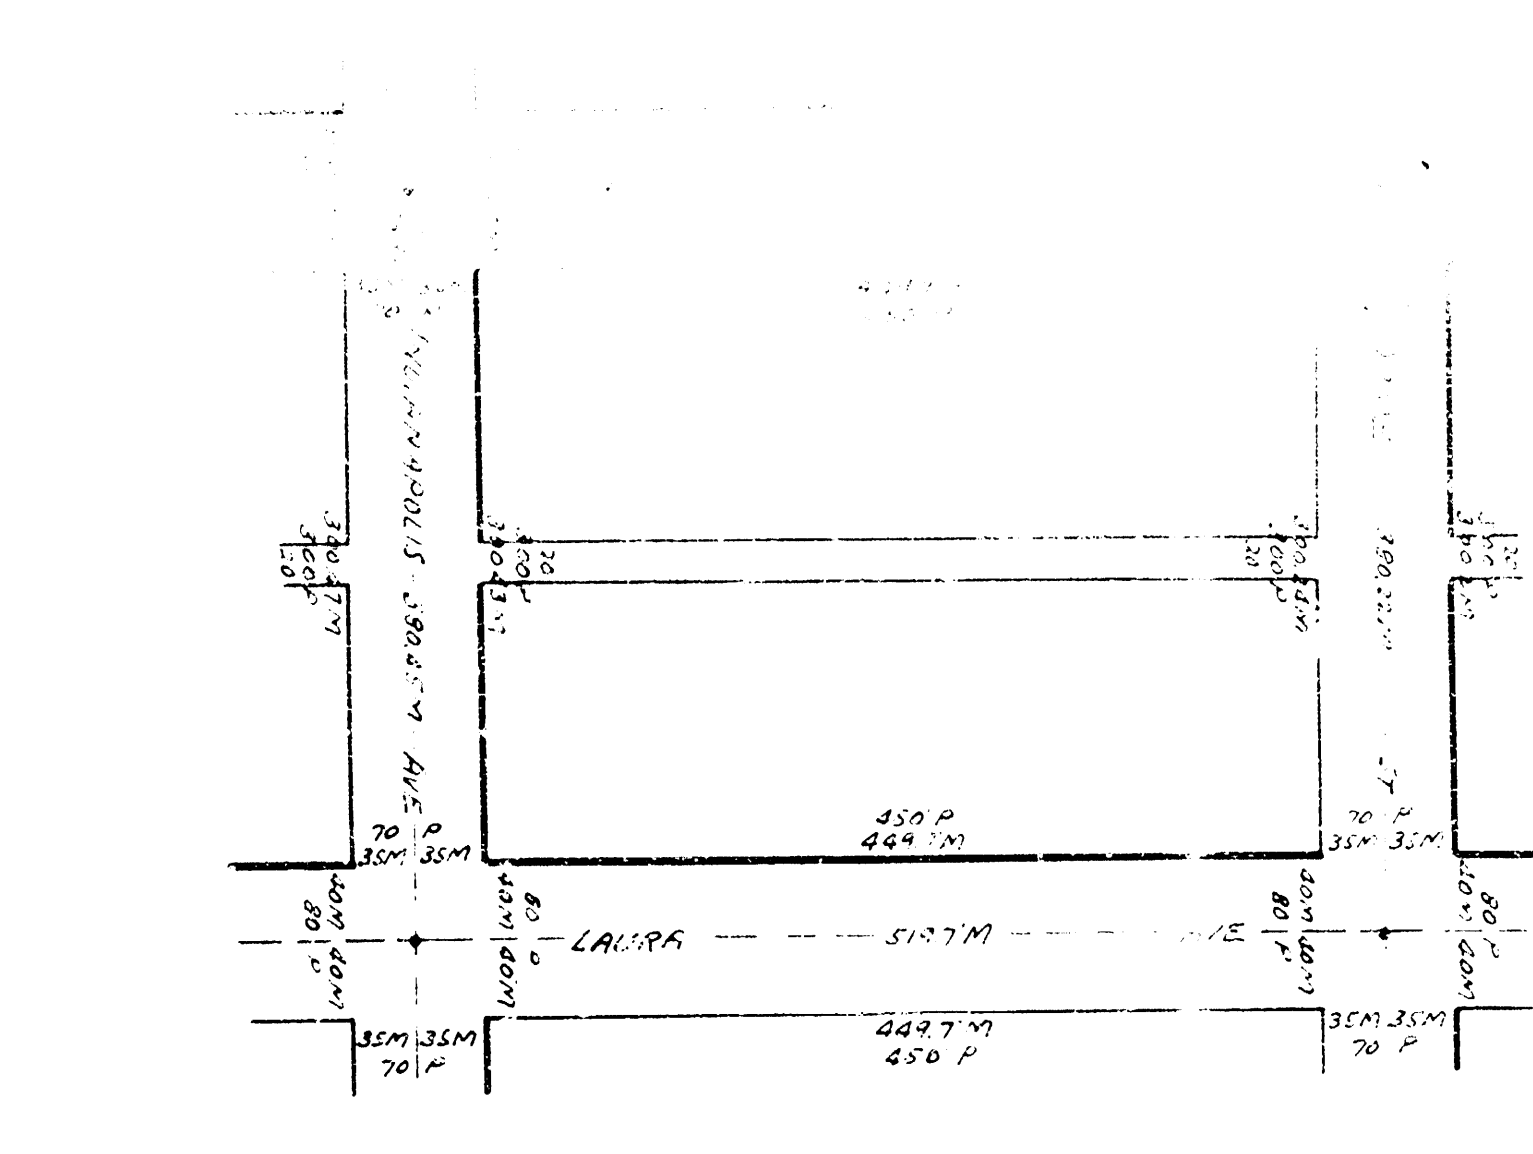


30

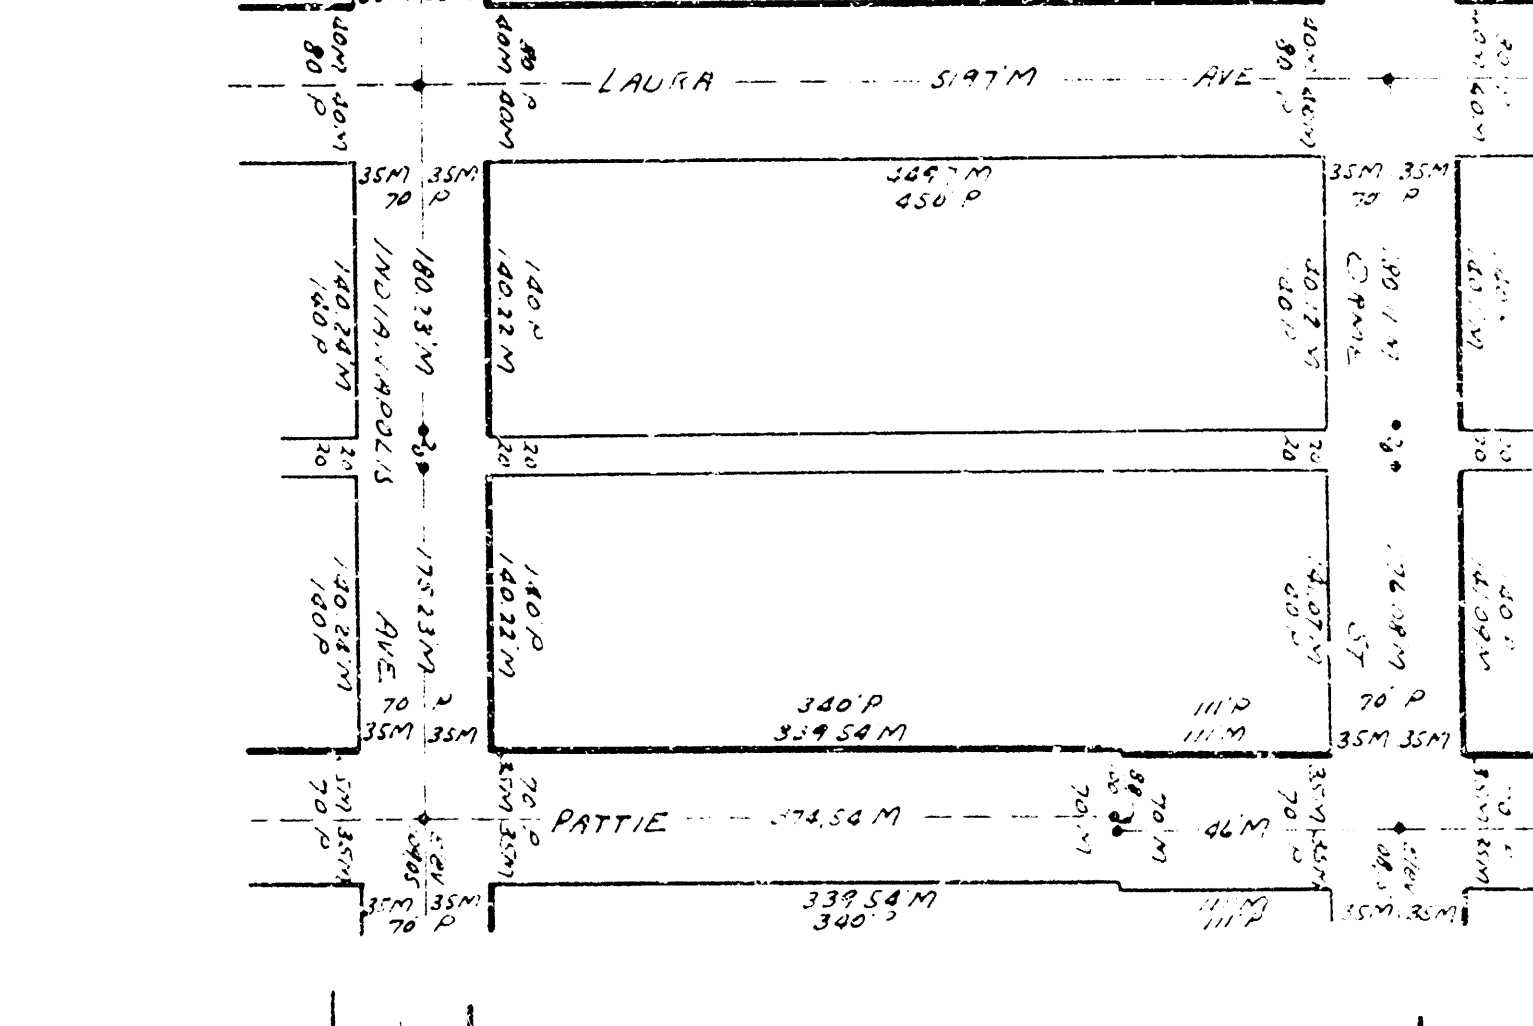


31

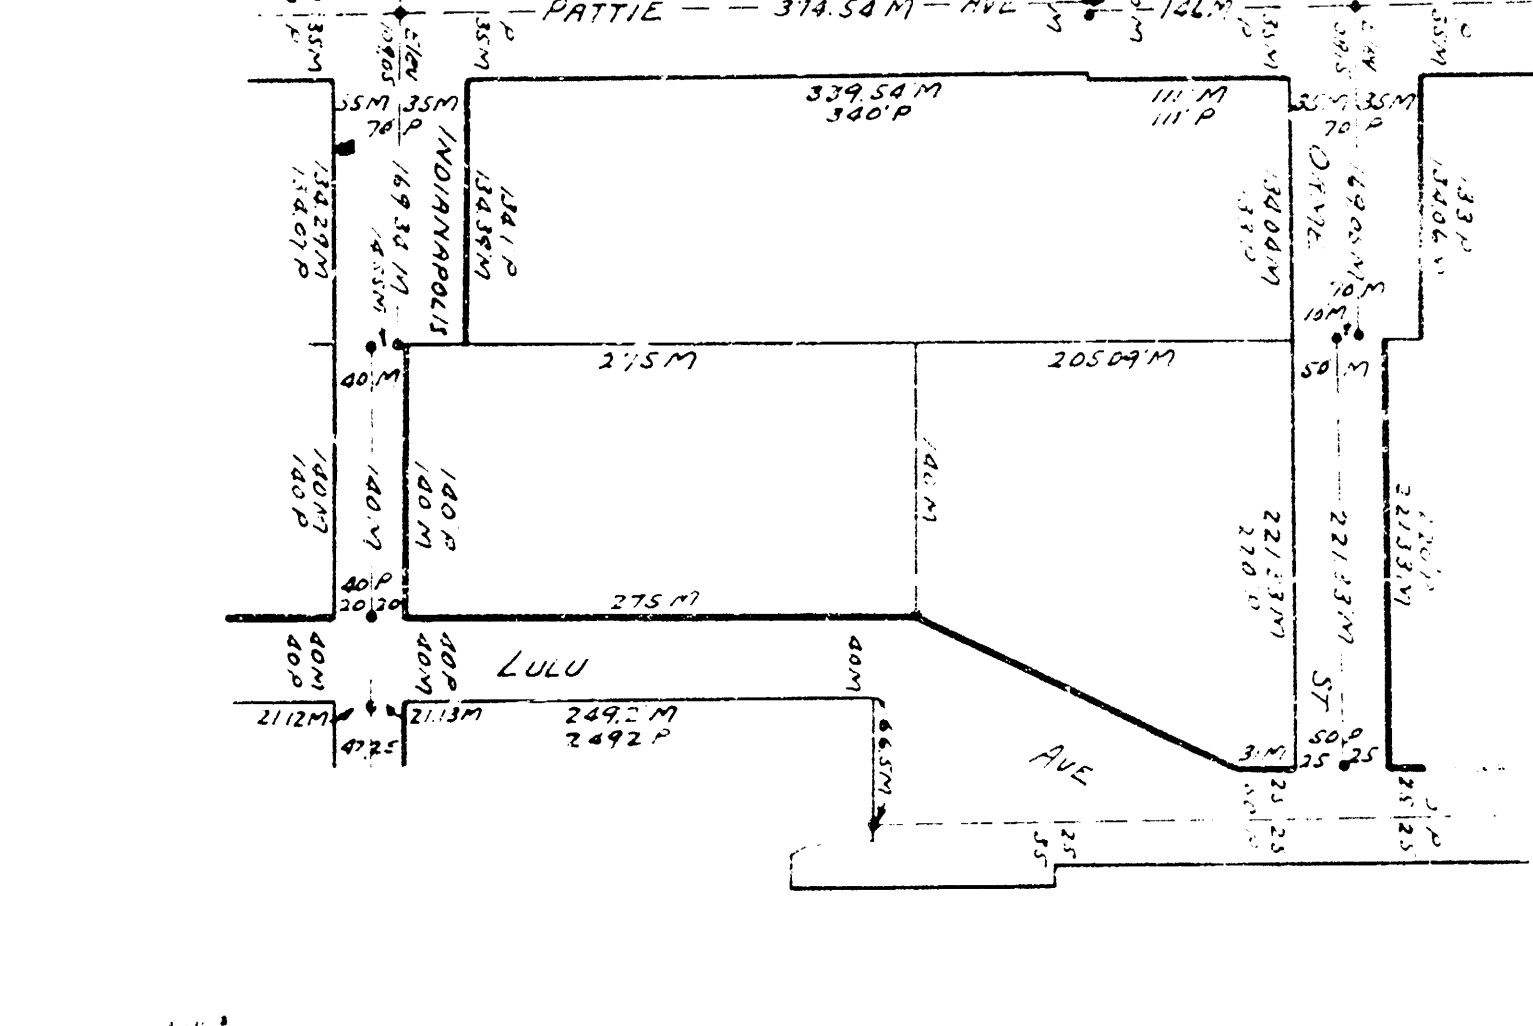


32

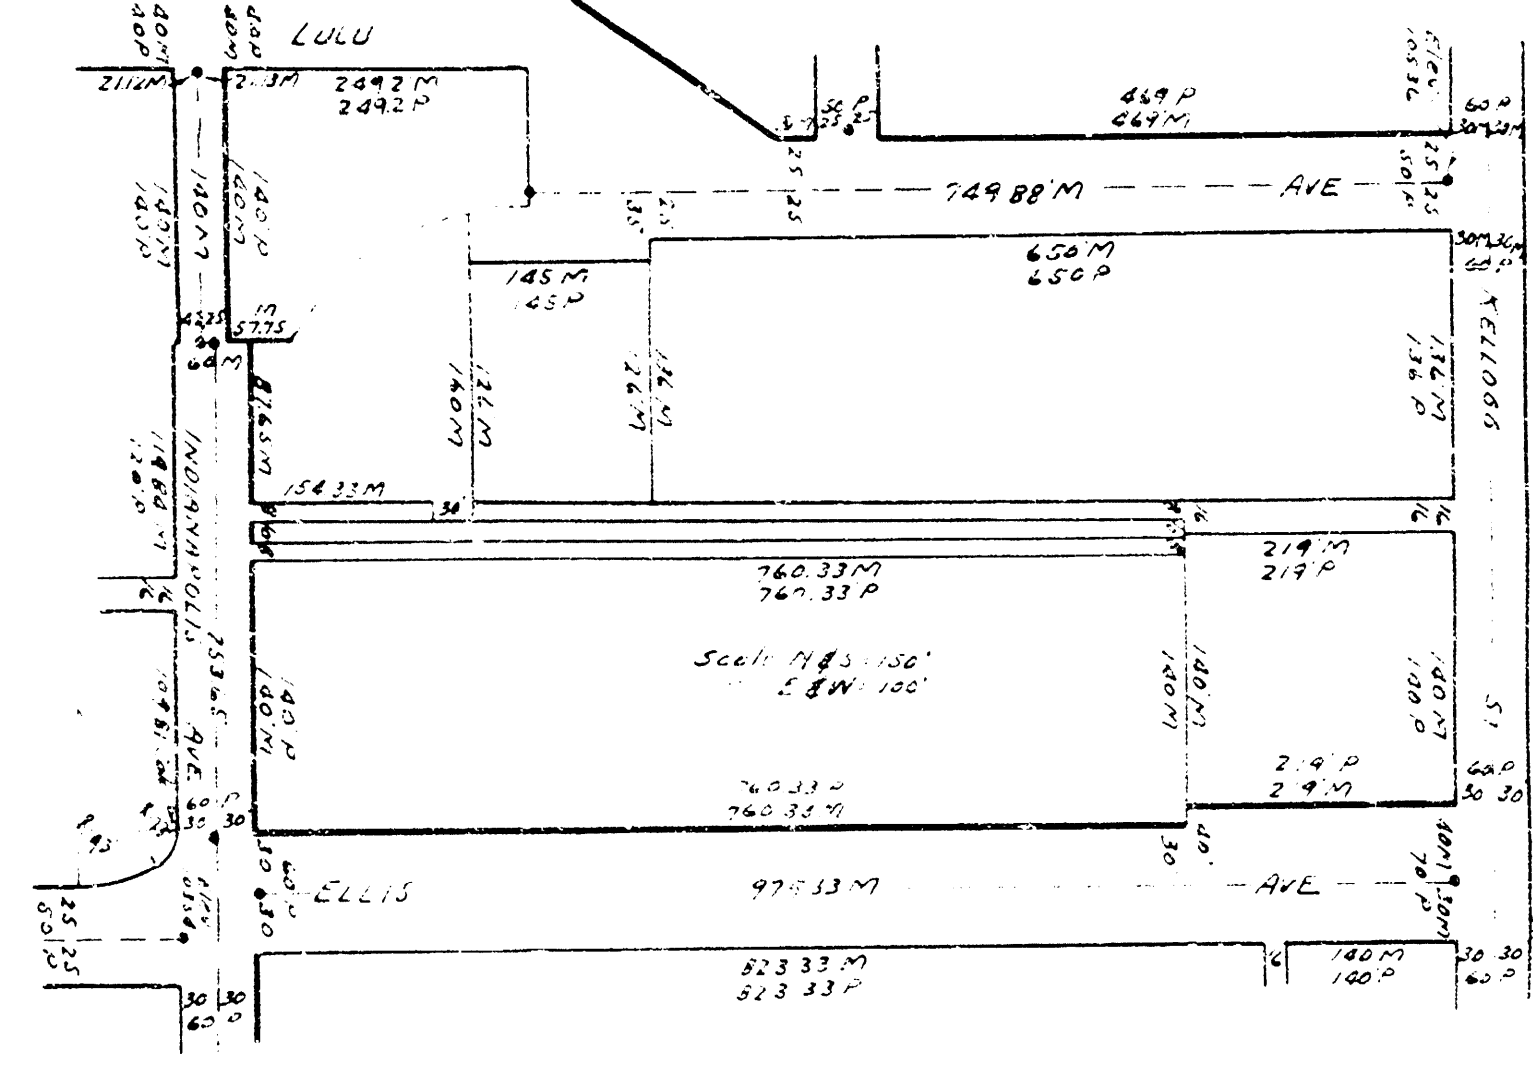


33

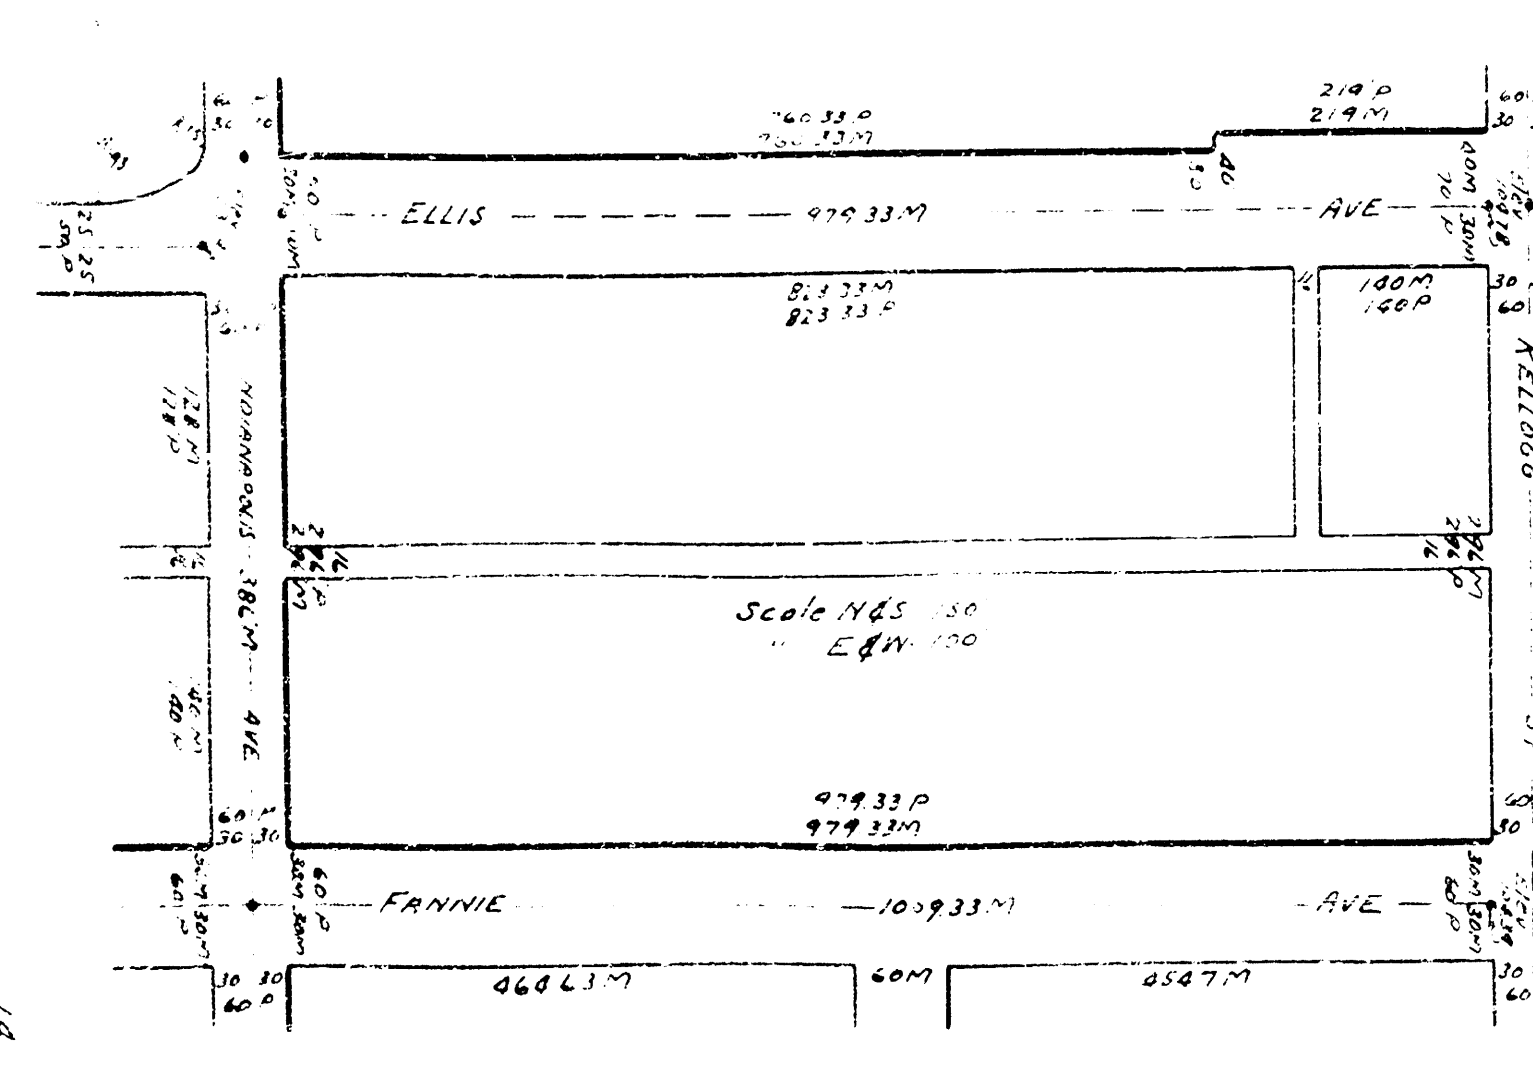


34

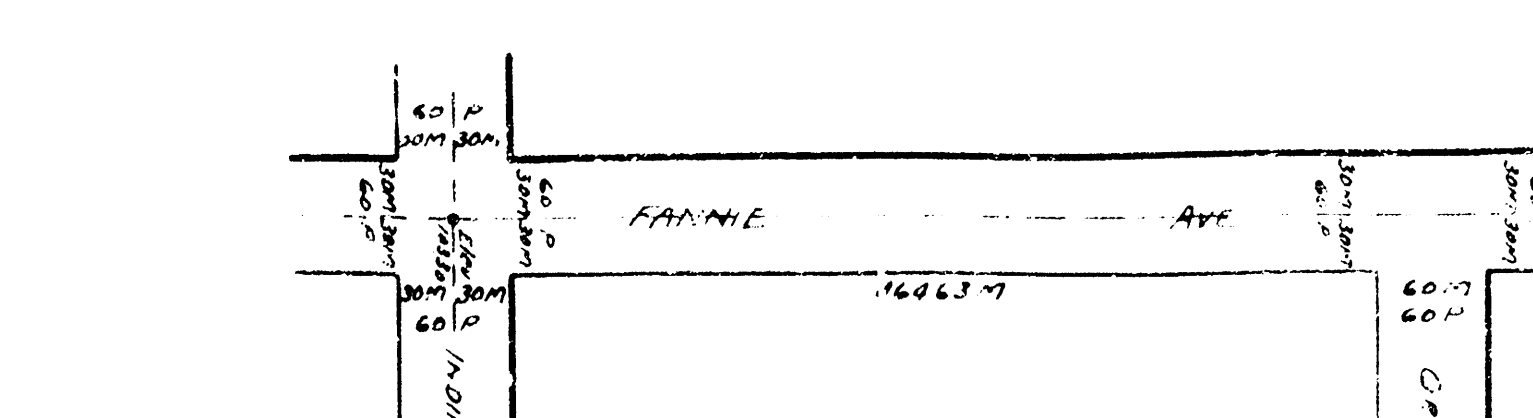


35

 


36

 


37

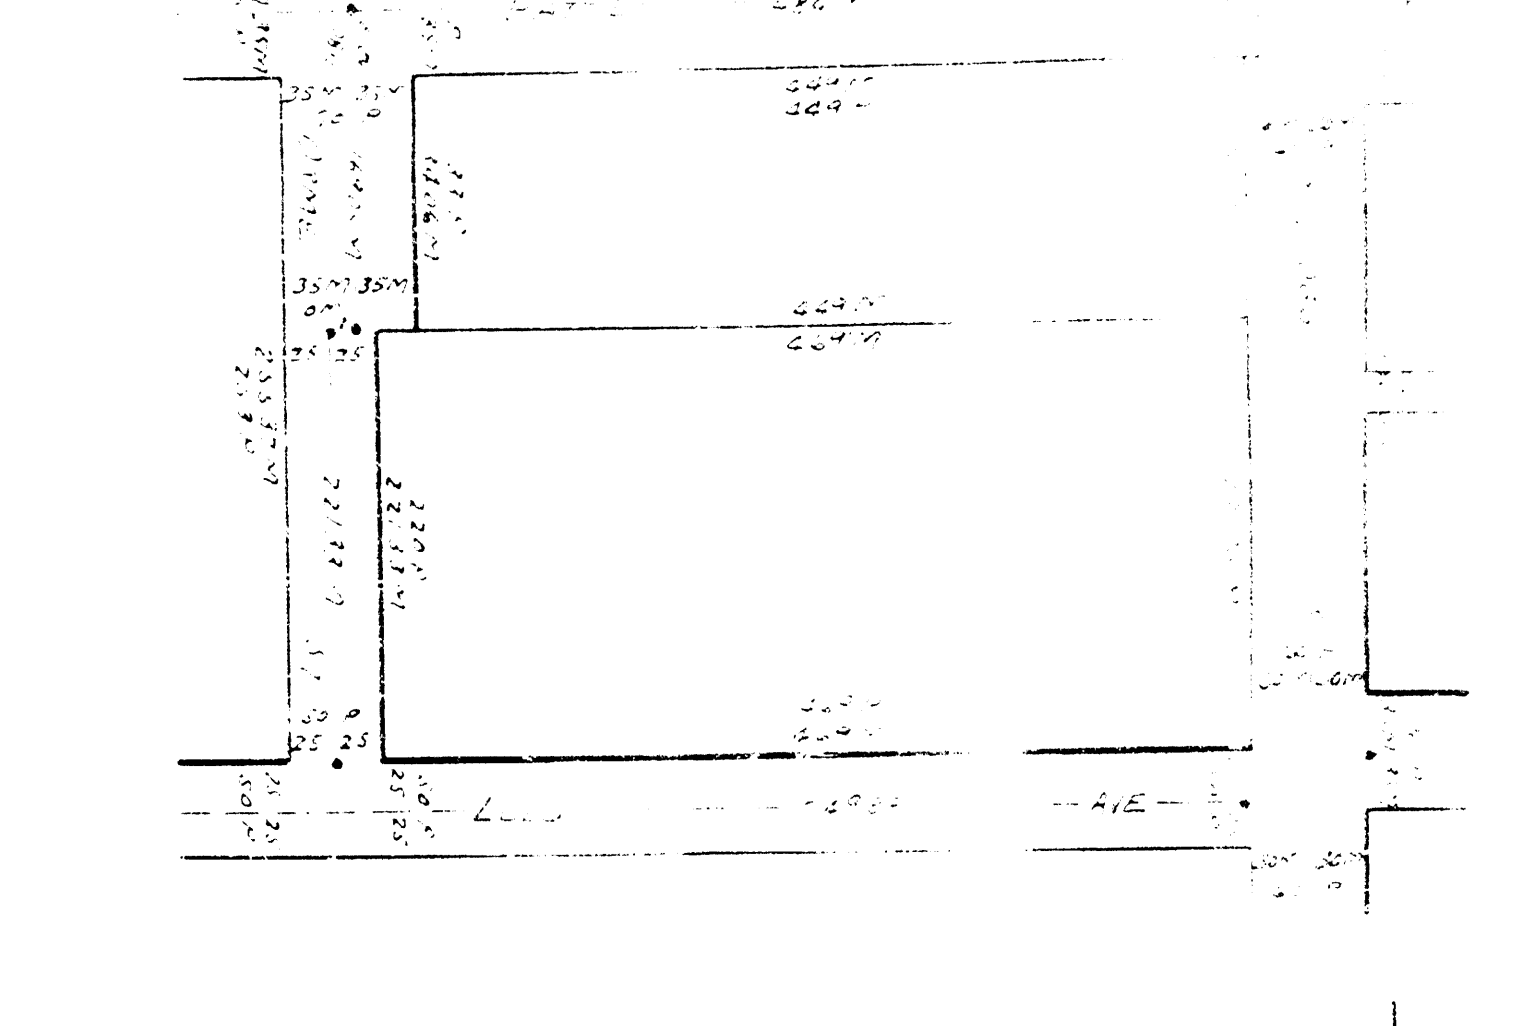


38

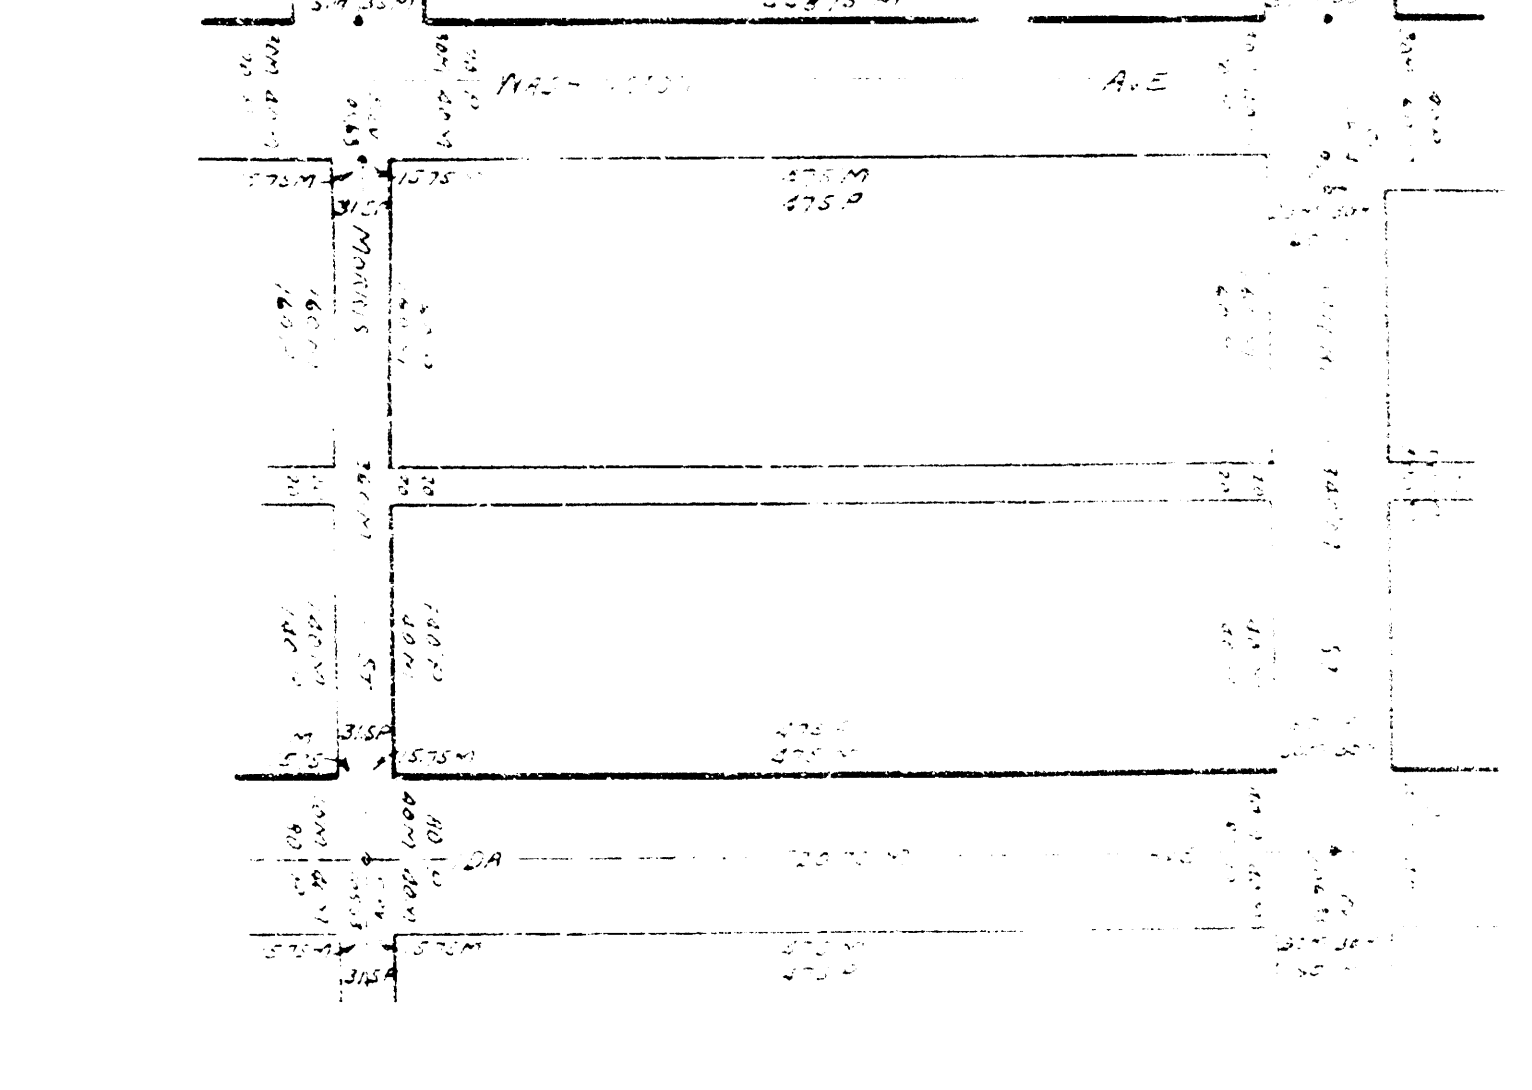
























39

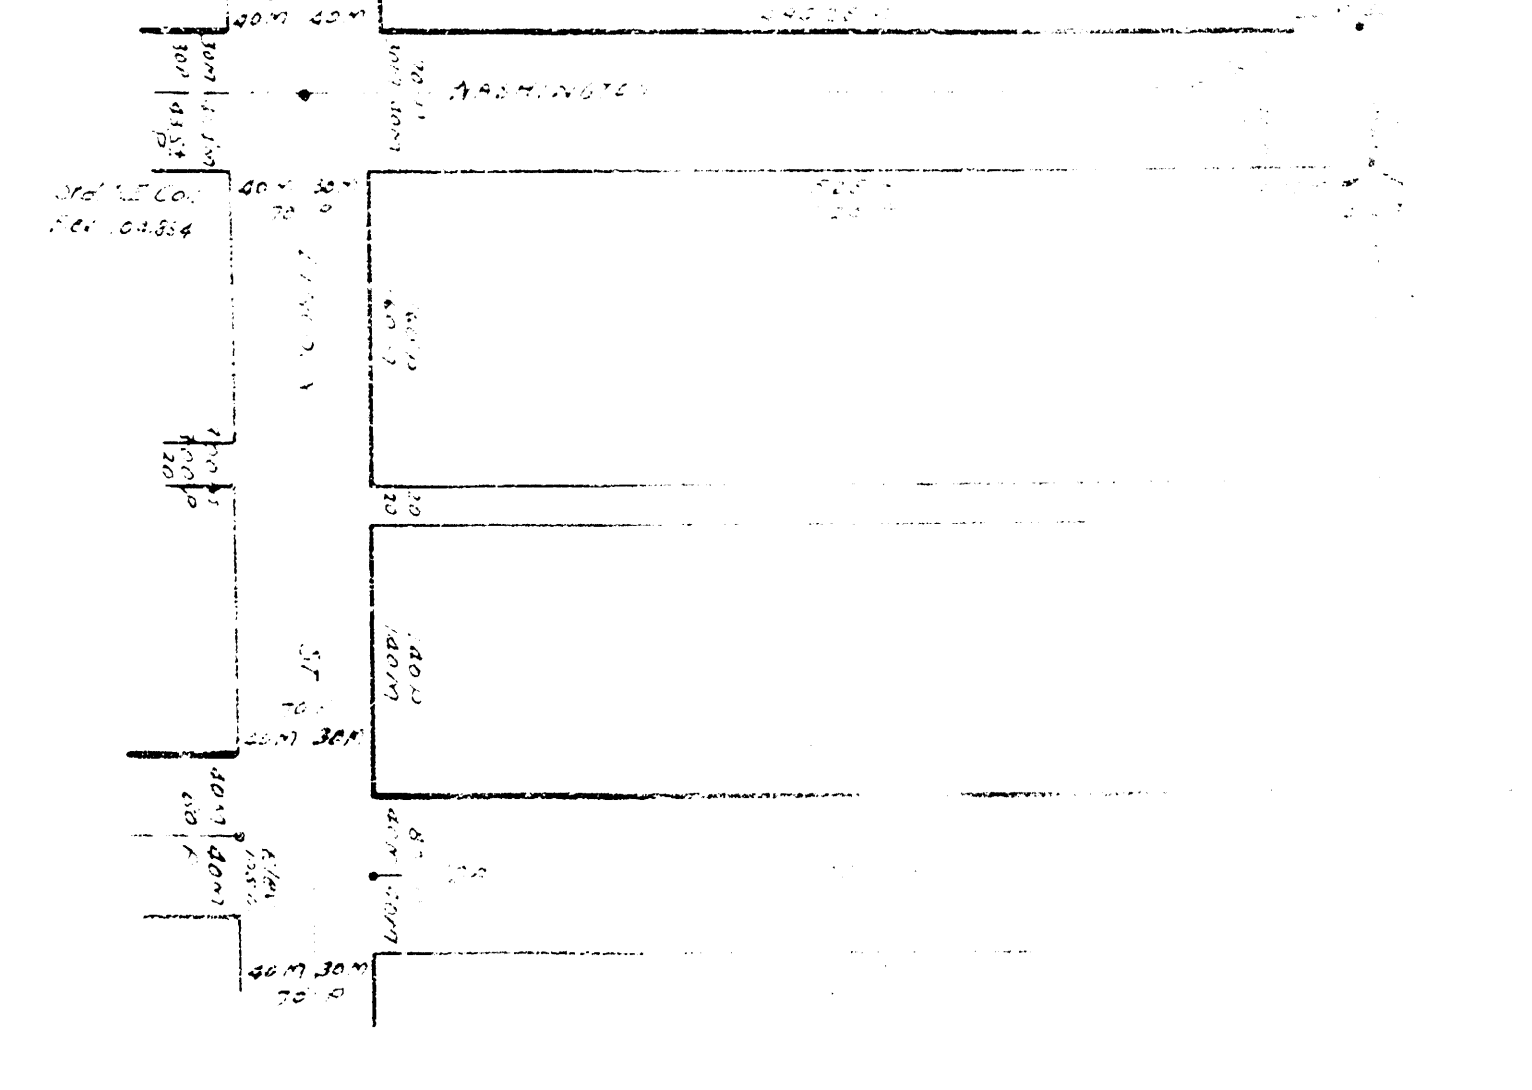

40

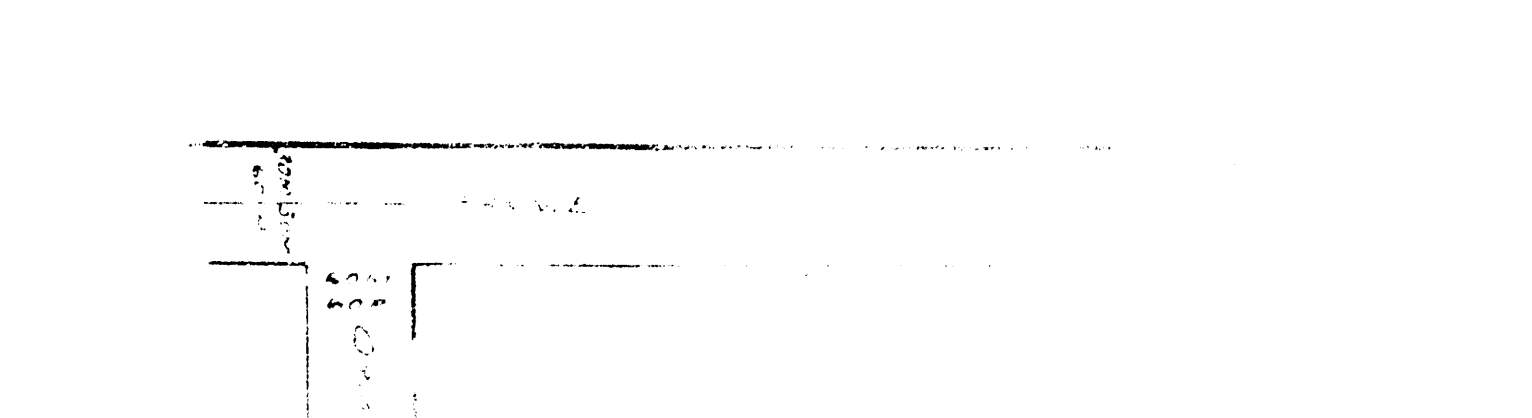


41

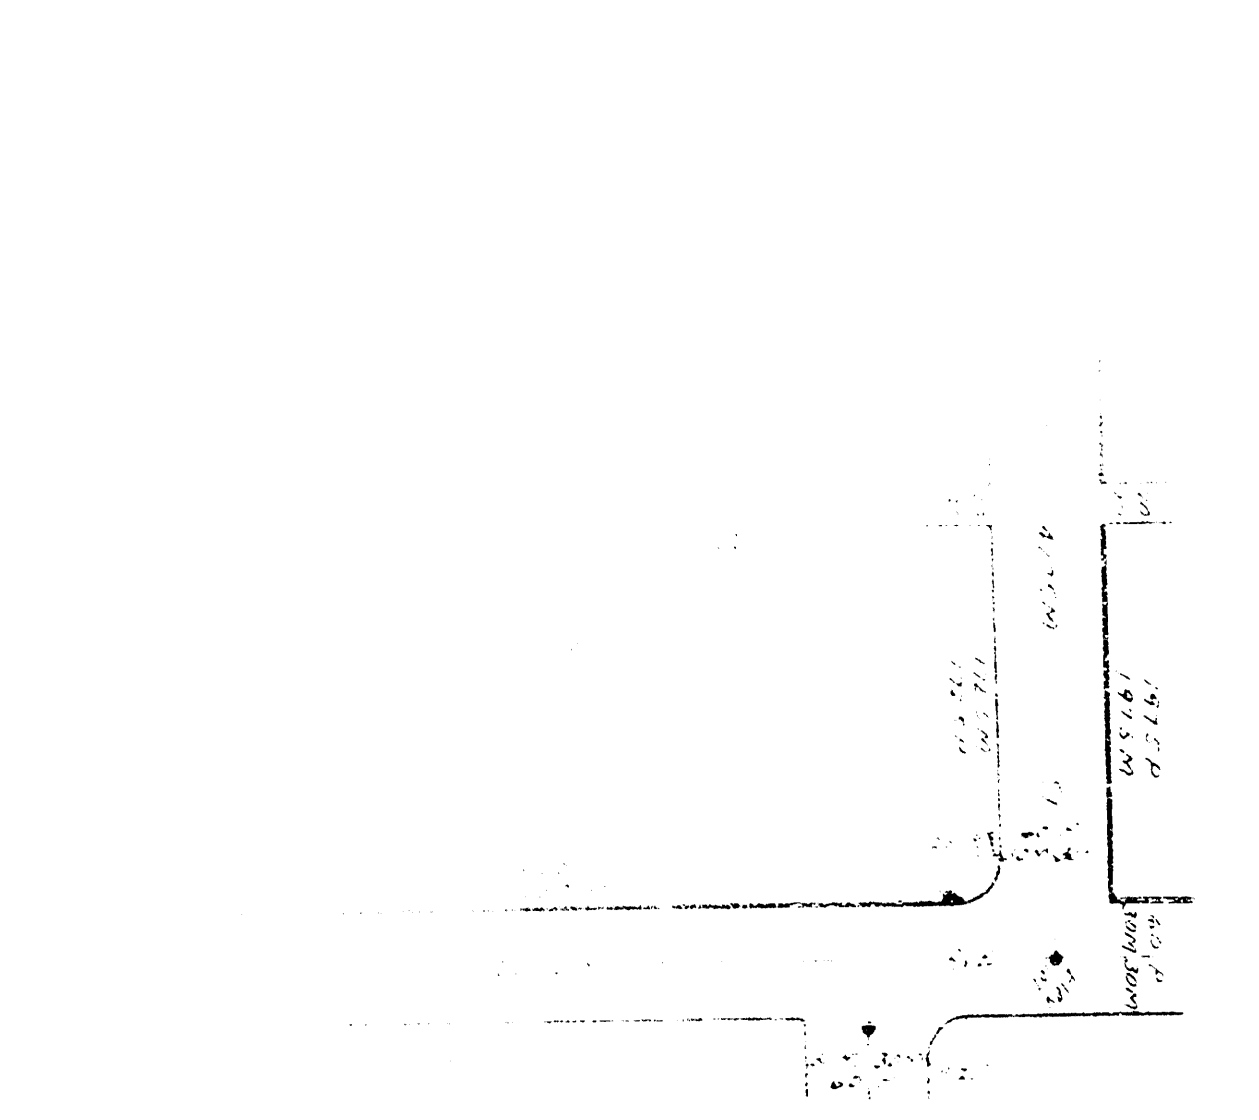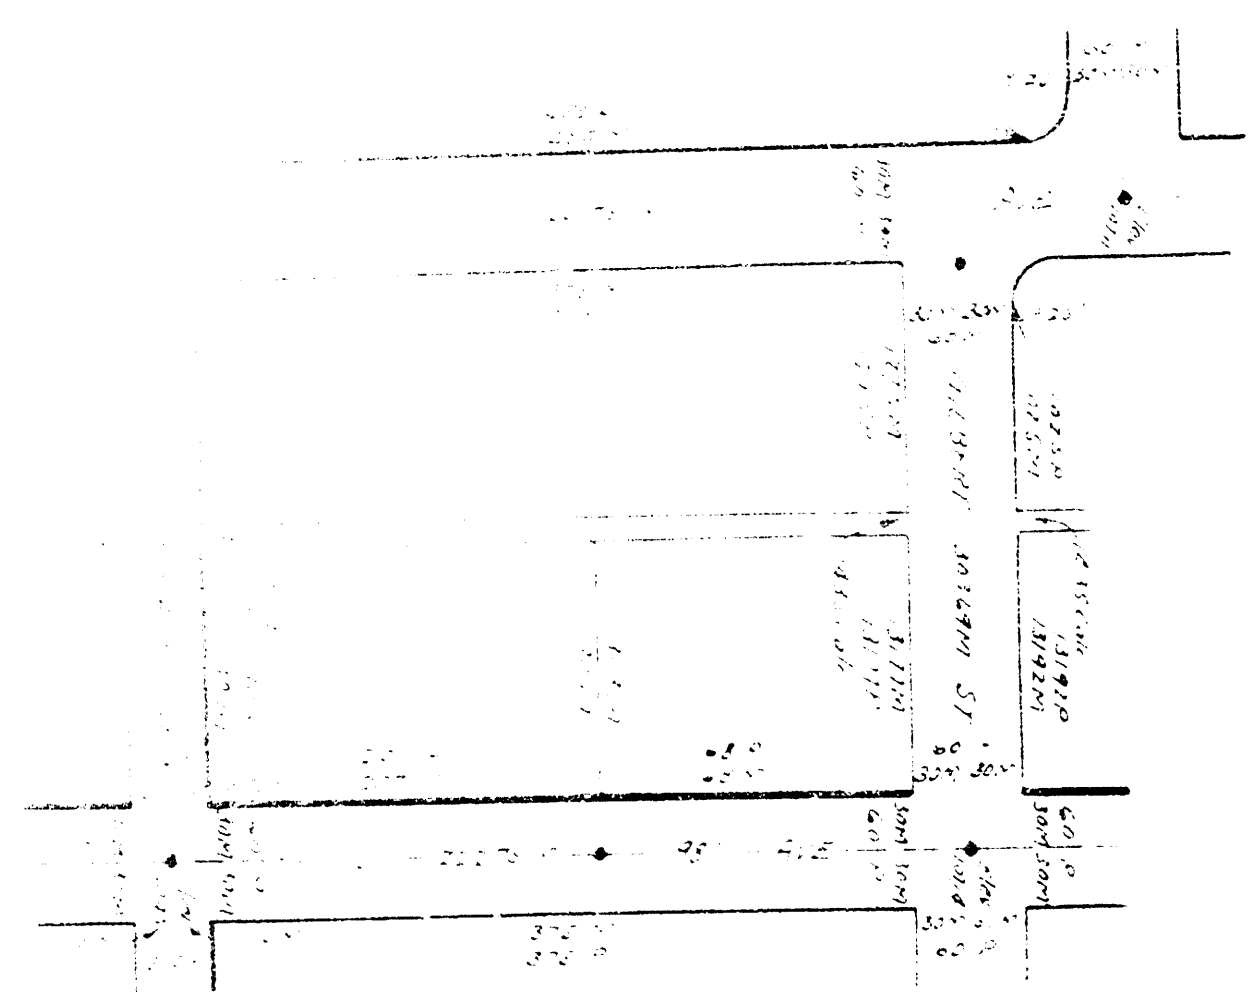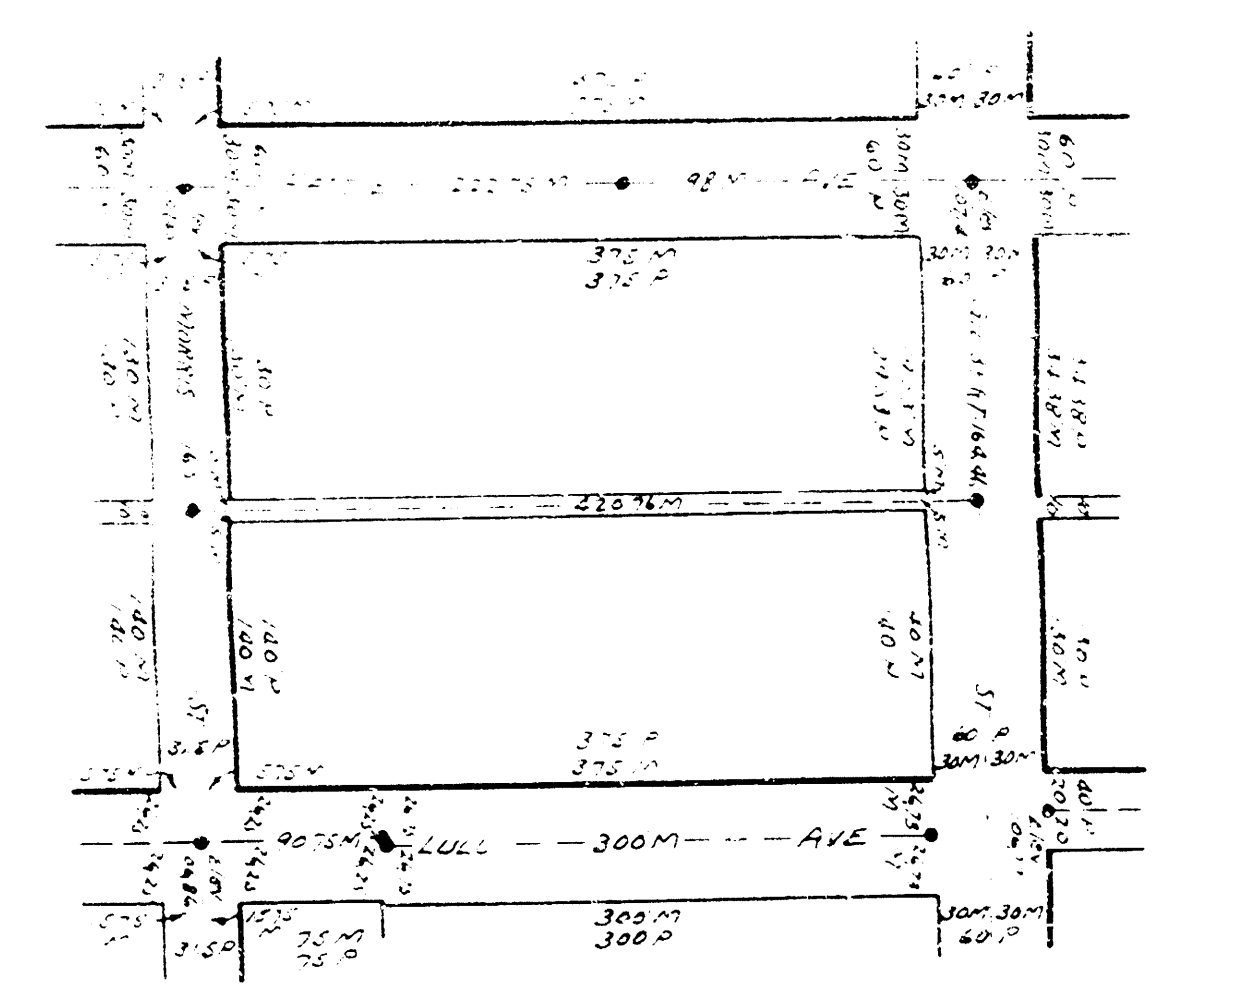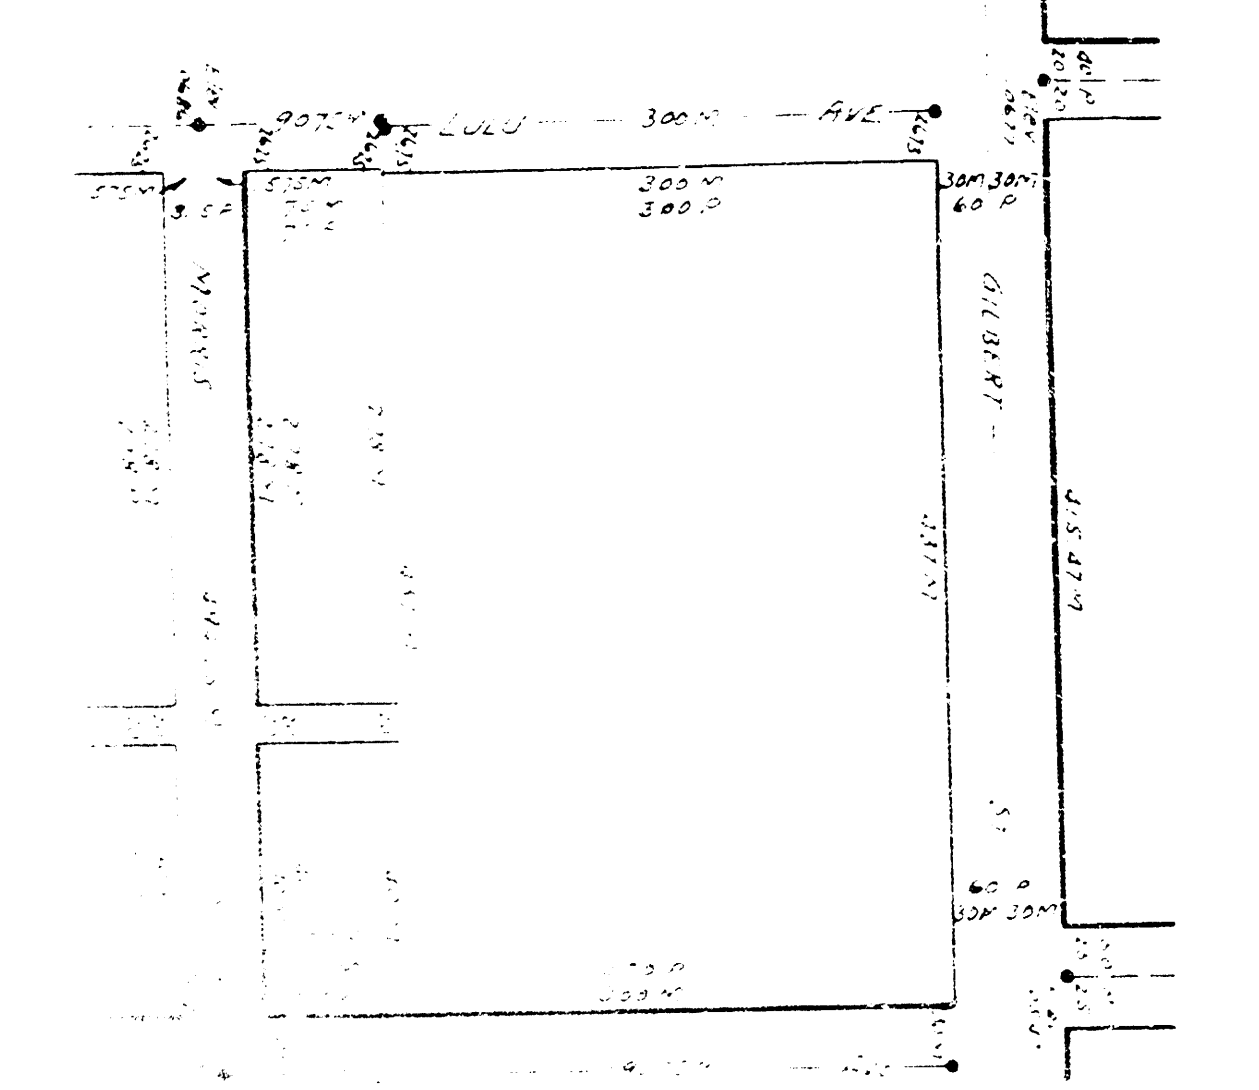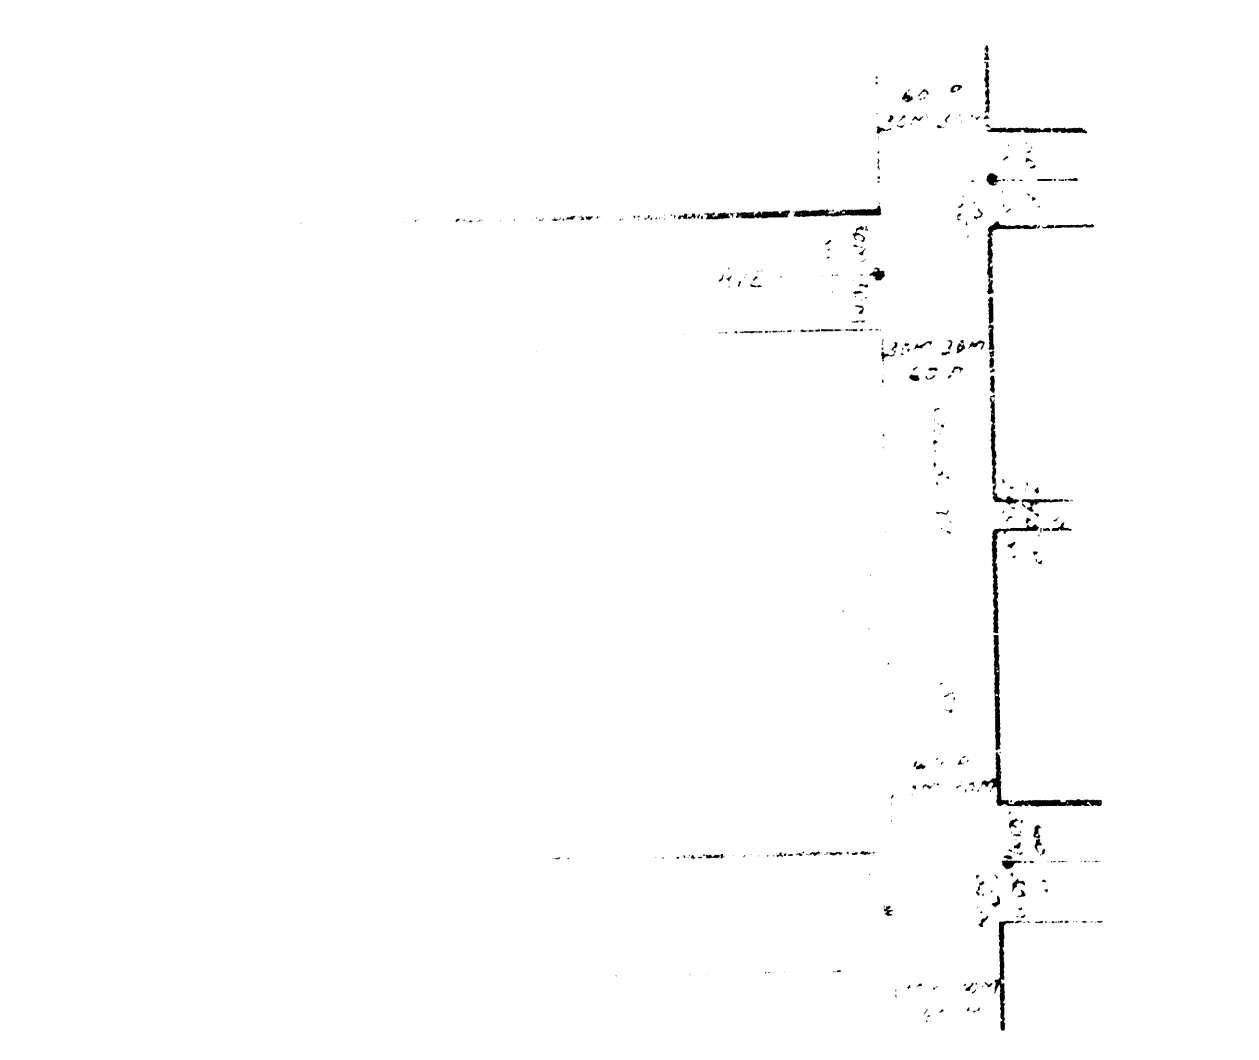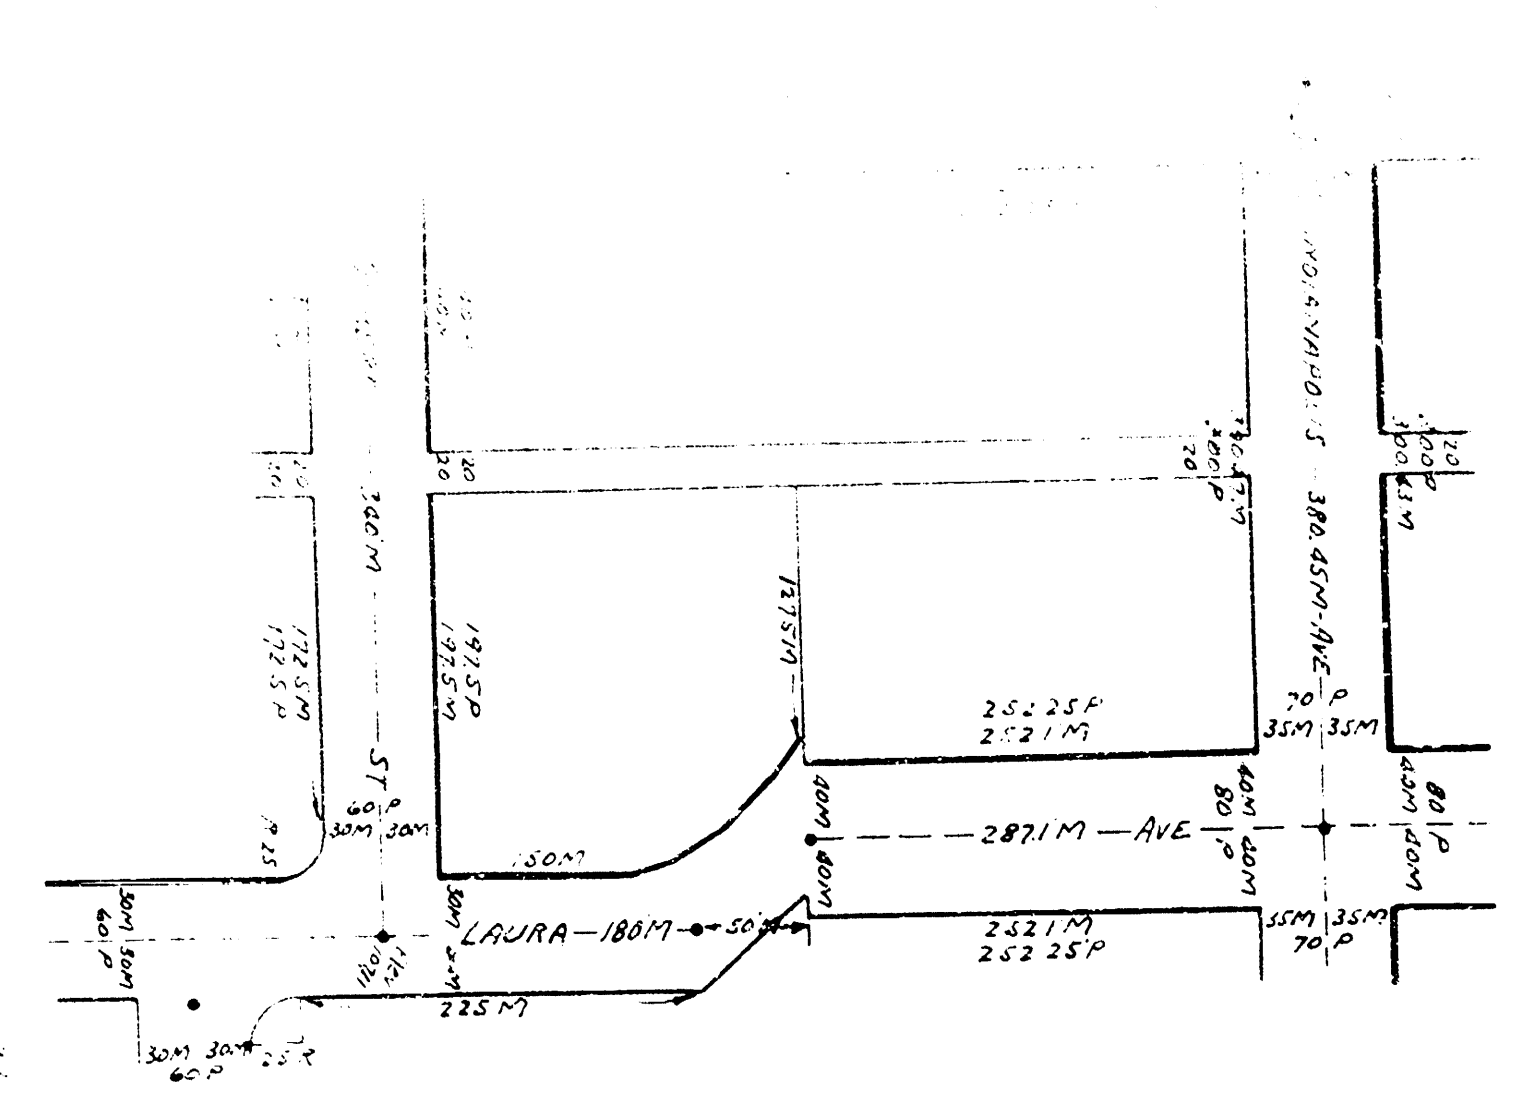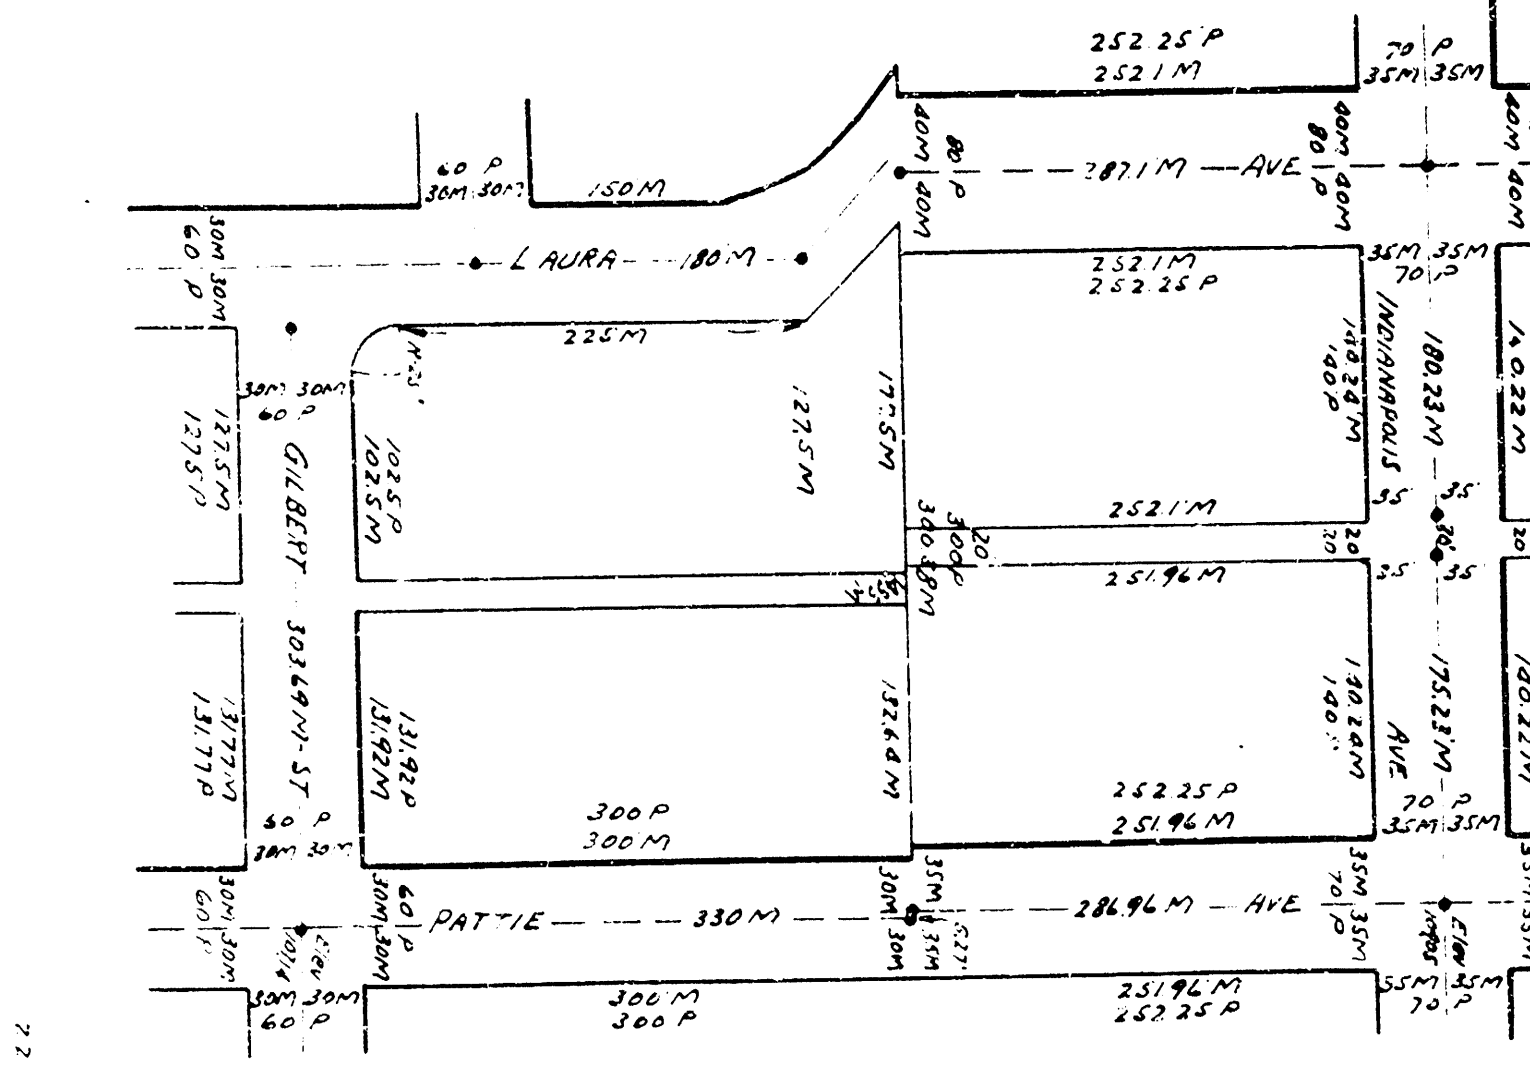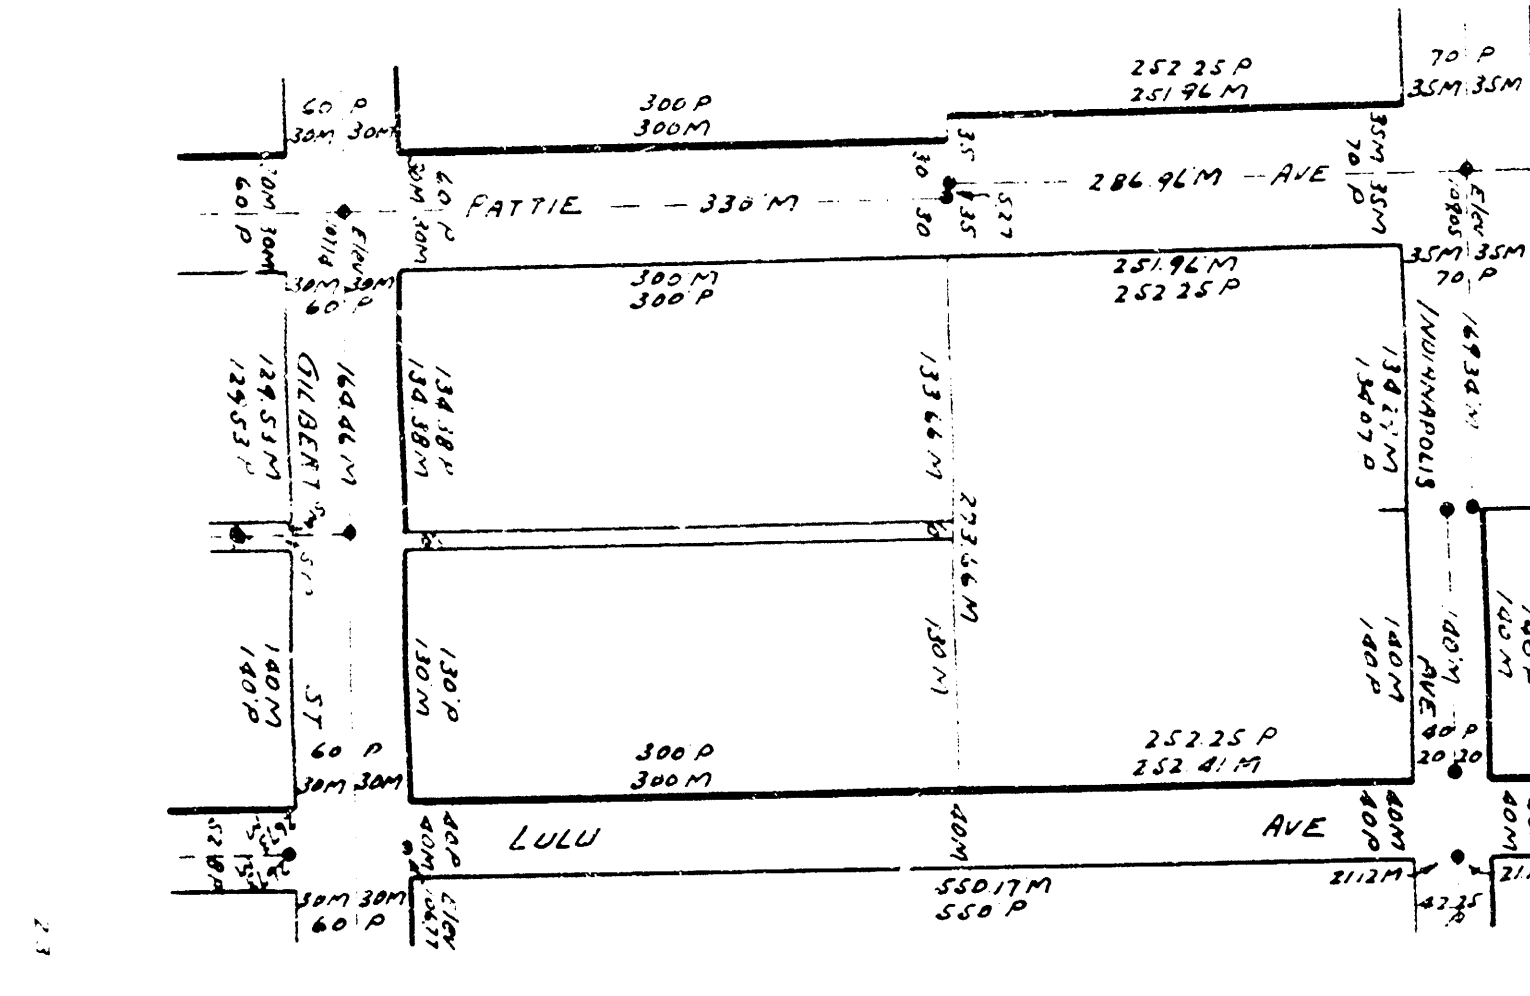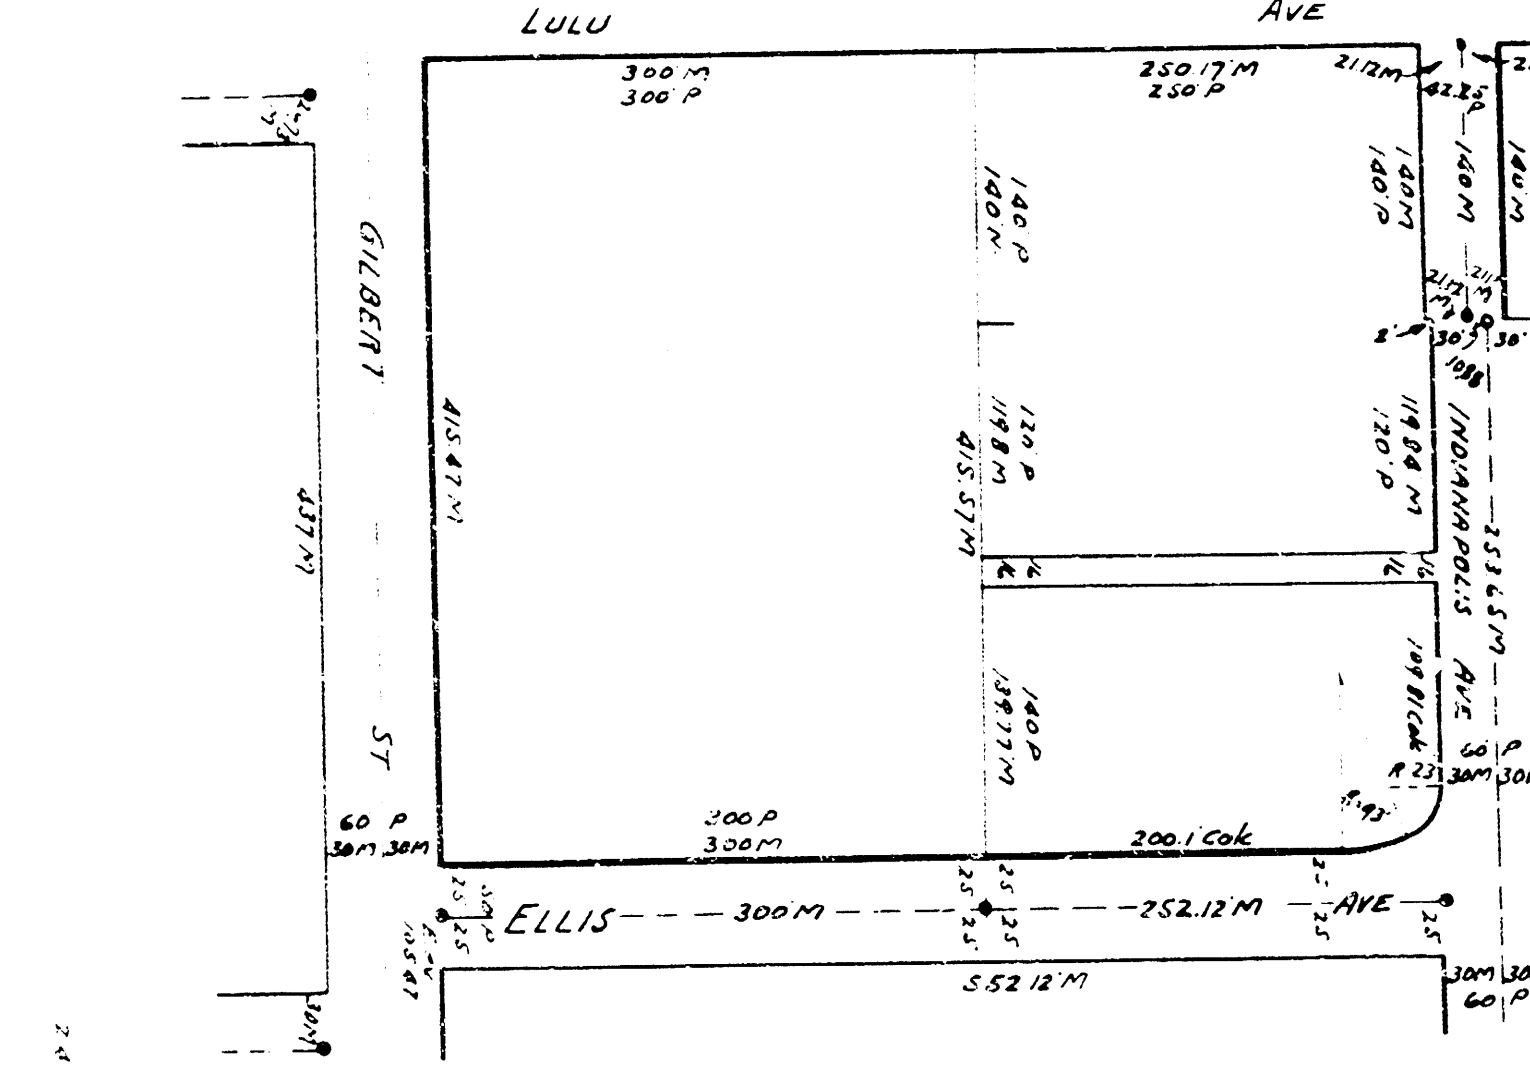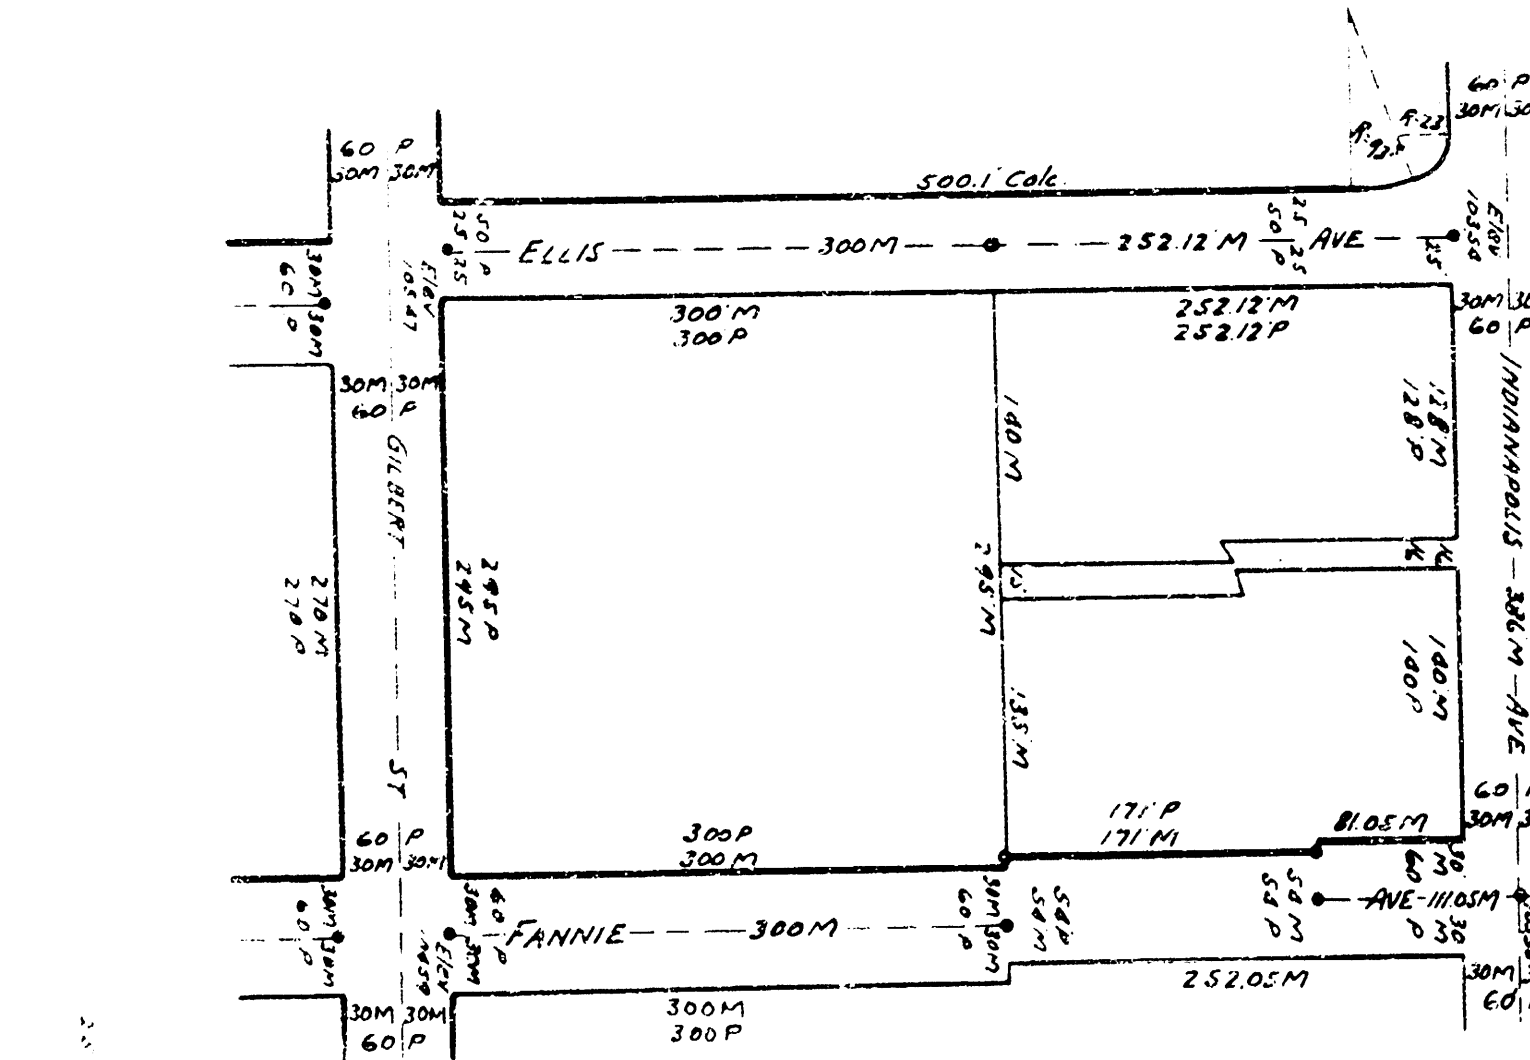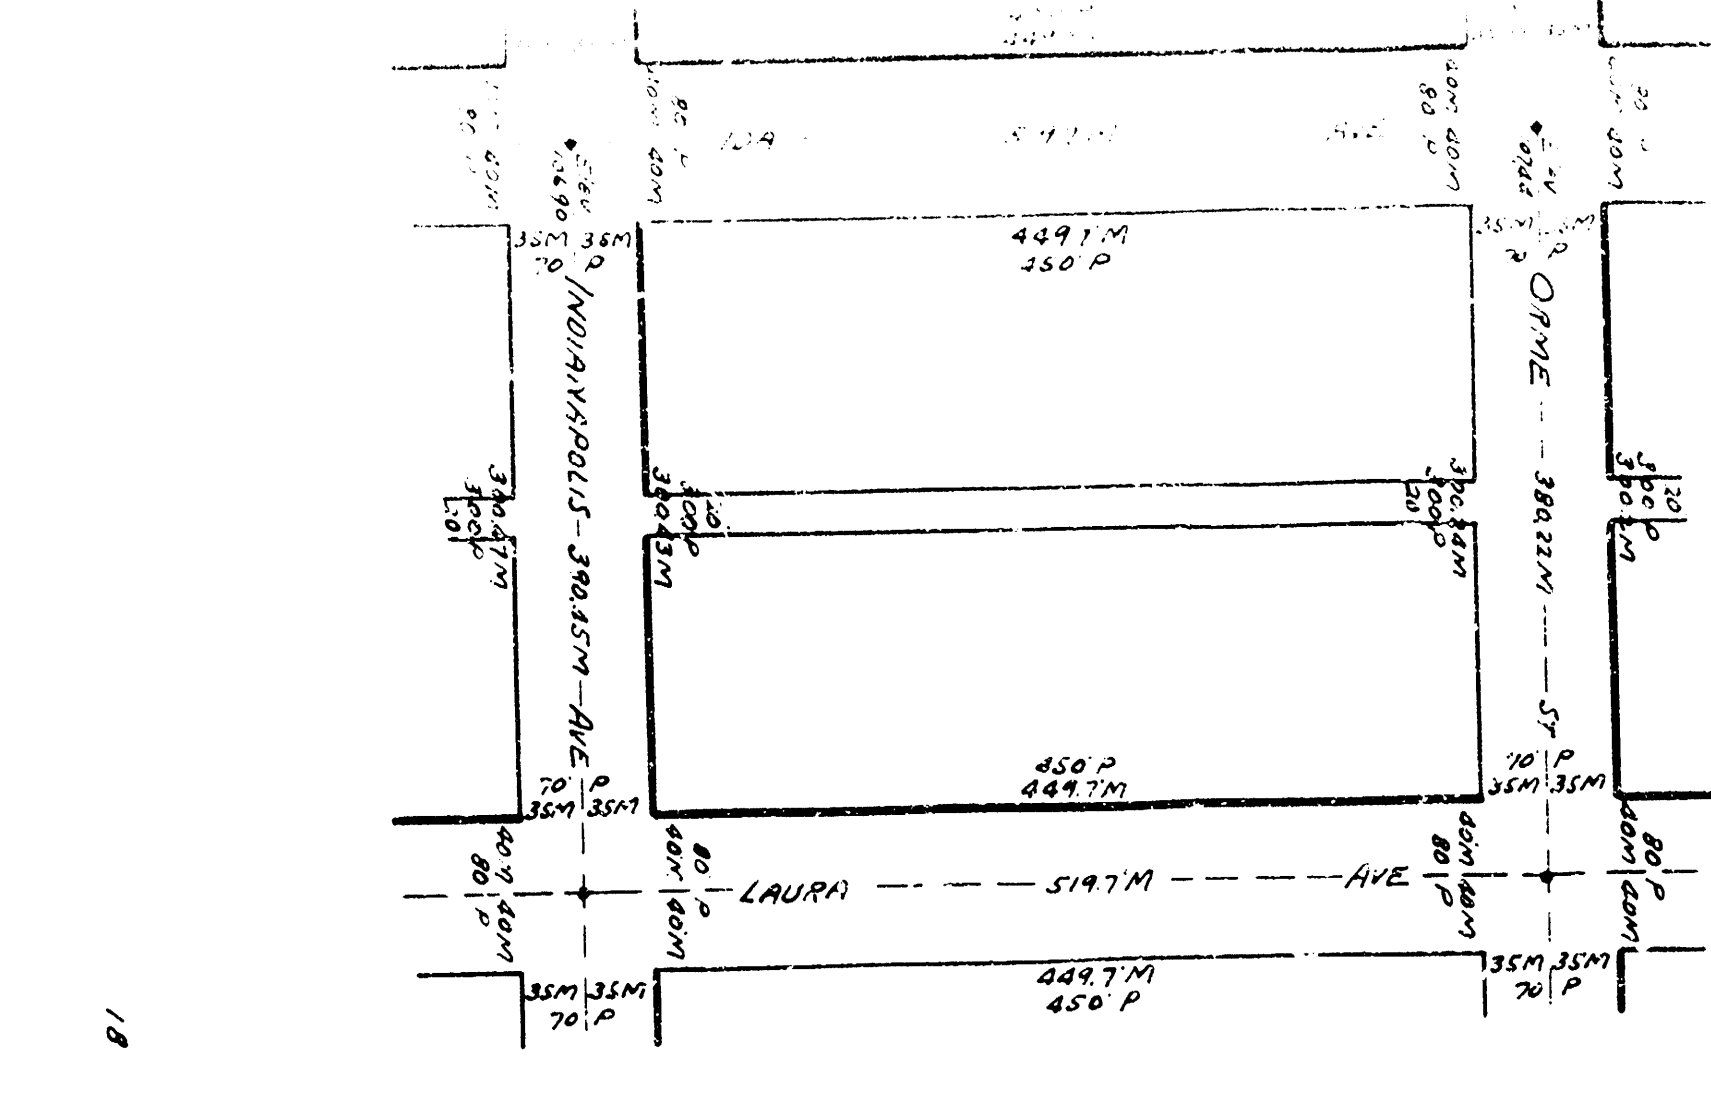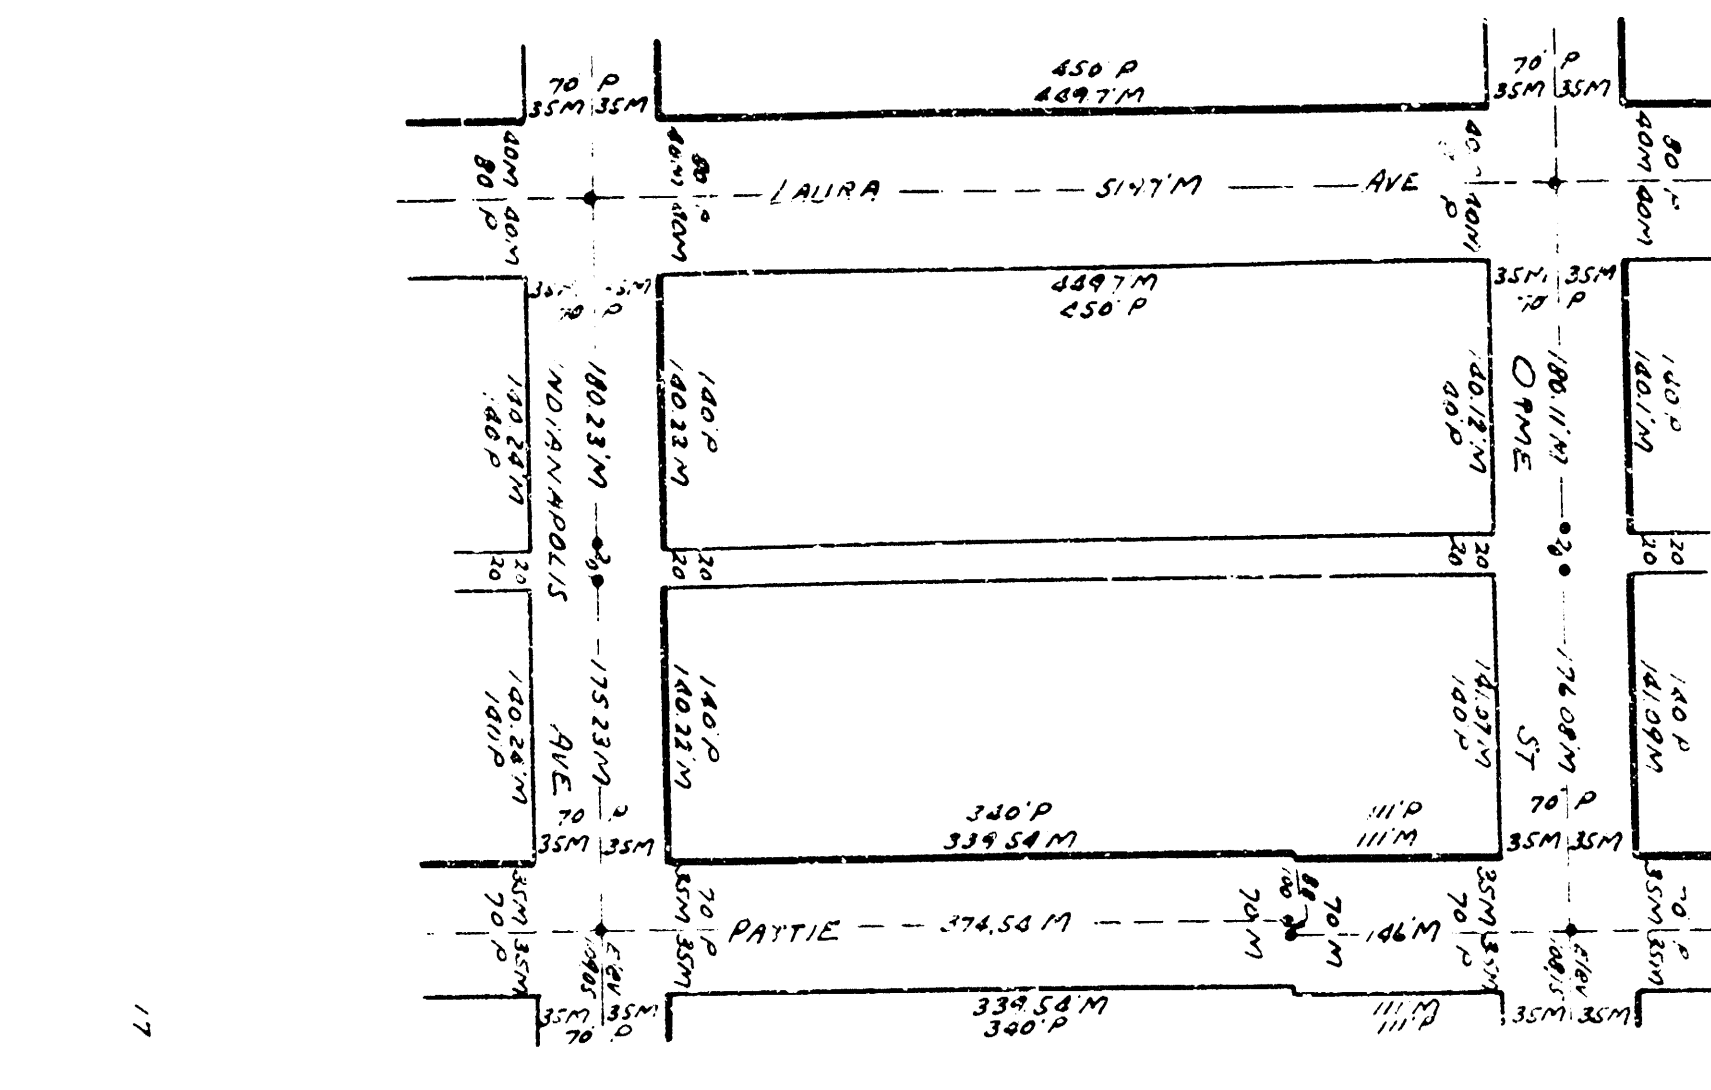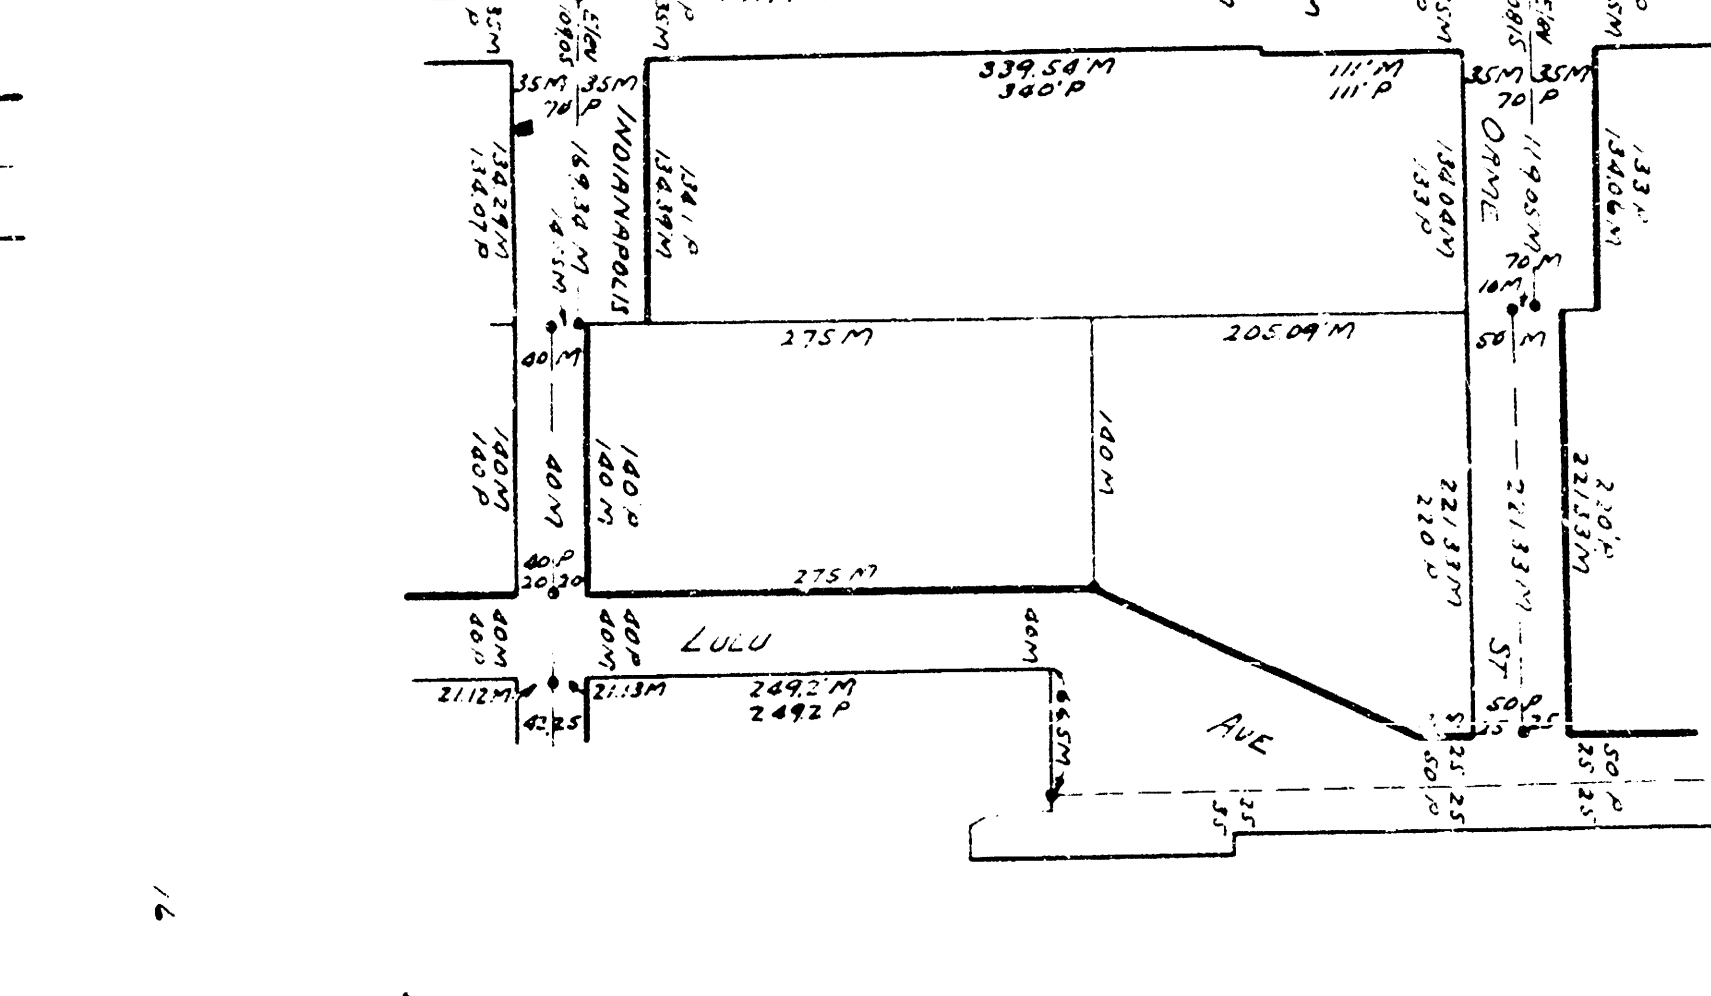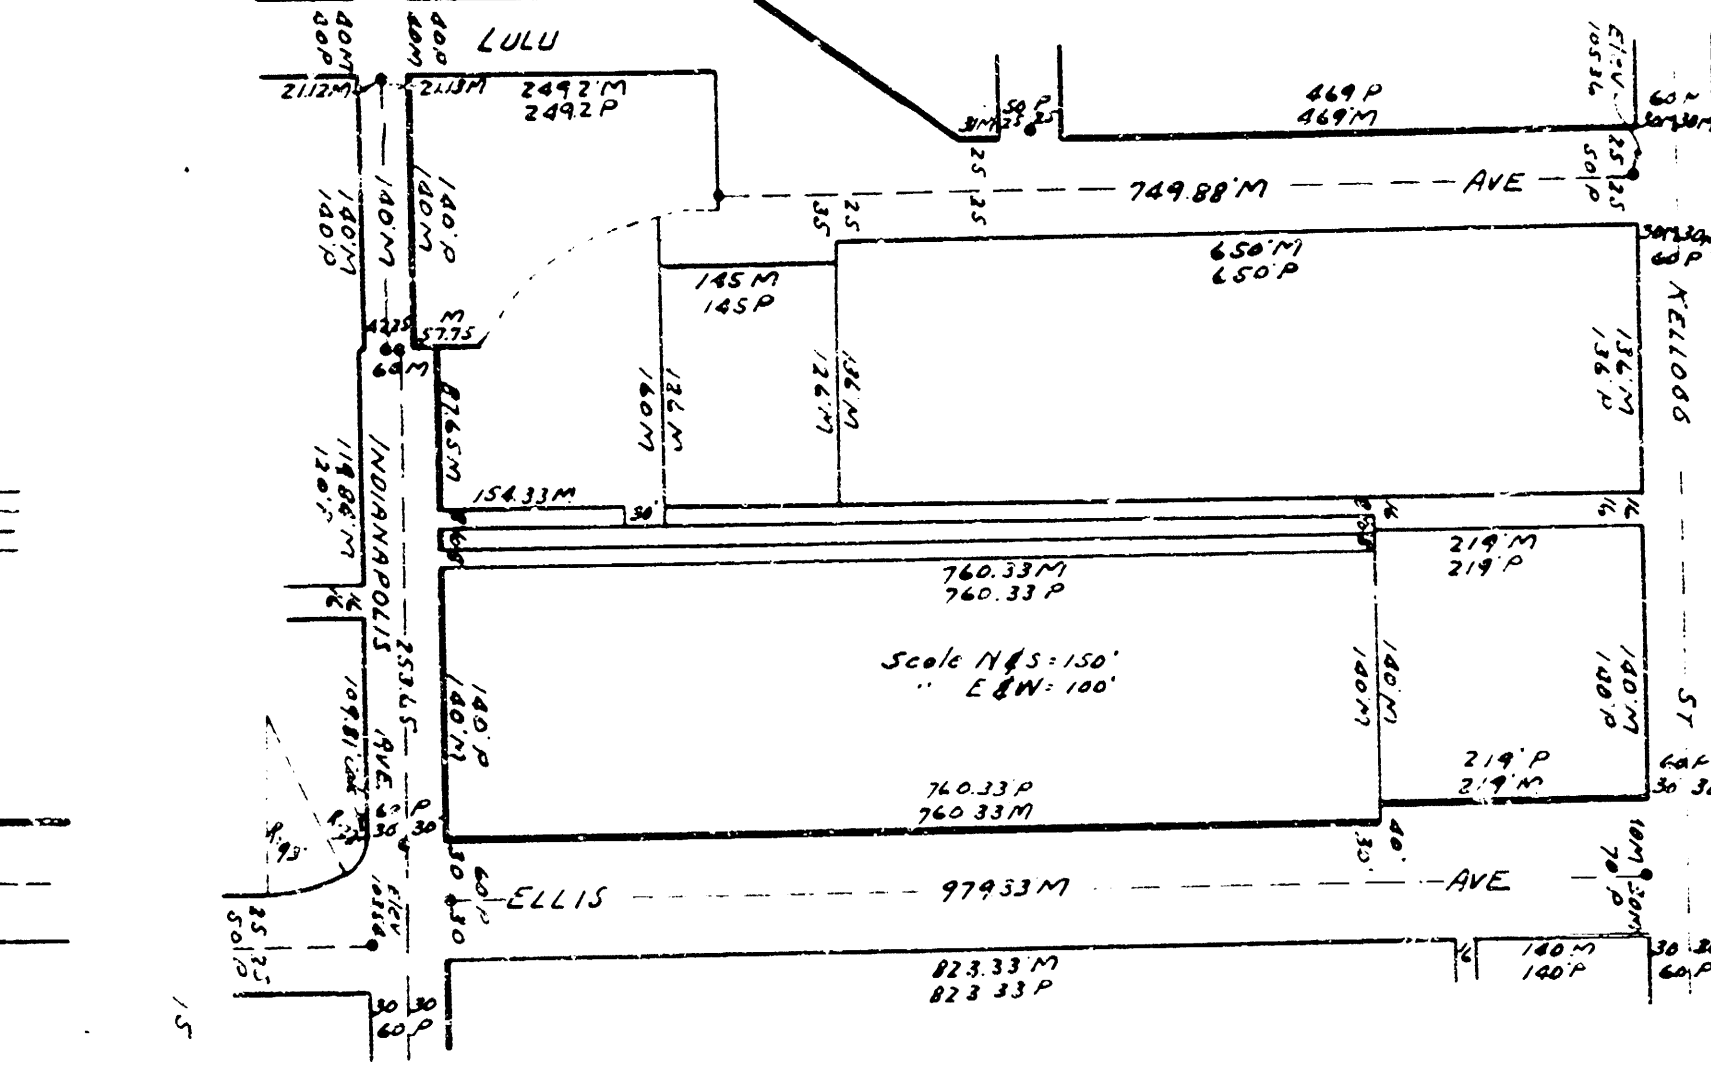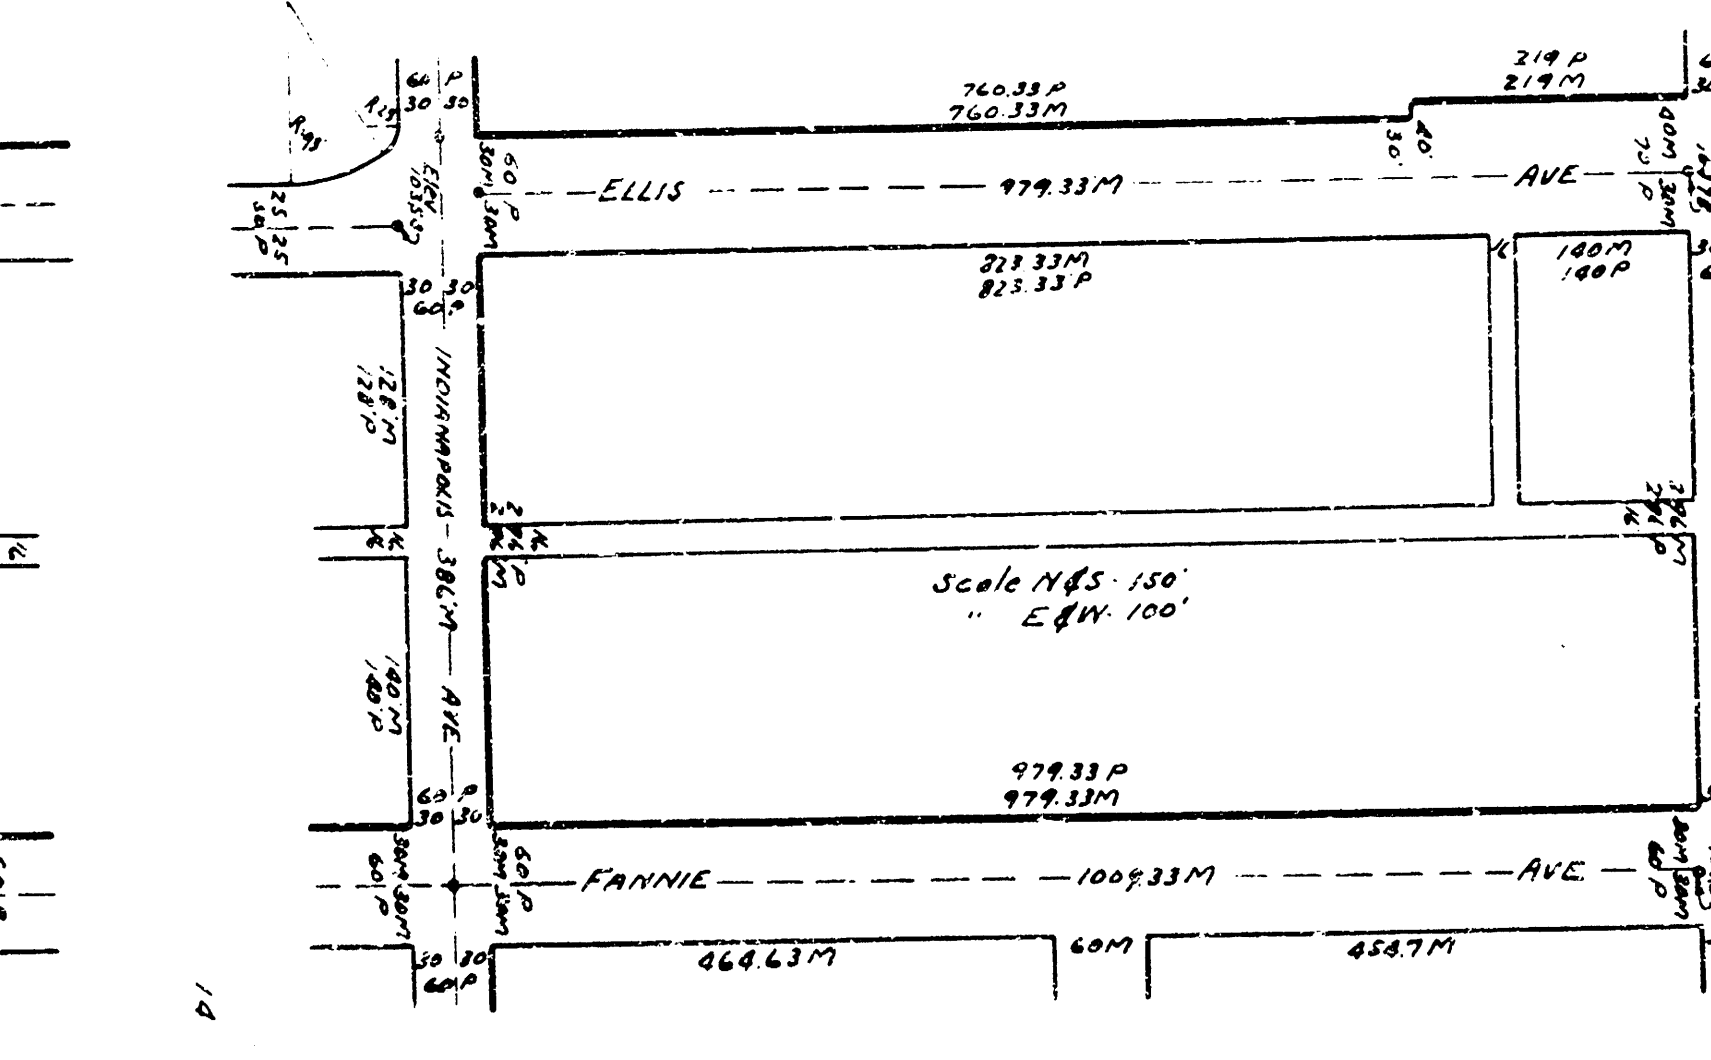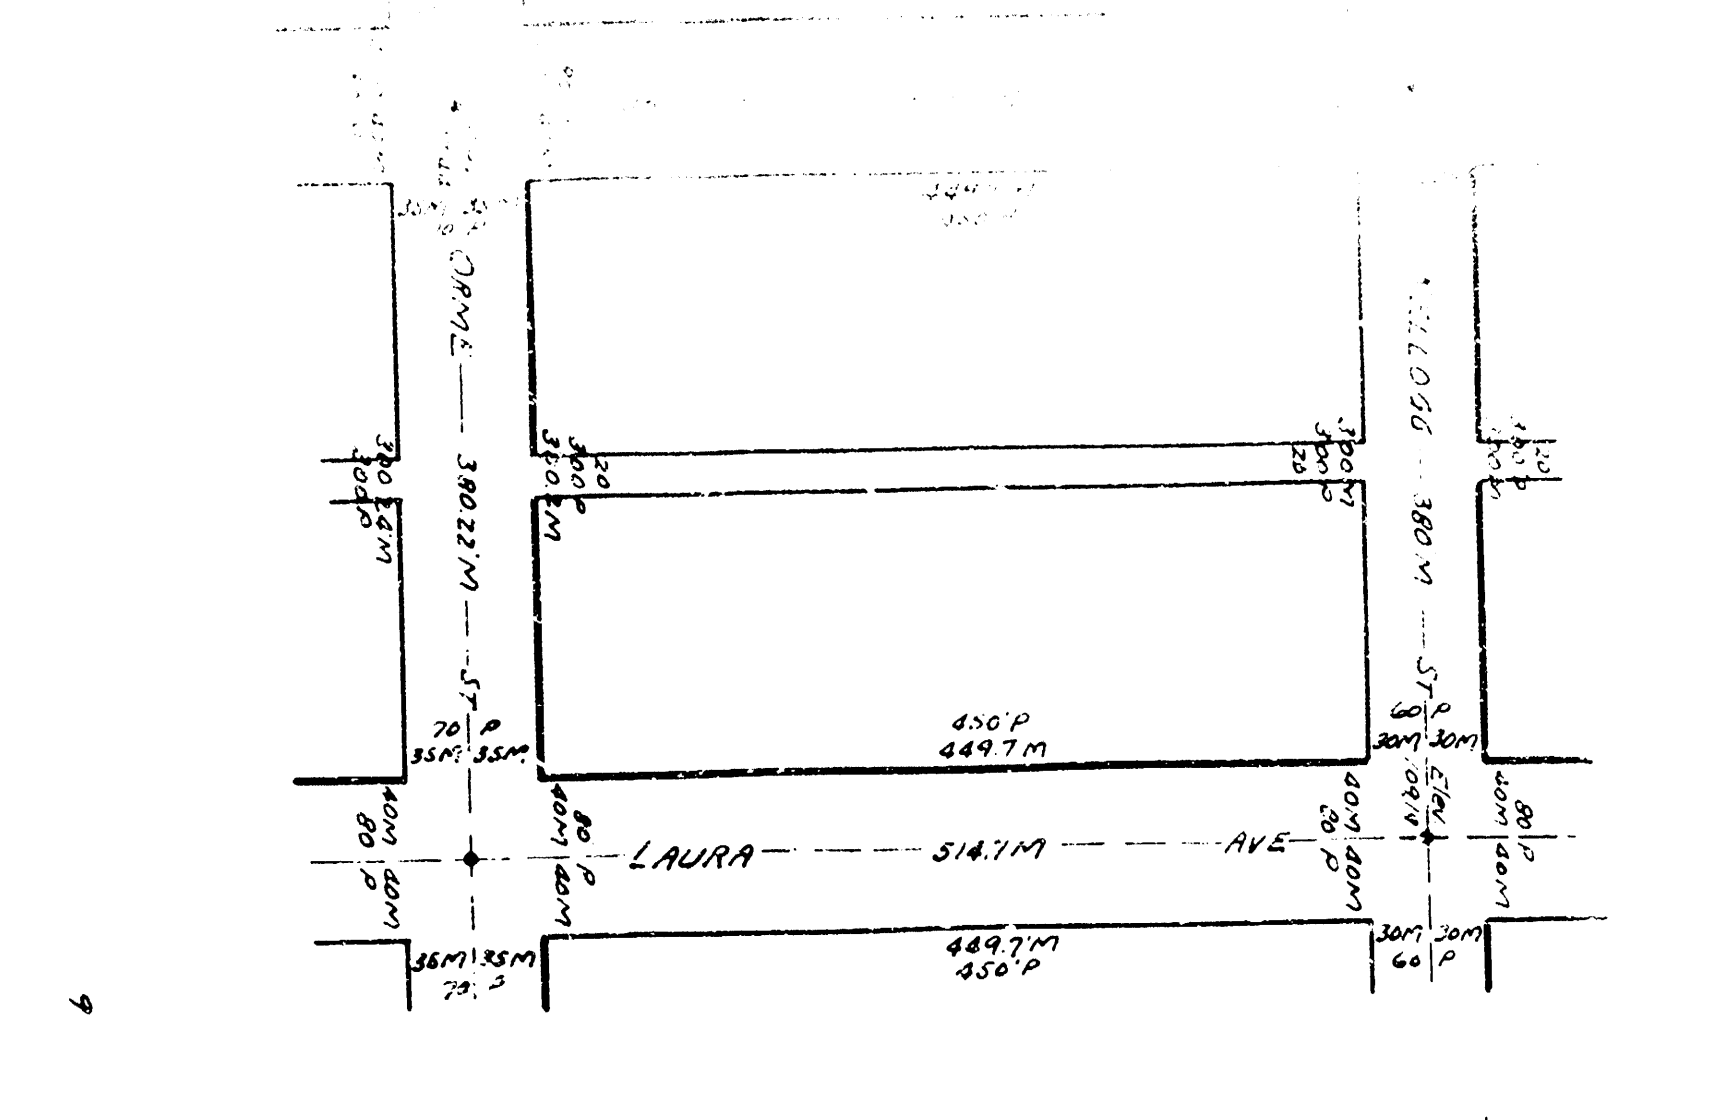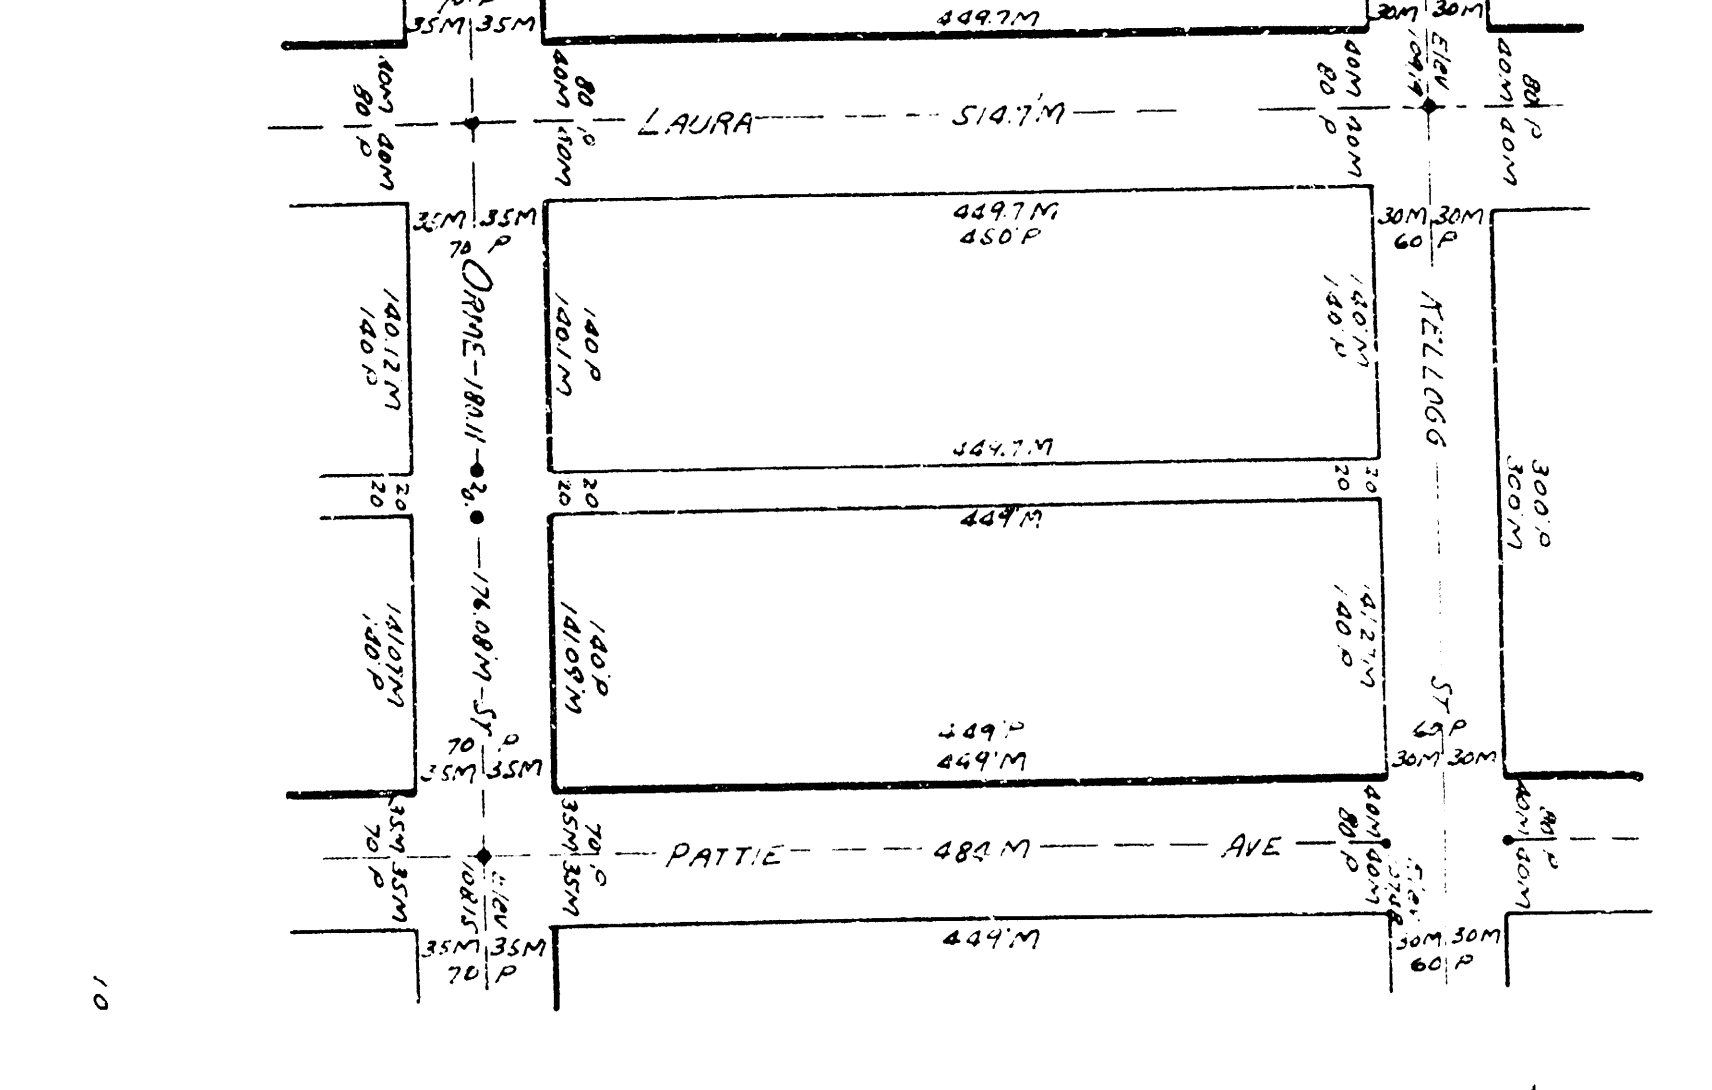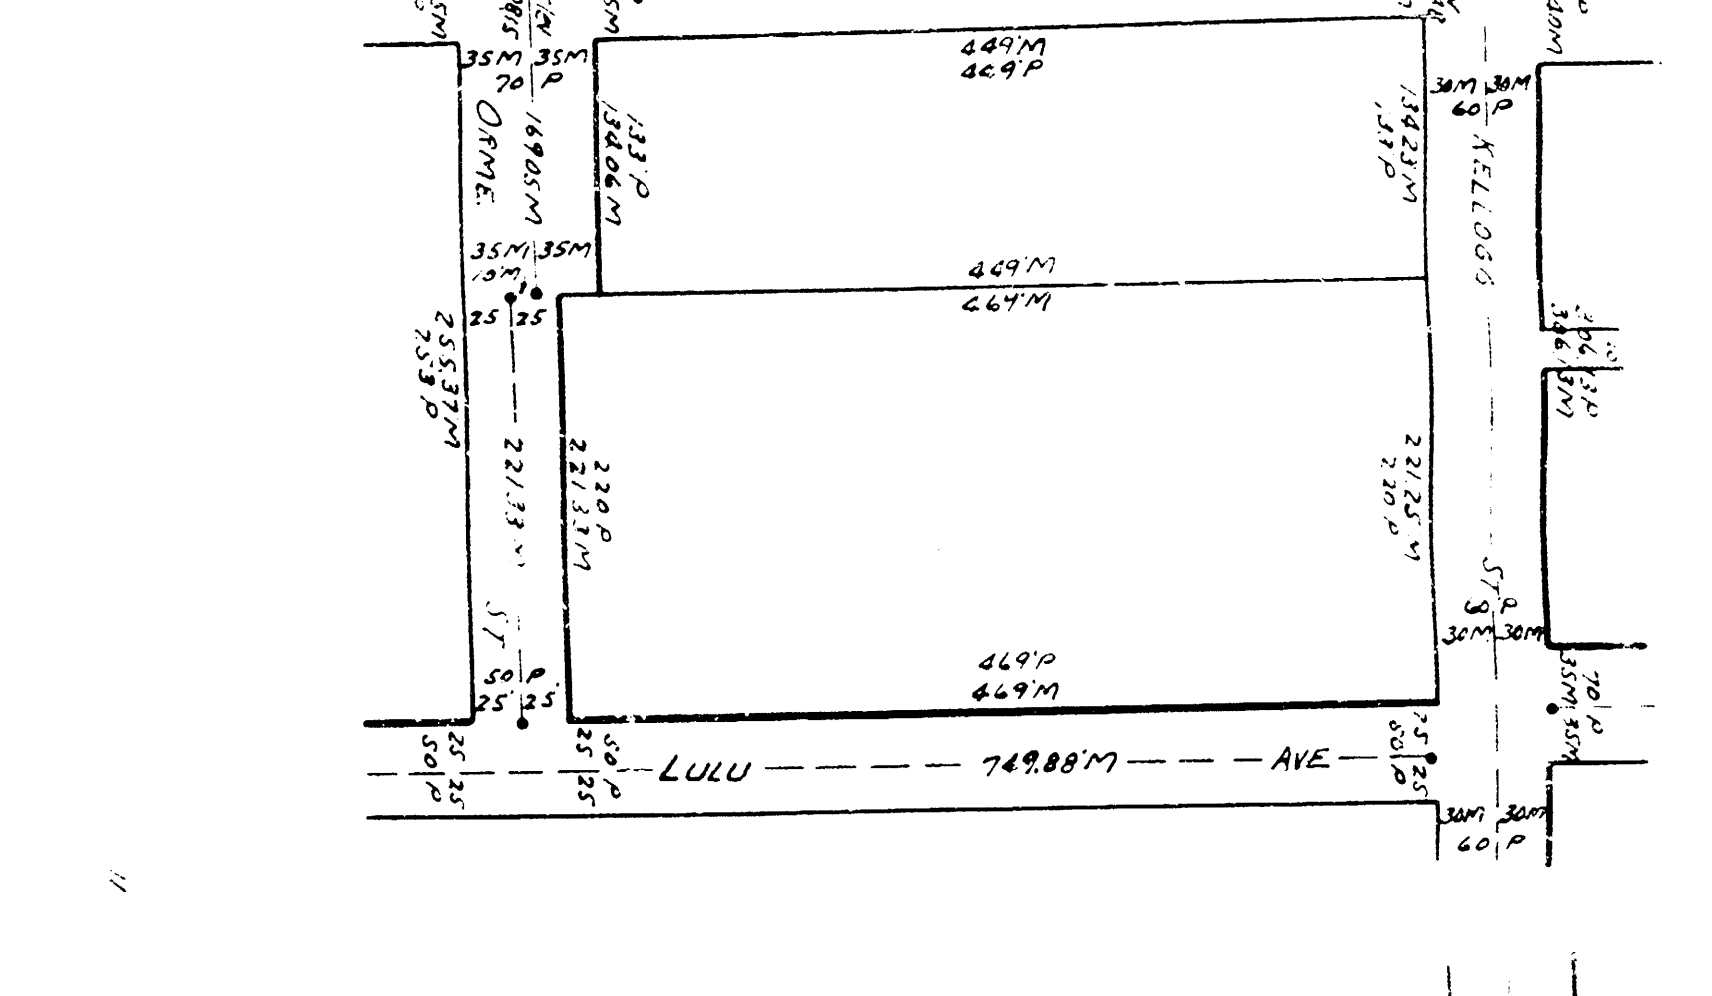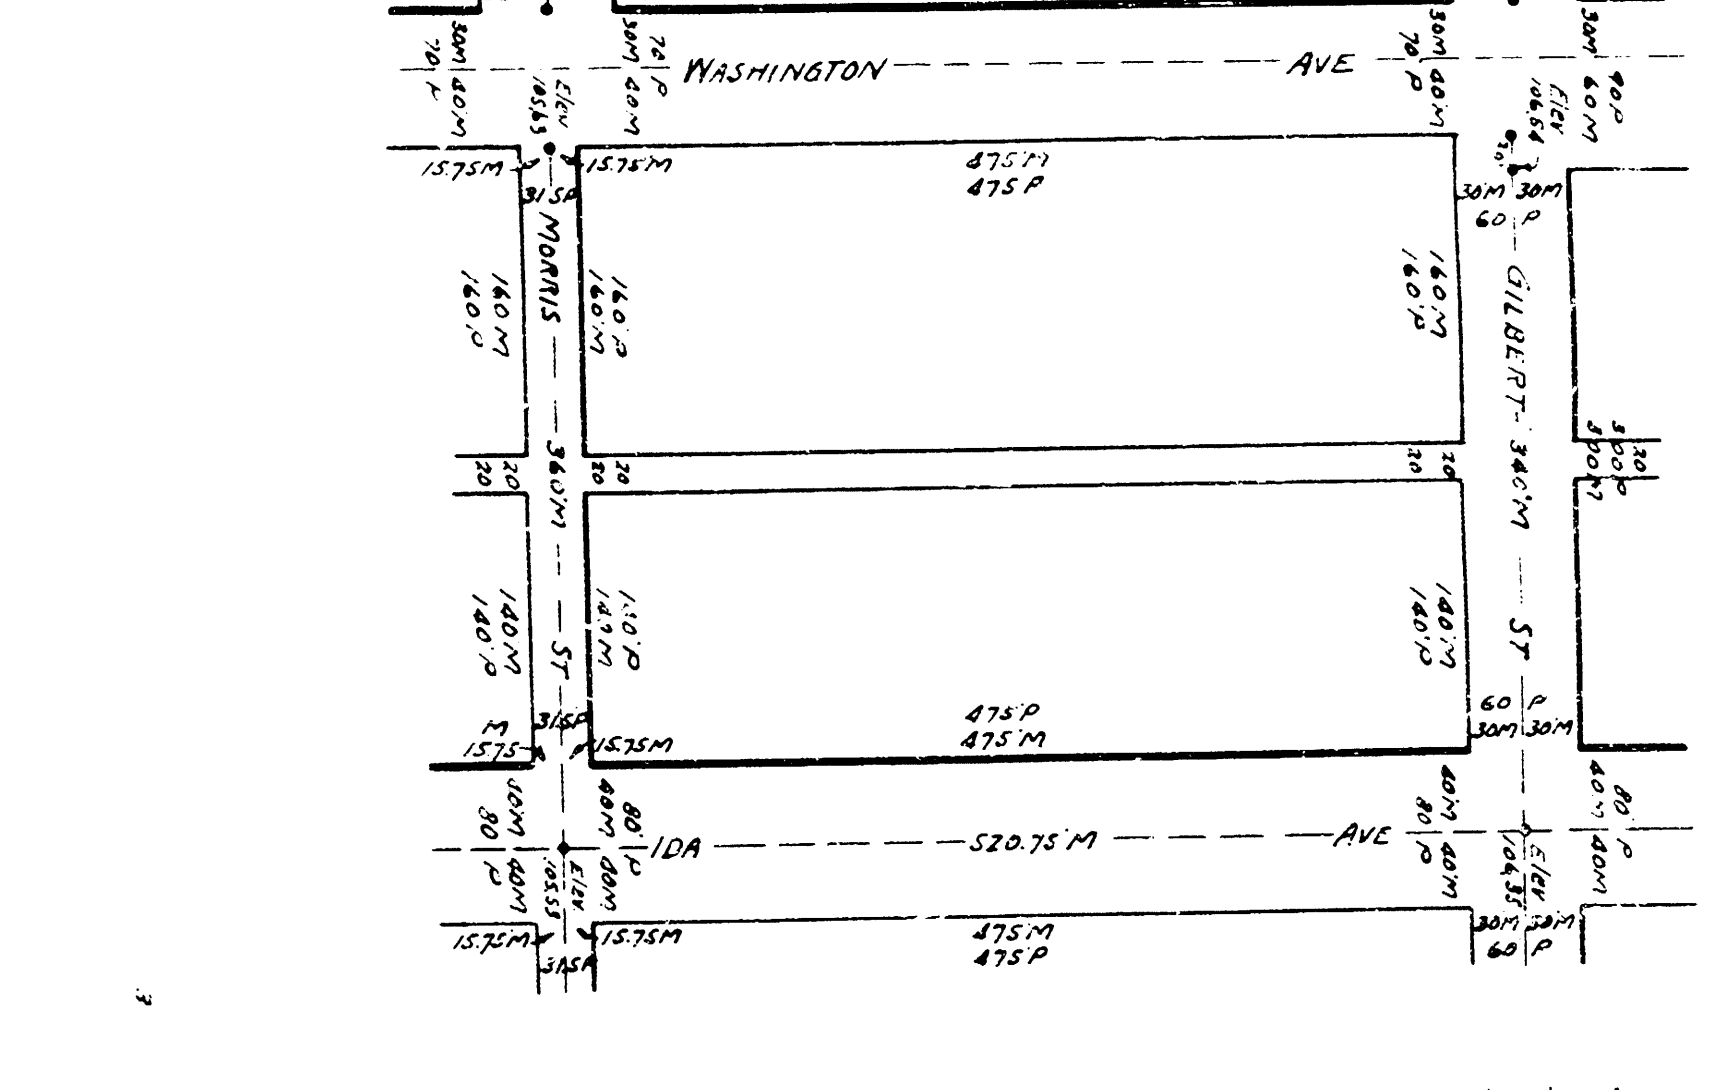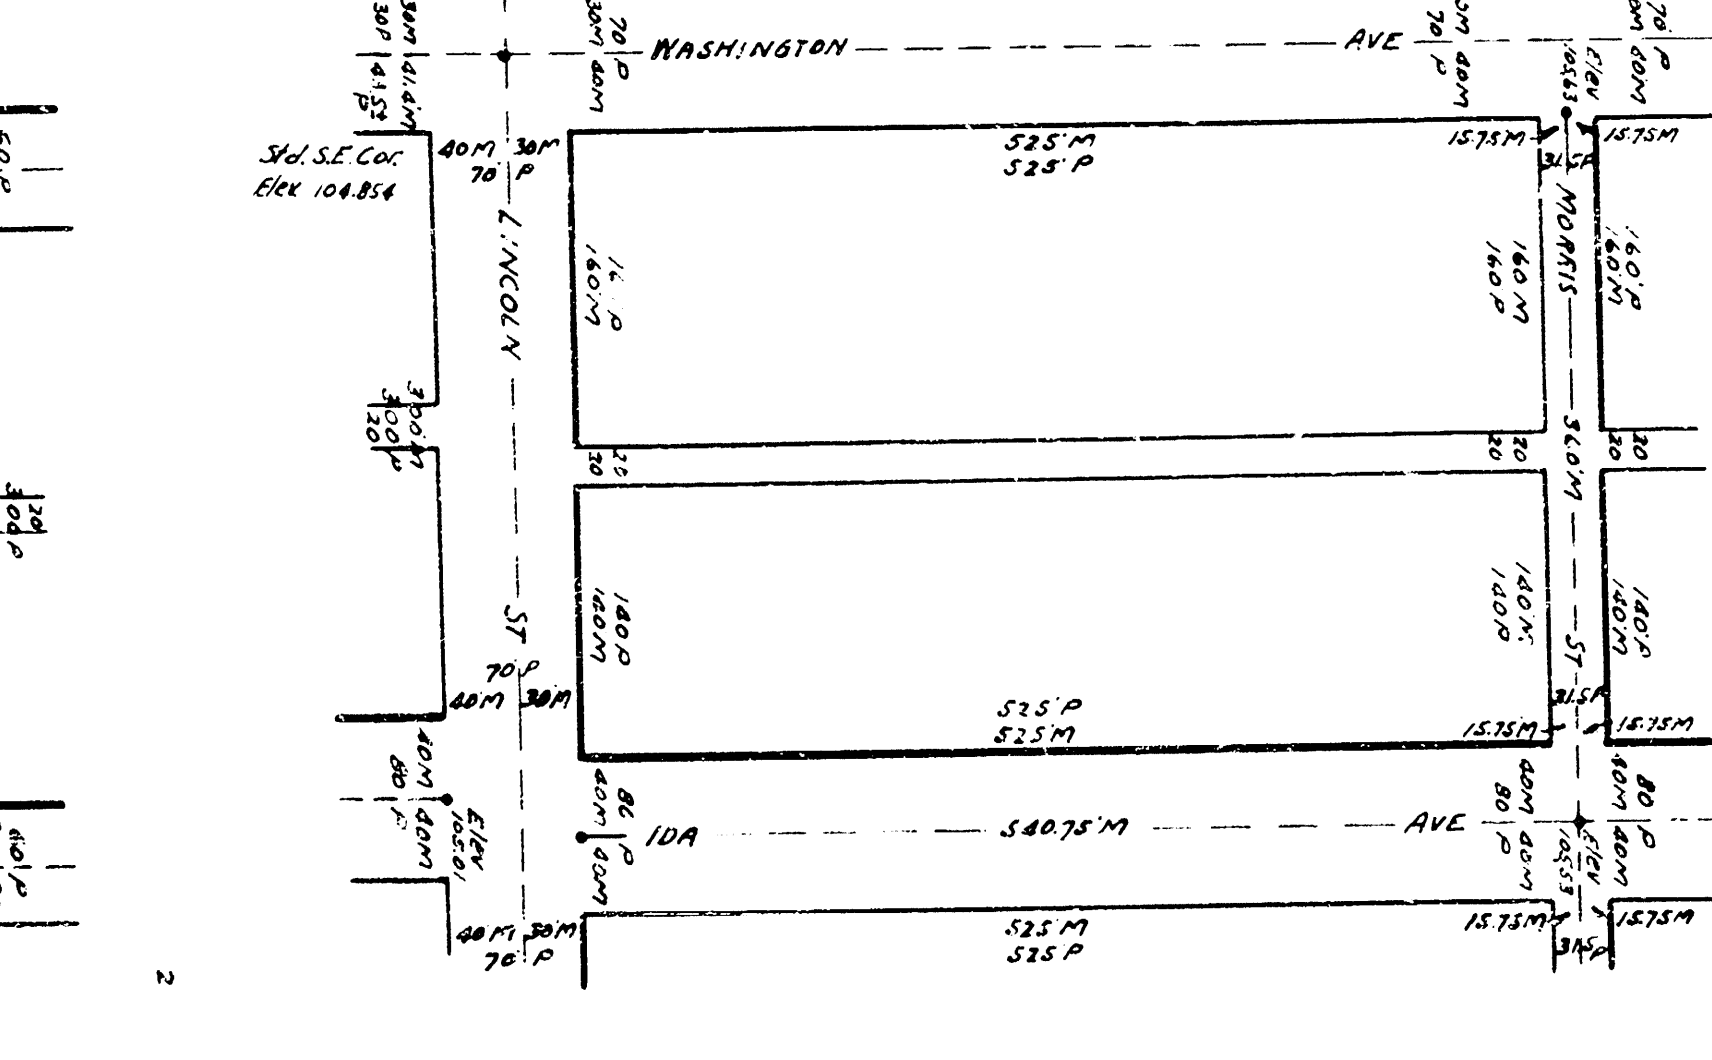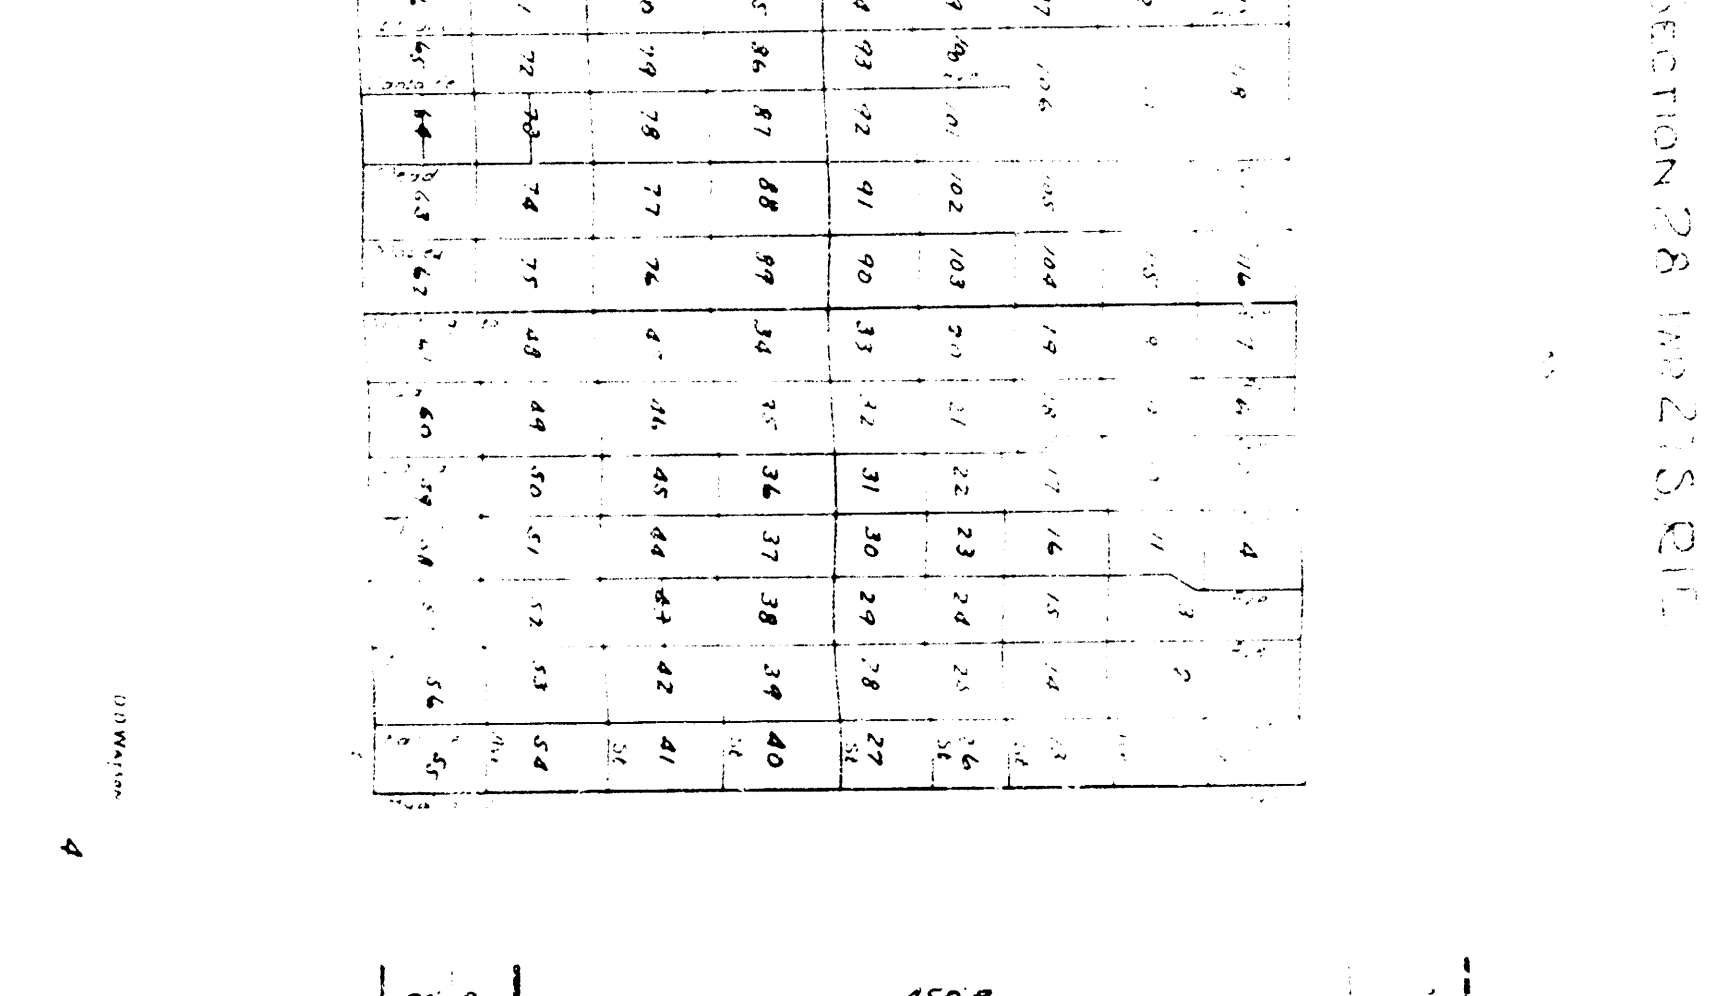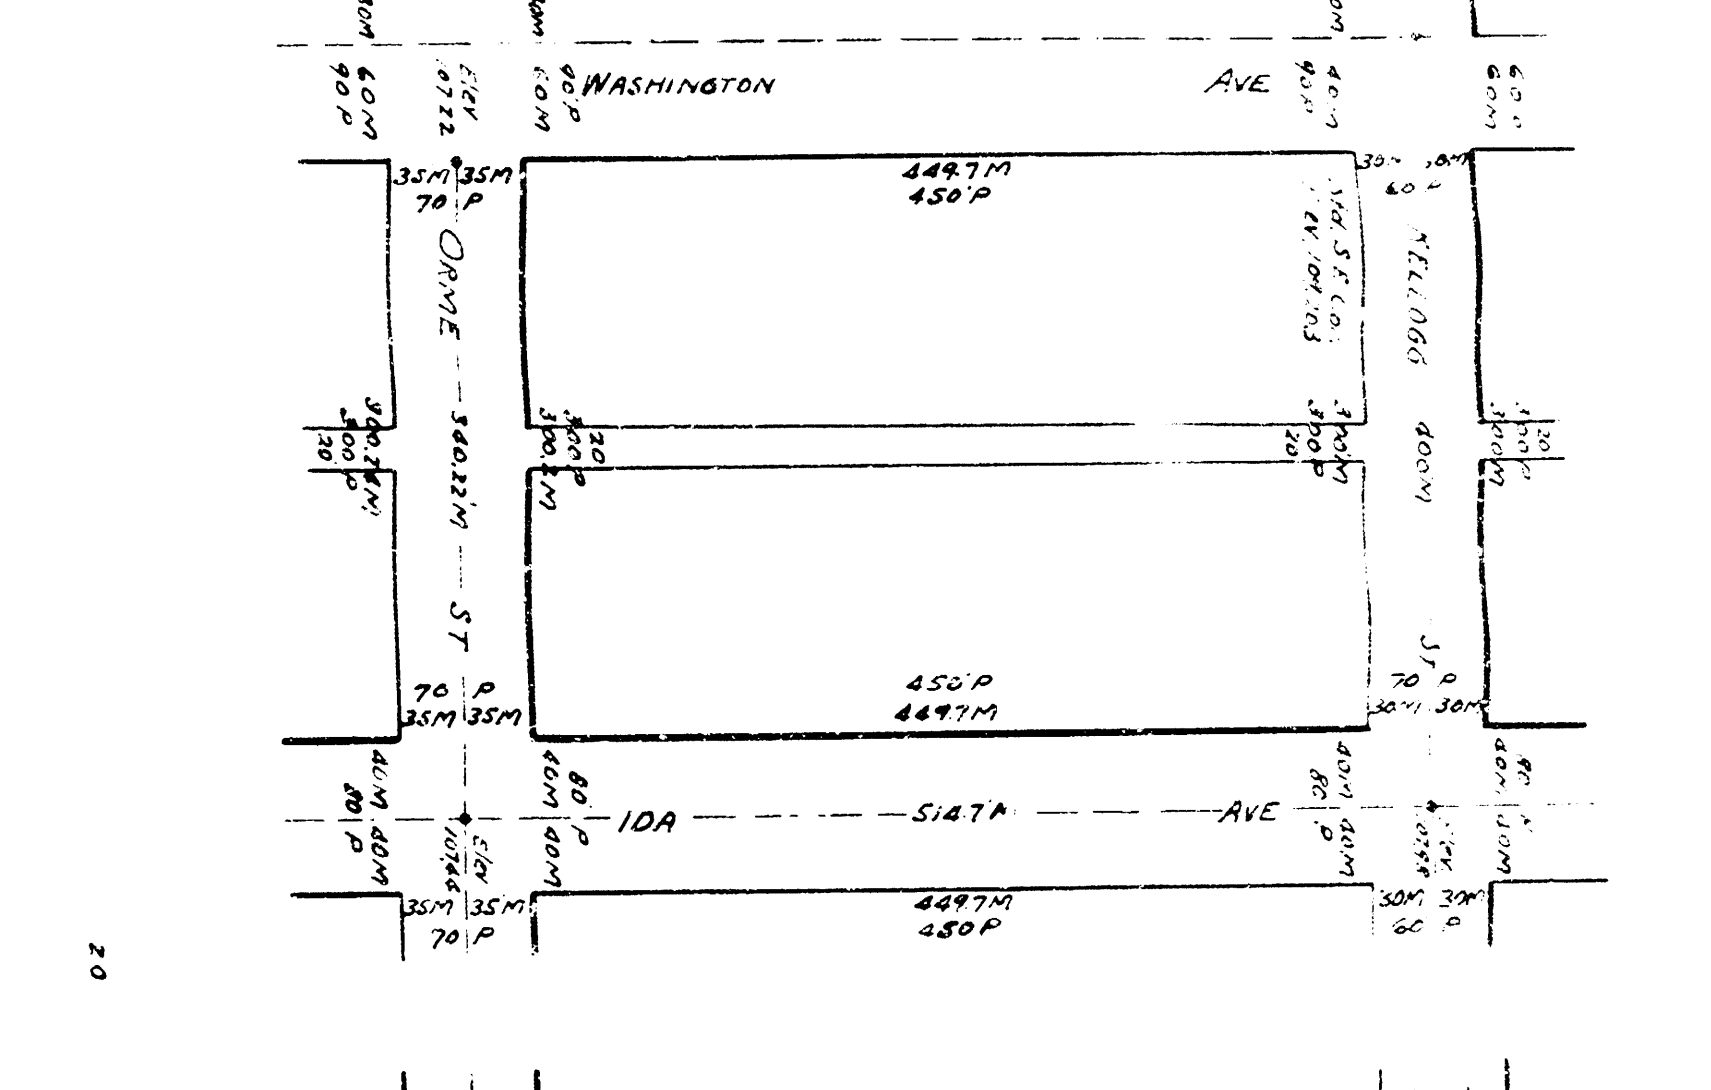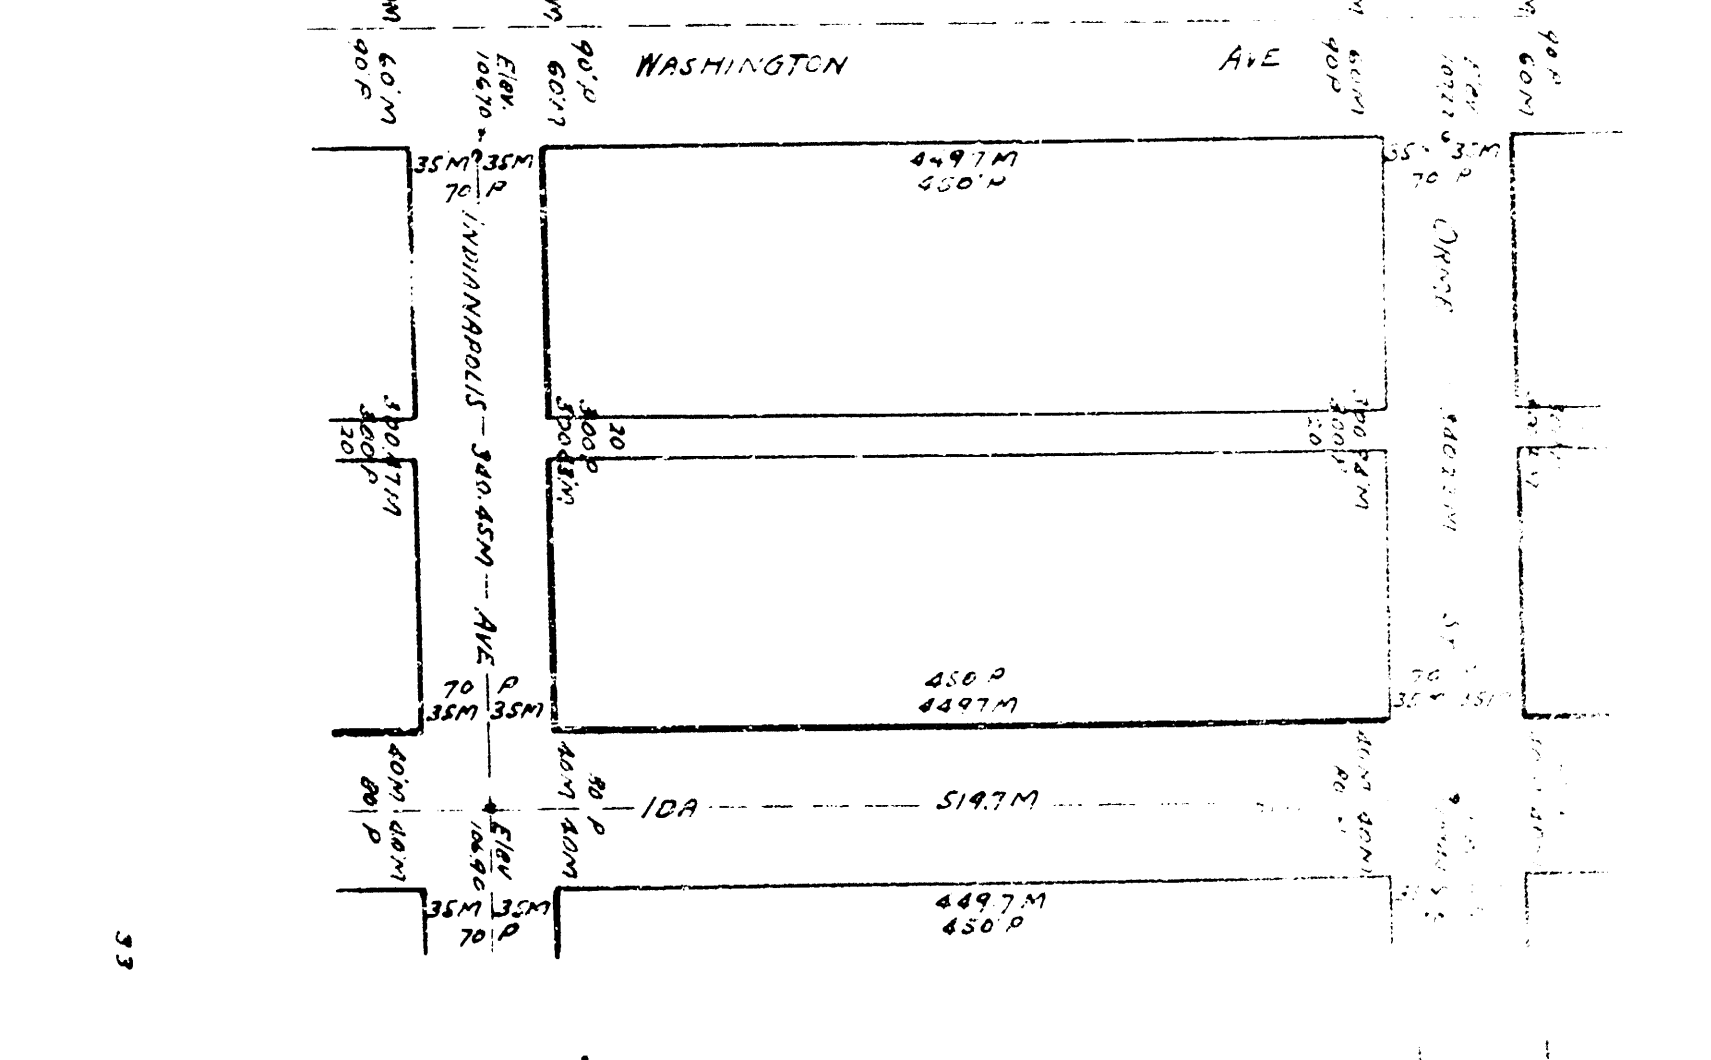


1	2	
---	---	---	---	---	---	---	---	---	----	----	-----


SECTION 28 TOWNSHIP 25 S. R. 12 E.

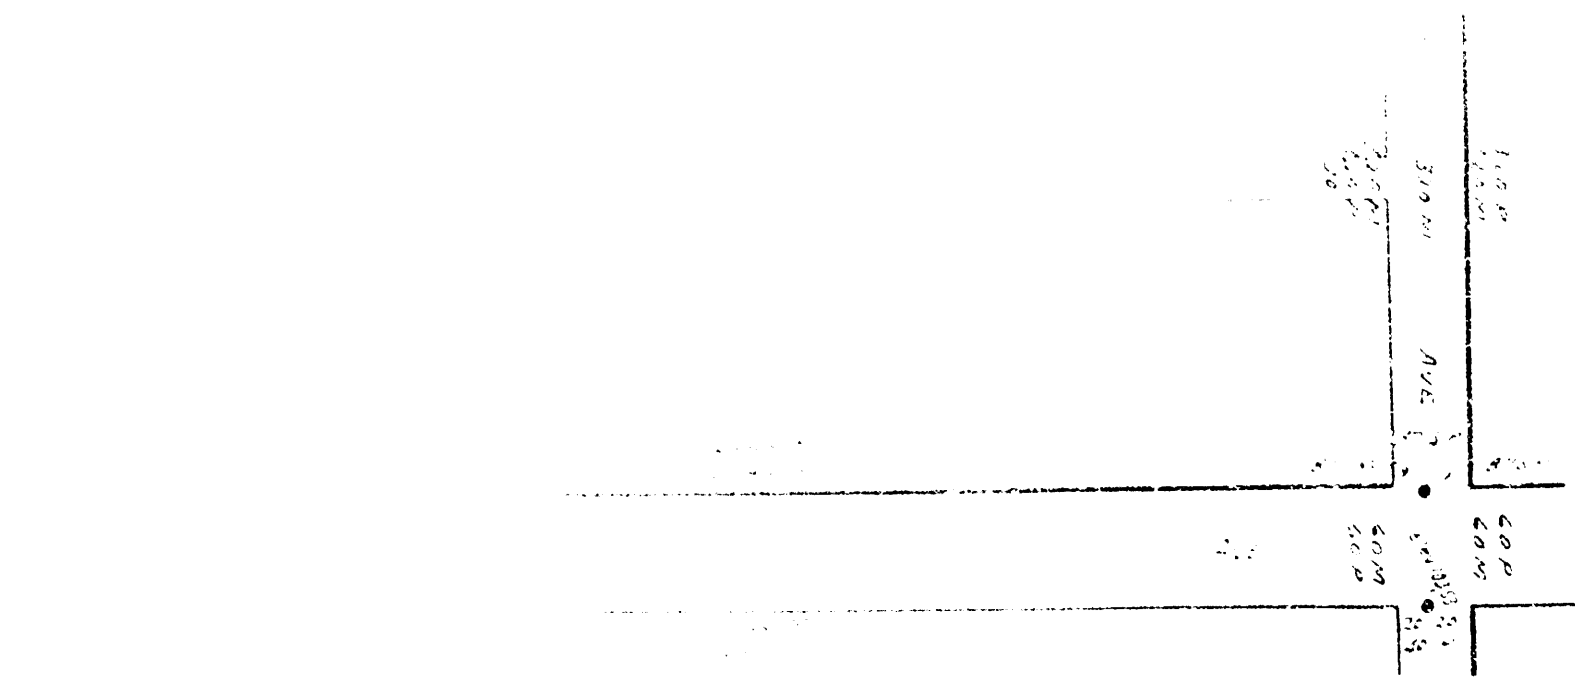


63

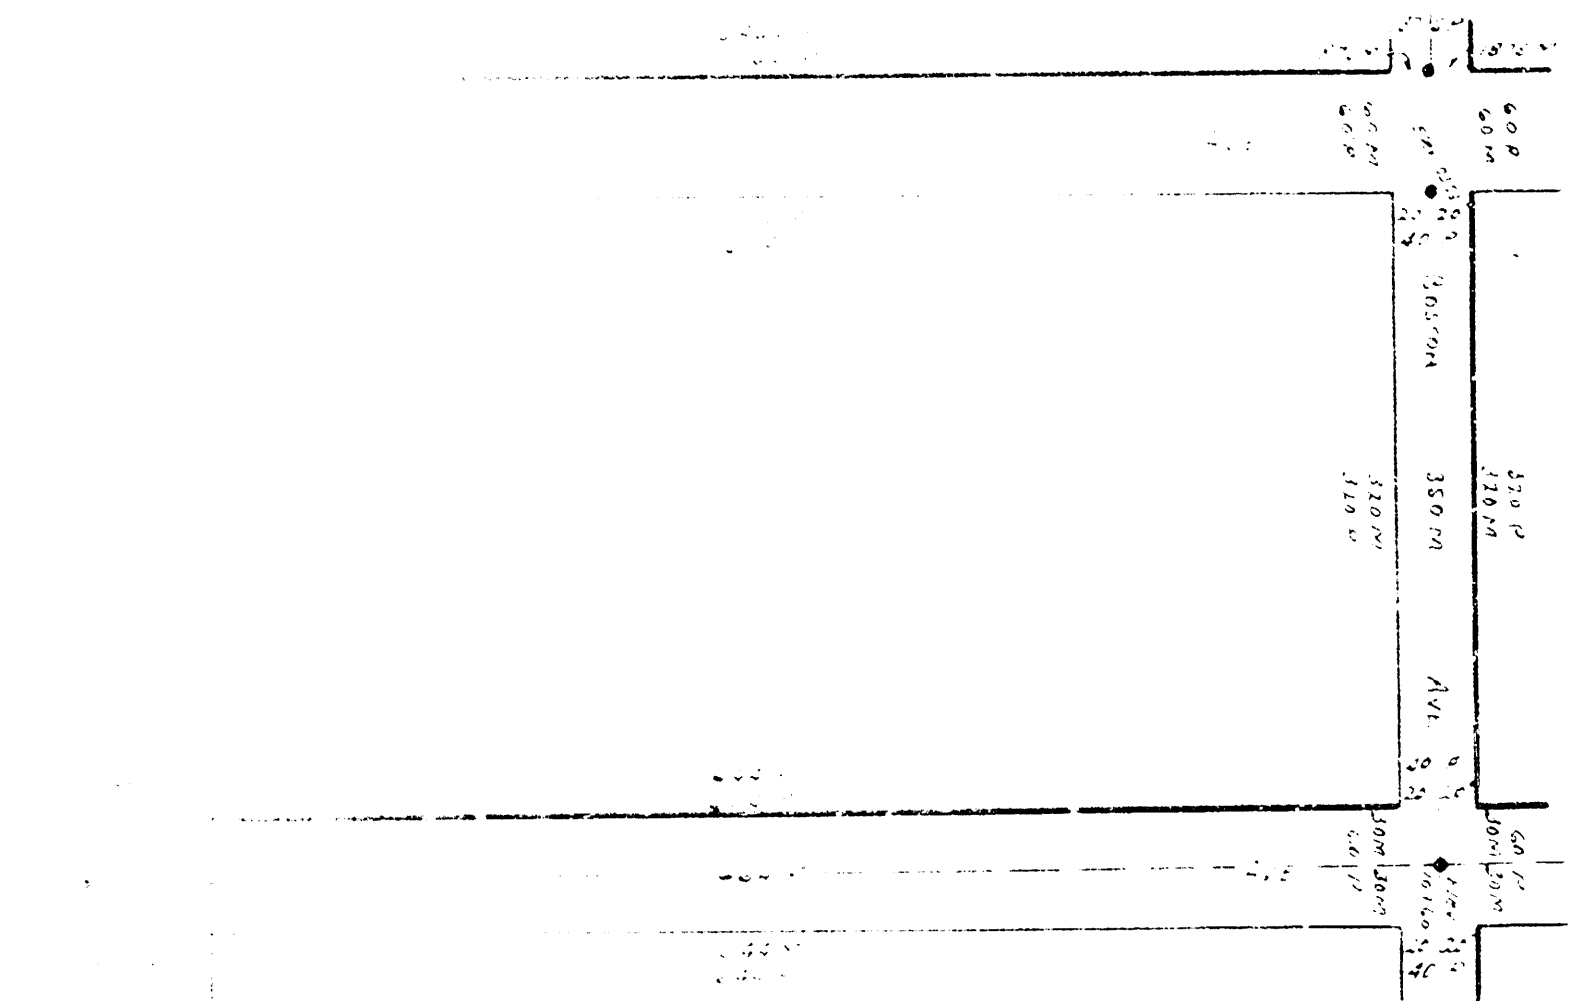


64

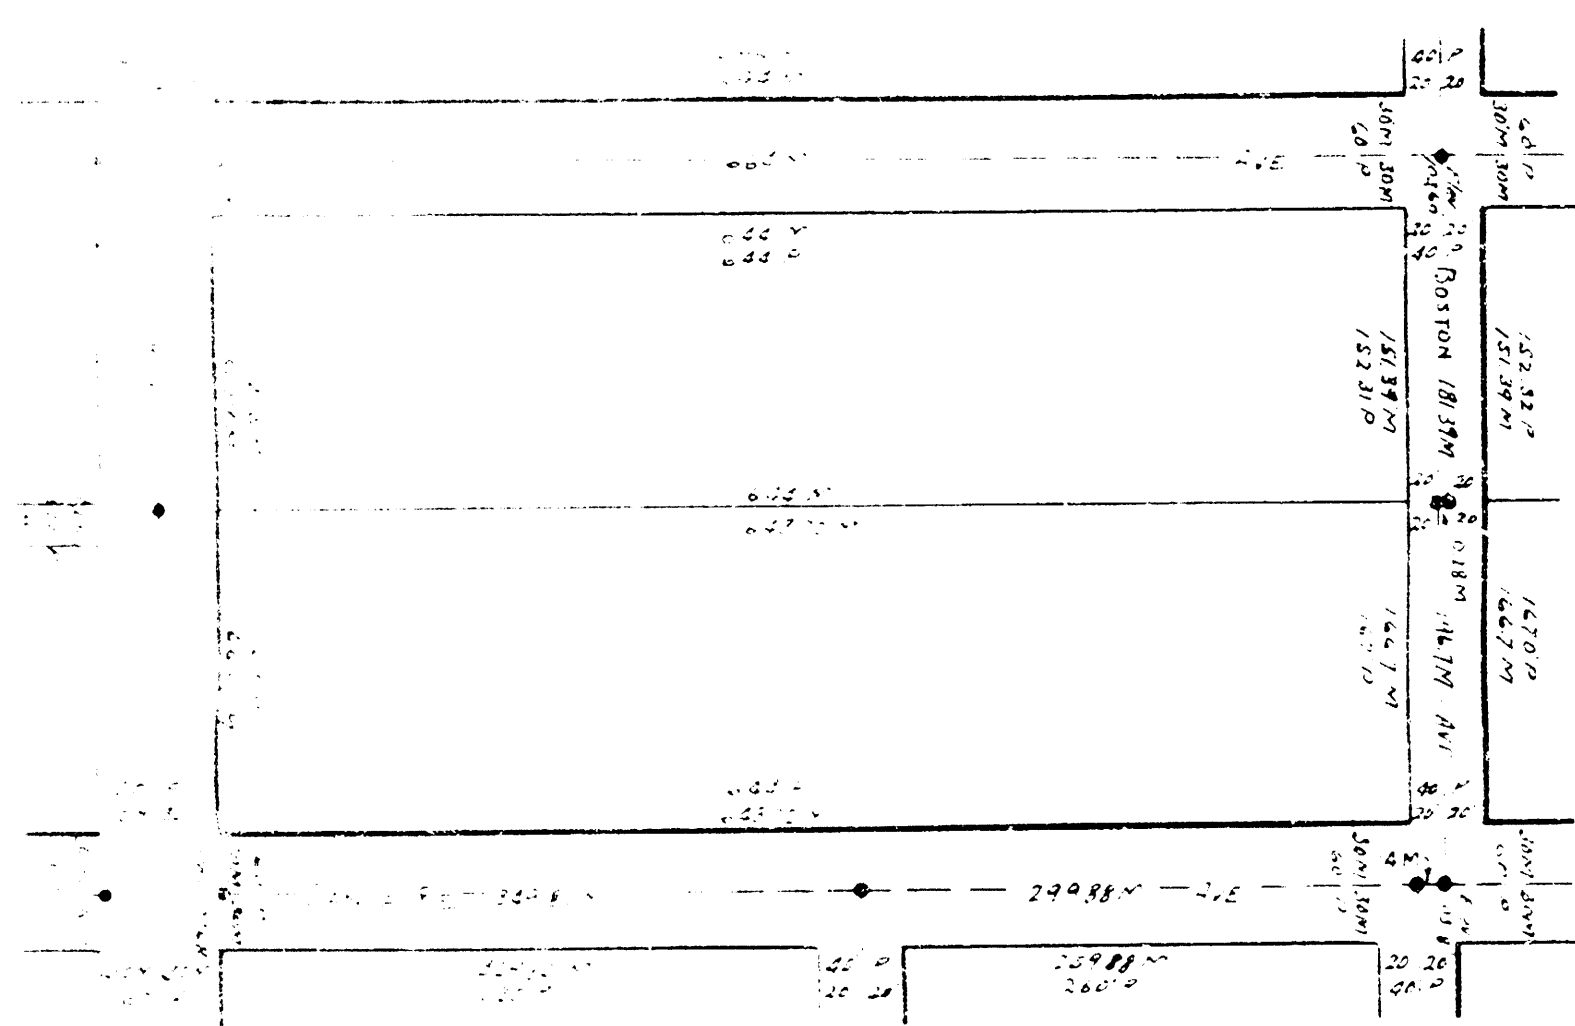



65

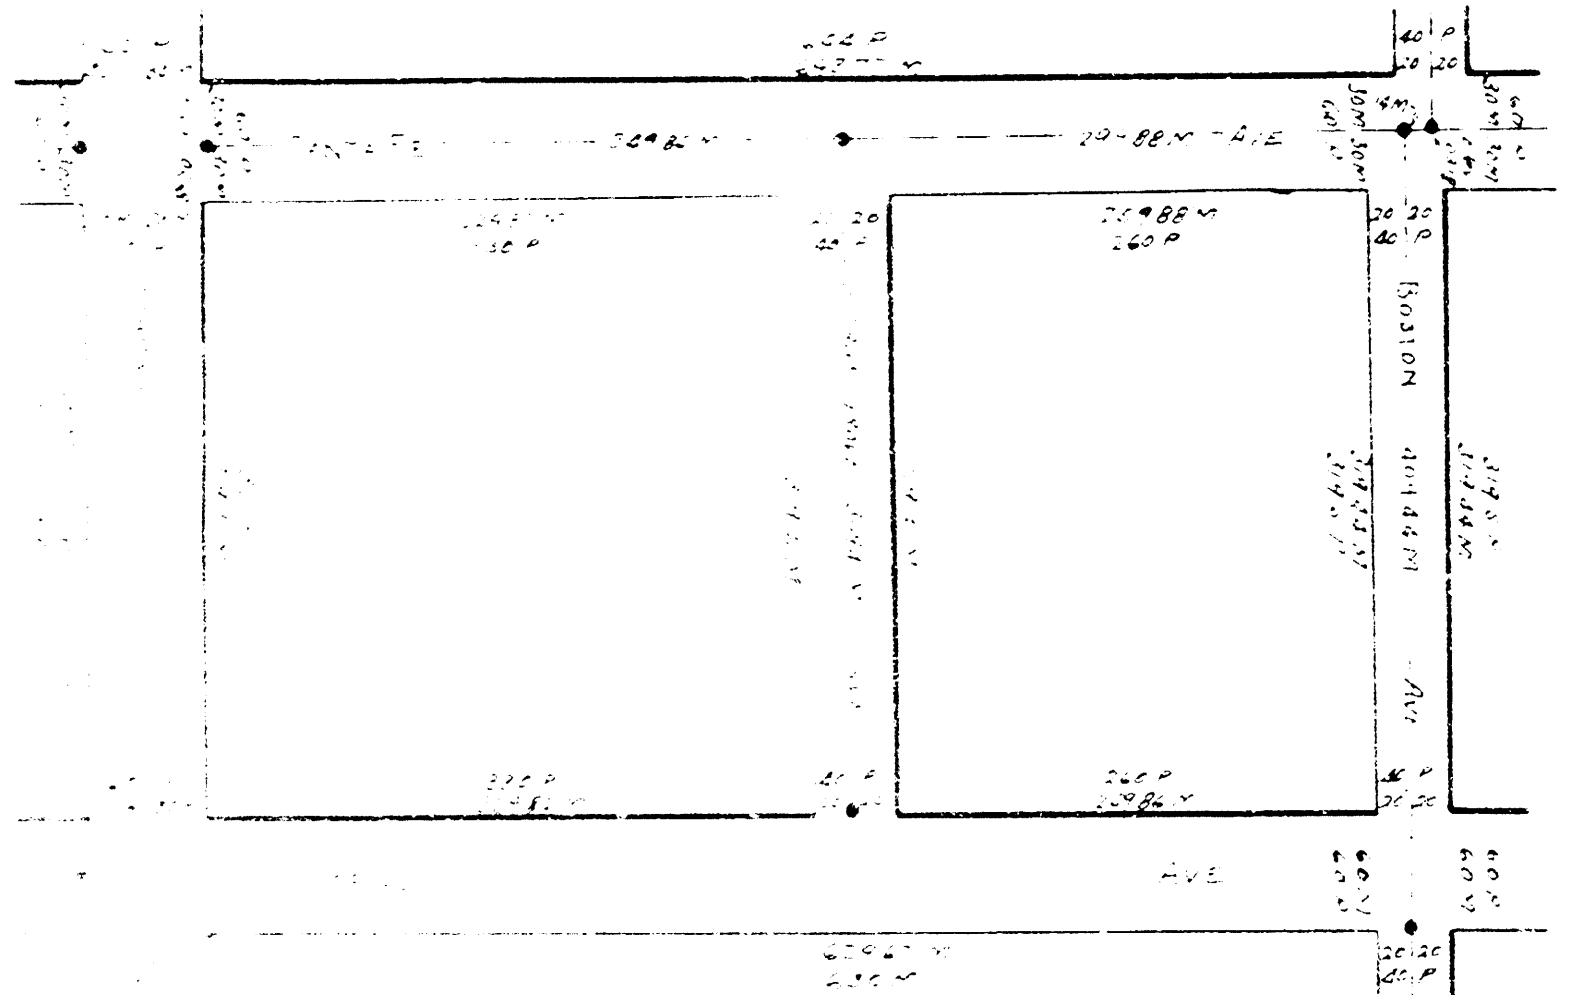


66

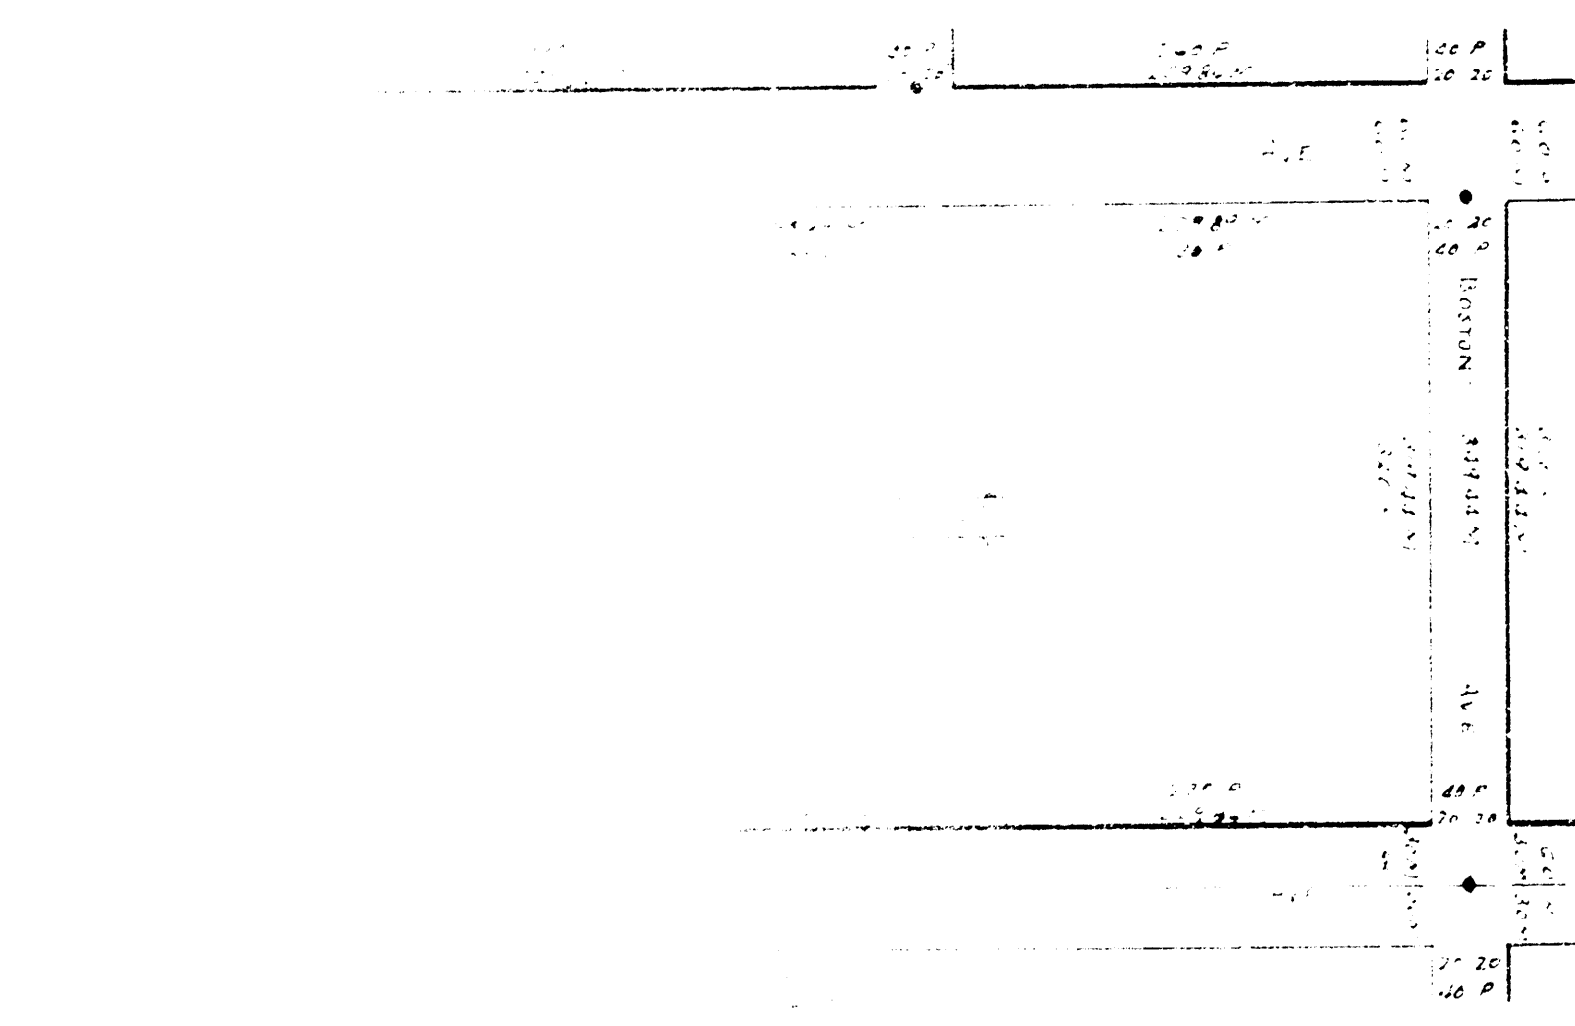


67

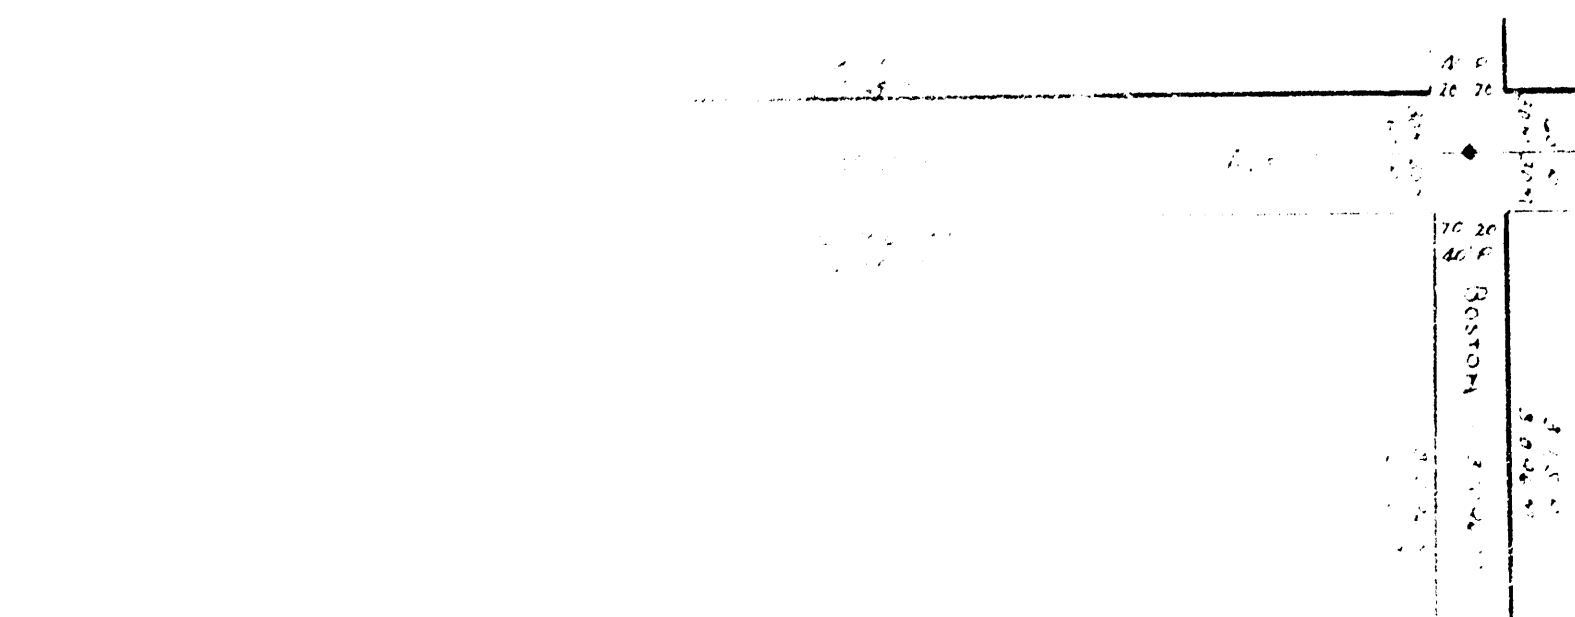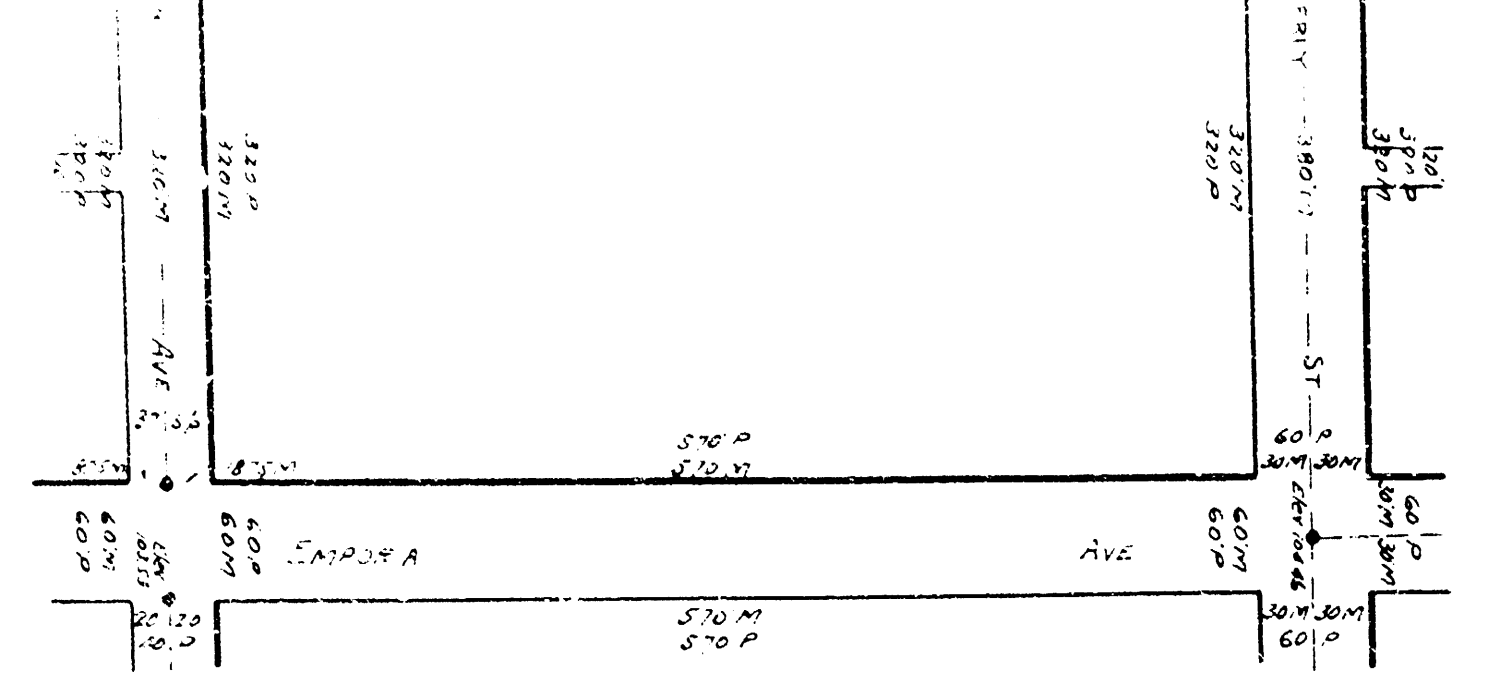


69

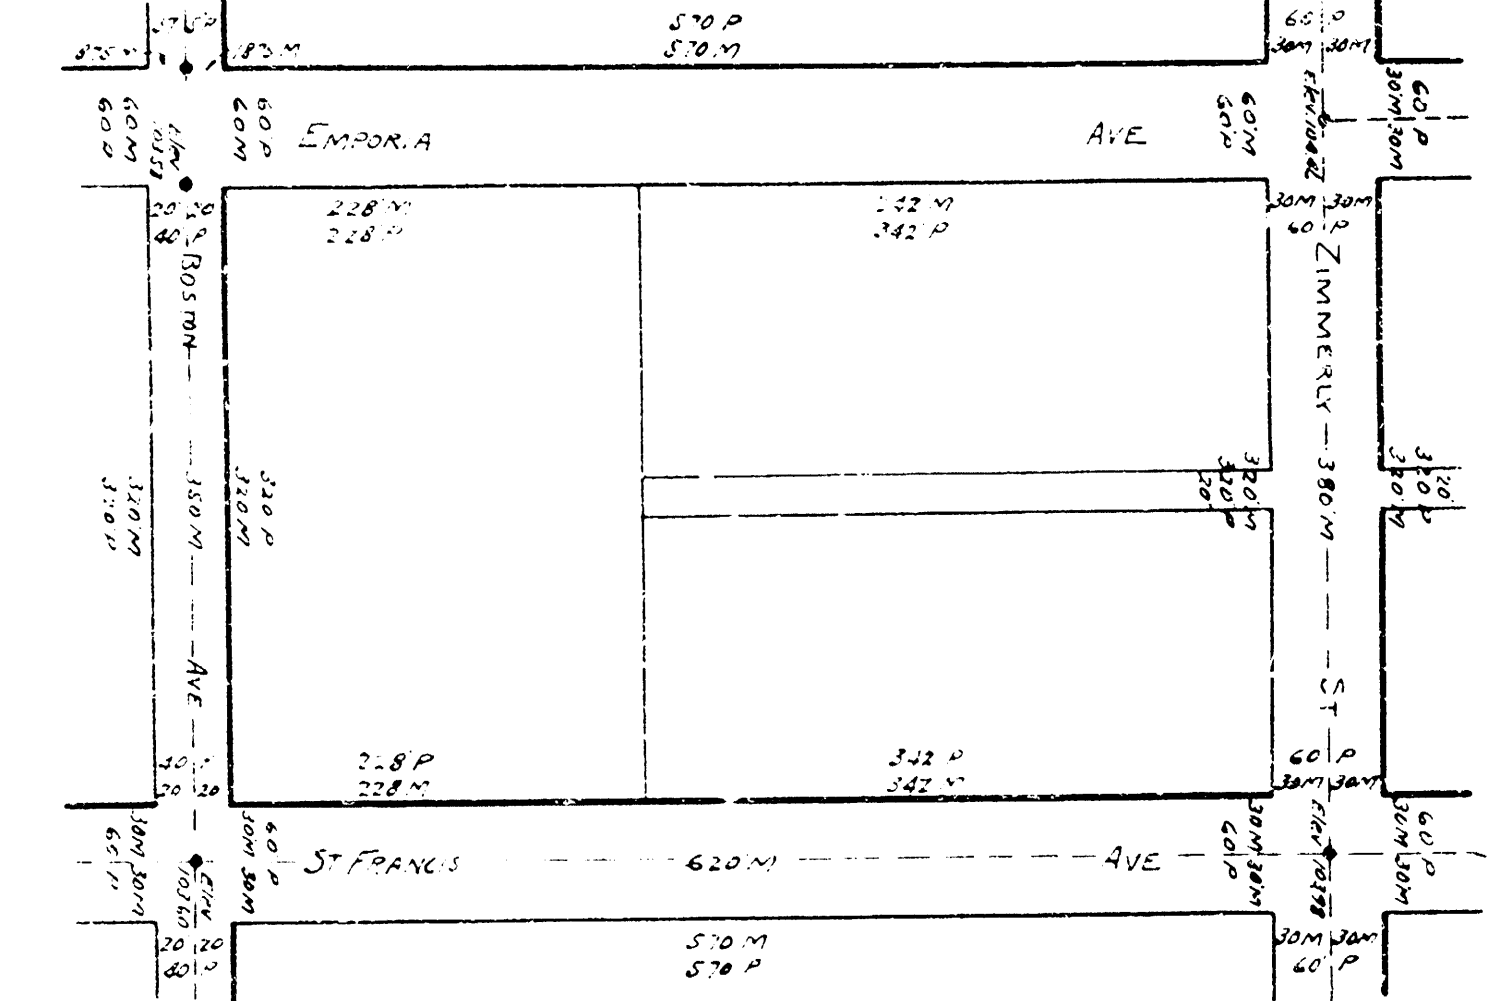


70

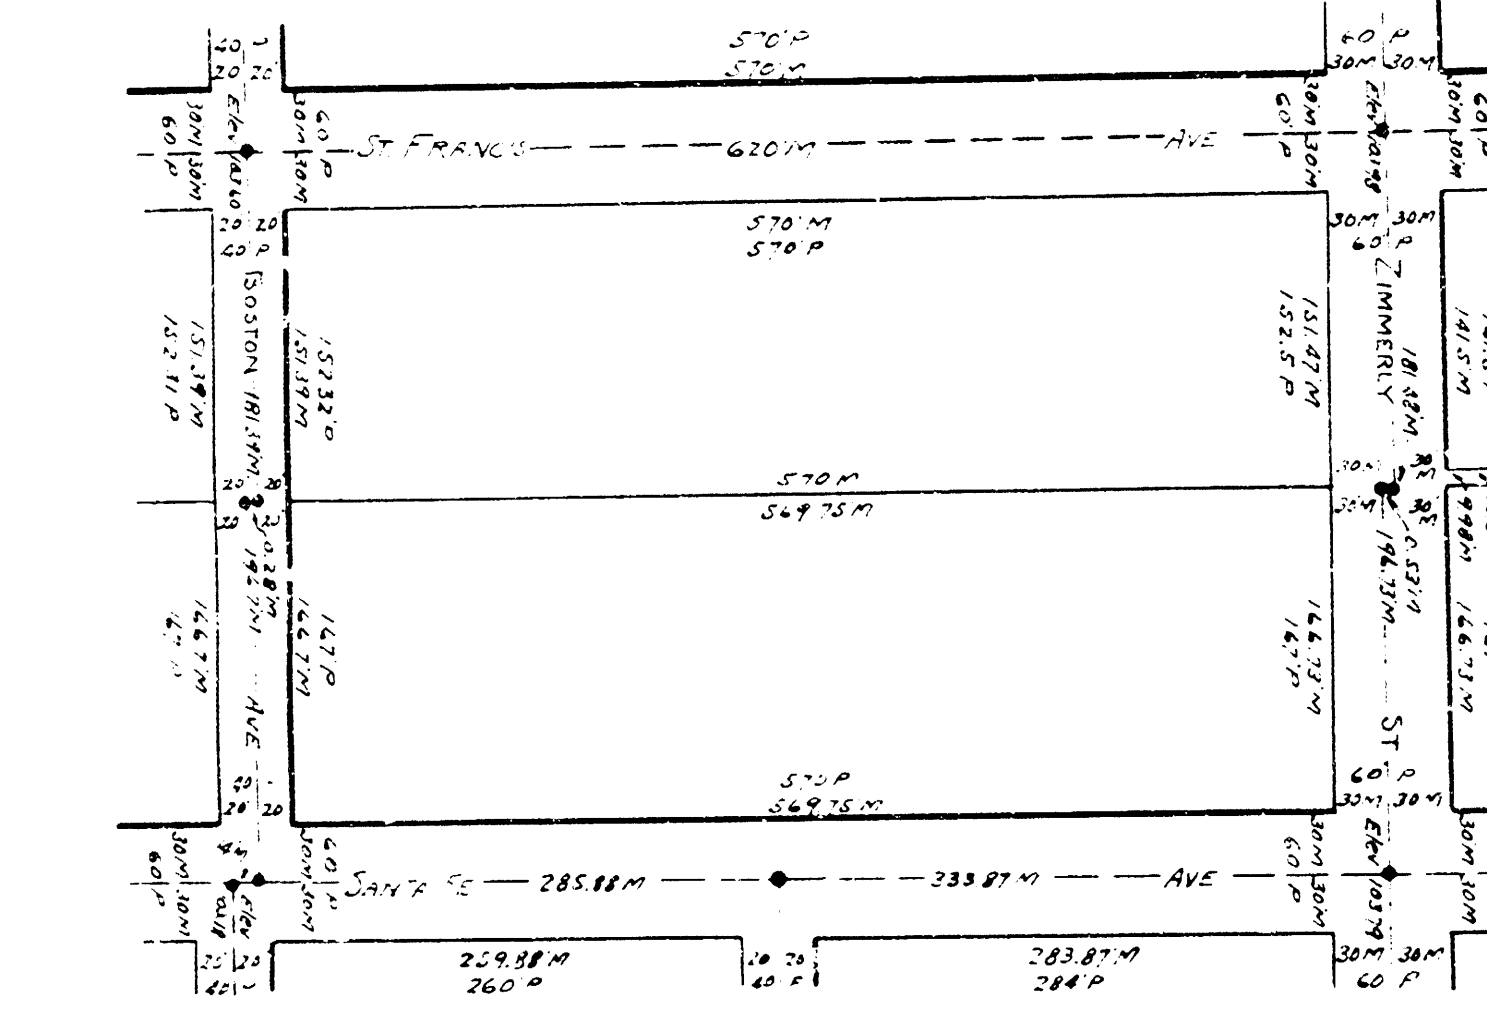



71

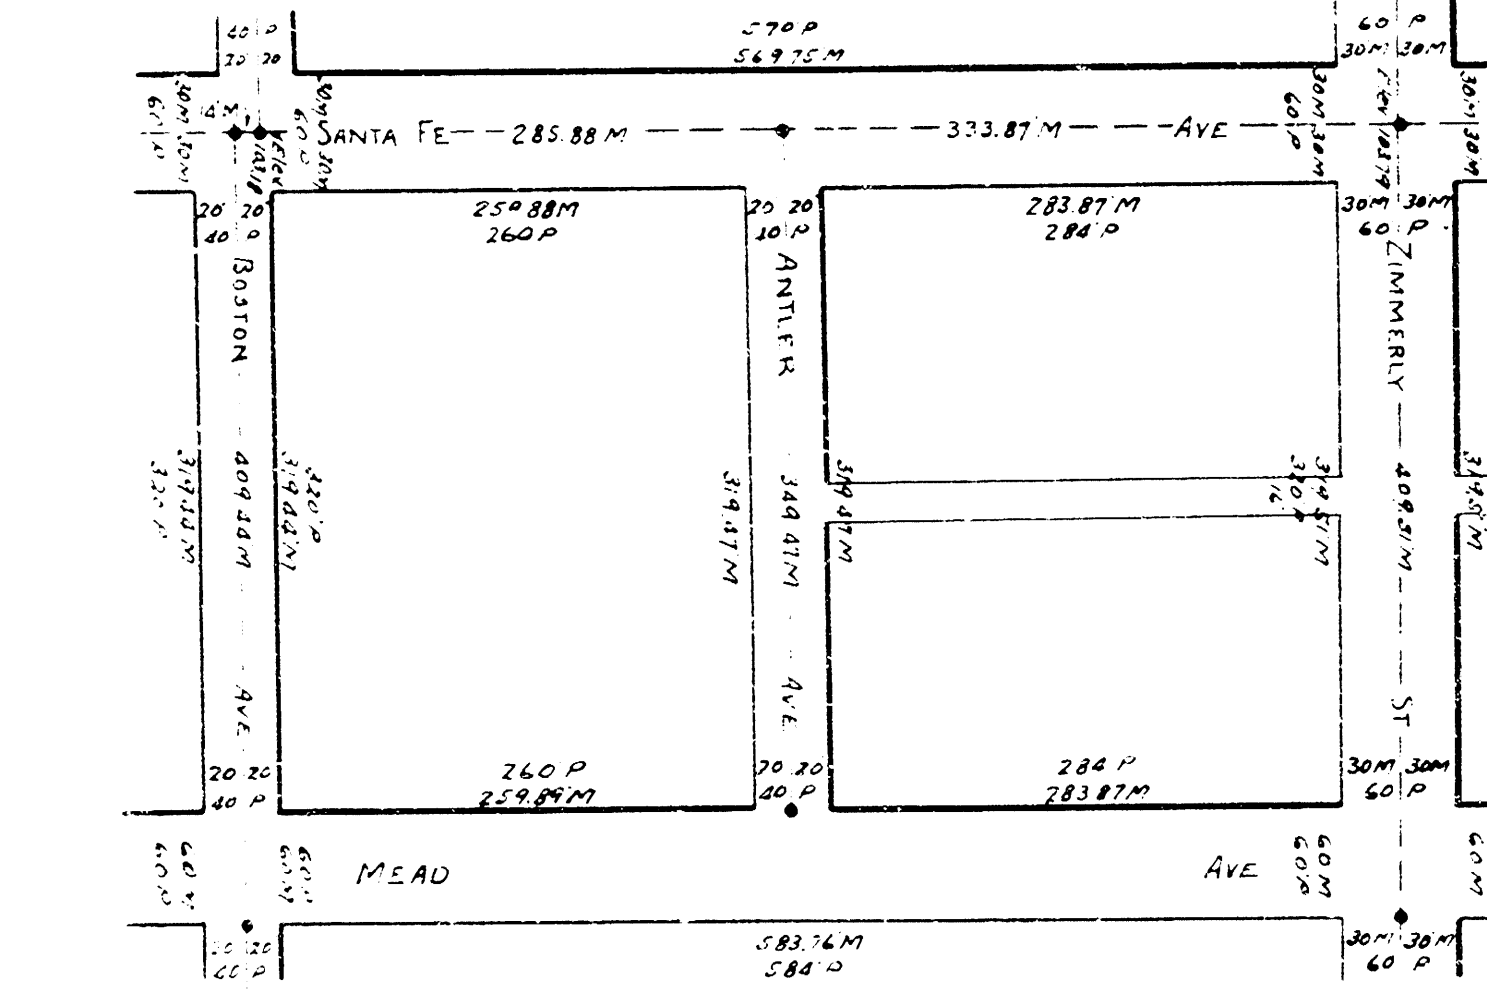


72

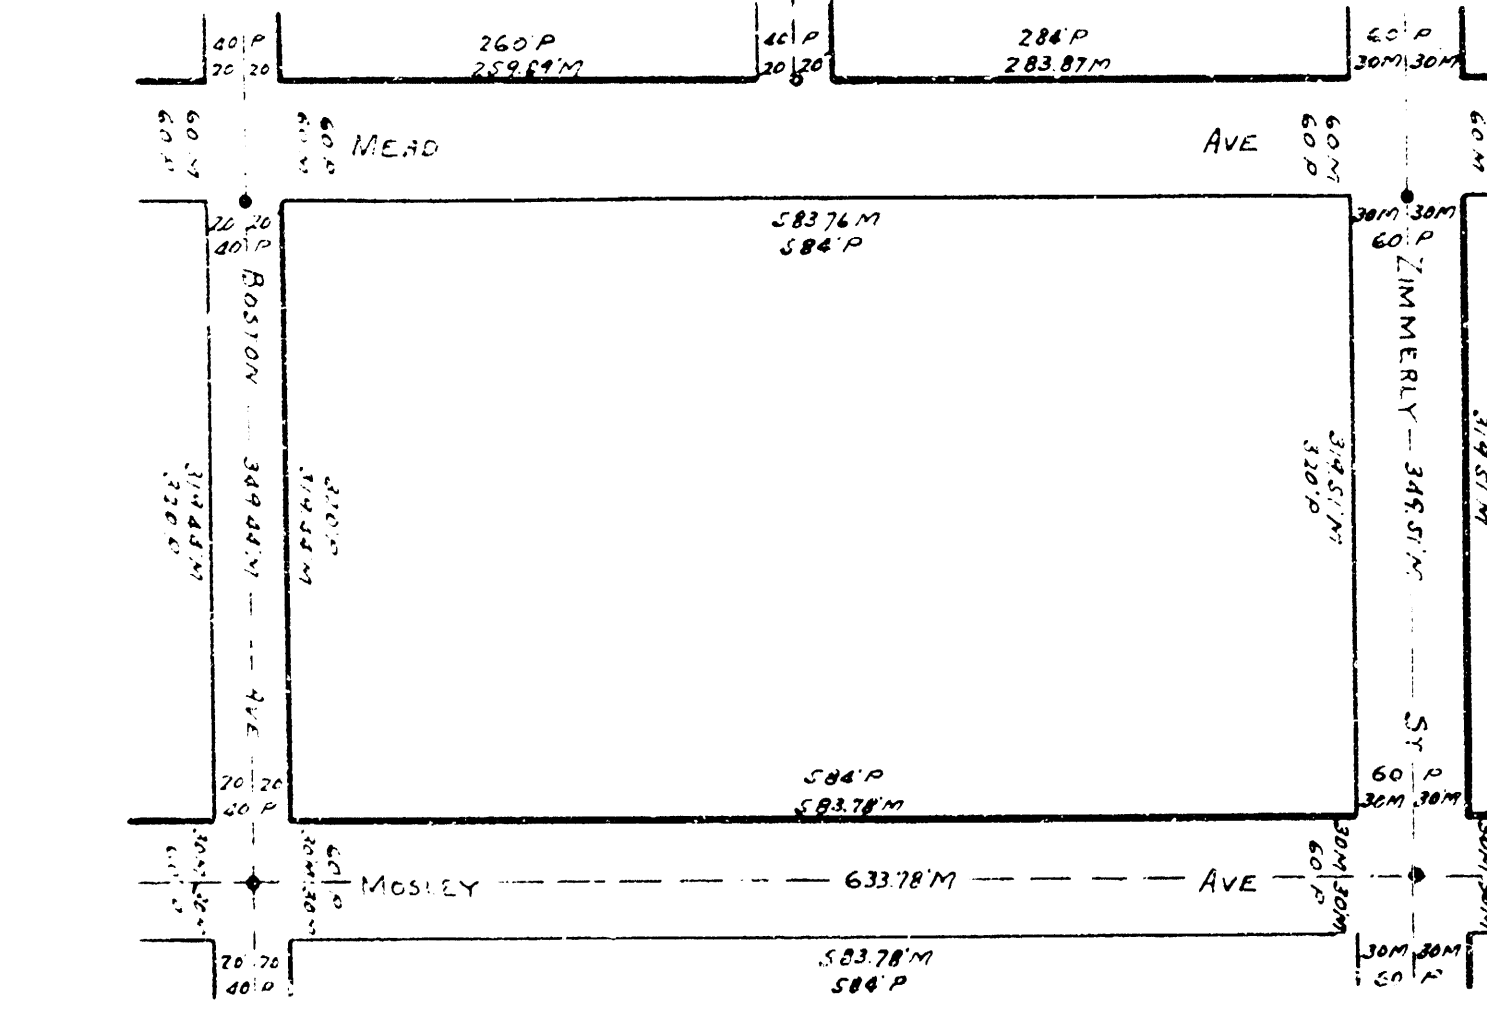


73

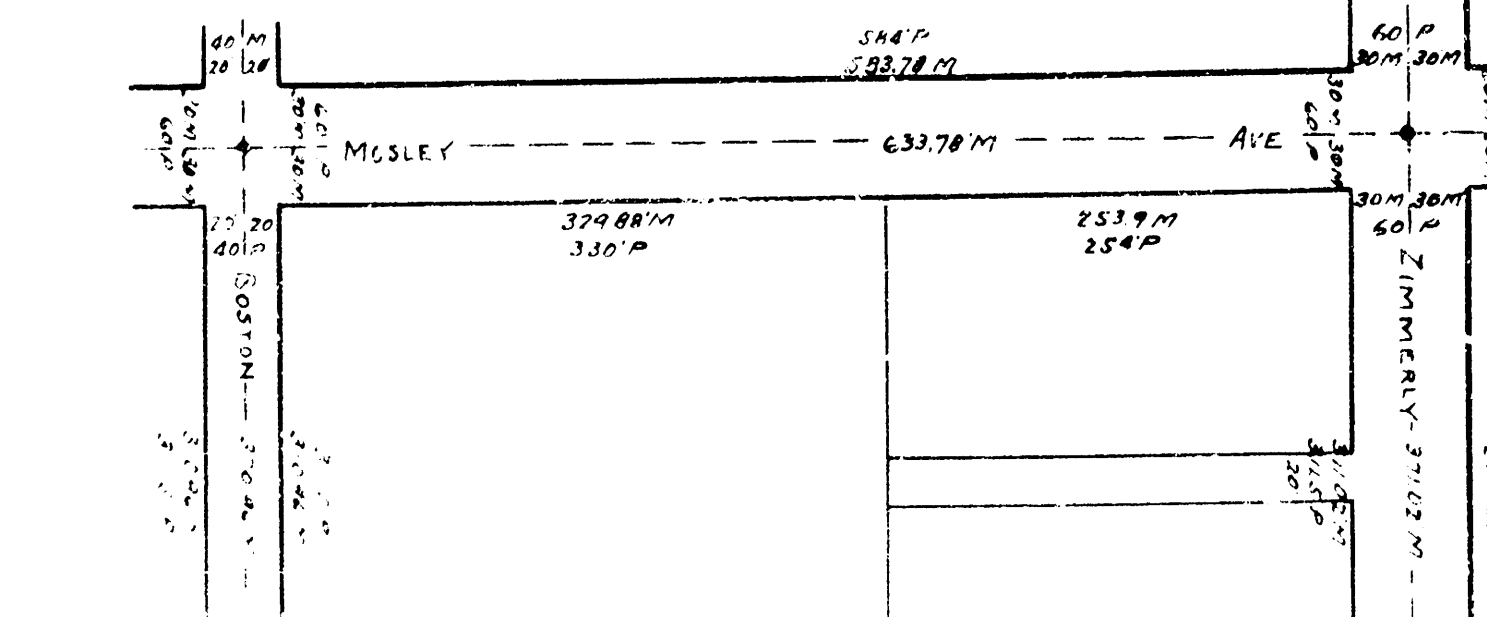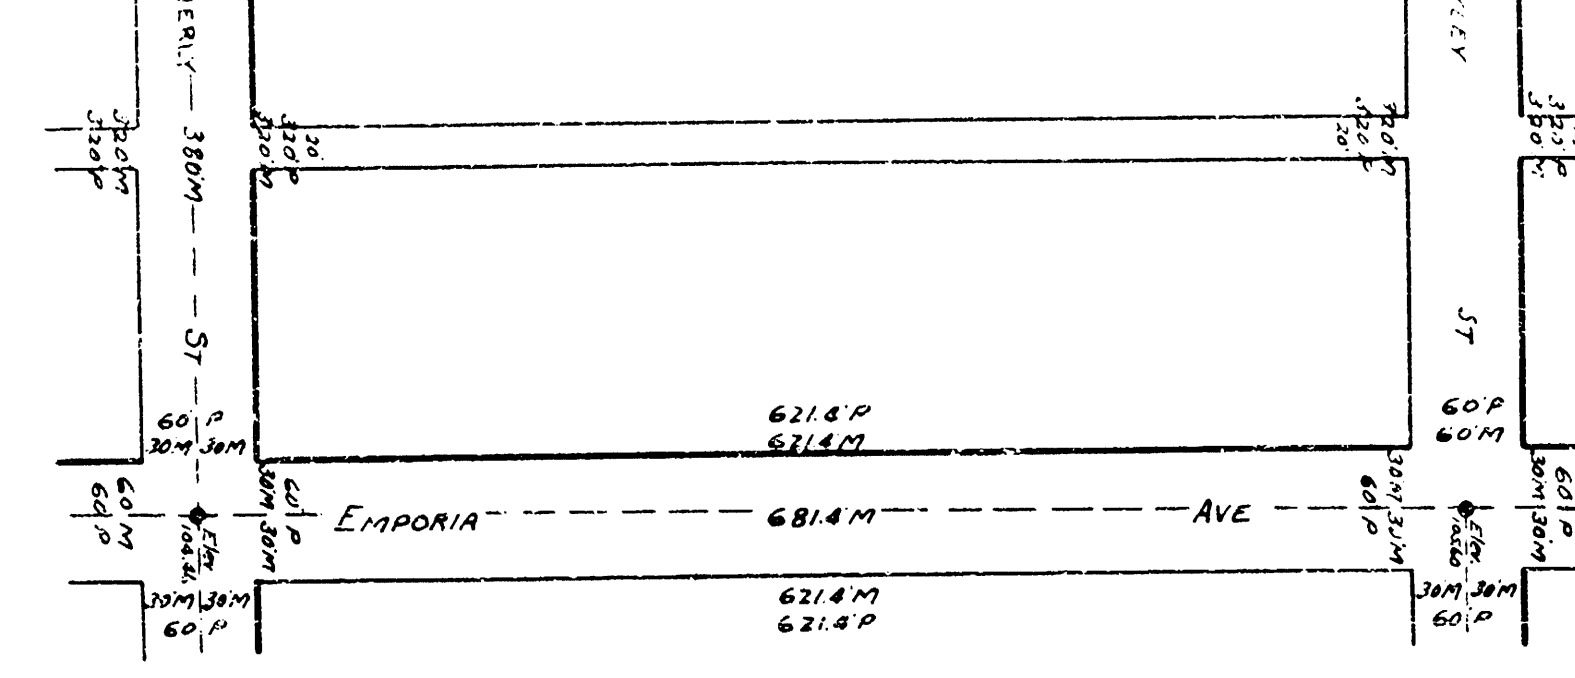


75

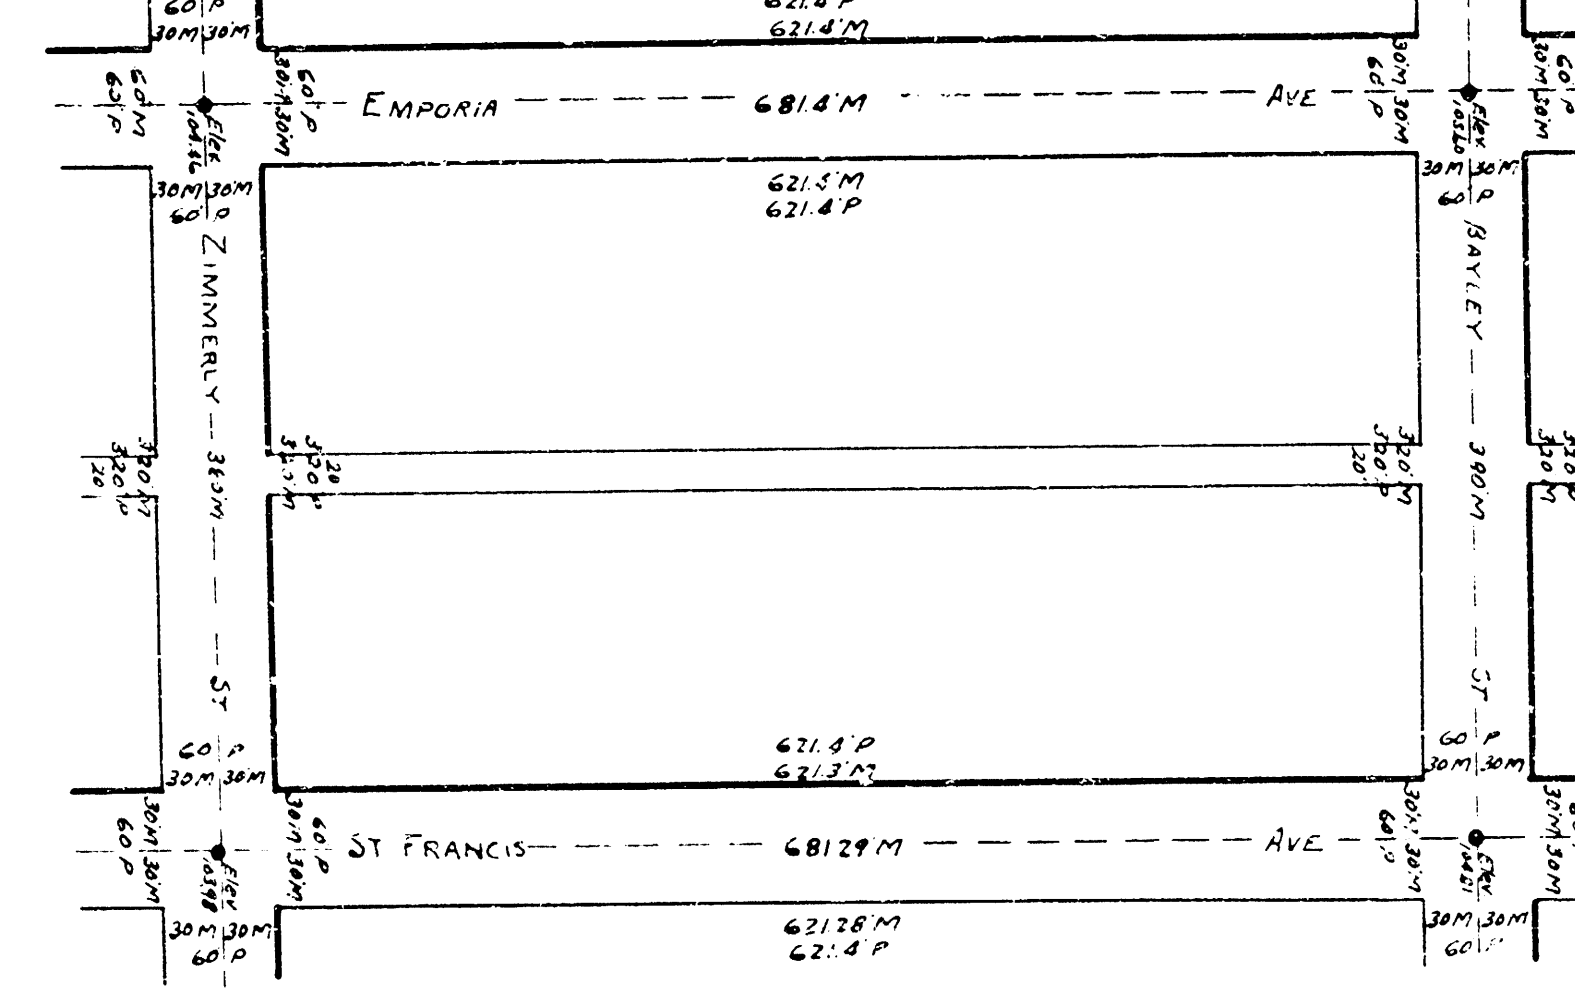


76

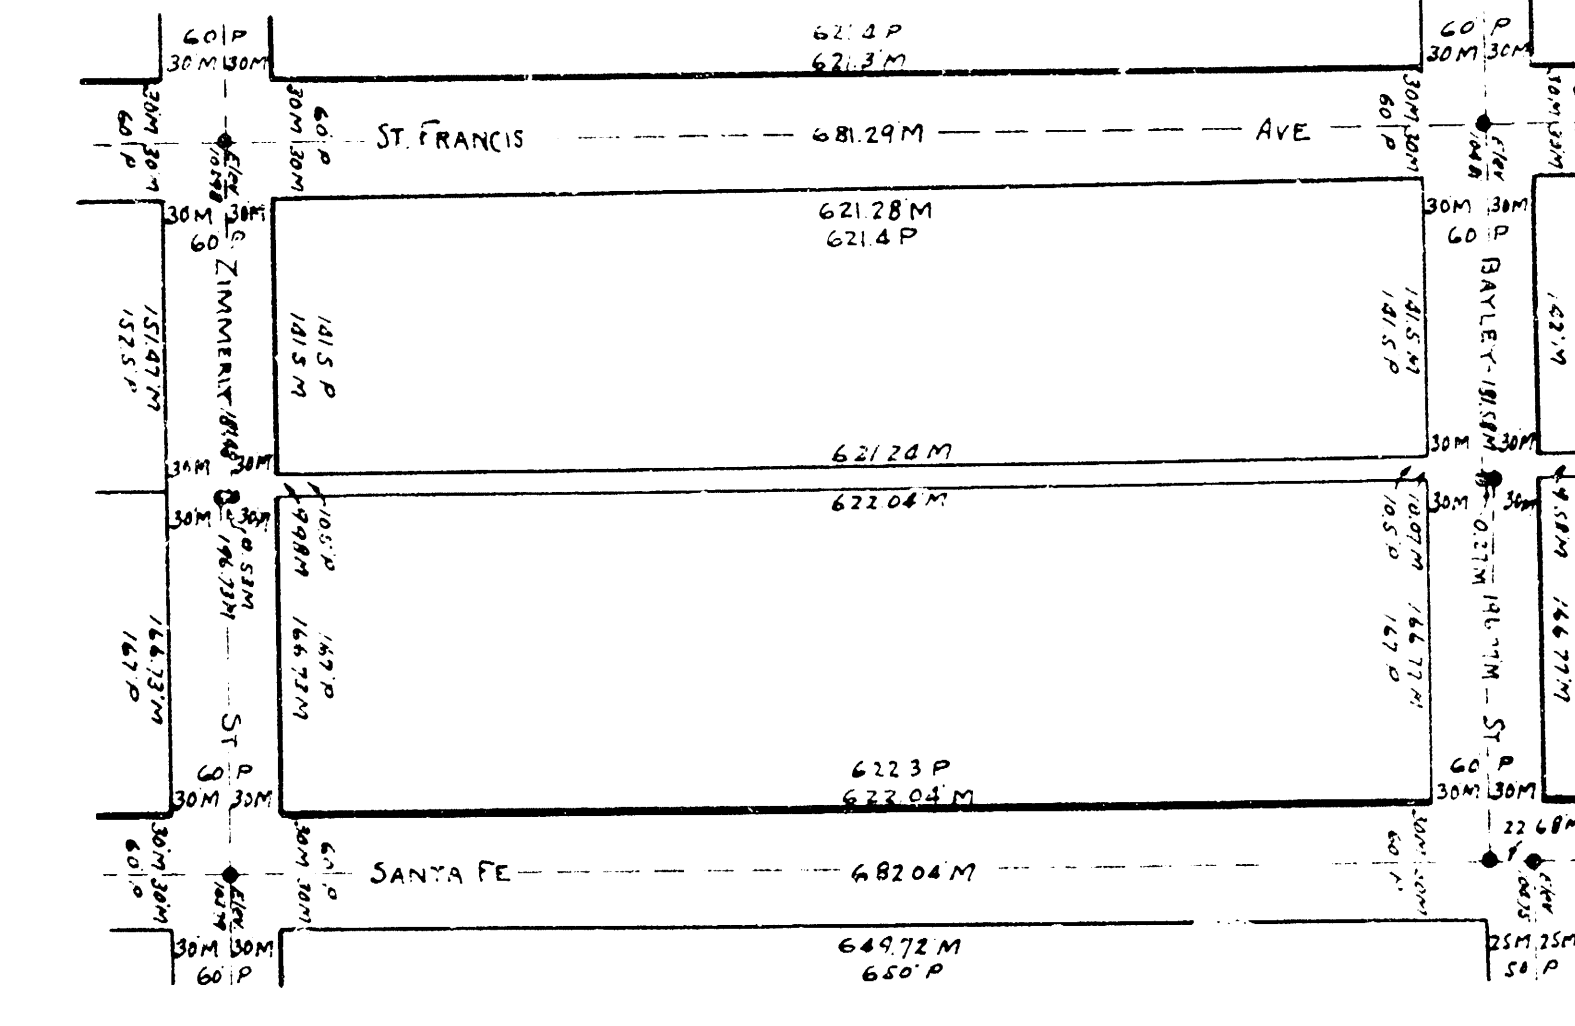



77

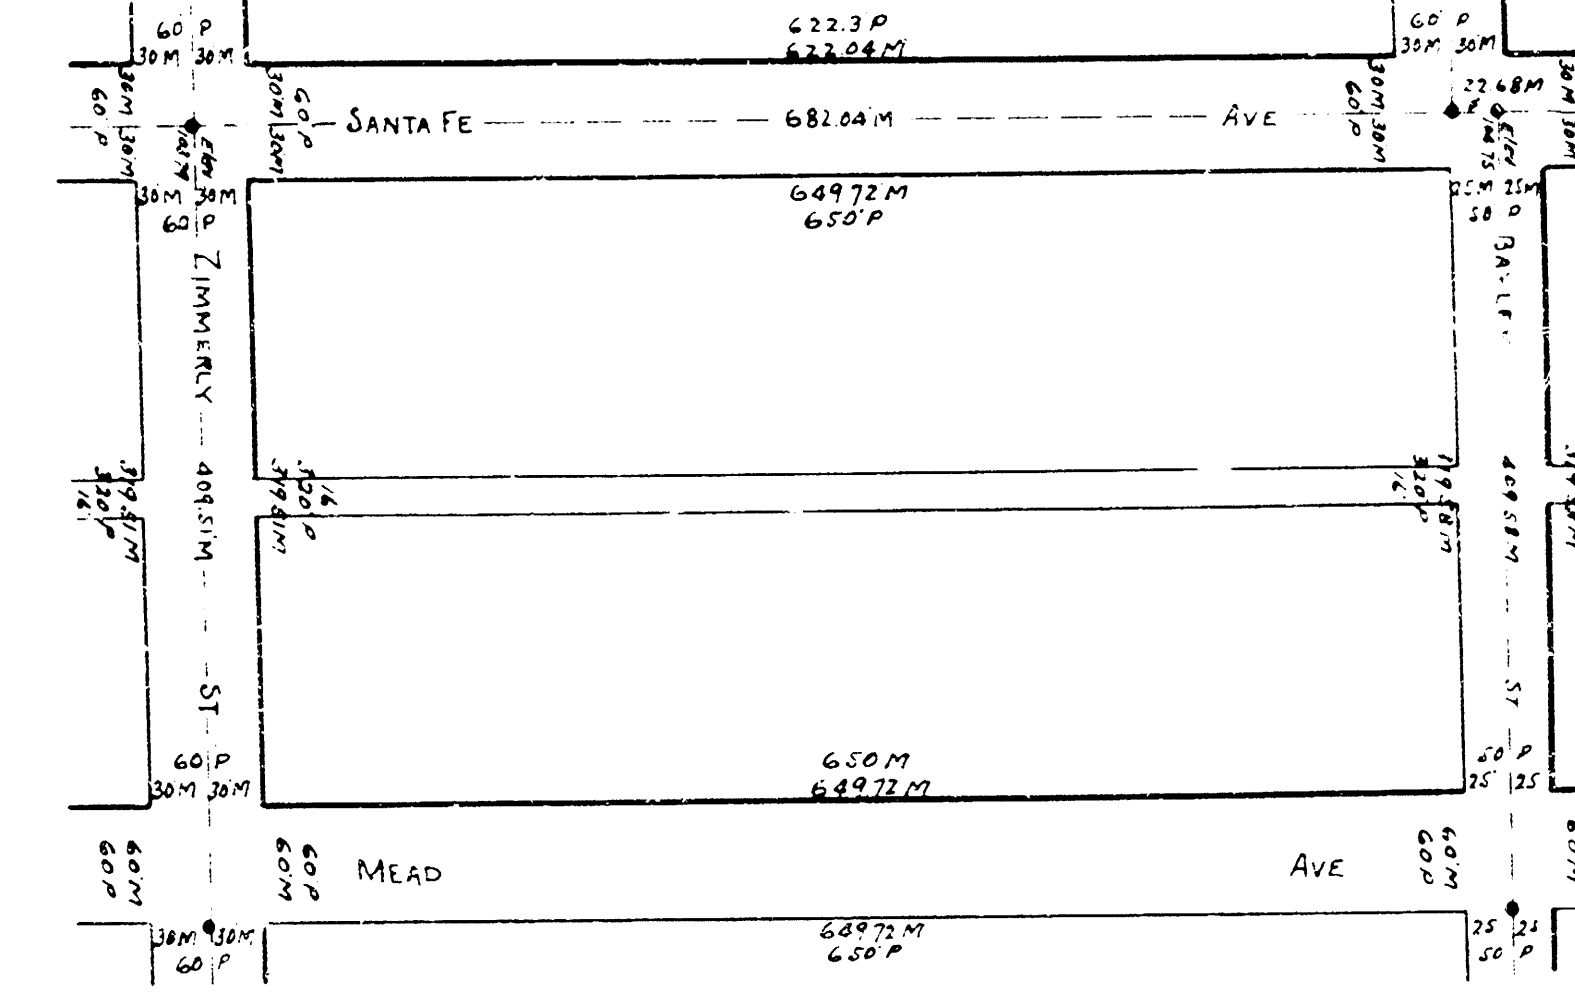


78

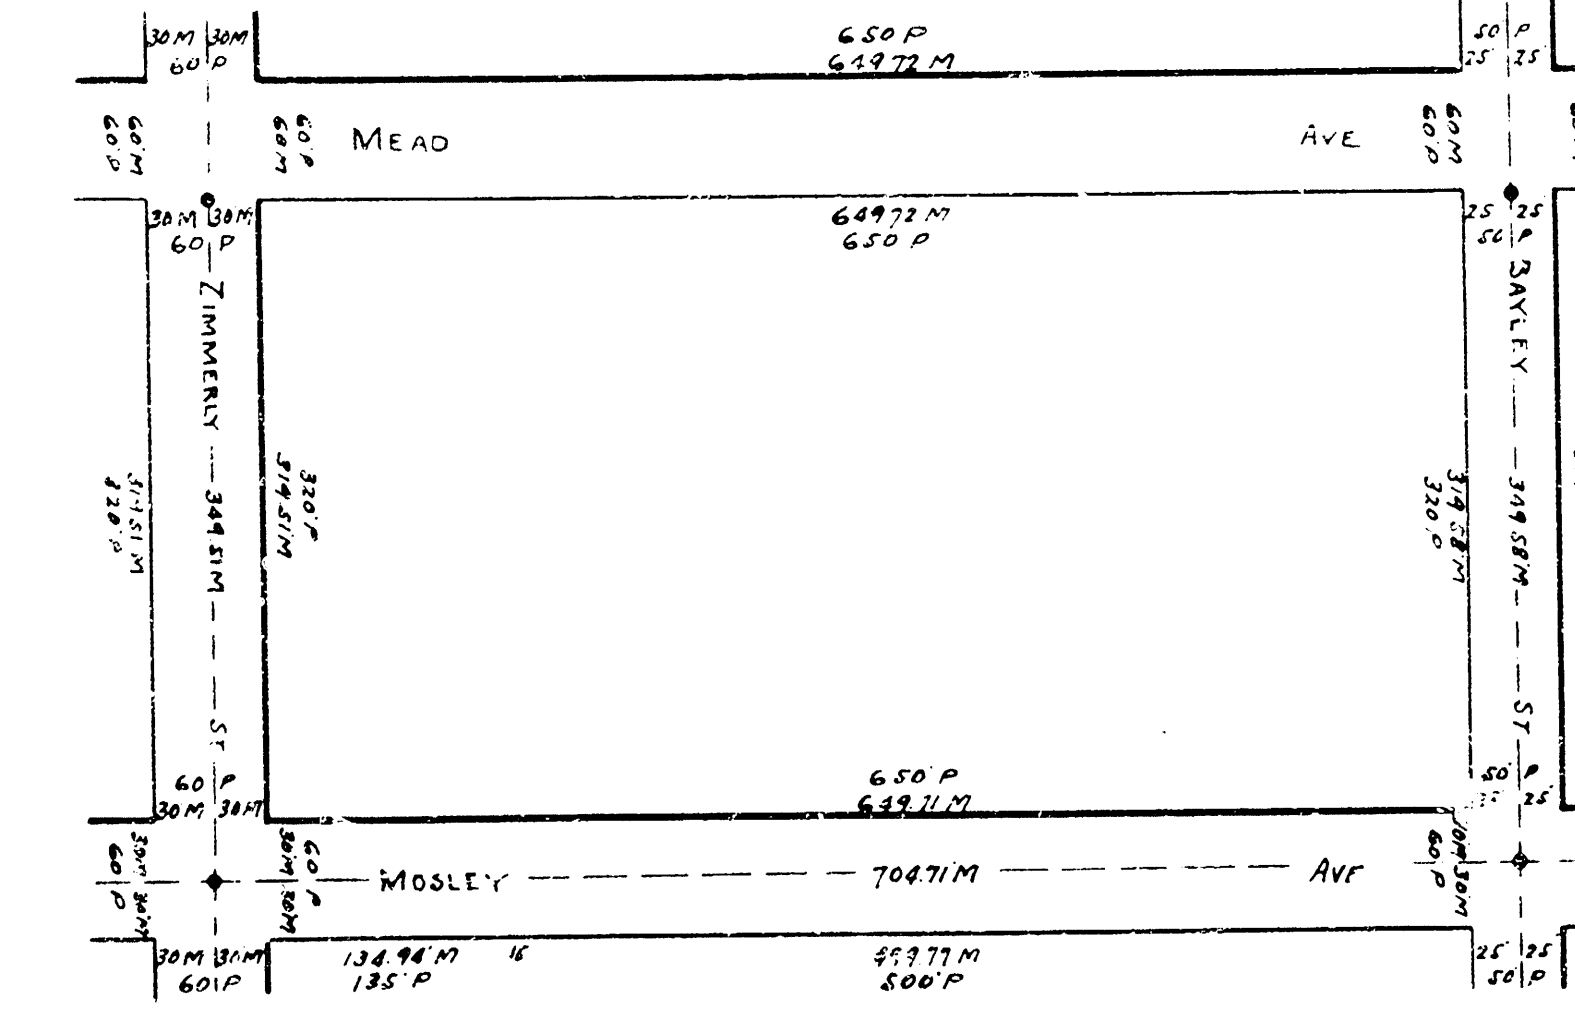


79

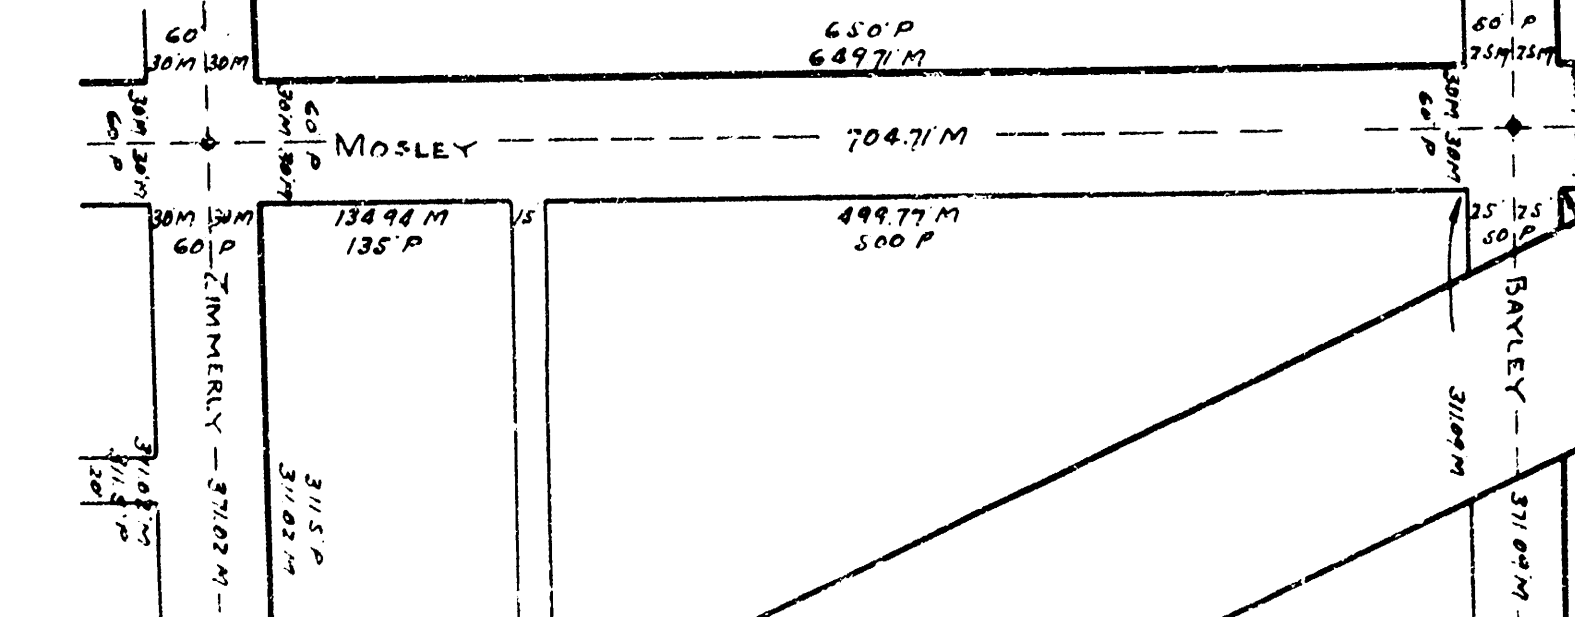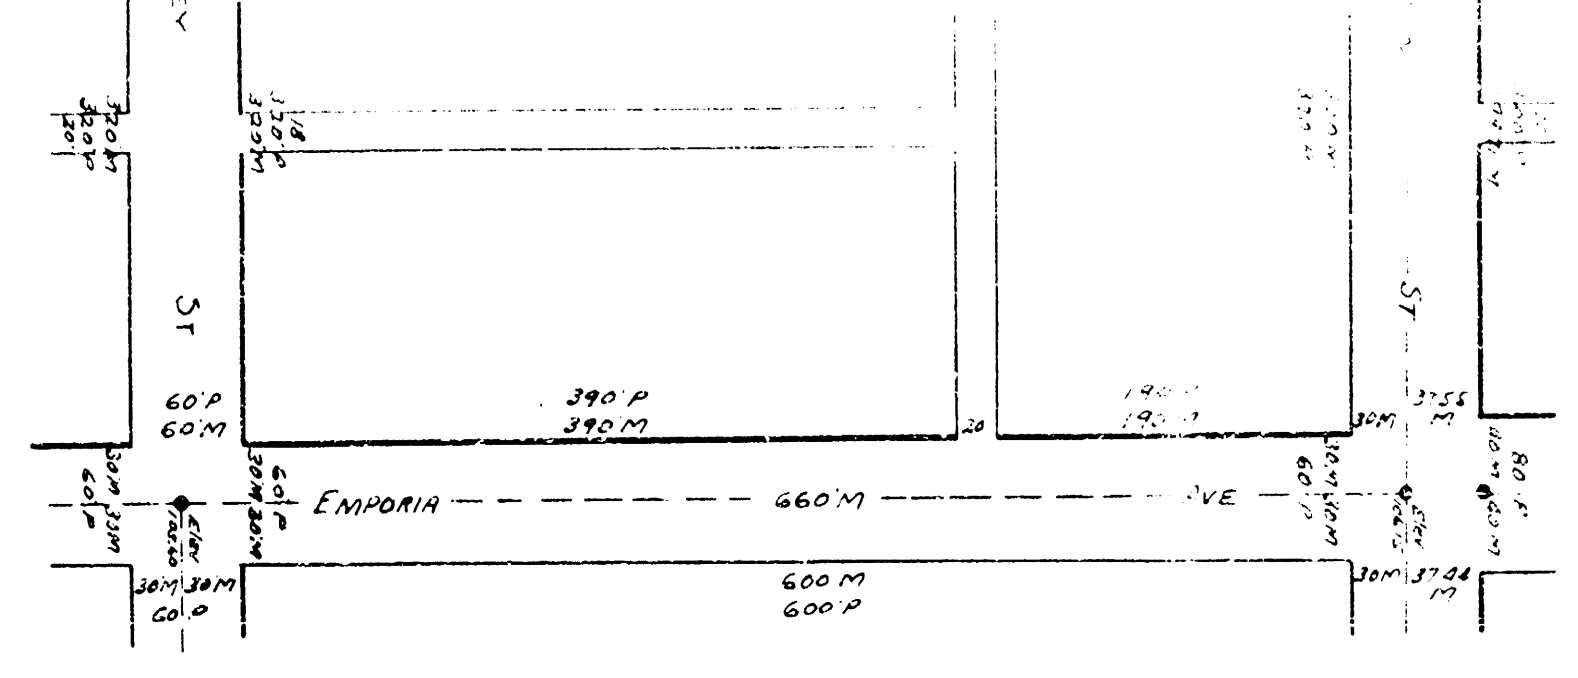


81

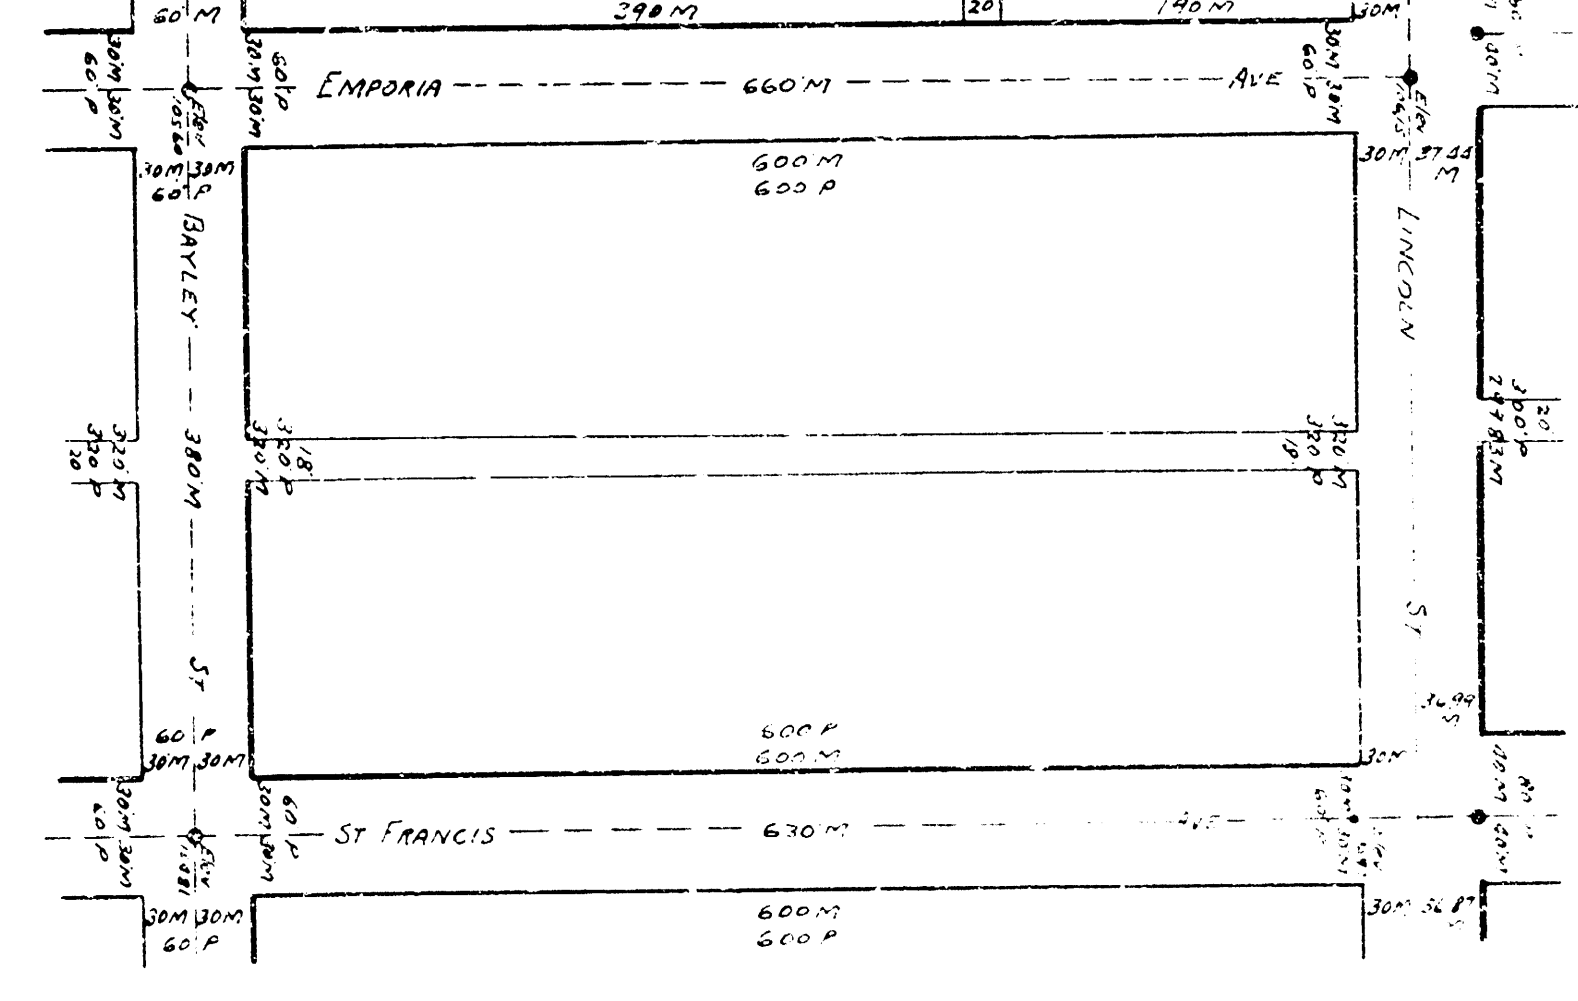


82

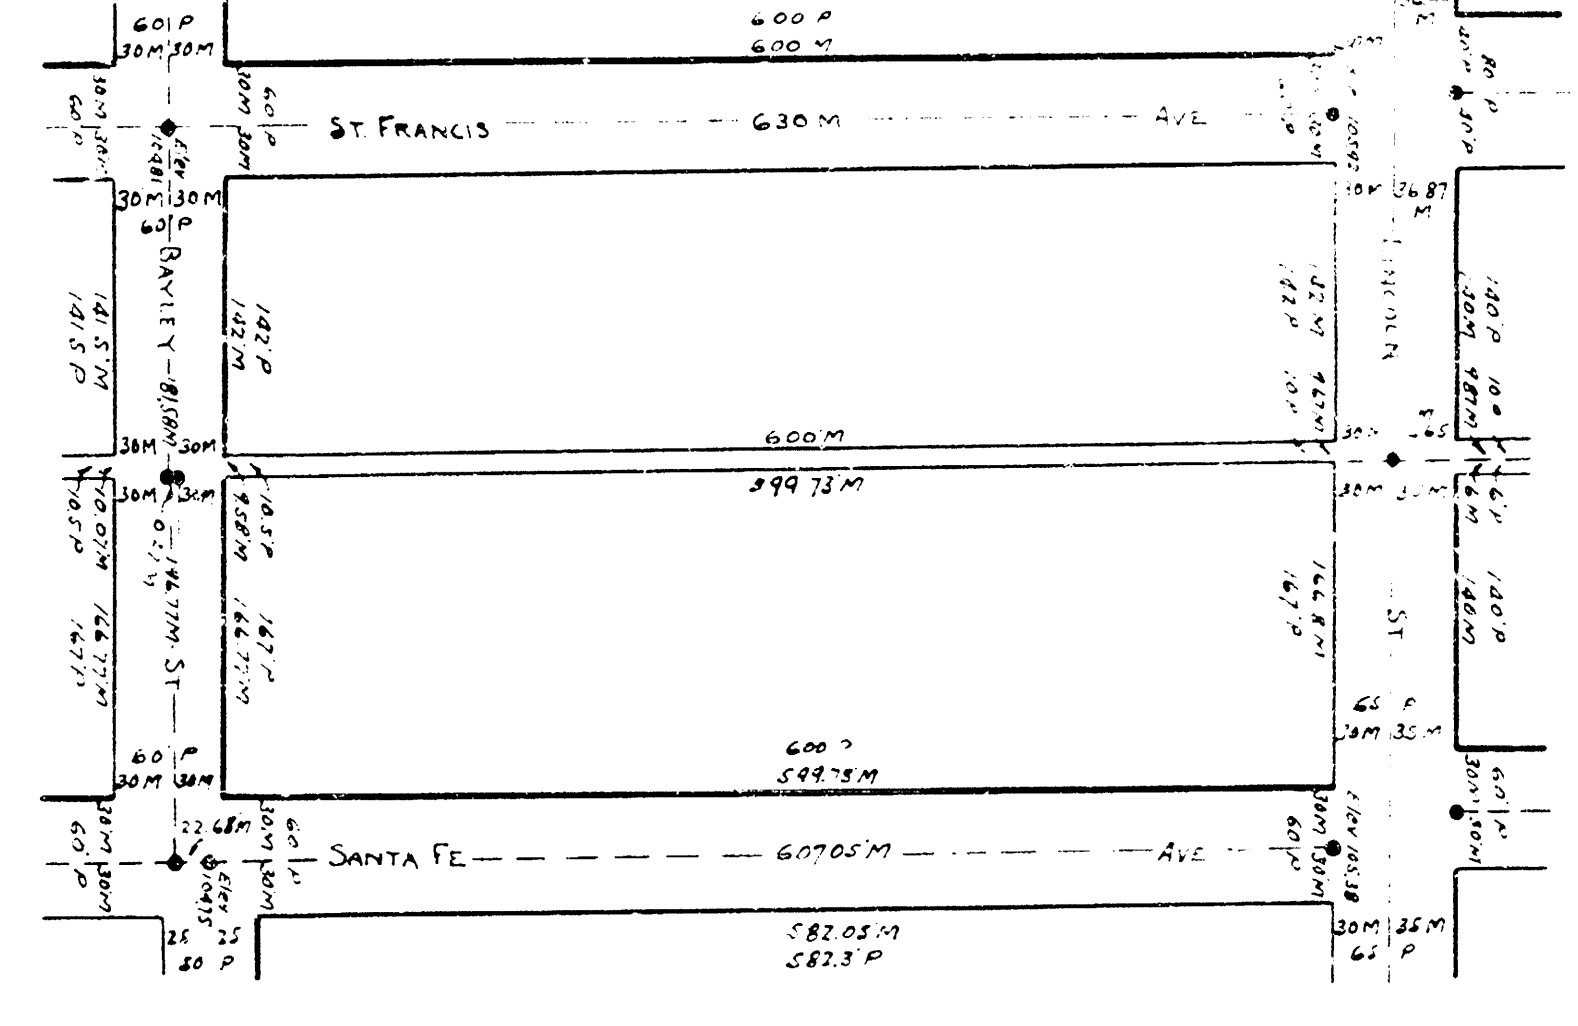



83

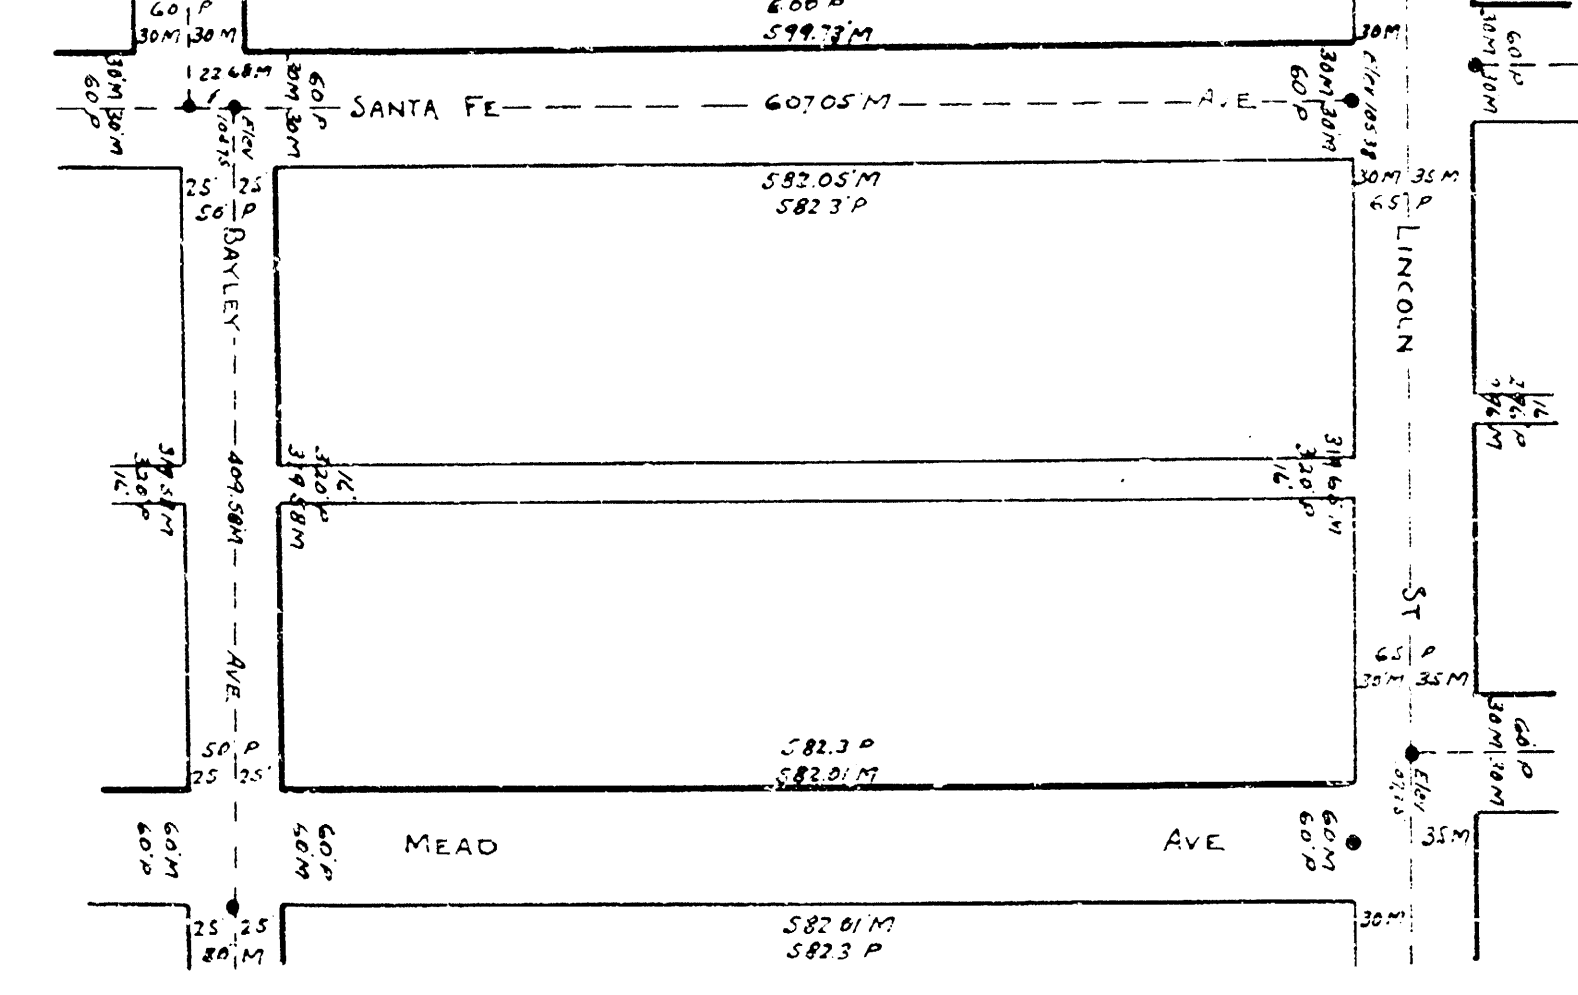


84

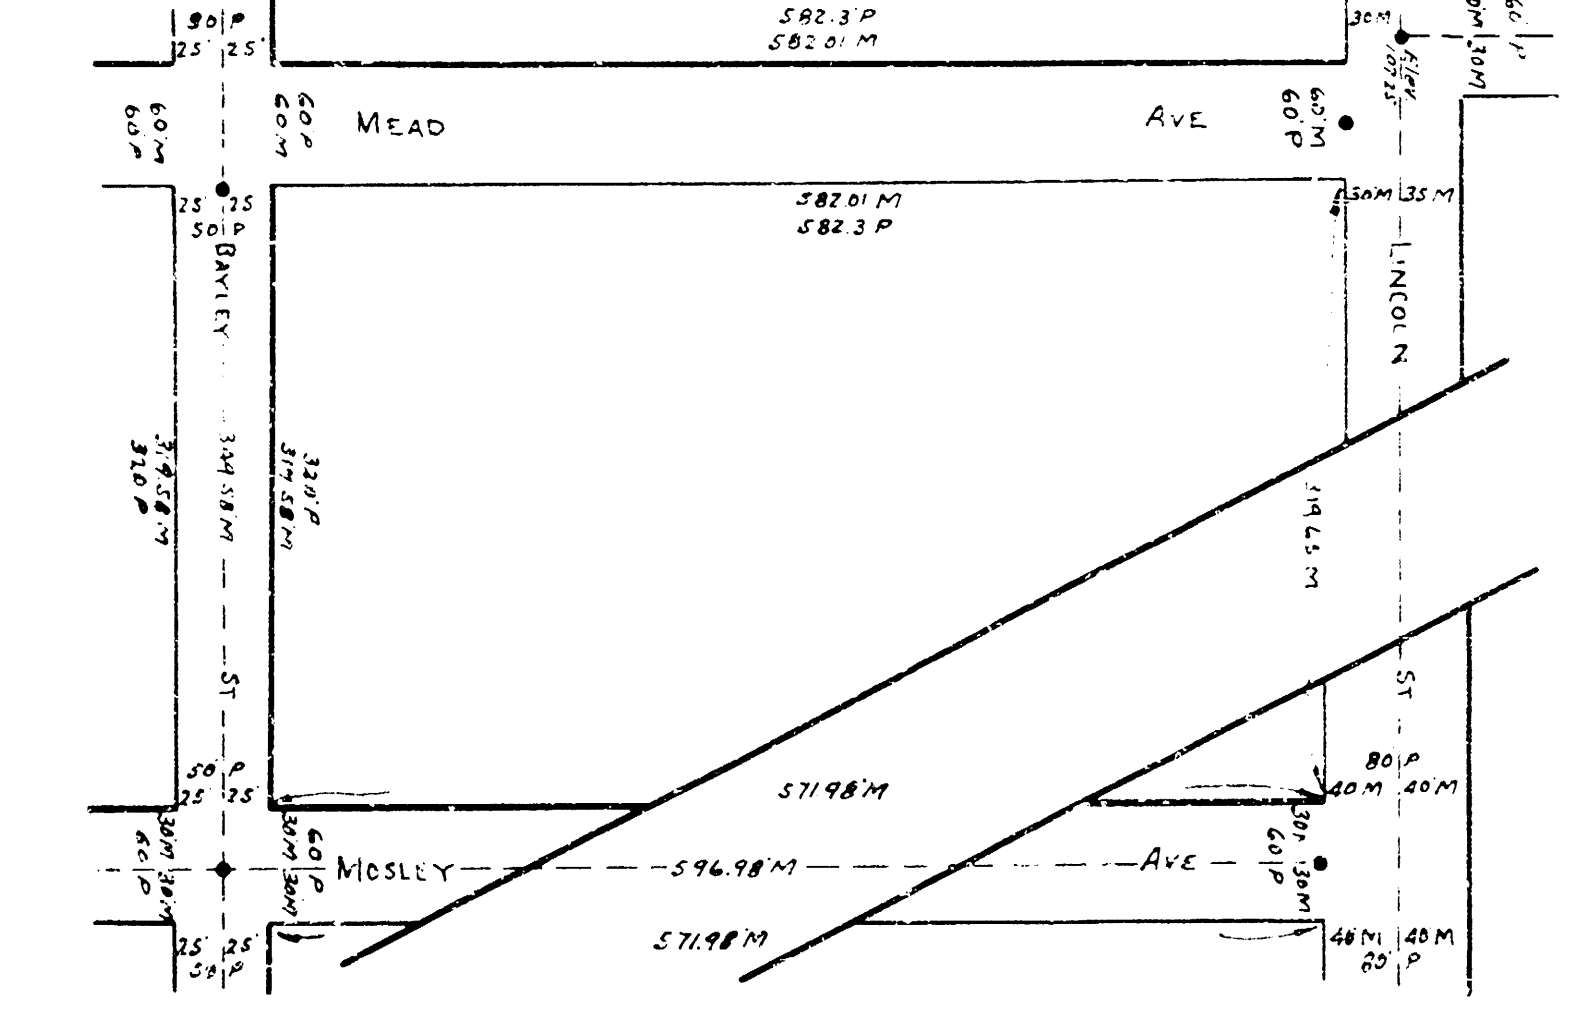


85

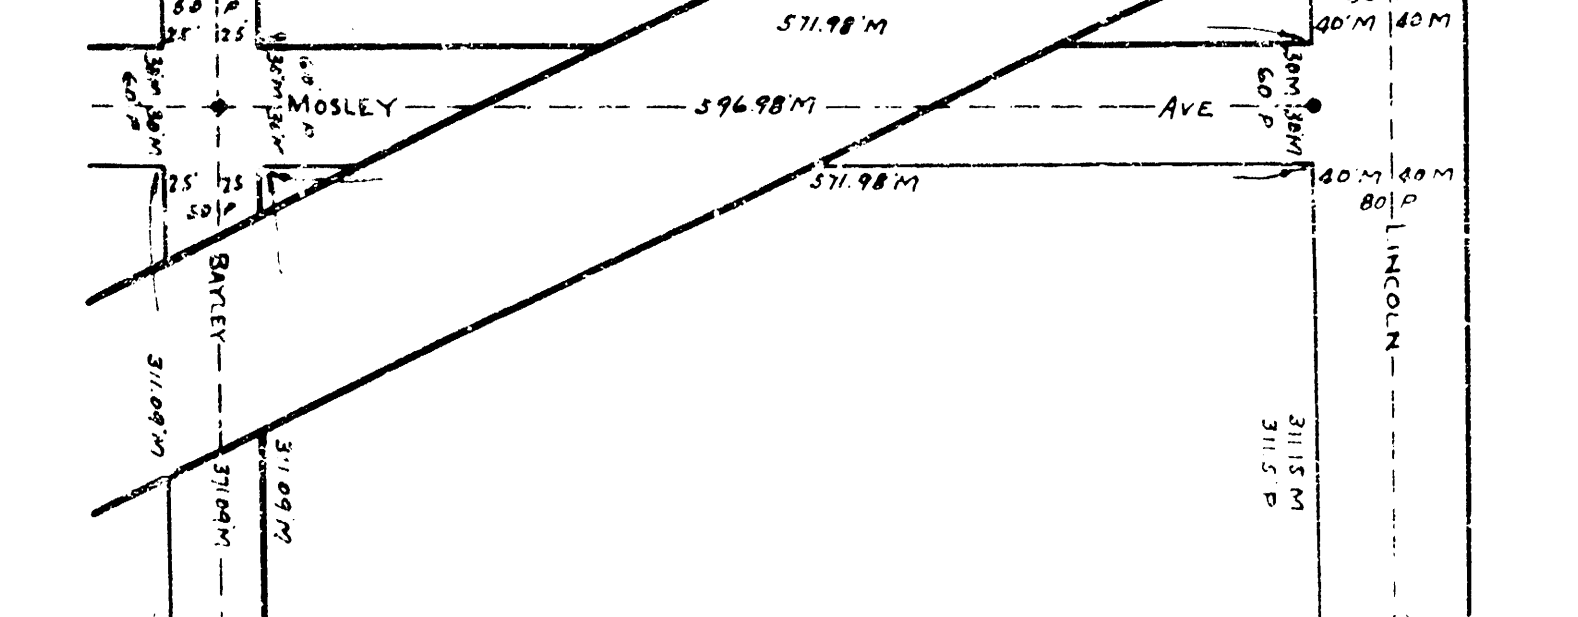 


87

 

88

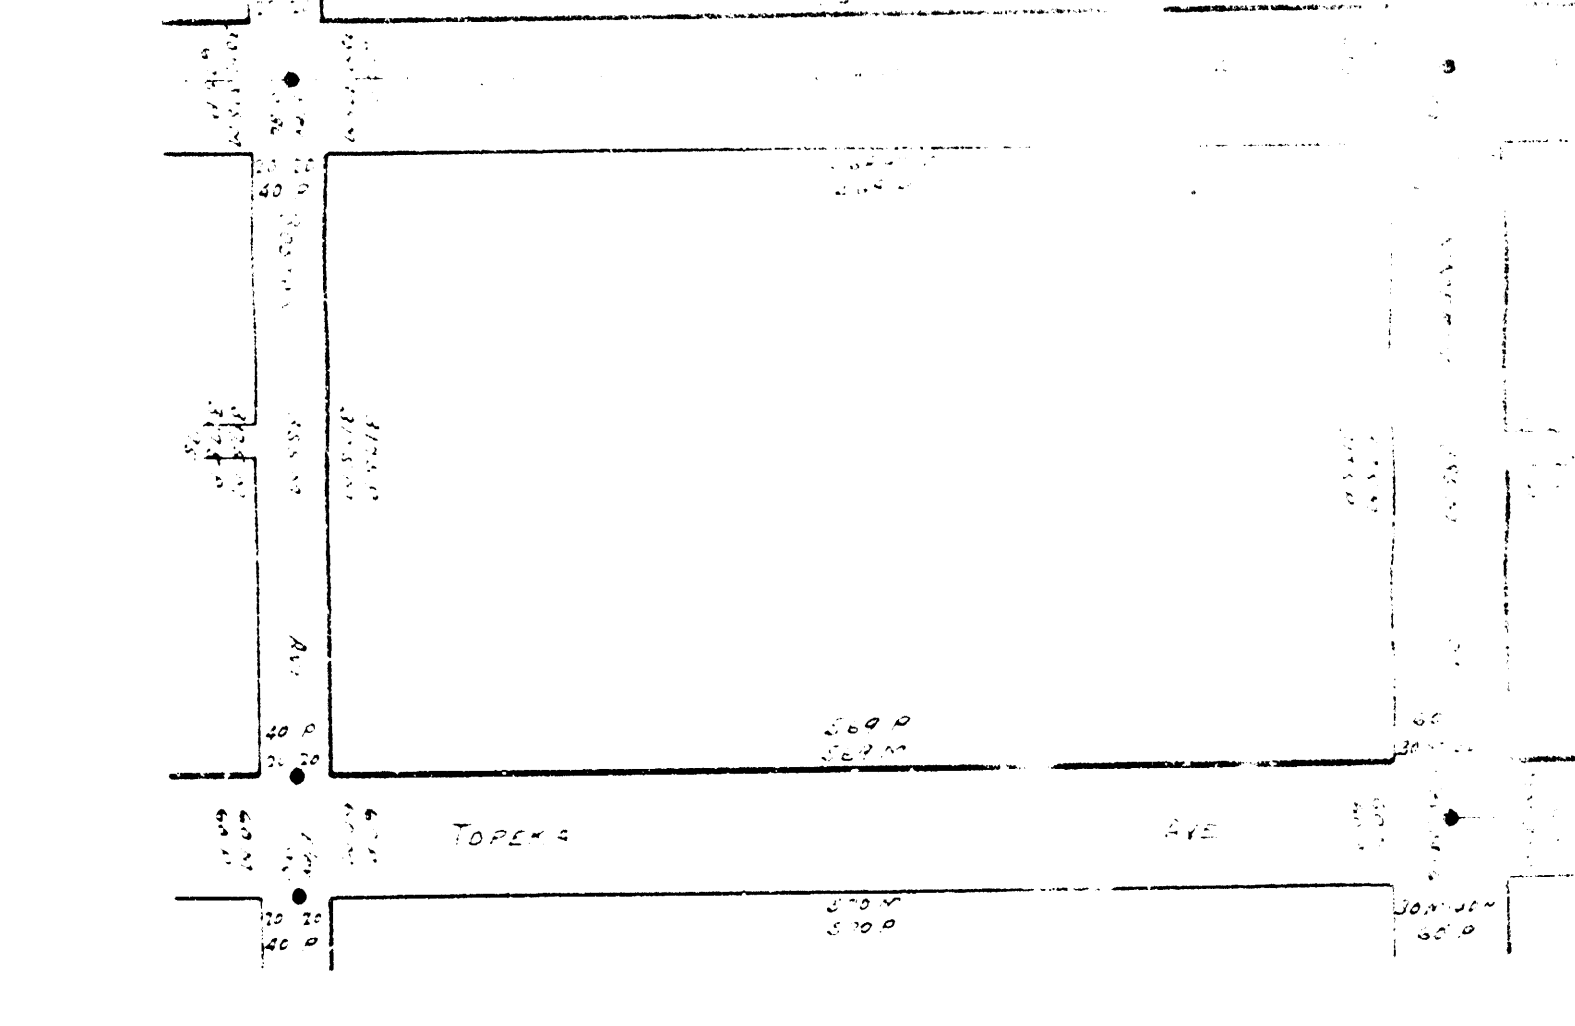

89

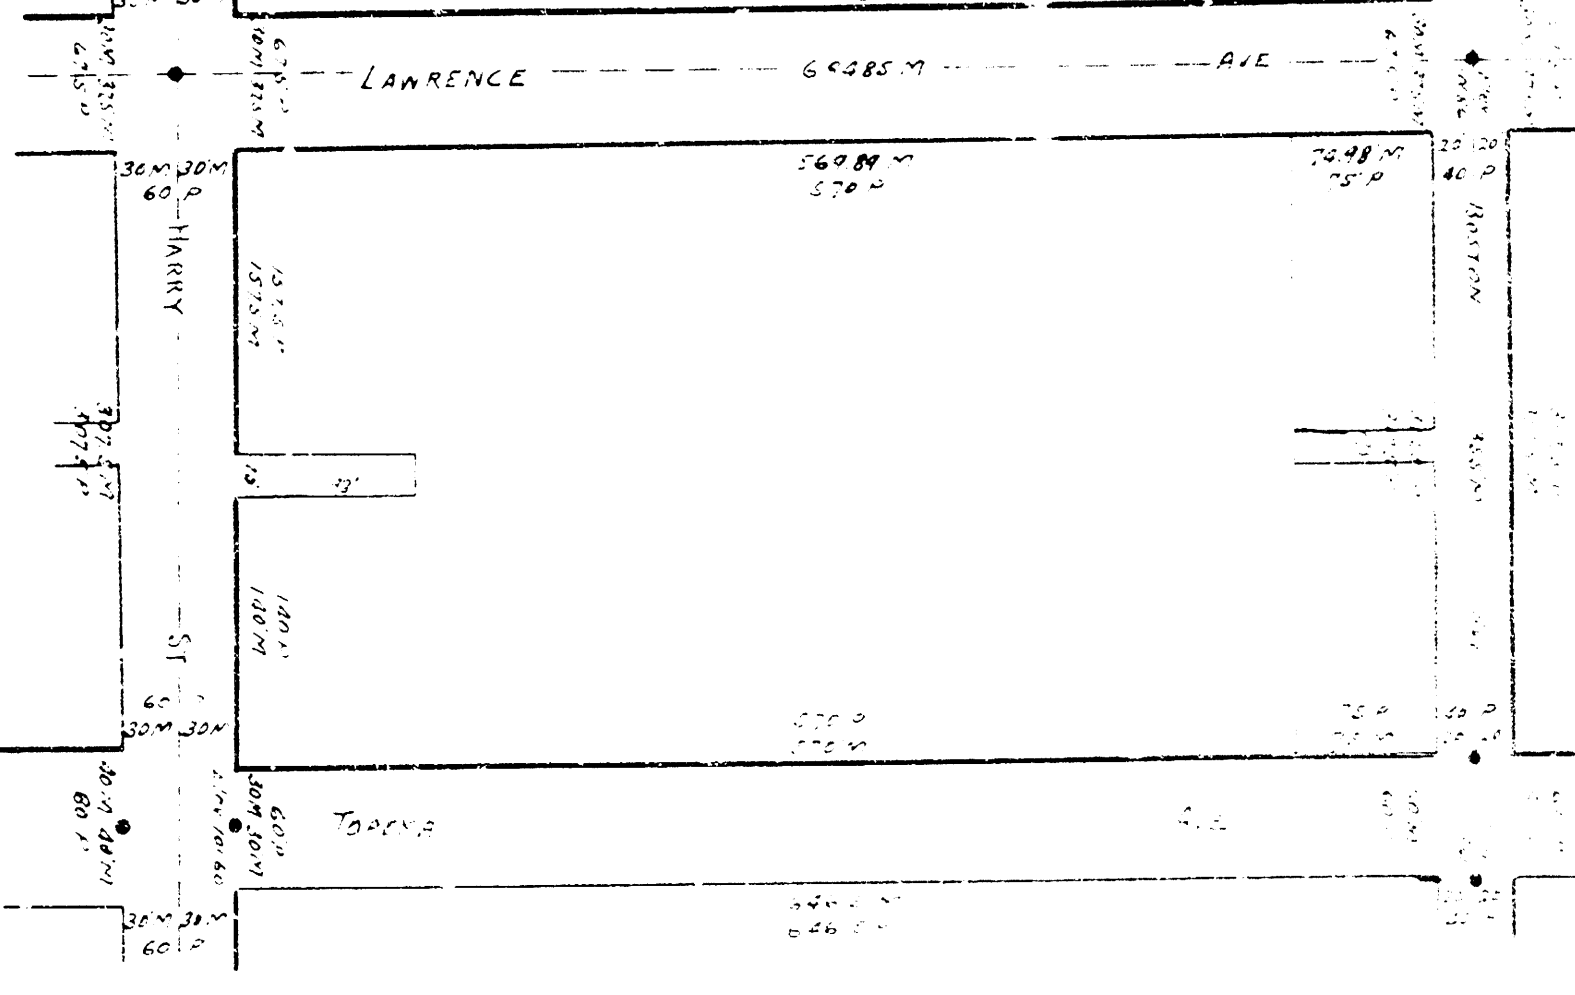

90



91



92

