

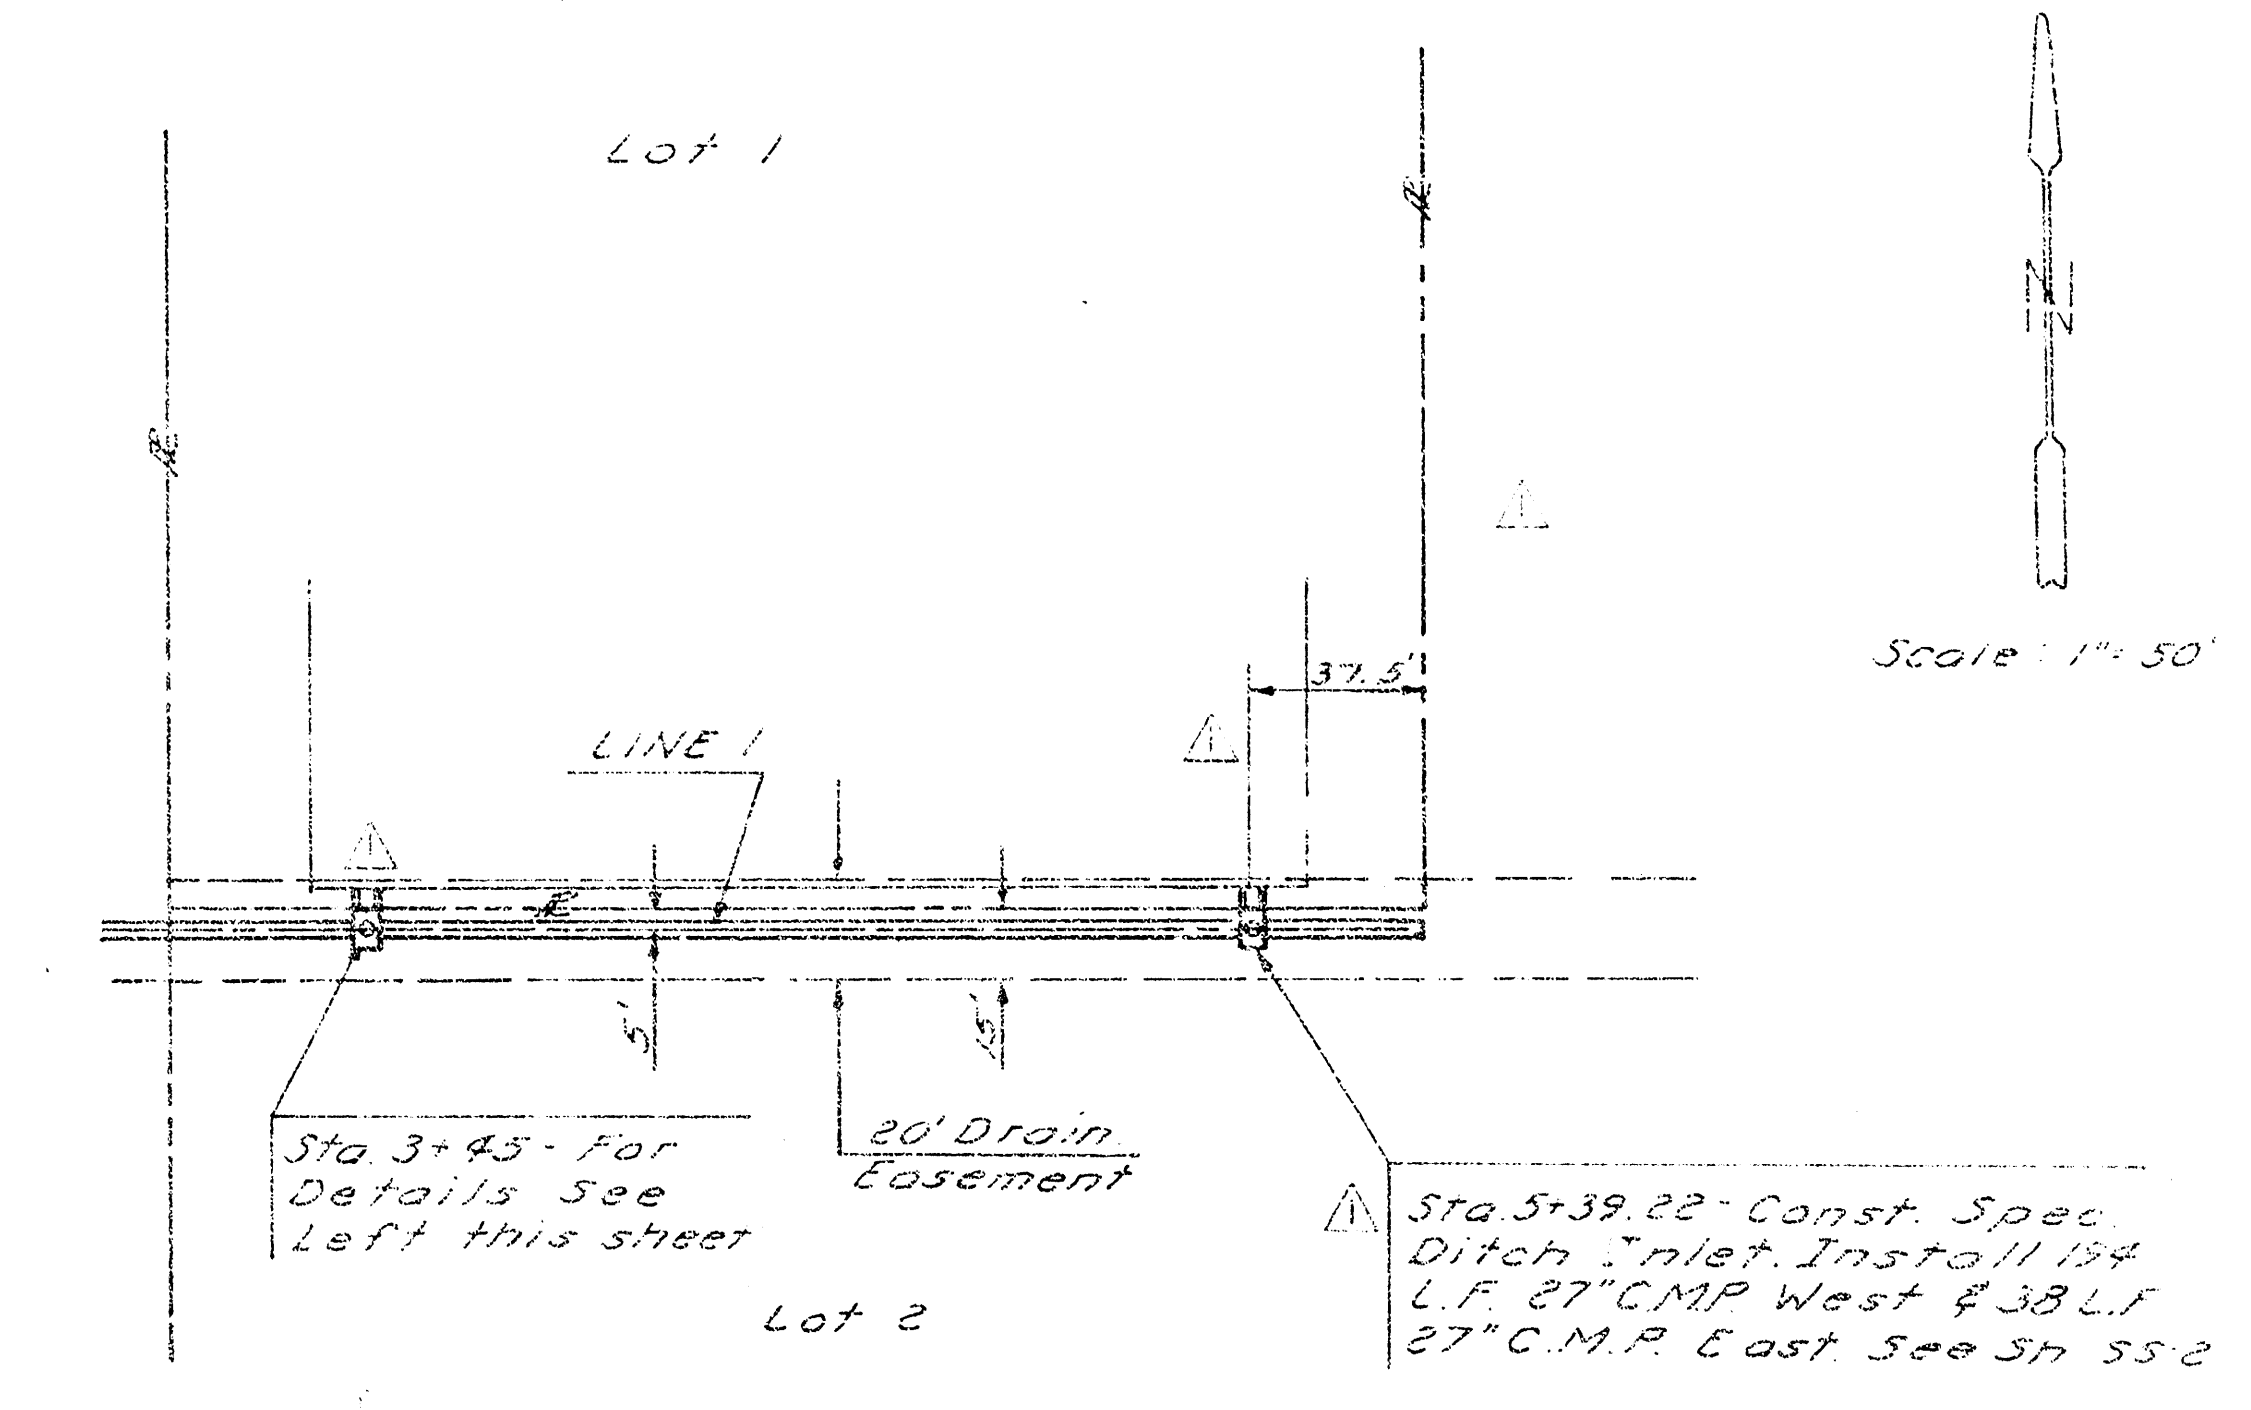
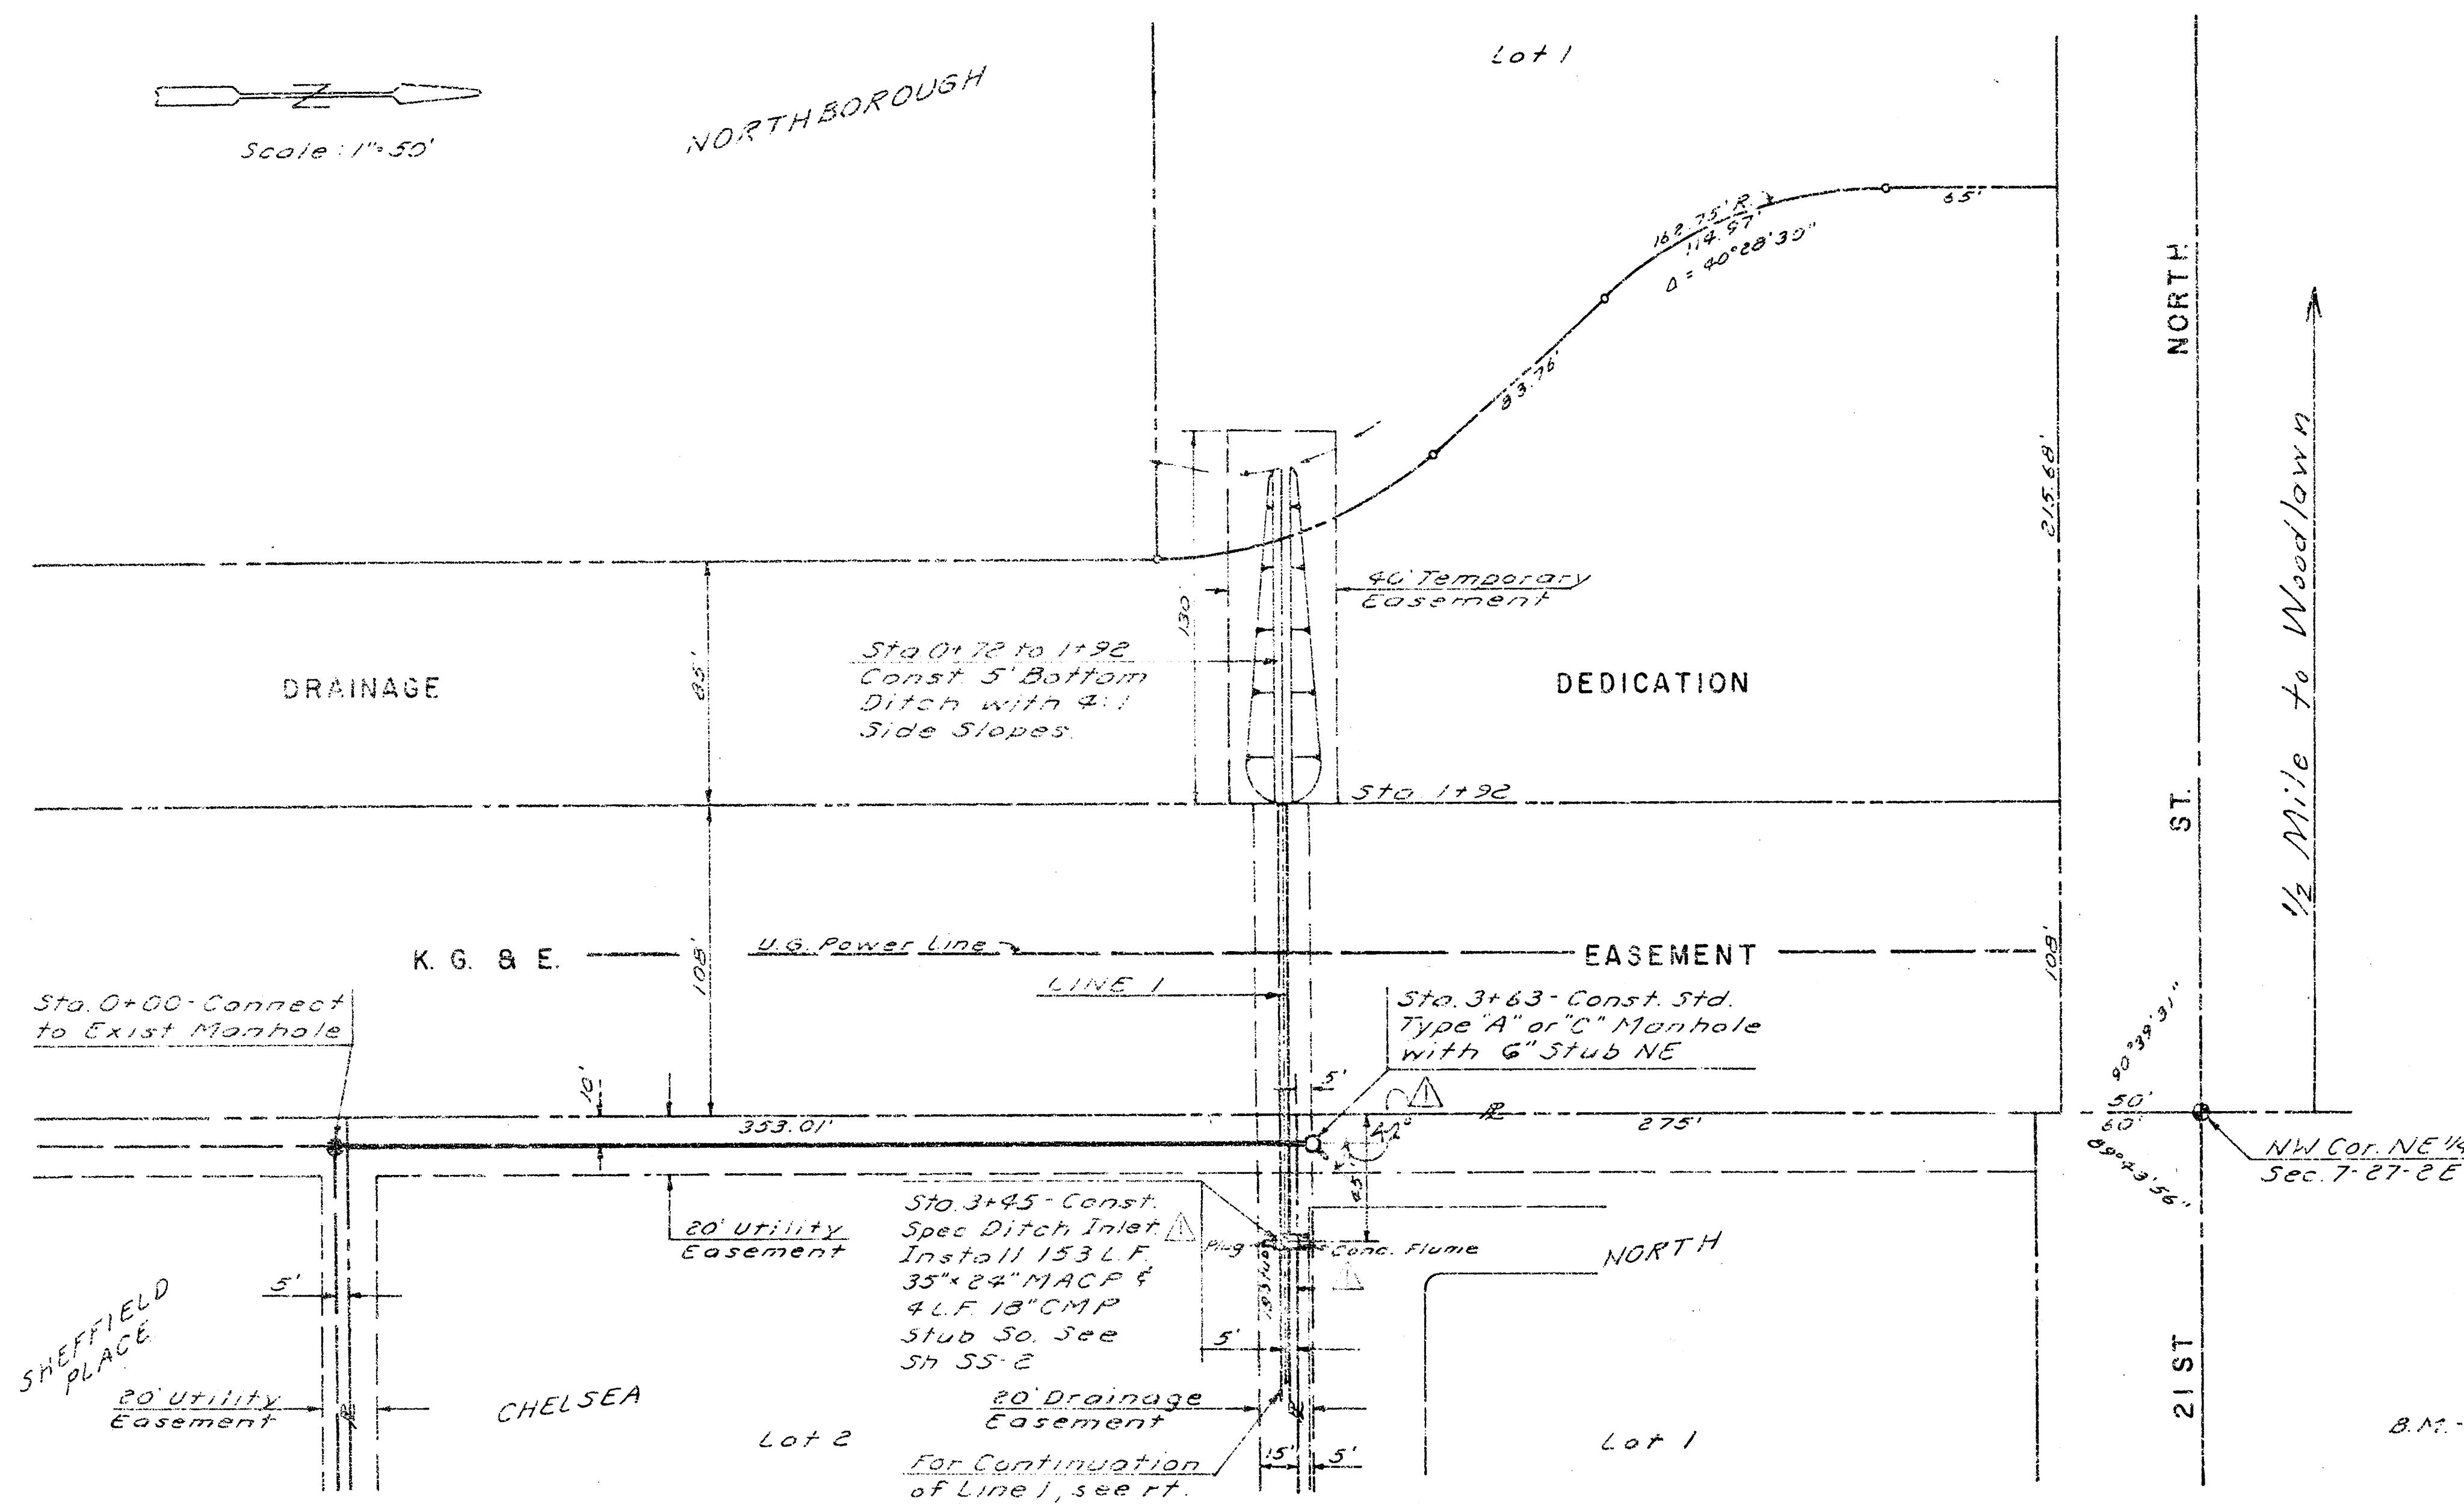
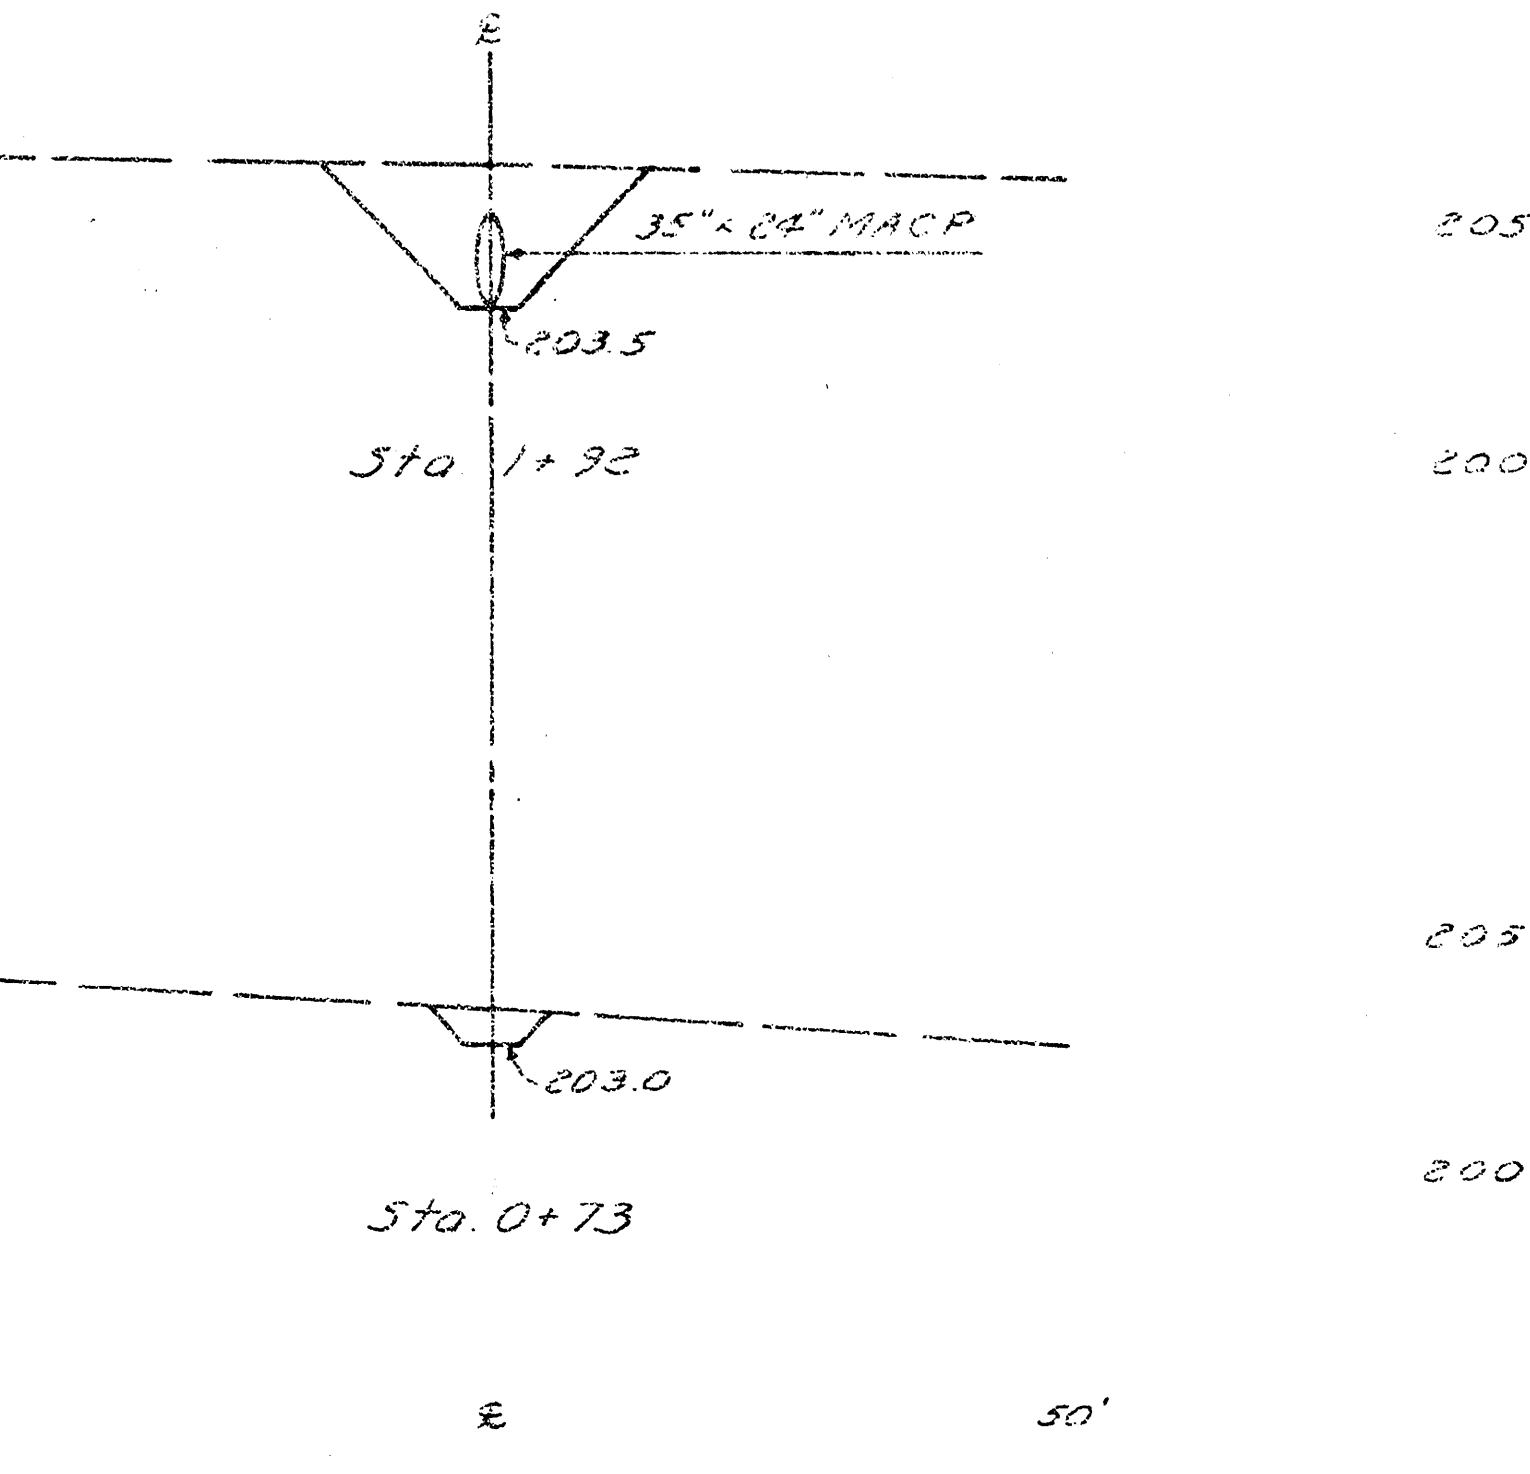


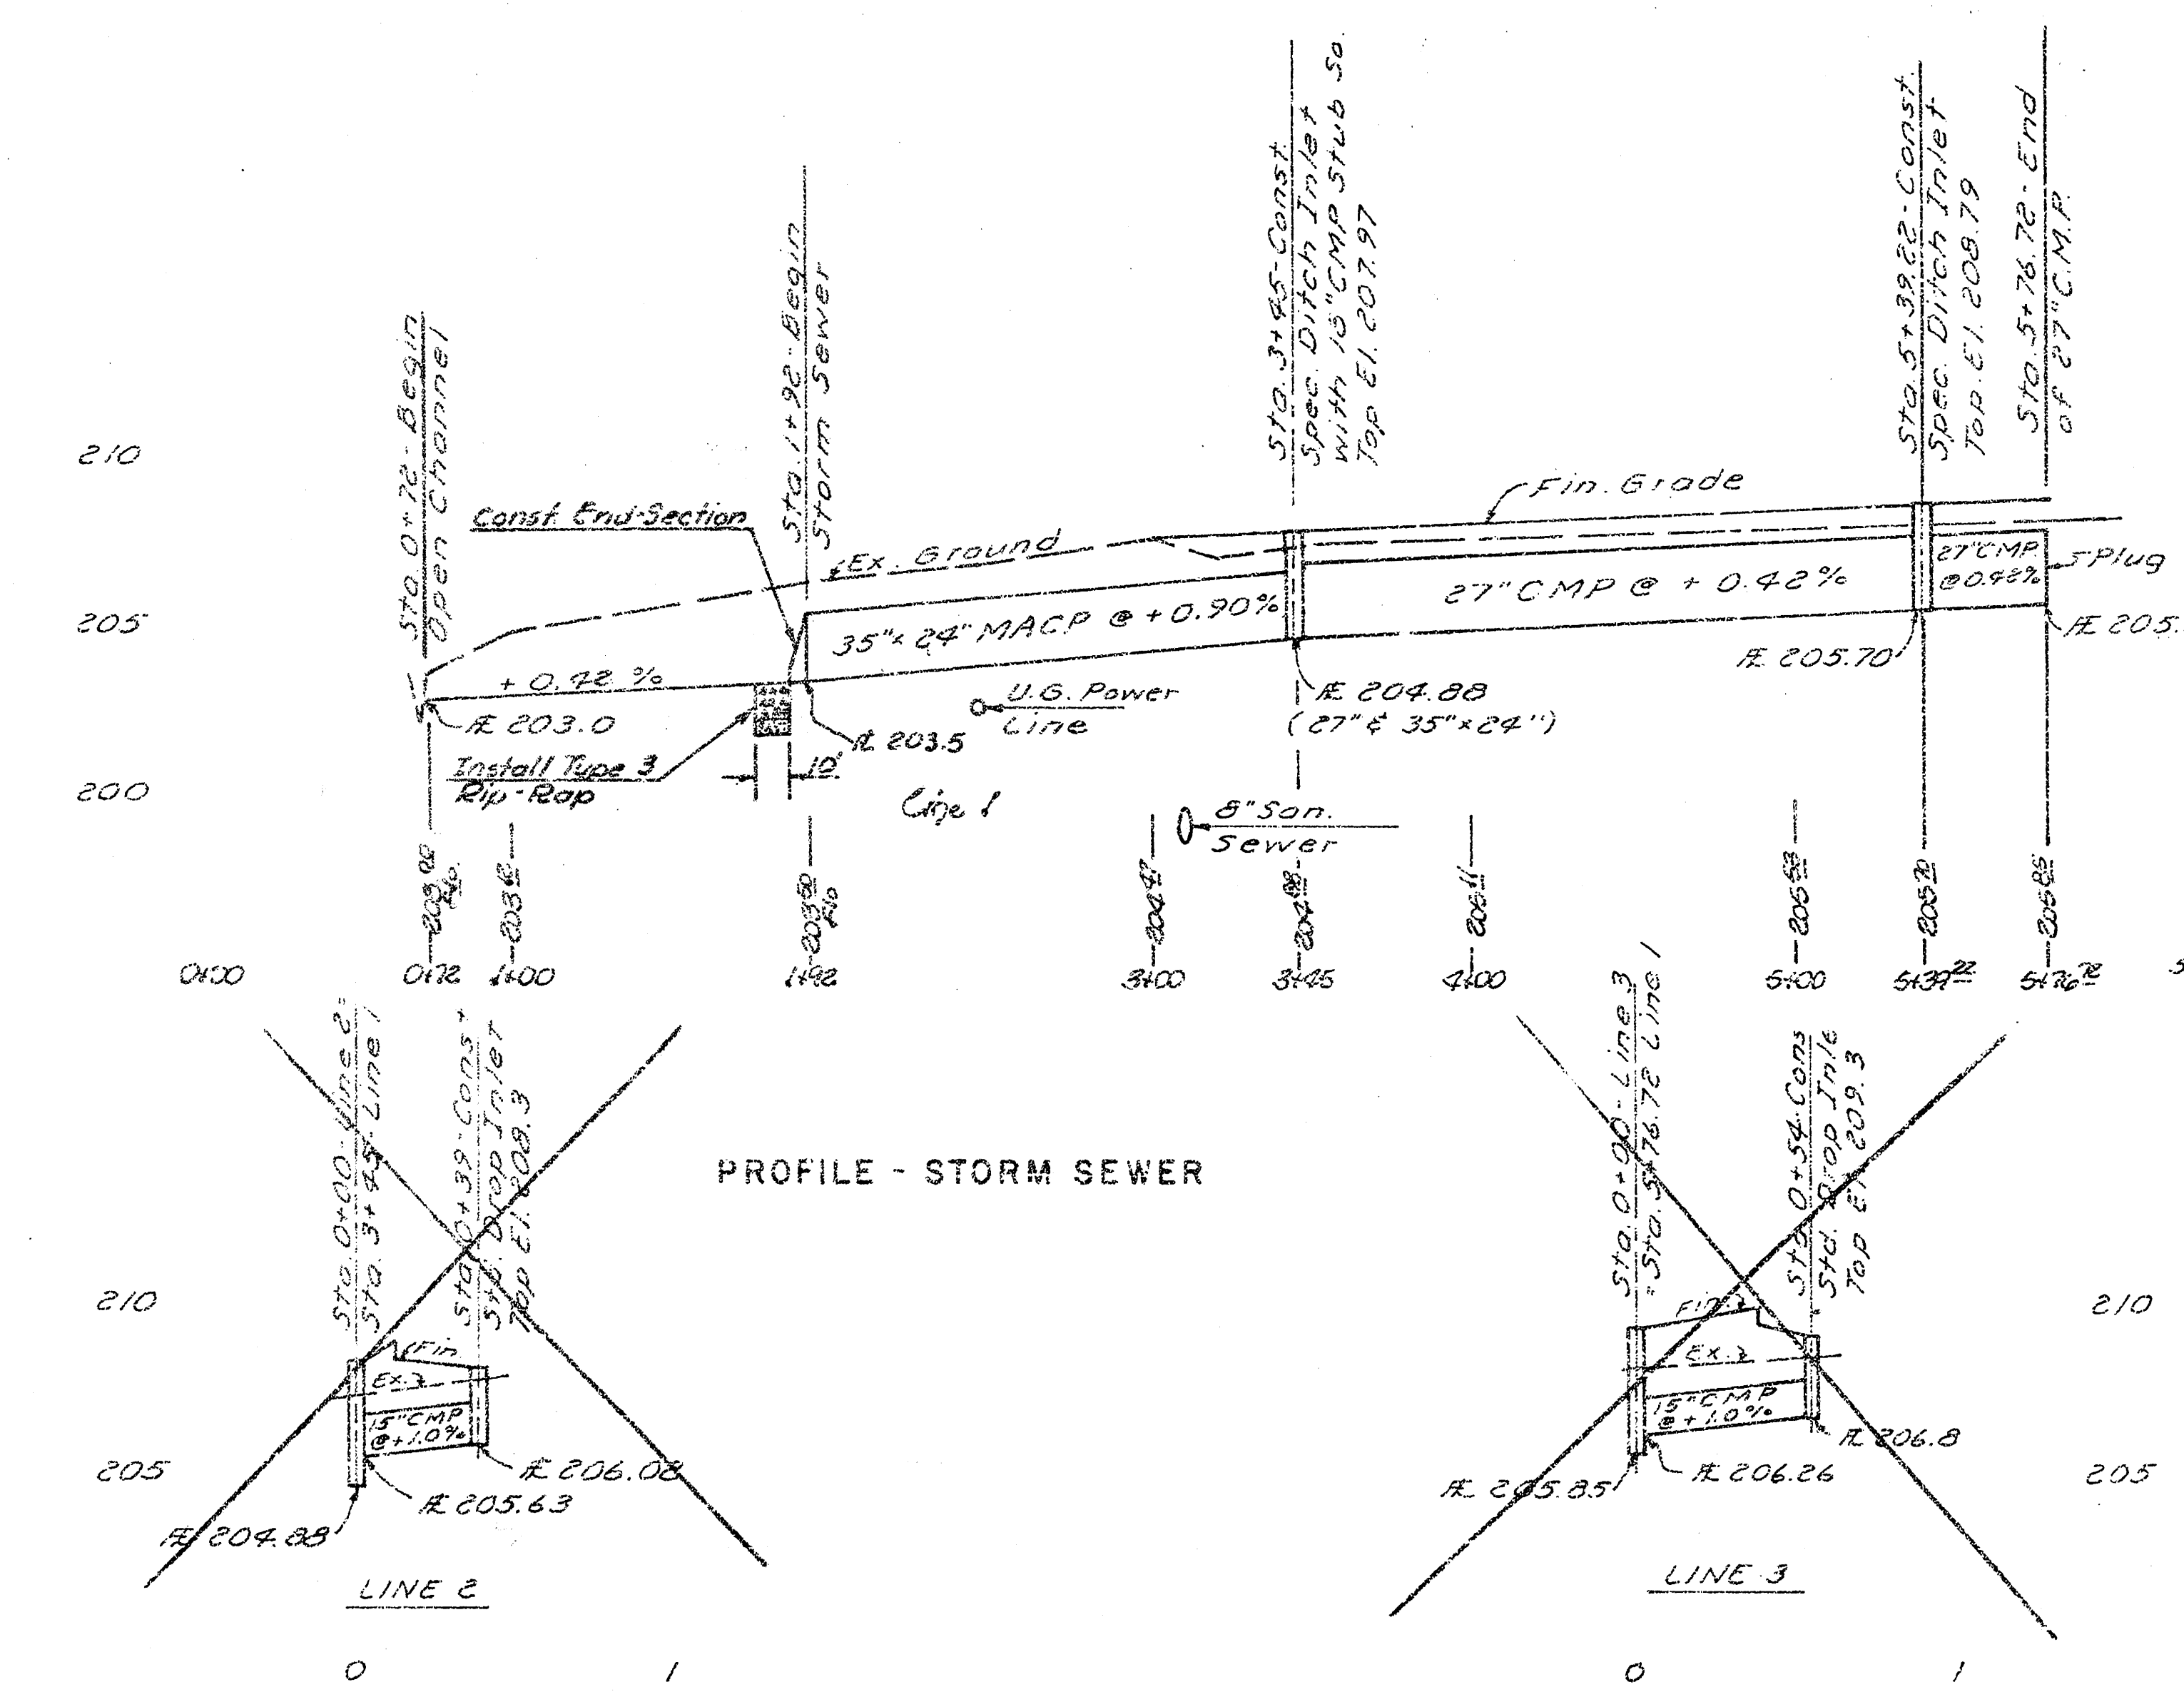

NOTE TO CONTRACTOR:
Beware of underground power line in K.G. & E. easement. K.G. & E. to be contacted prior to any excavation within their easement.




NOTE:
You are informed that there is a 12 kV underground line running north and south through this easement. Before excavating you will contact Jerry Young, Division Line Supervisor, at 1500 East Central, 201-6975, who will cause the underground line to be located. Any digging in the immediate vicinity of the line will be held until a qualified representative is at the site.

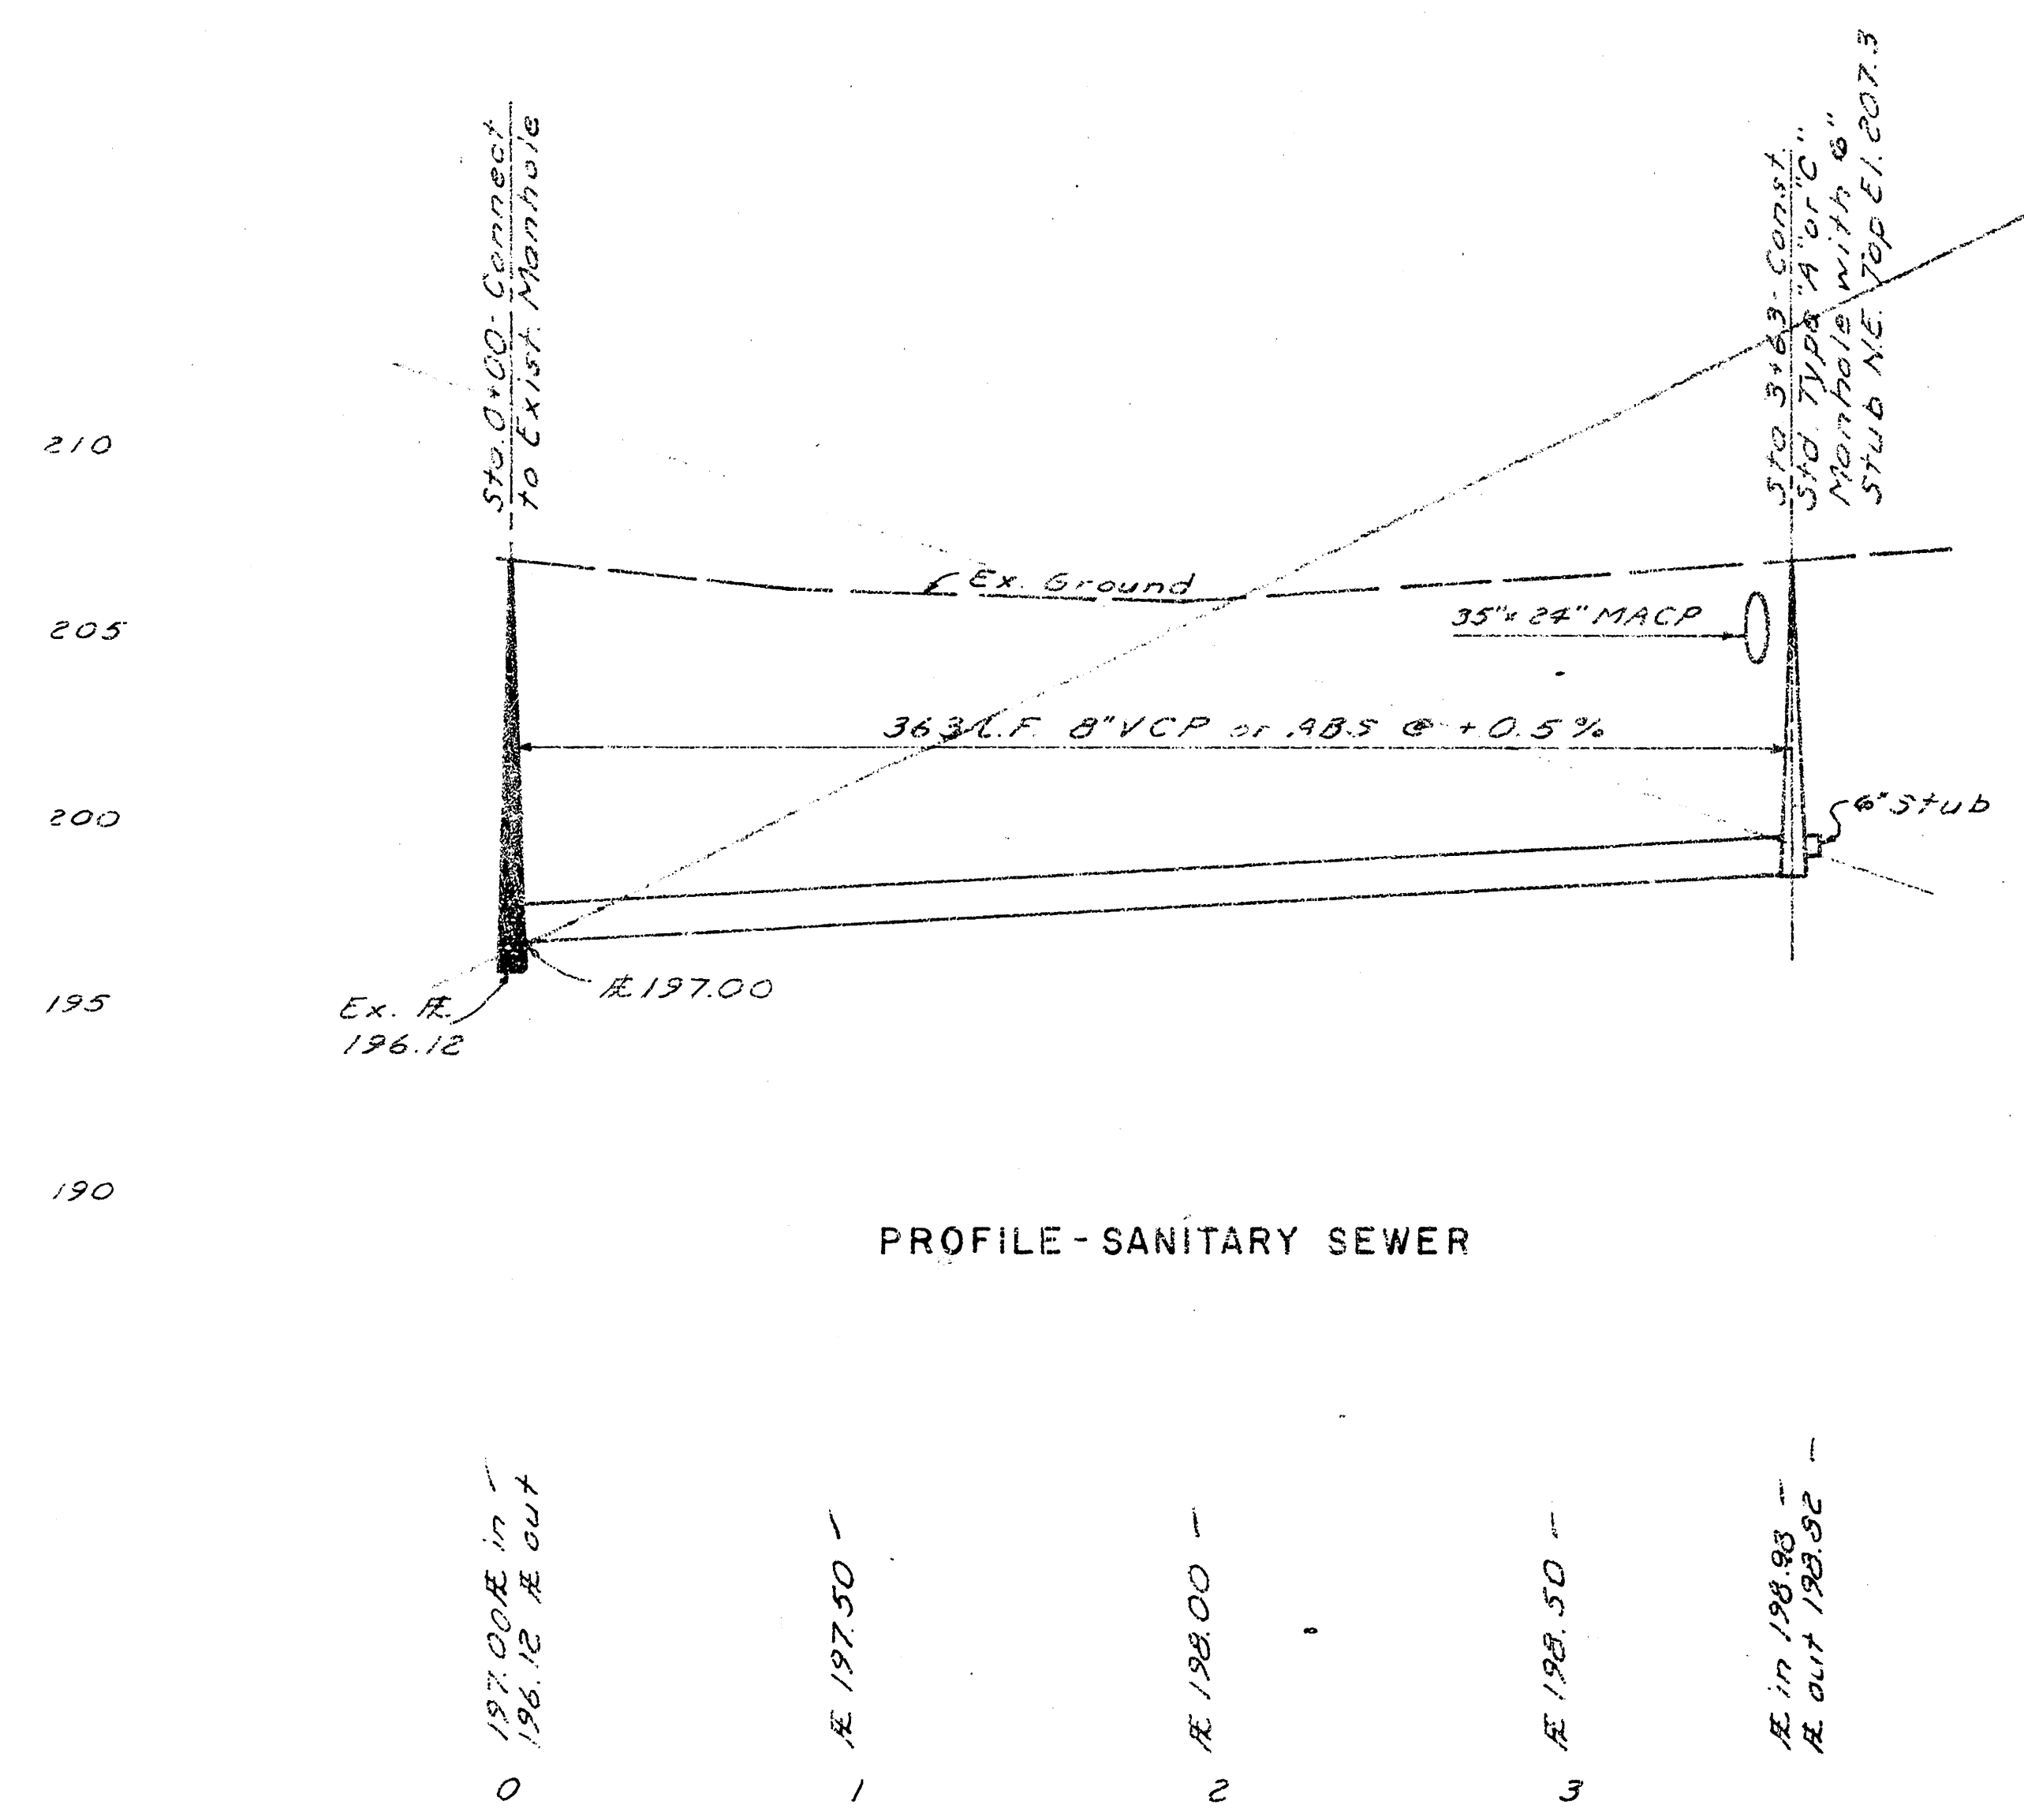

Revised 4-13-81
Revised 11-12-80

S.W.S. No. 217
W. CHELSEA NORTH ADDN.
CITY OF WICHITA, KS.
R.W. BRUGGEMAN - DIR. ENGINEERING.
PROJECT NO. 468-76-245-61048-000-000-001

FILED FROM THE BEST AVAILABLE COPY

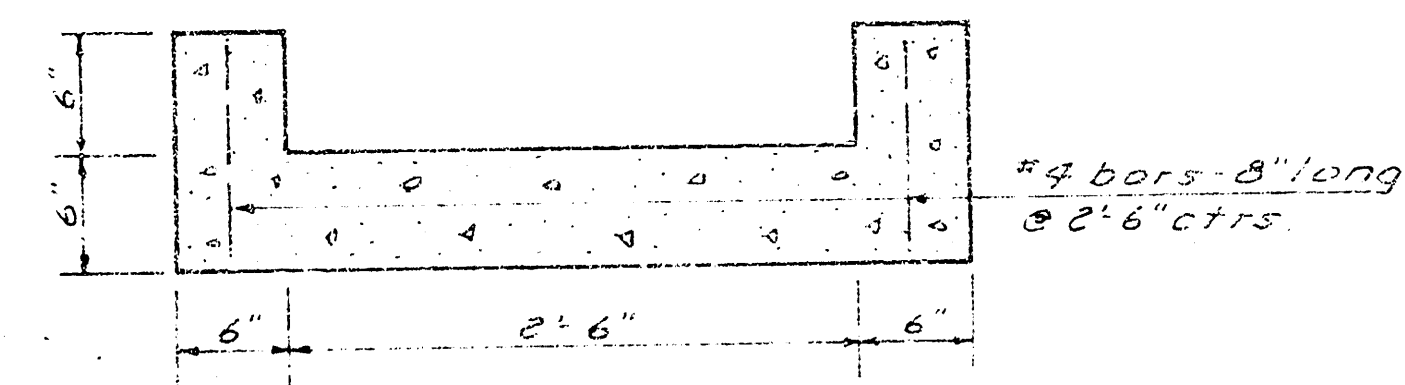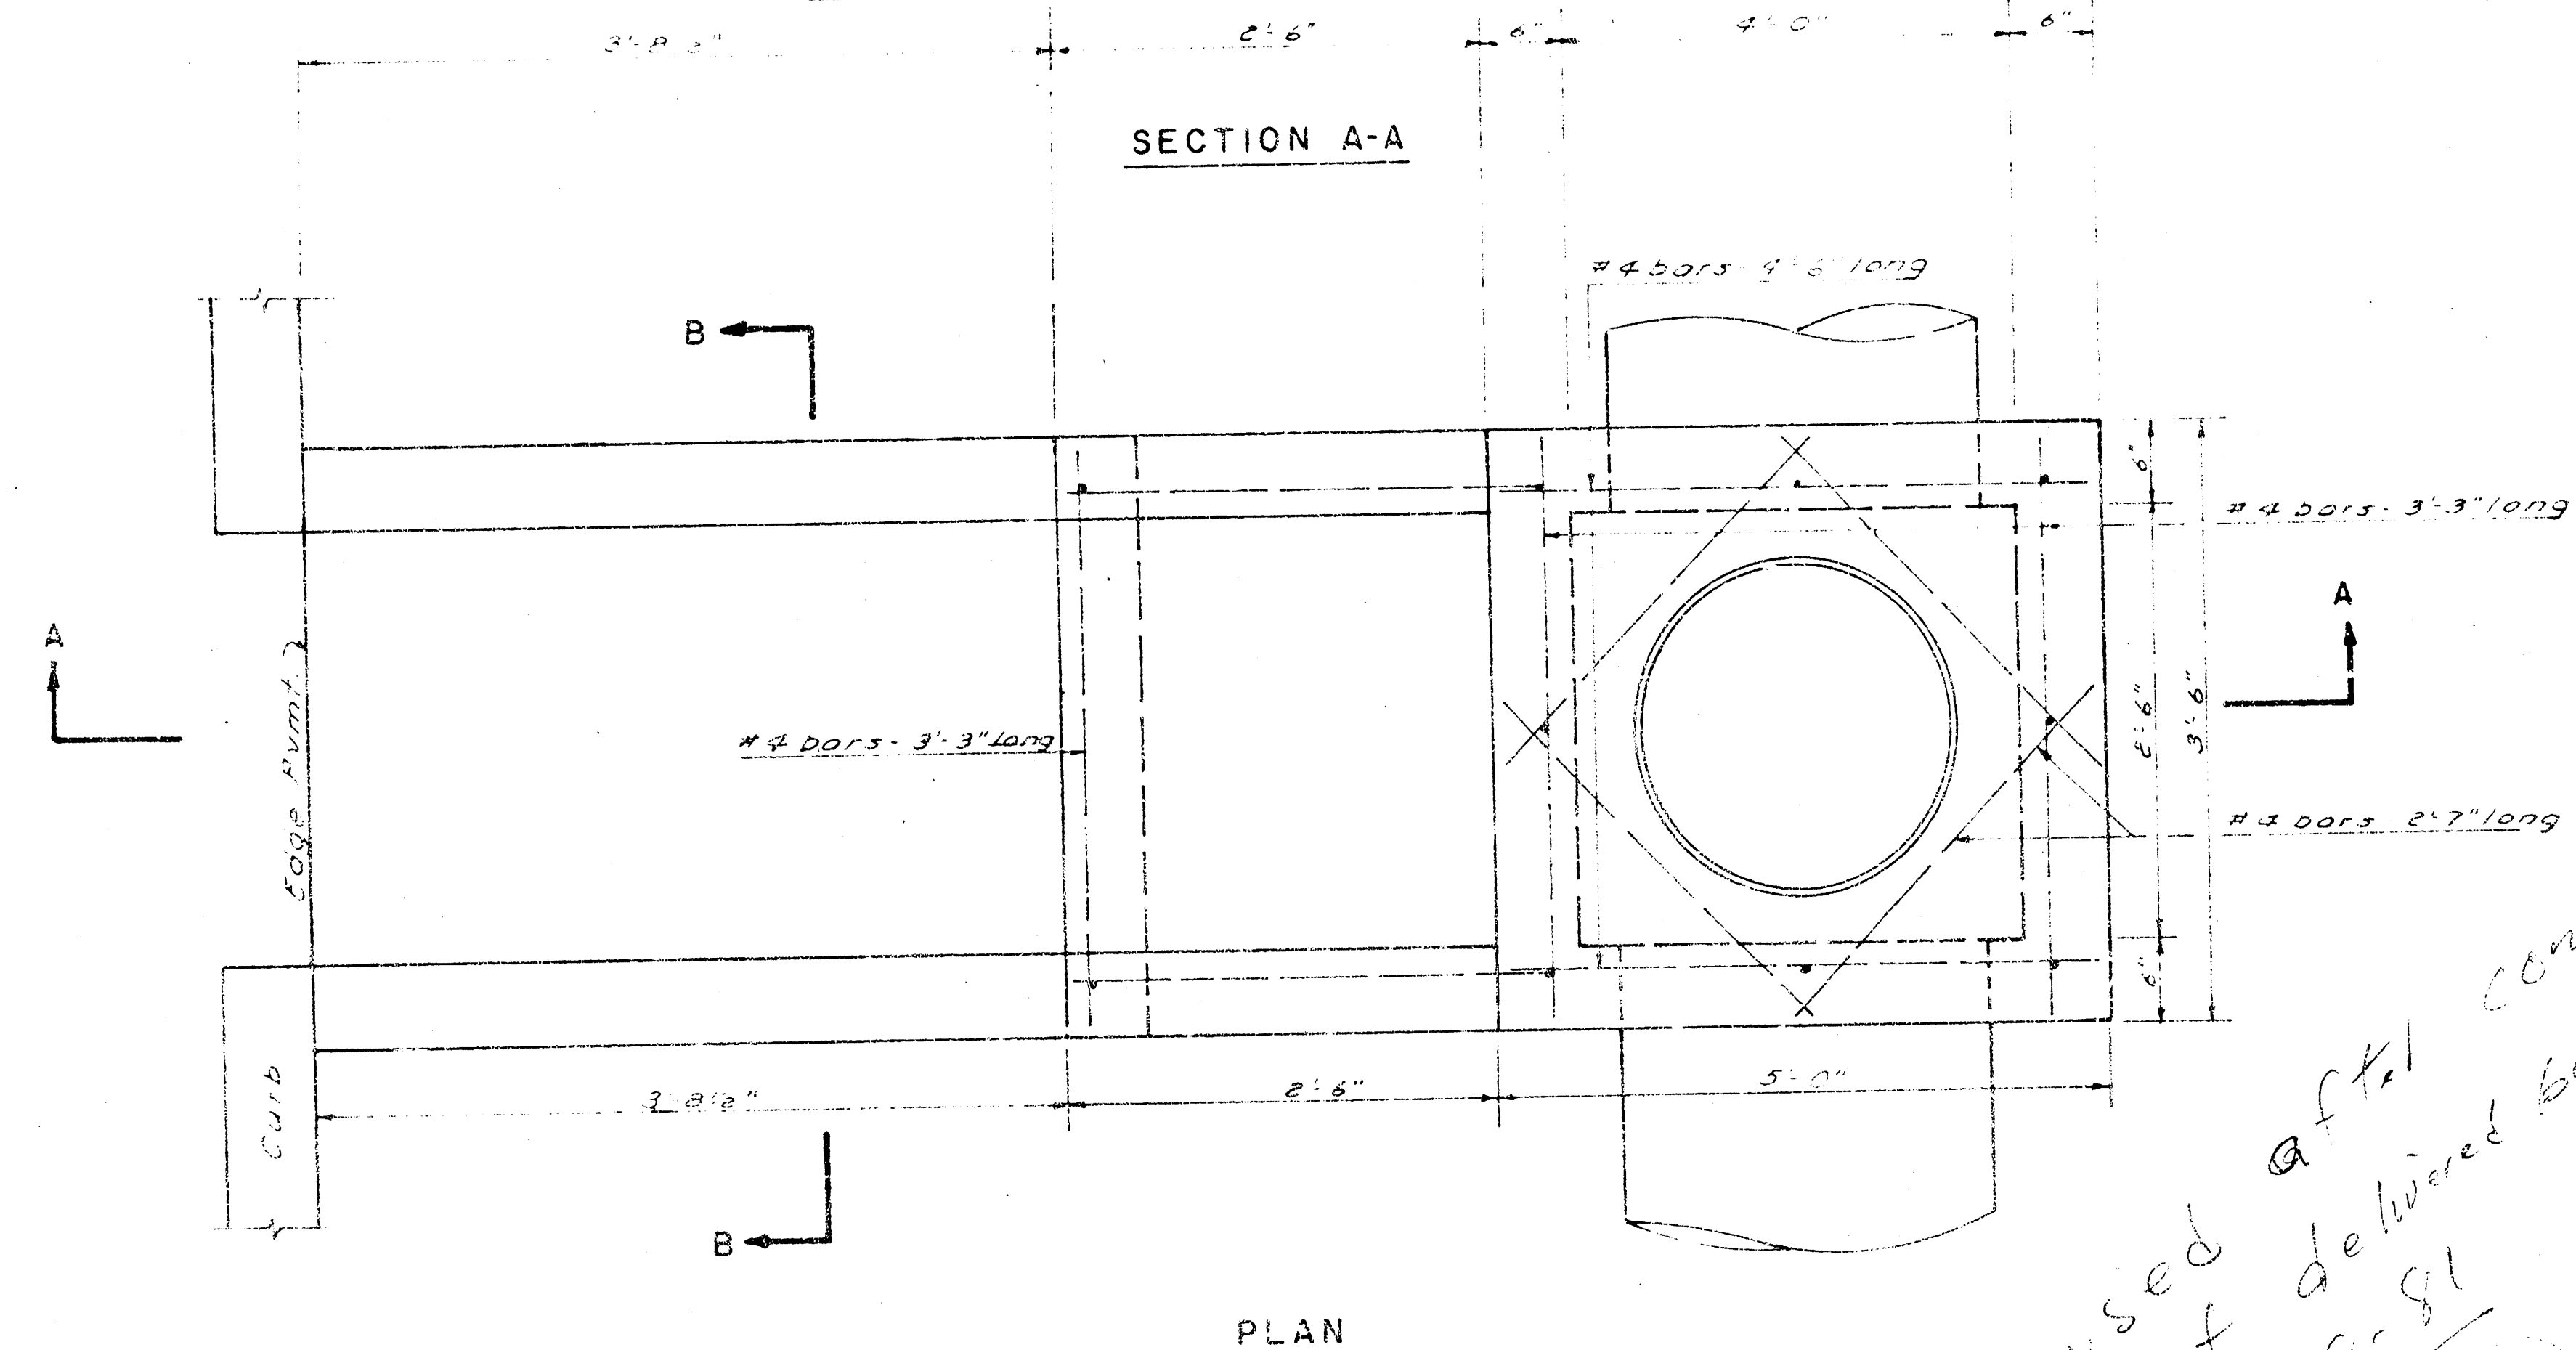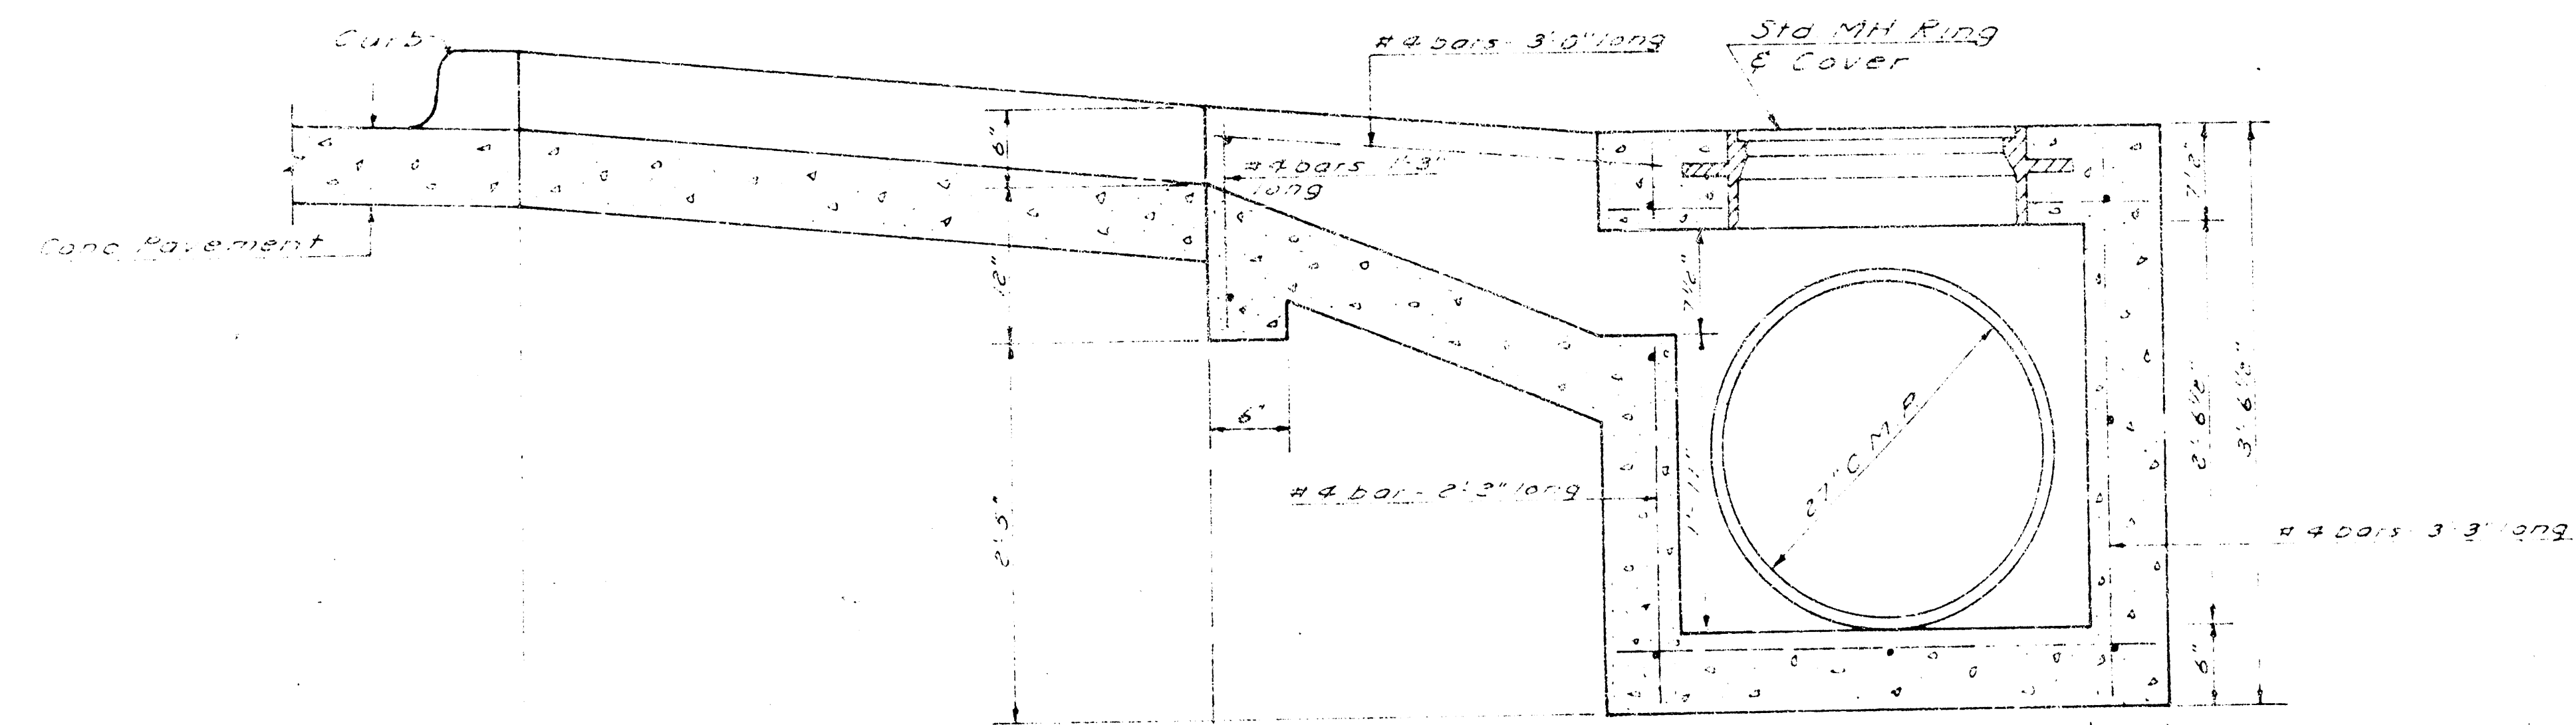

SPECIAL DITCH INLET DETAILS
Scale: 1" = 1'-0"

*Revised after contract
was let delivered by Baughman & Co
6-8-81*

DATE ISSUED	6-8-81
REVISIONS	6-8-81
DATE DRAWN	

JEFF KREHBIEL ASSOCIATES, AIA
architecture · planning

NORTHEAST FAMILY HEALTH CARE CENTER
THE EAST 6TH STREET
WICHITA, KANSAS

SHEET TITLE
DITCH INLET DTLS

SHEET
SS2
OF 3 SHEETS